




236+25

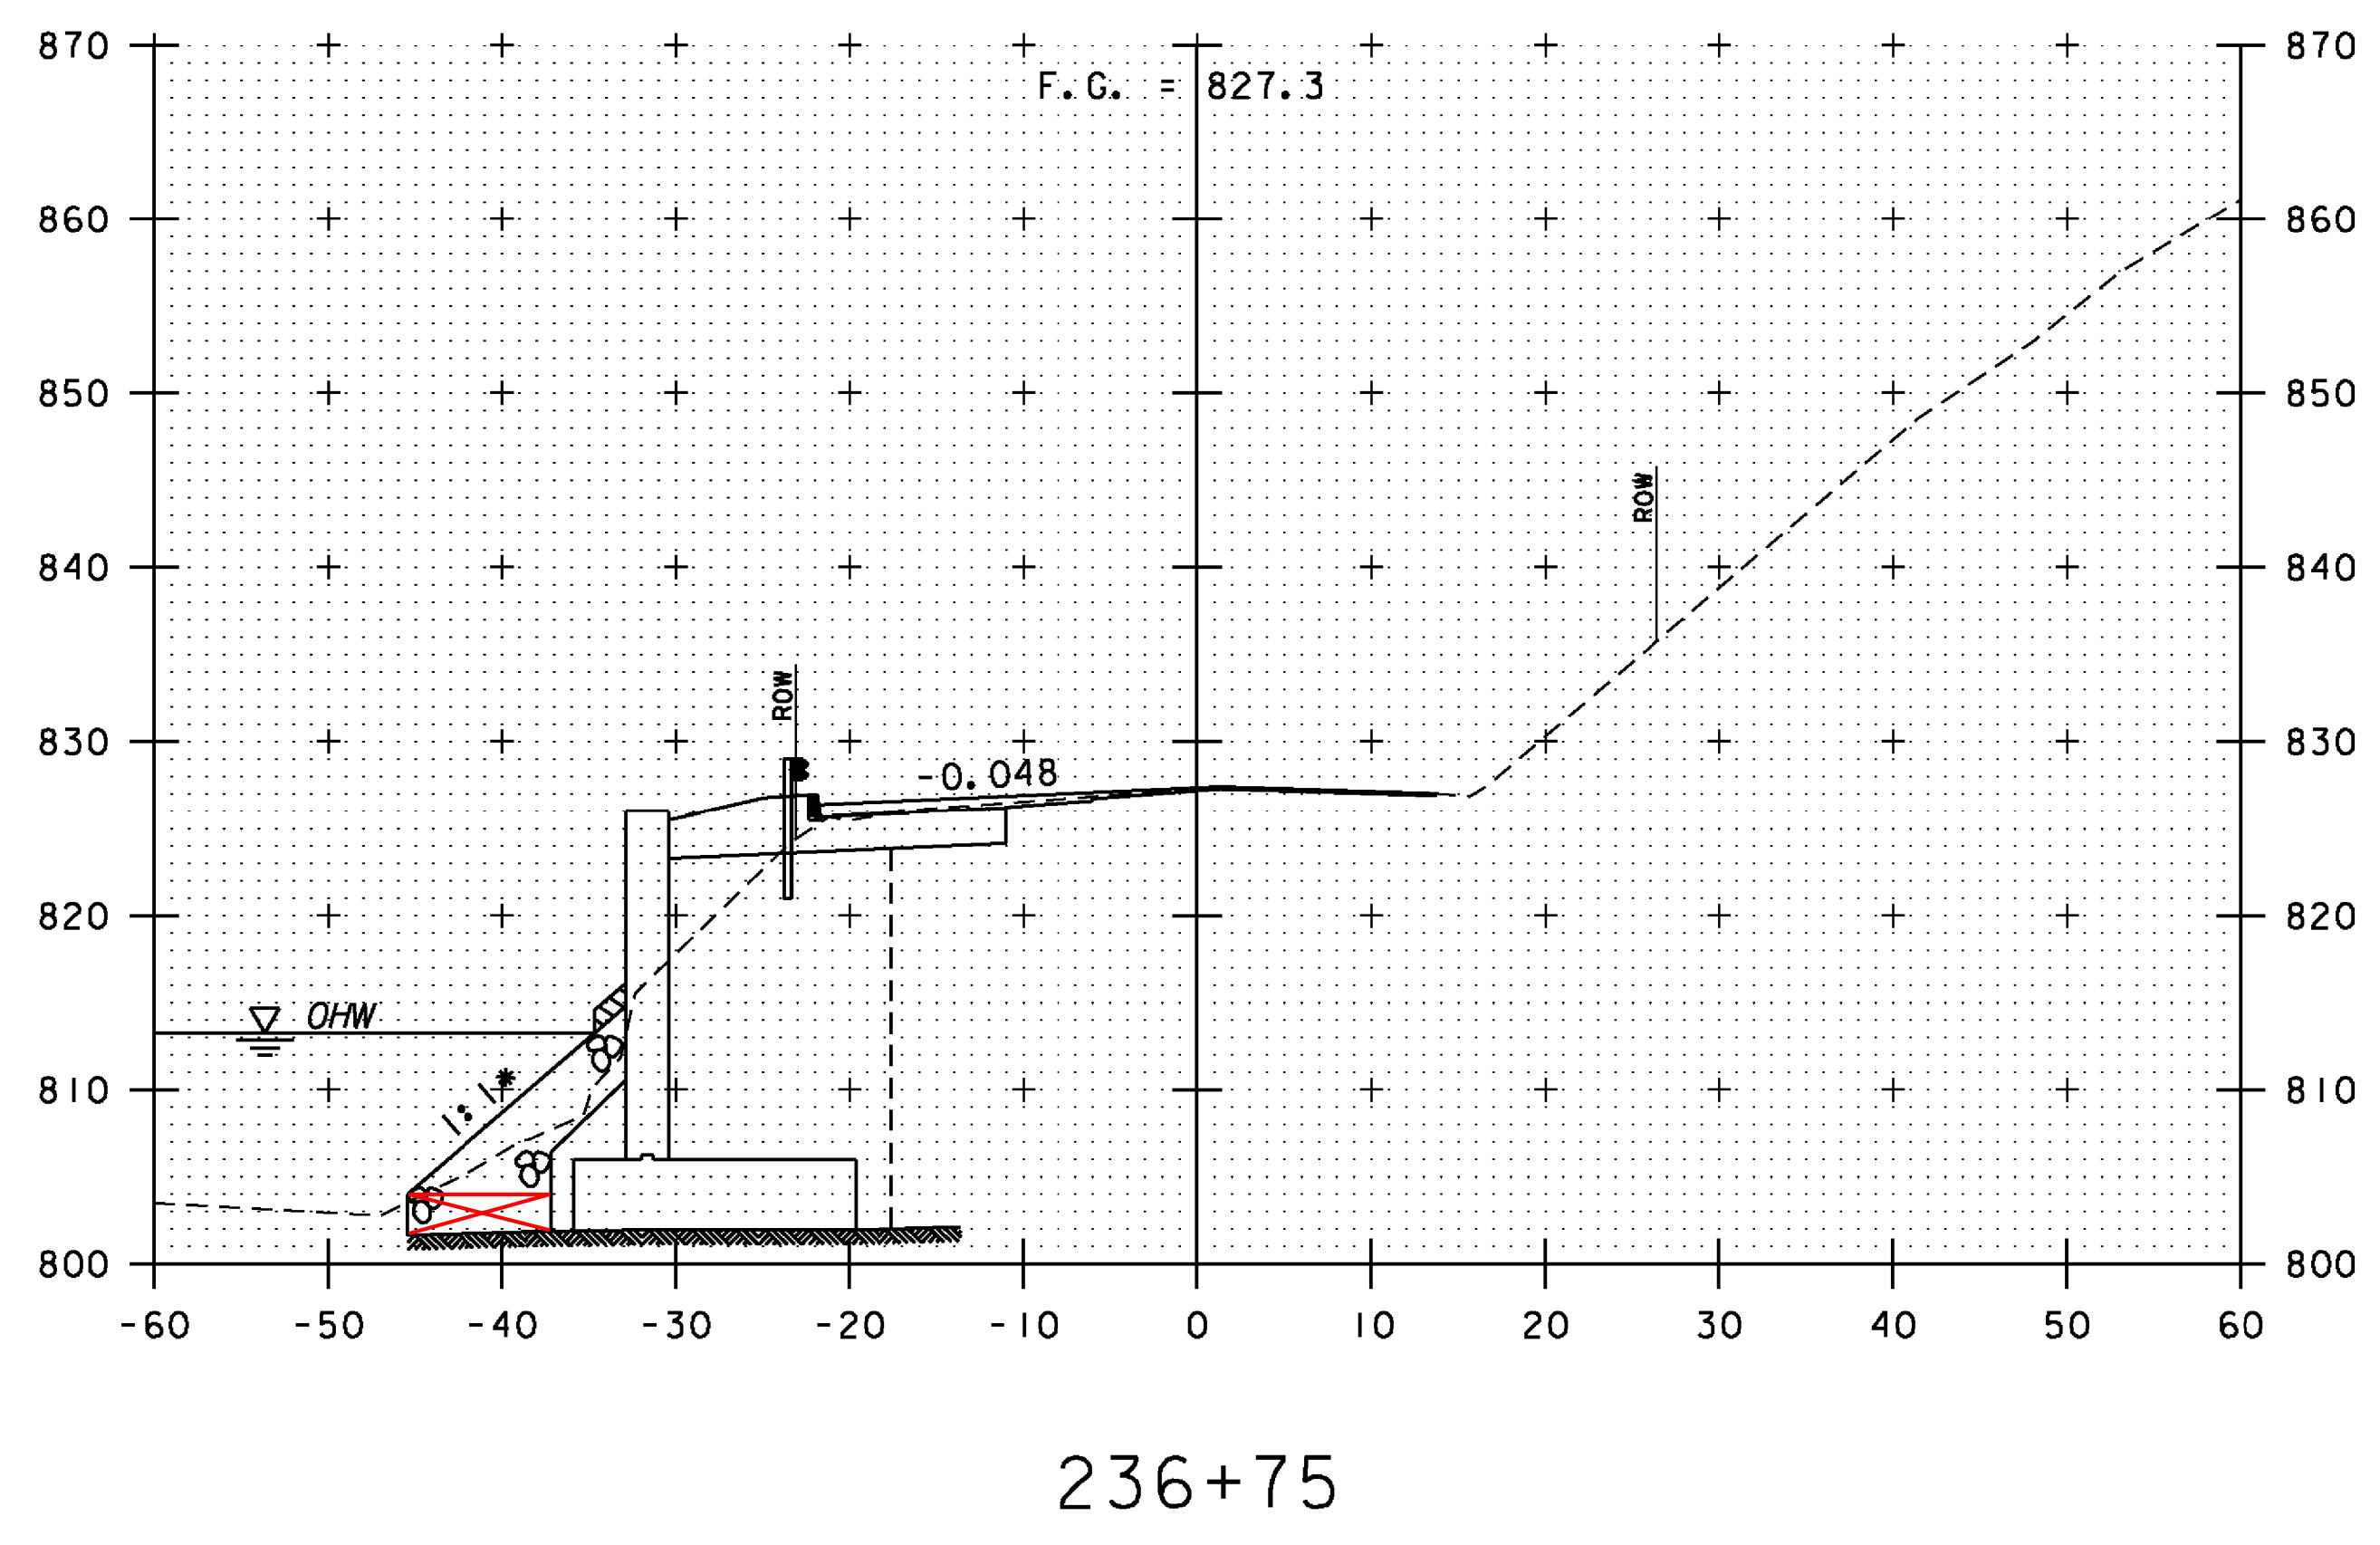

236+75

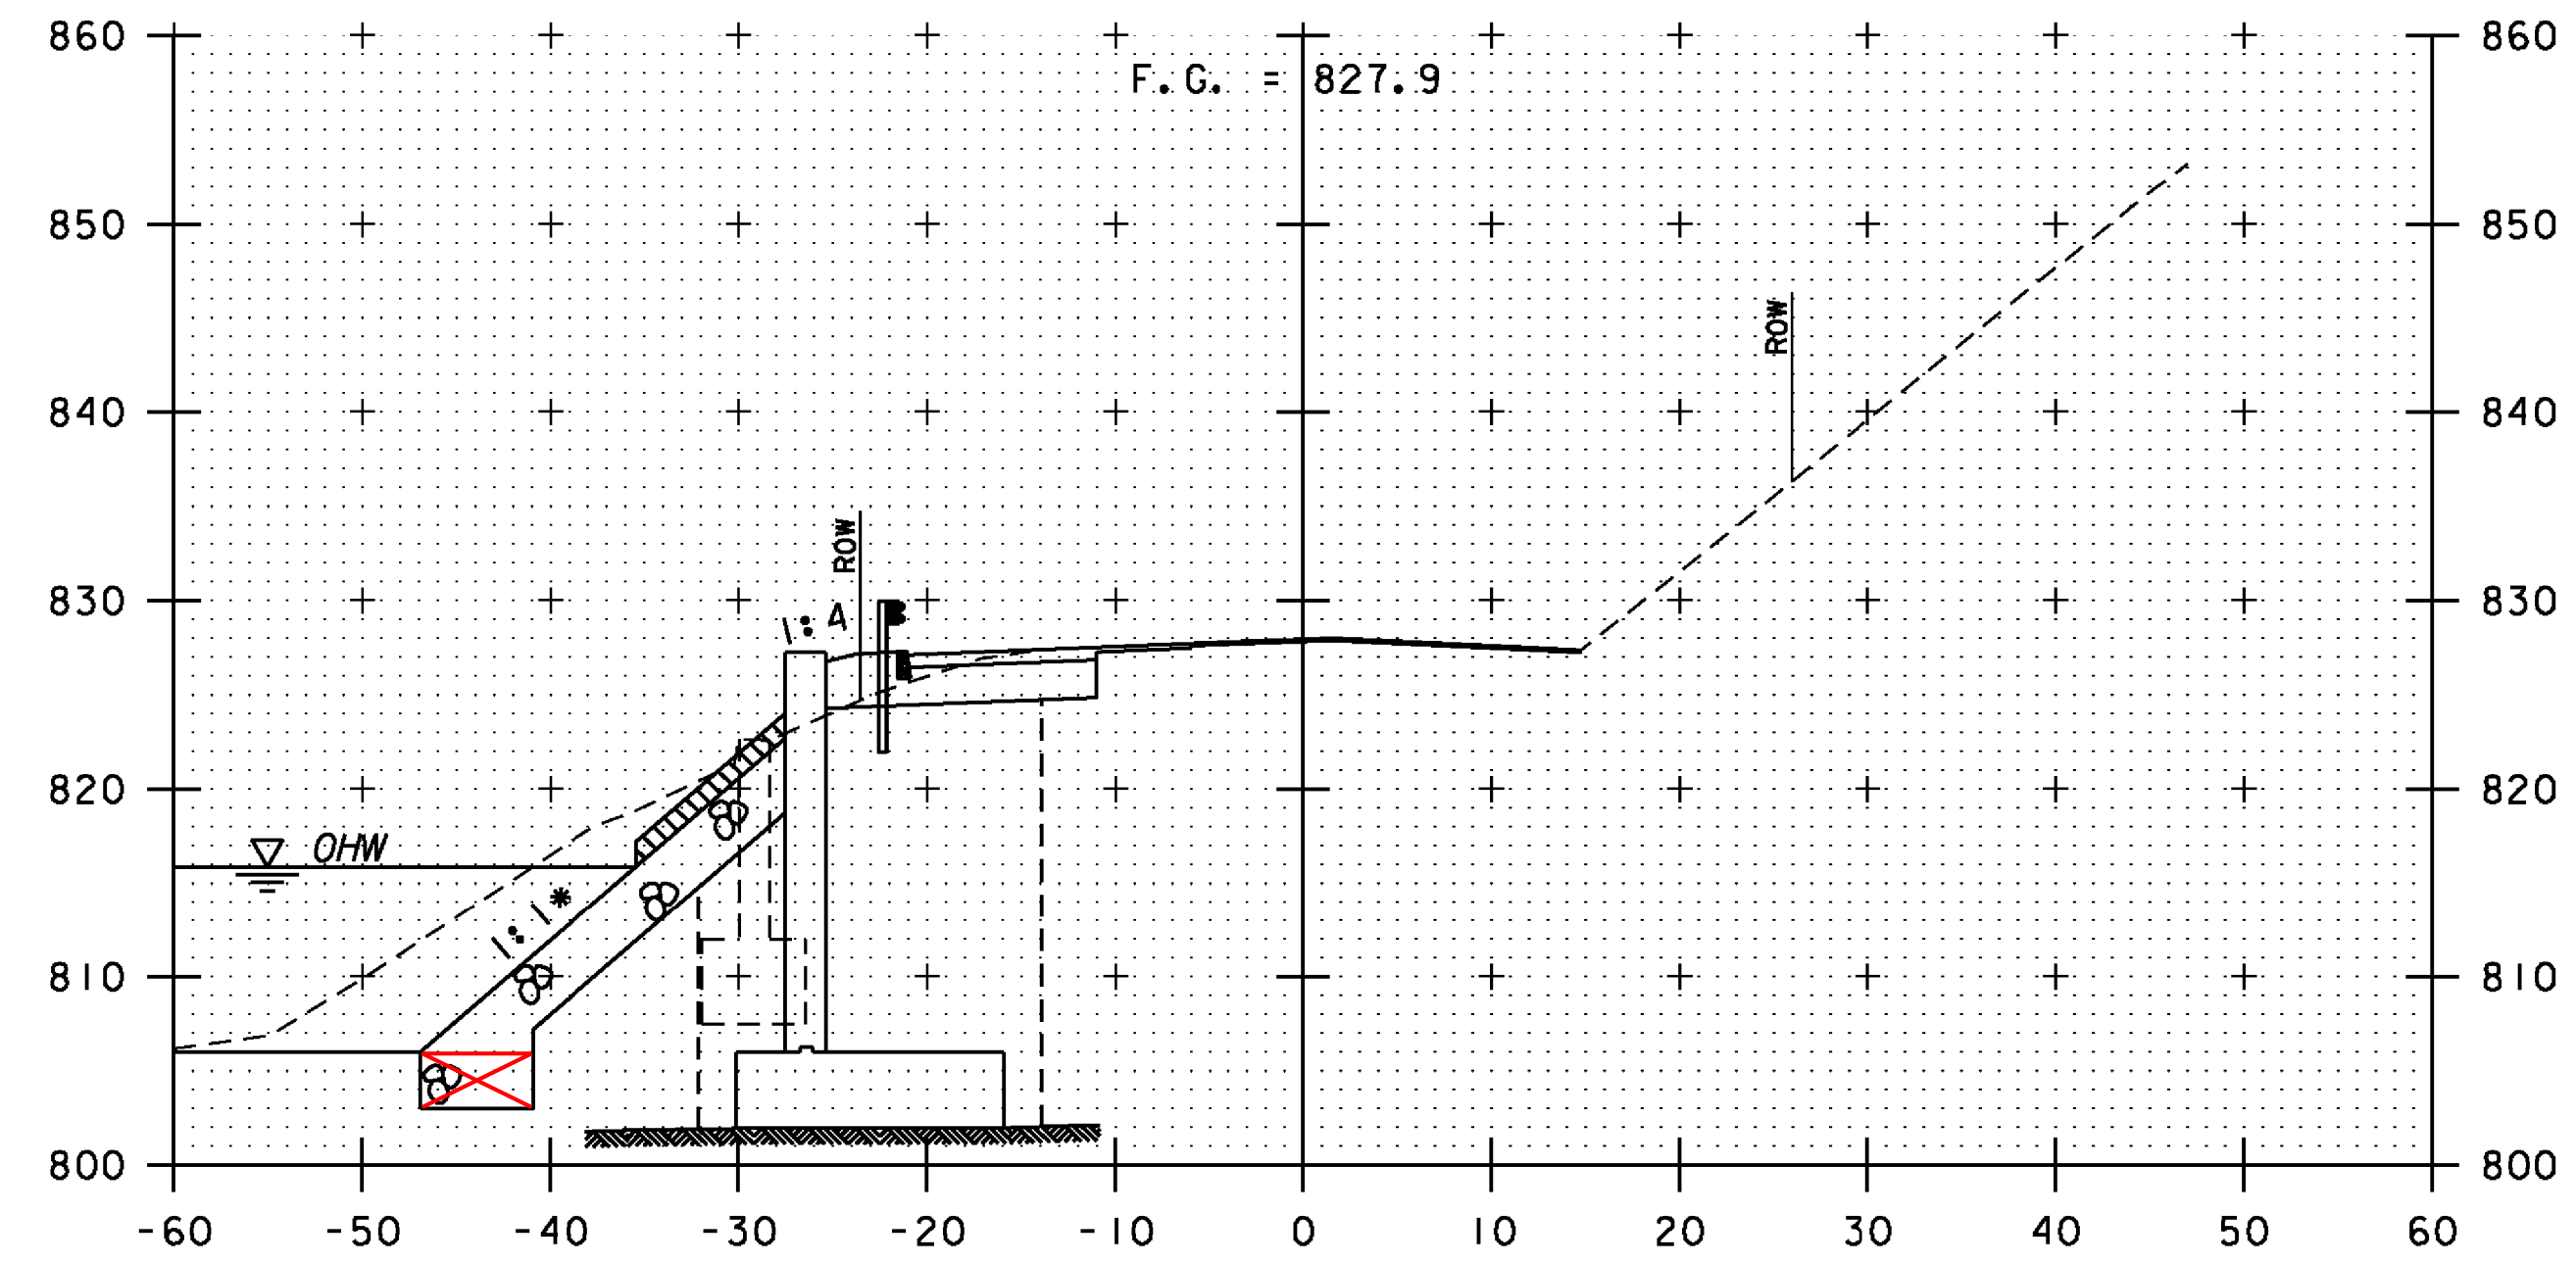

236+00

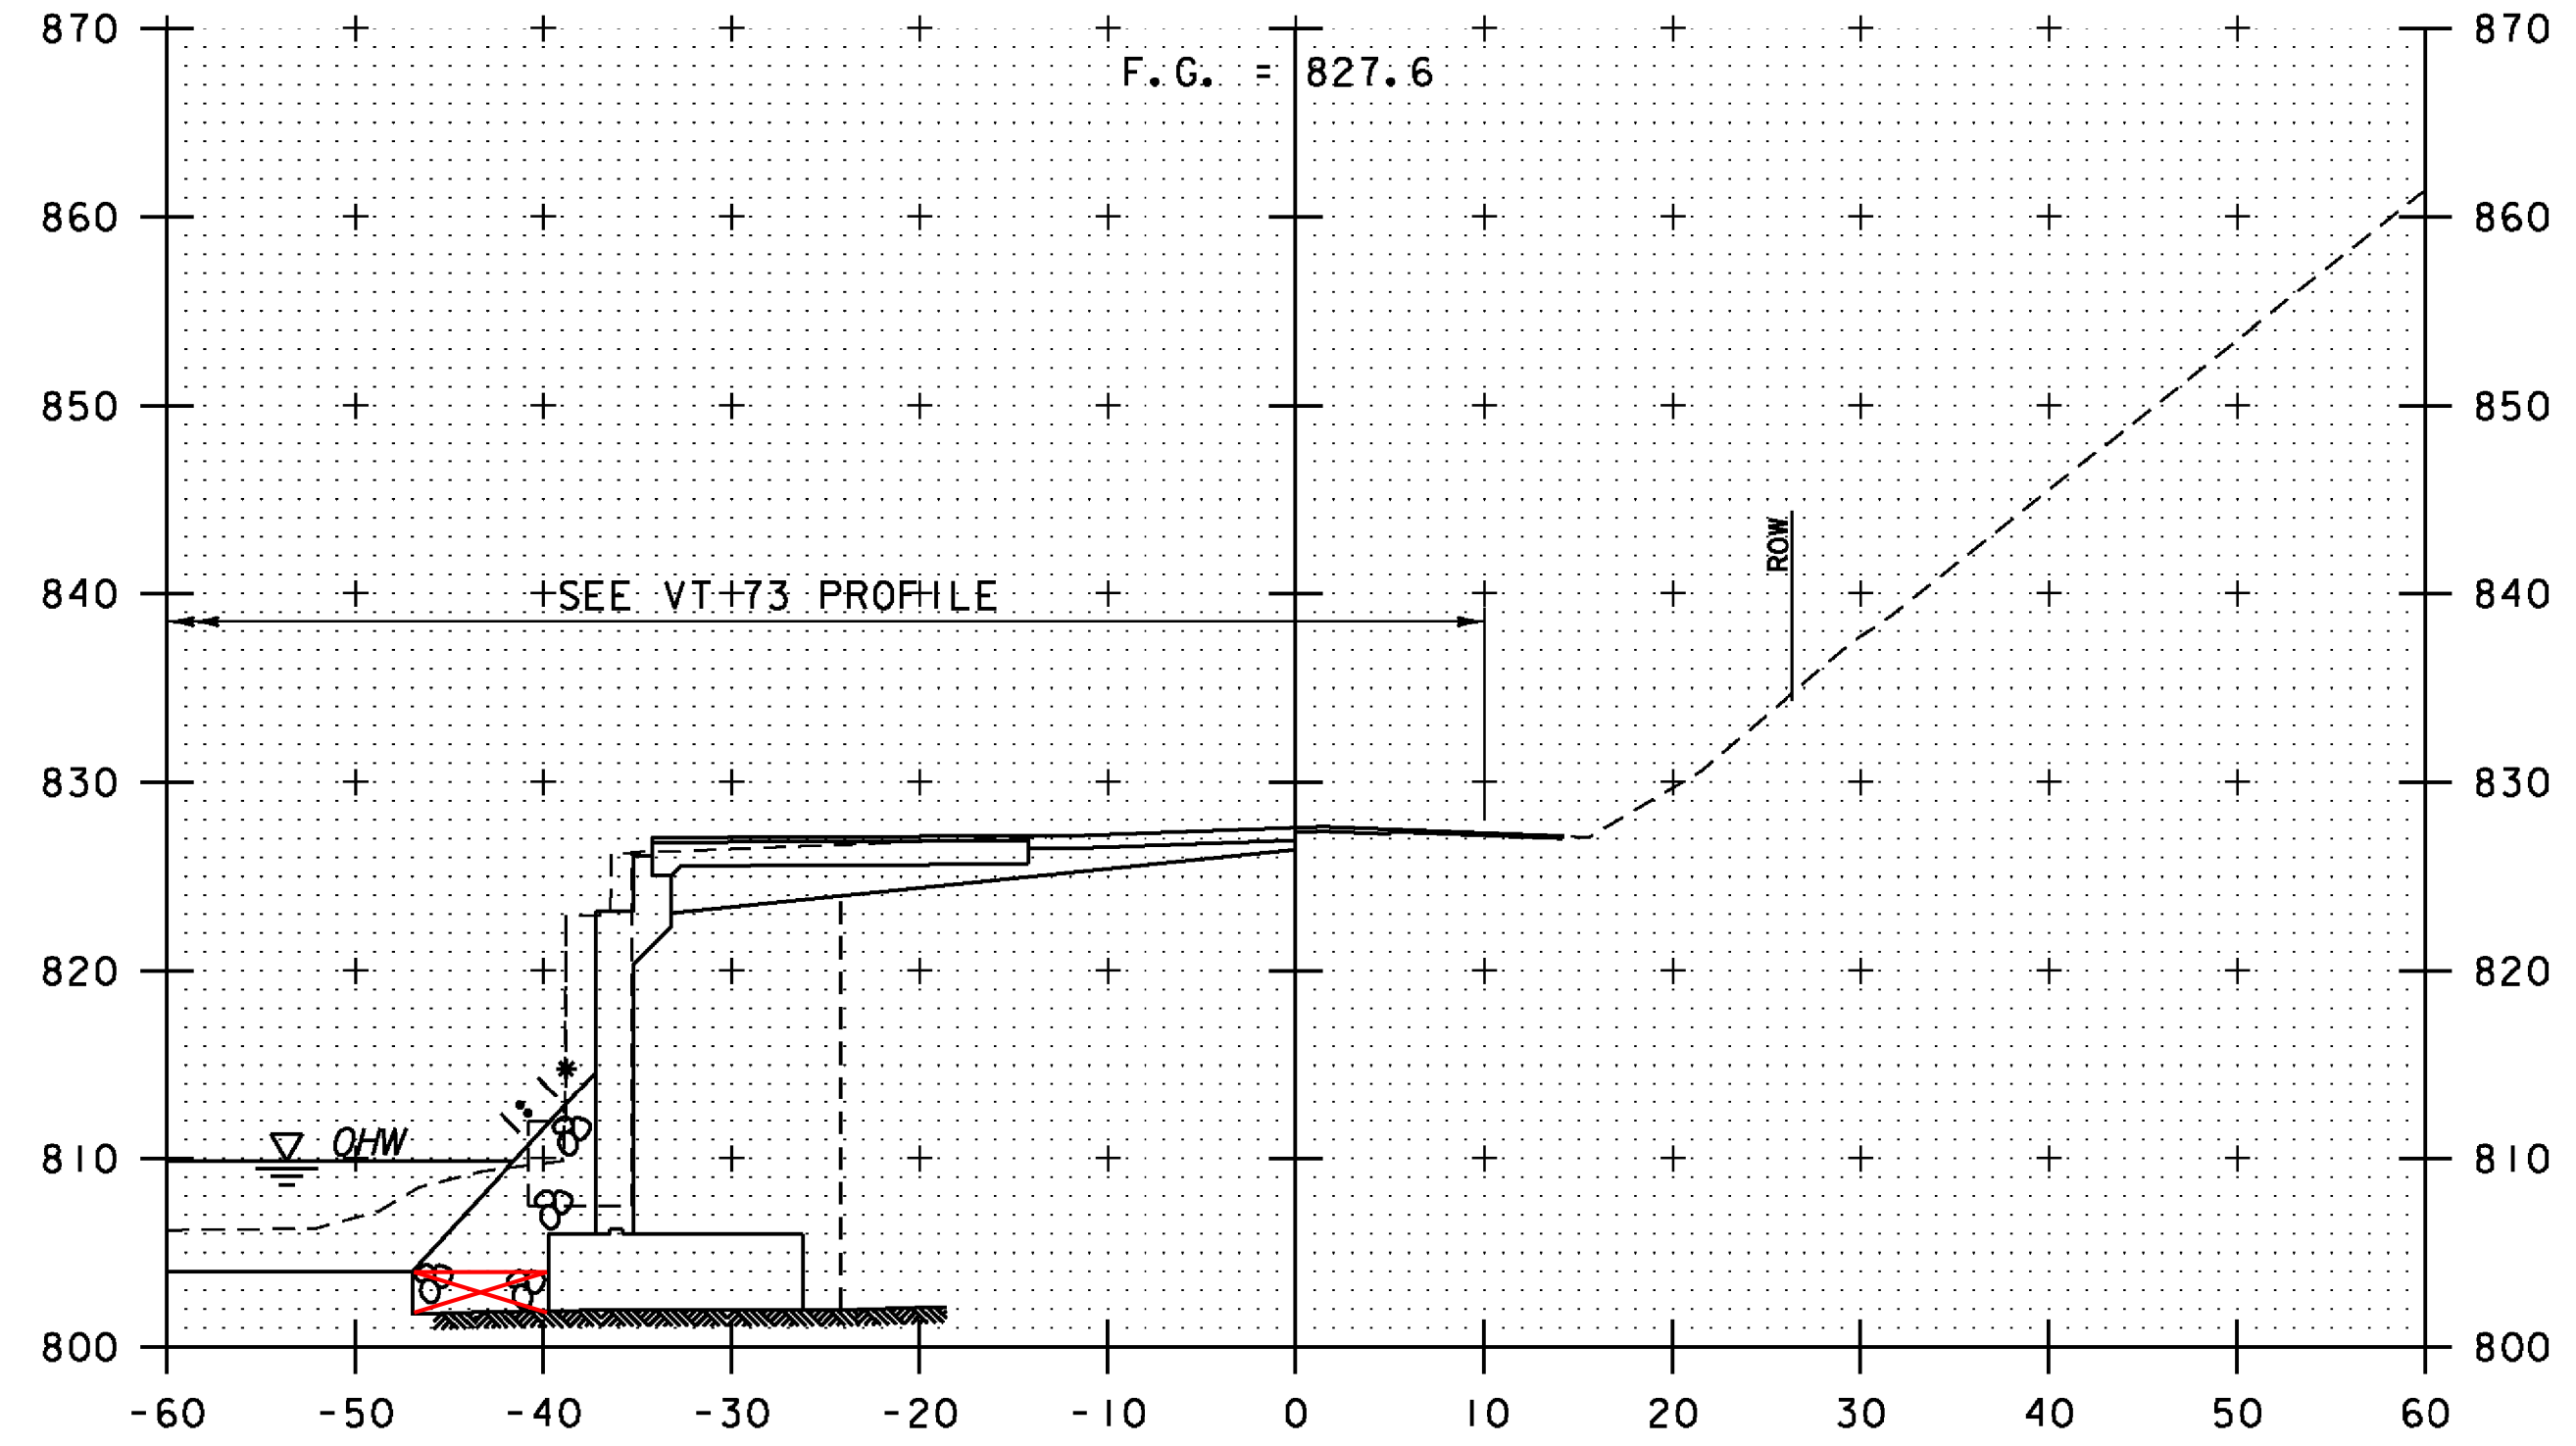

236+50

* - STONE FILL, TYPE III
MATCH EXISTING STONE SLOPE (TYP)

VT 100 CROSS SECTIONS

STA 236+00 TO STA 236+75

•SEE CHANNEL SECTIONS
FOR SUBFOOTING



PROJECT NAME:	ROCHESTER	FILE NAME:	zllc332xsl.dgn	PLOT DATE:	8/19/2013
PROJECT NUMBER:	ER BRF 0162(18)	PROJECT LEADER:	S.E. BURBANK	DRAWN BY:	C.L. CILLEY
		DESIGNED BY:	C.L. CILLEY	CHECKED BY:	D.M. PECK
			BR 19 VT 100 CROSS SECTIONS (2 OF 4)	SHEET	220 OF 238