




237+25
~~END APPROACH~~
~~STA 237+25~~

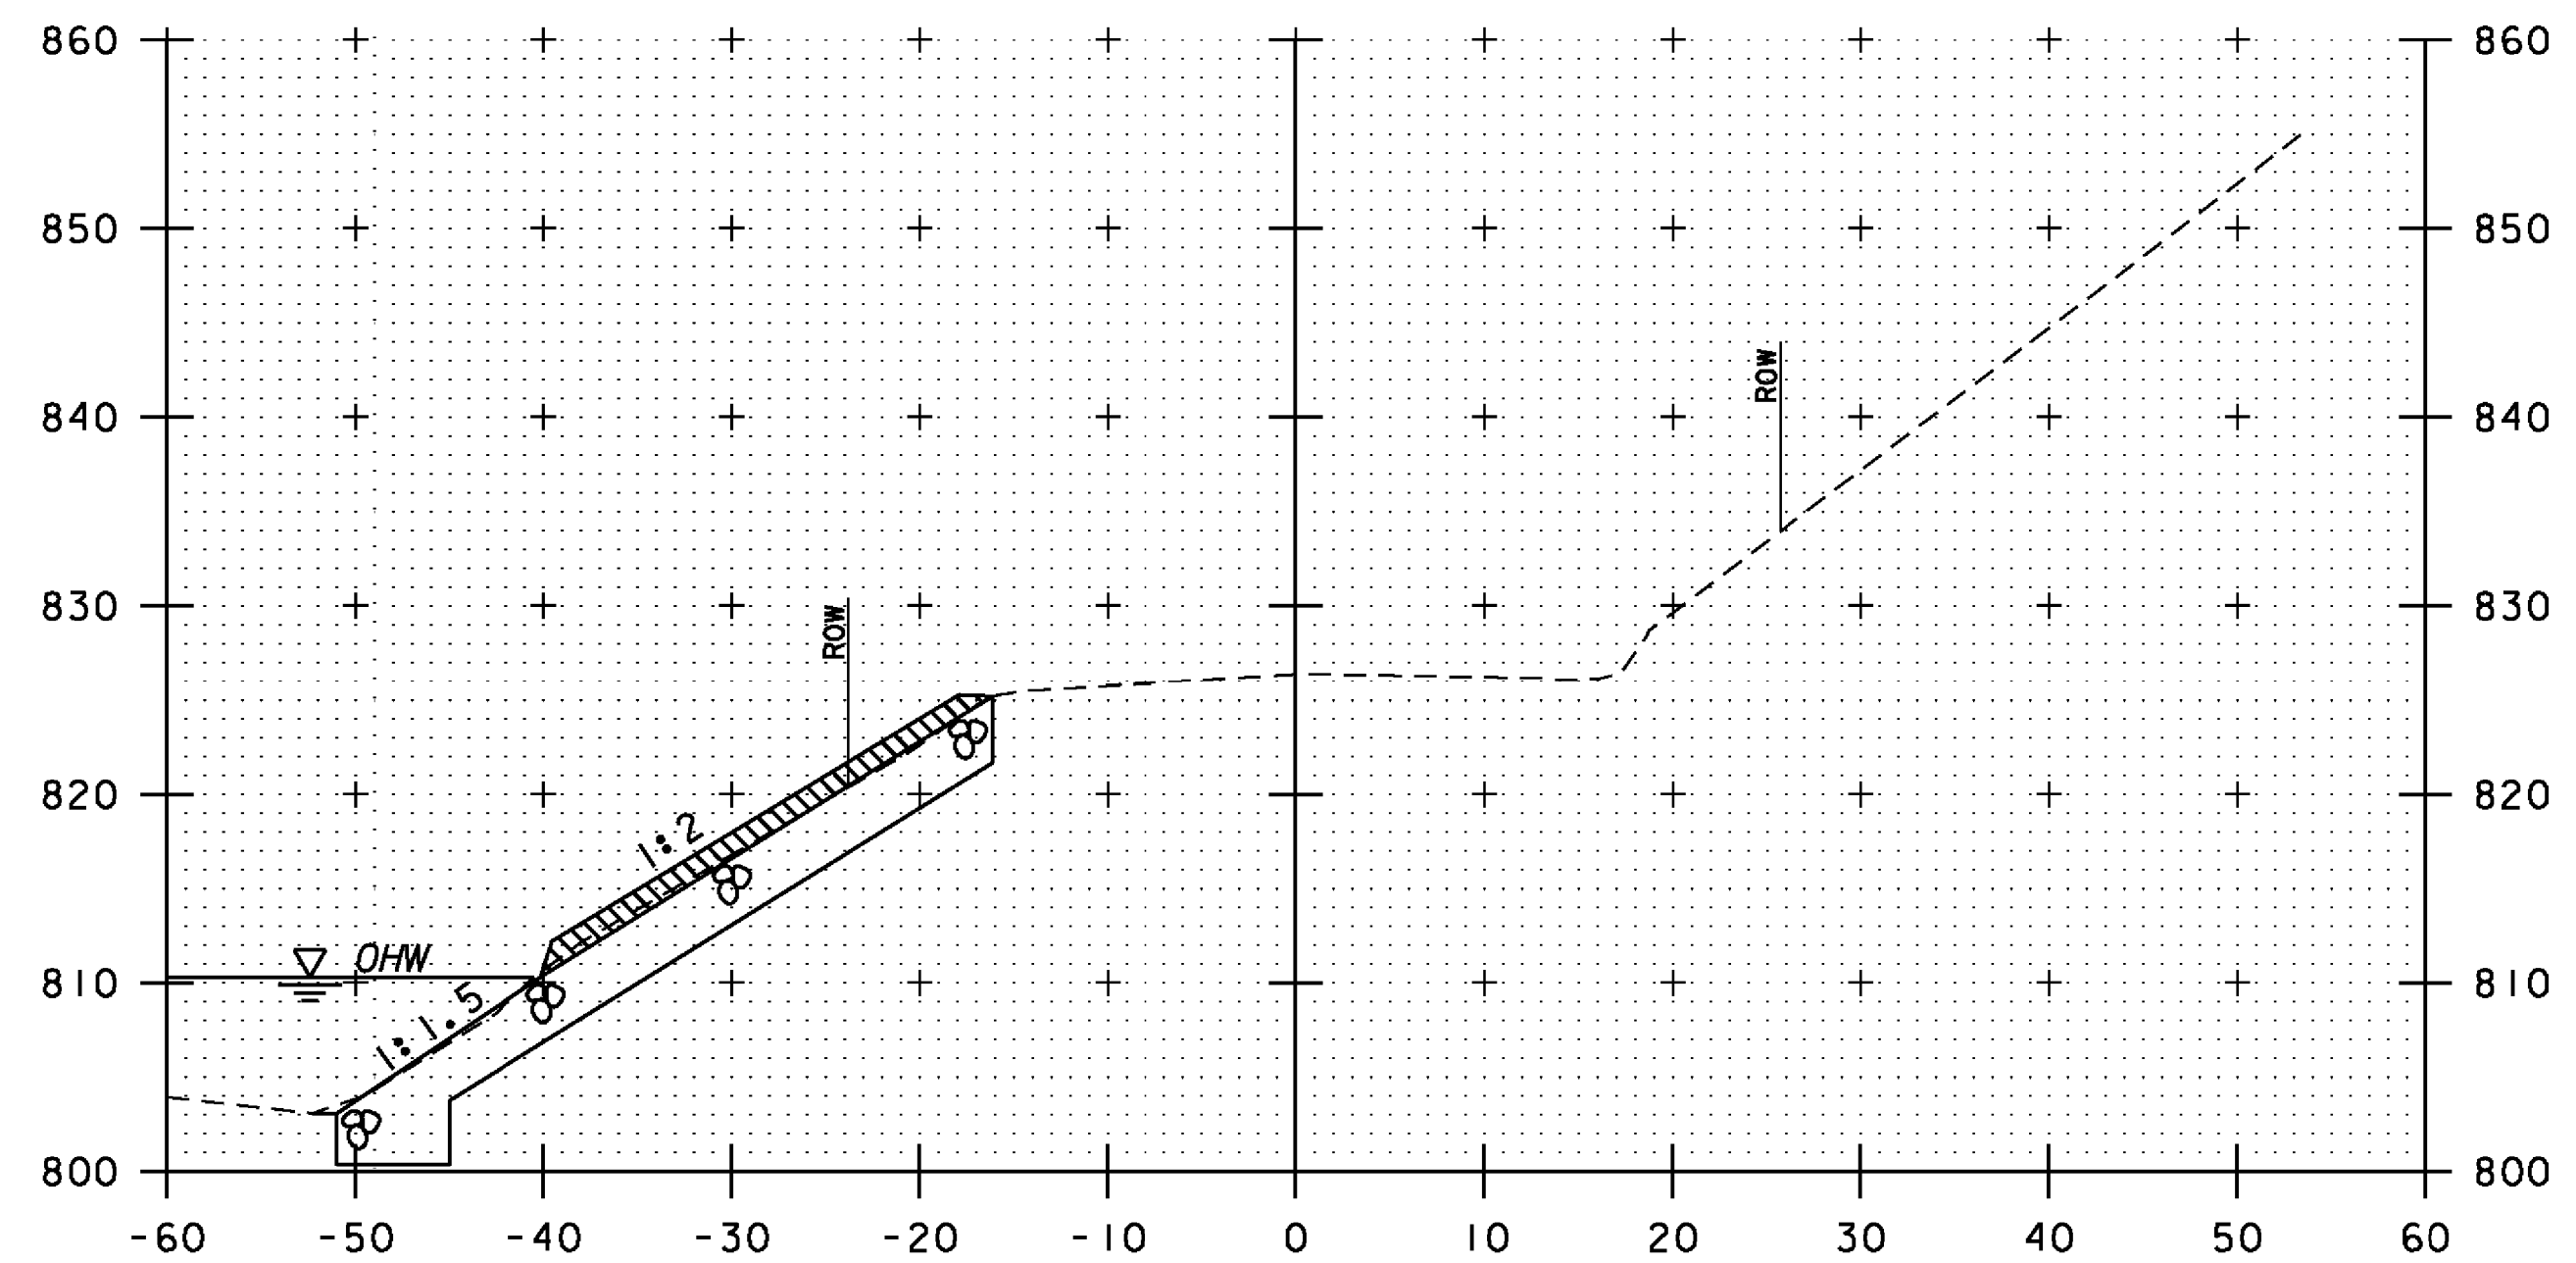

237+75

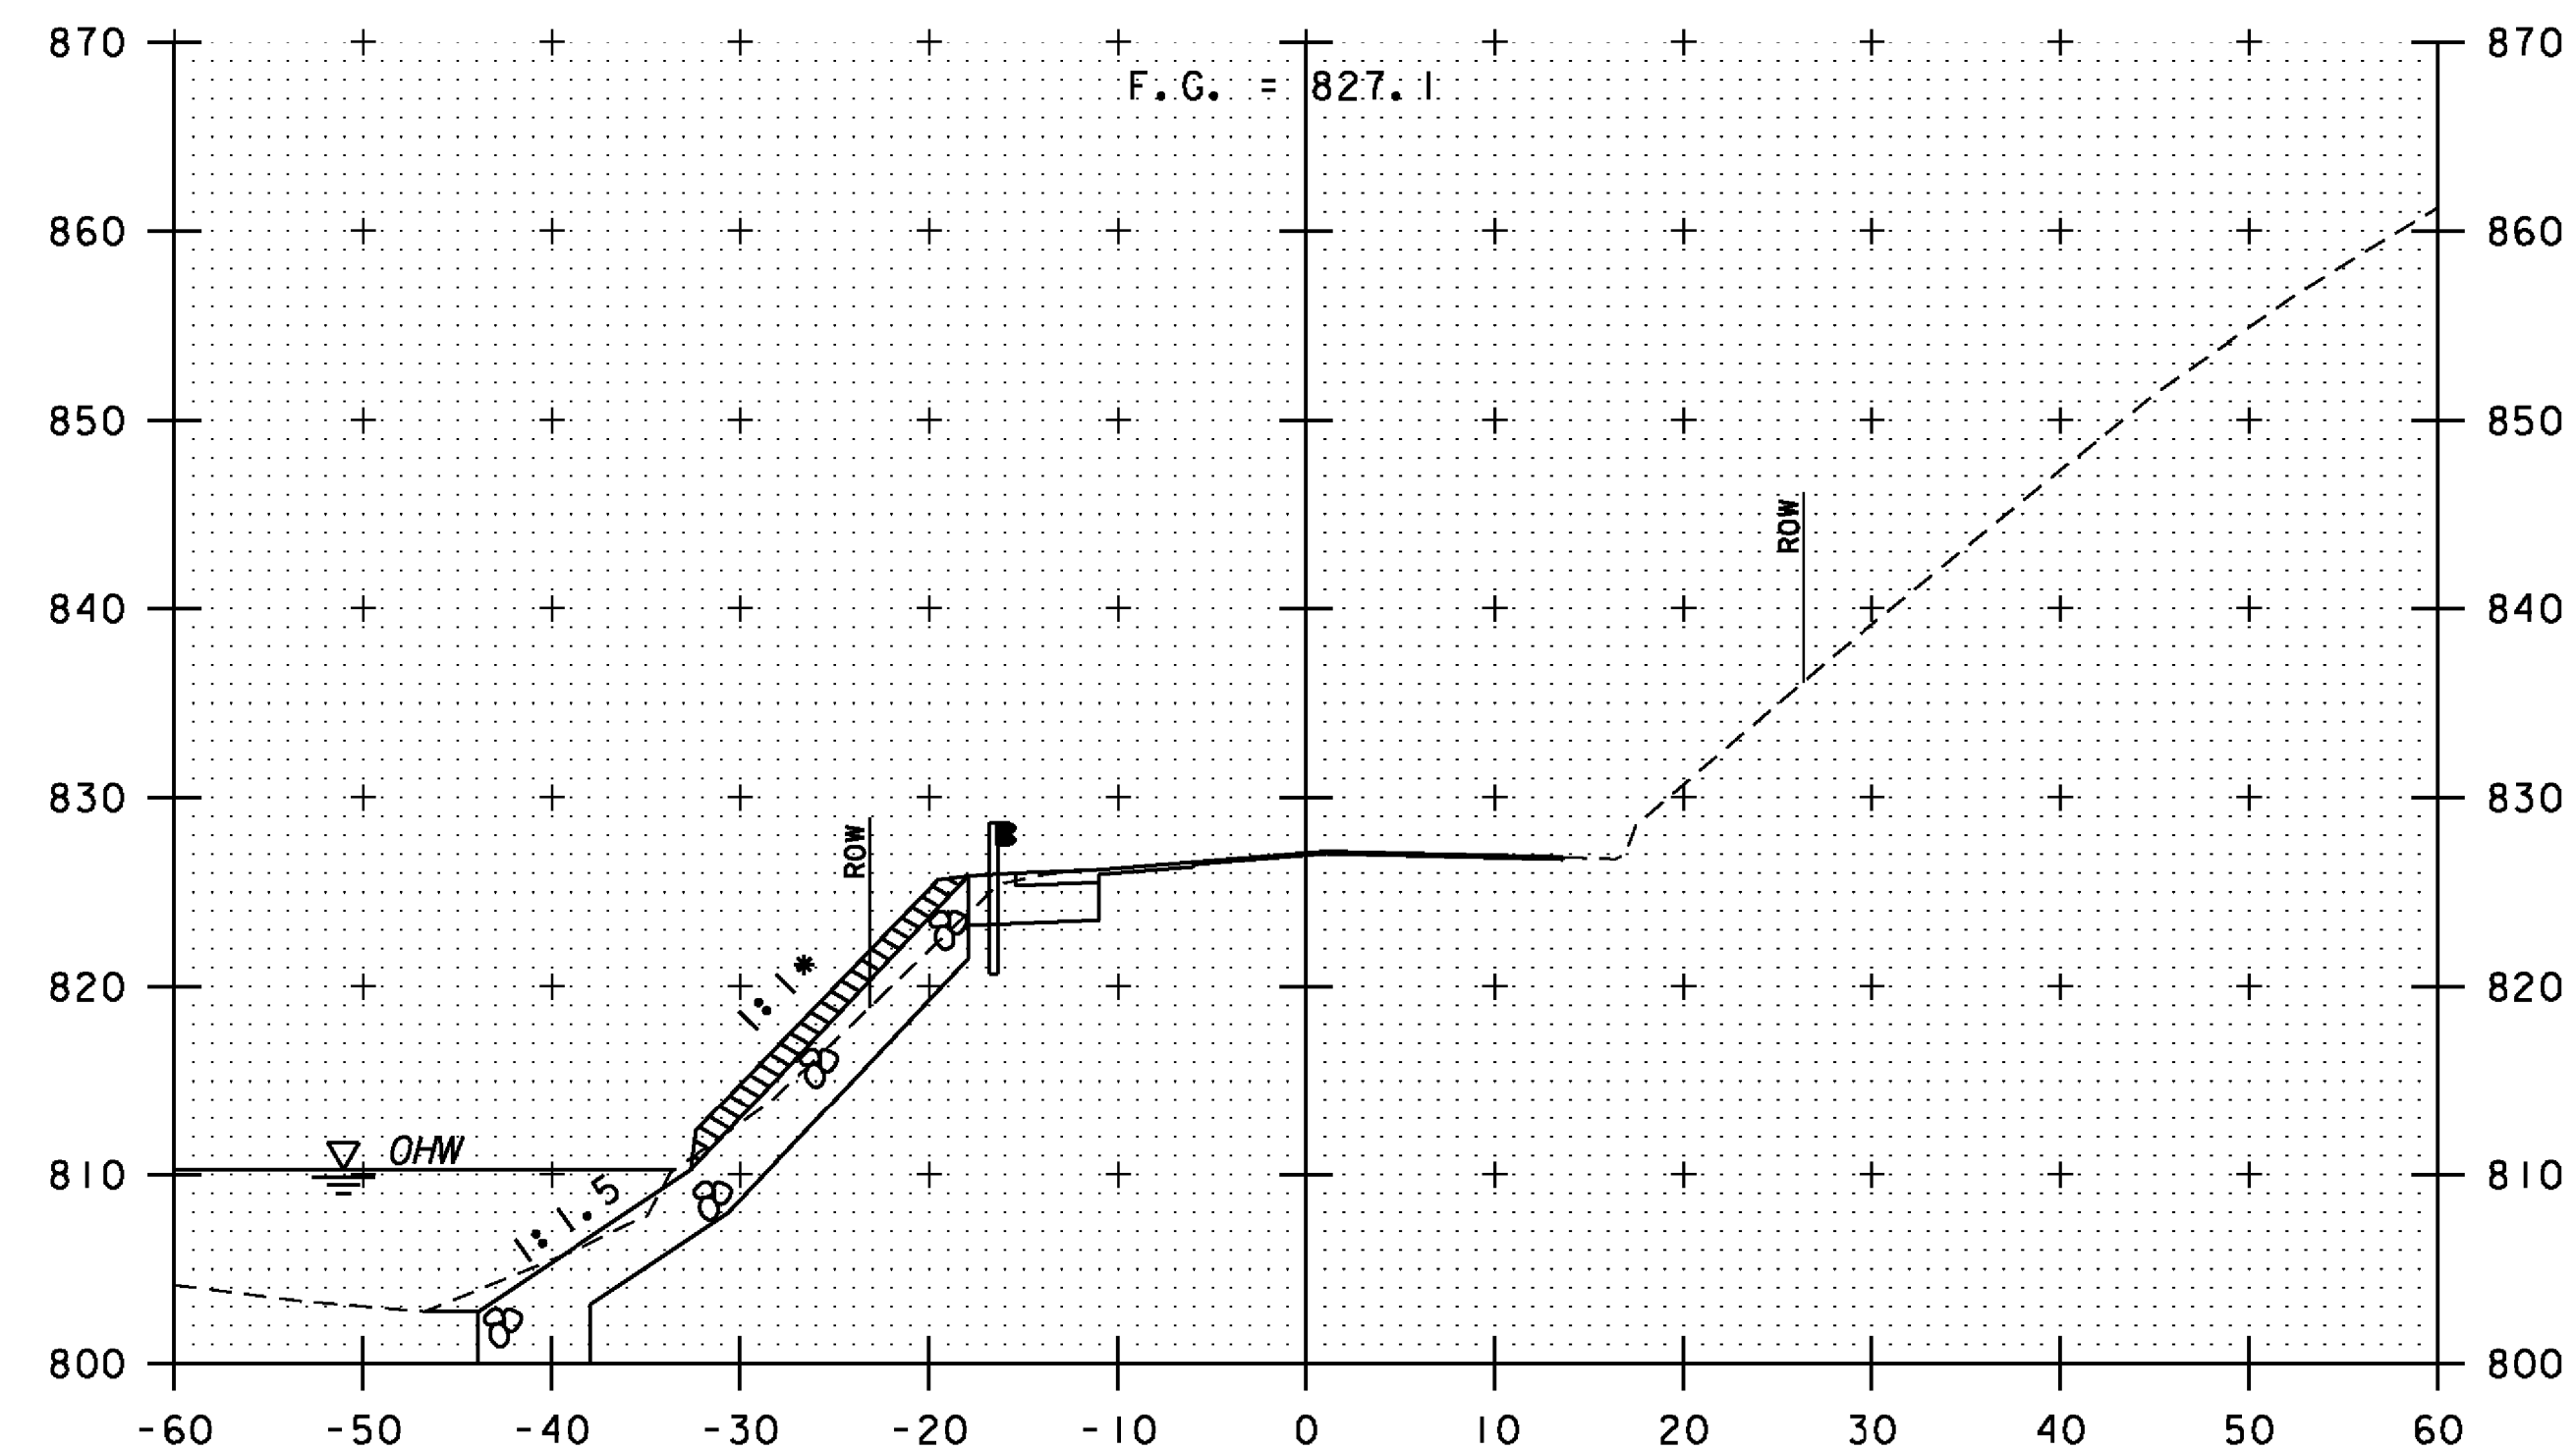

237+00

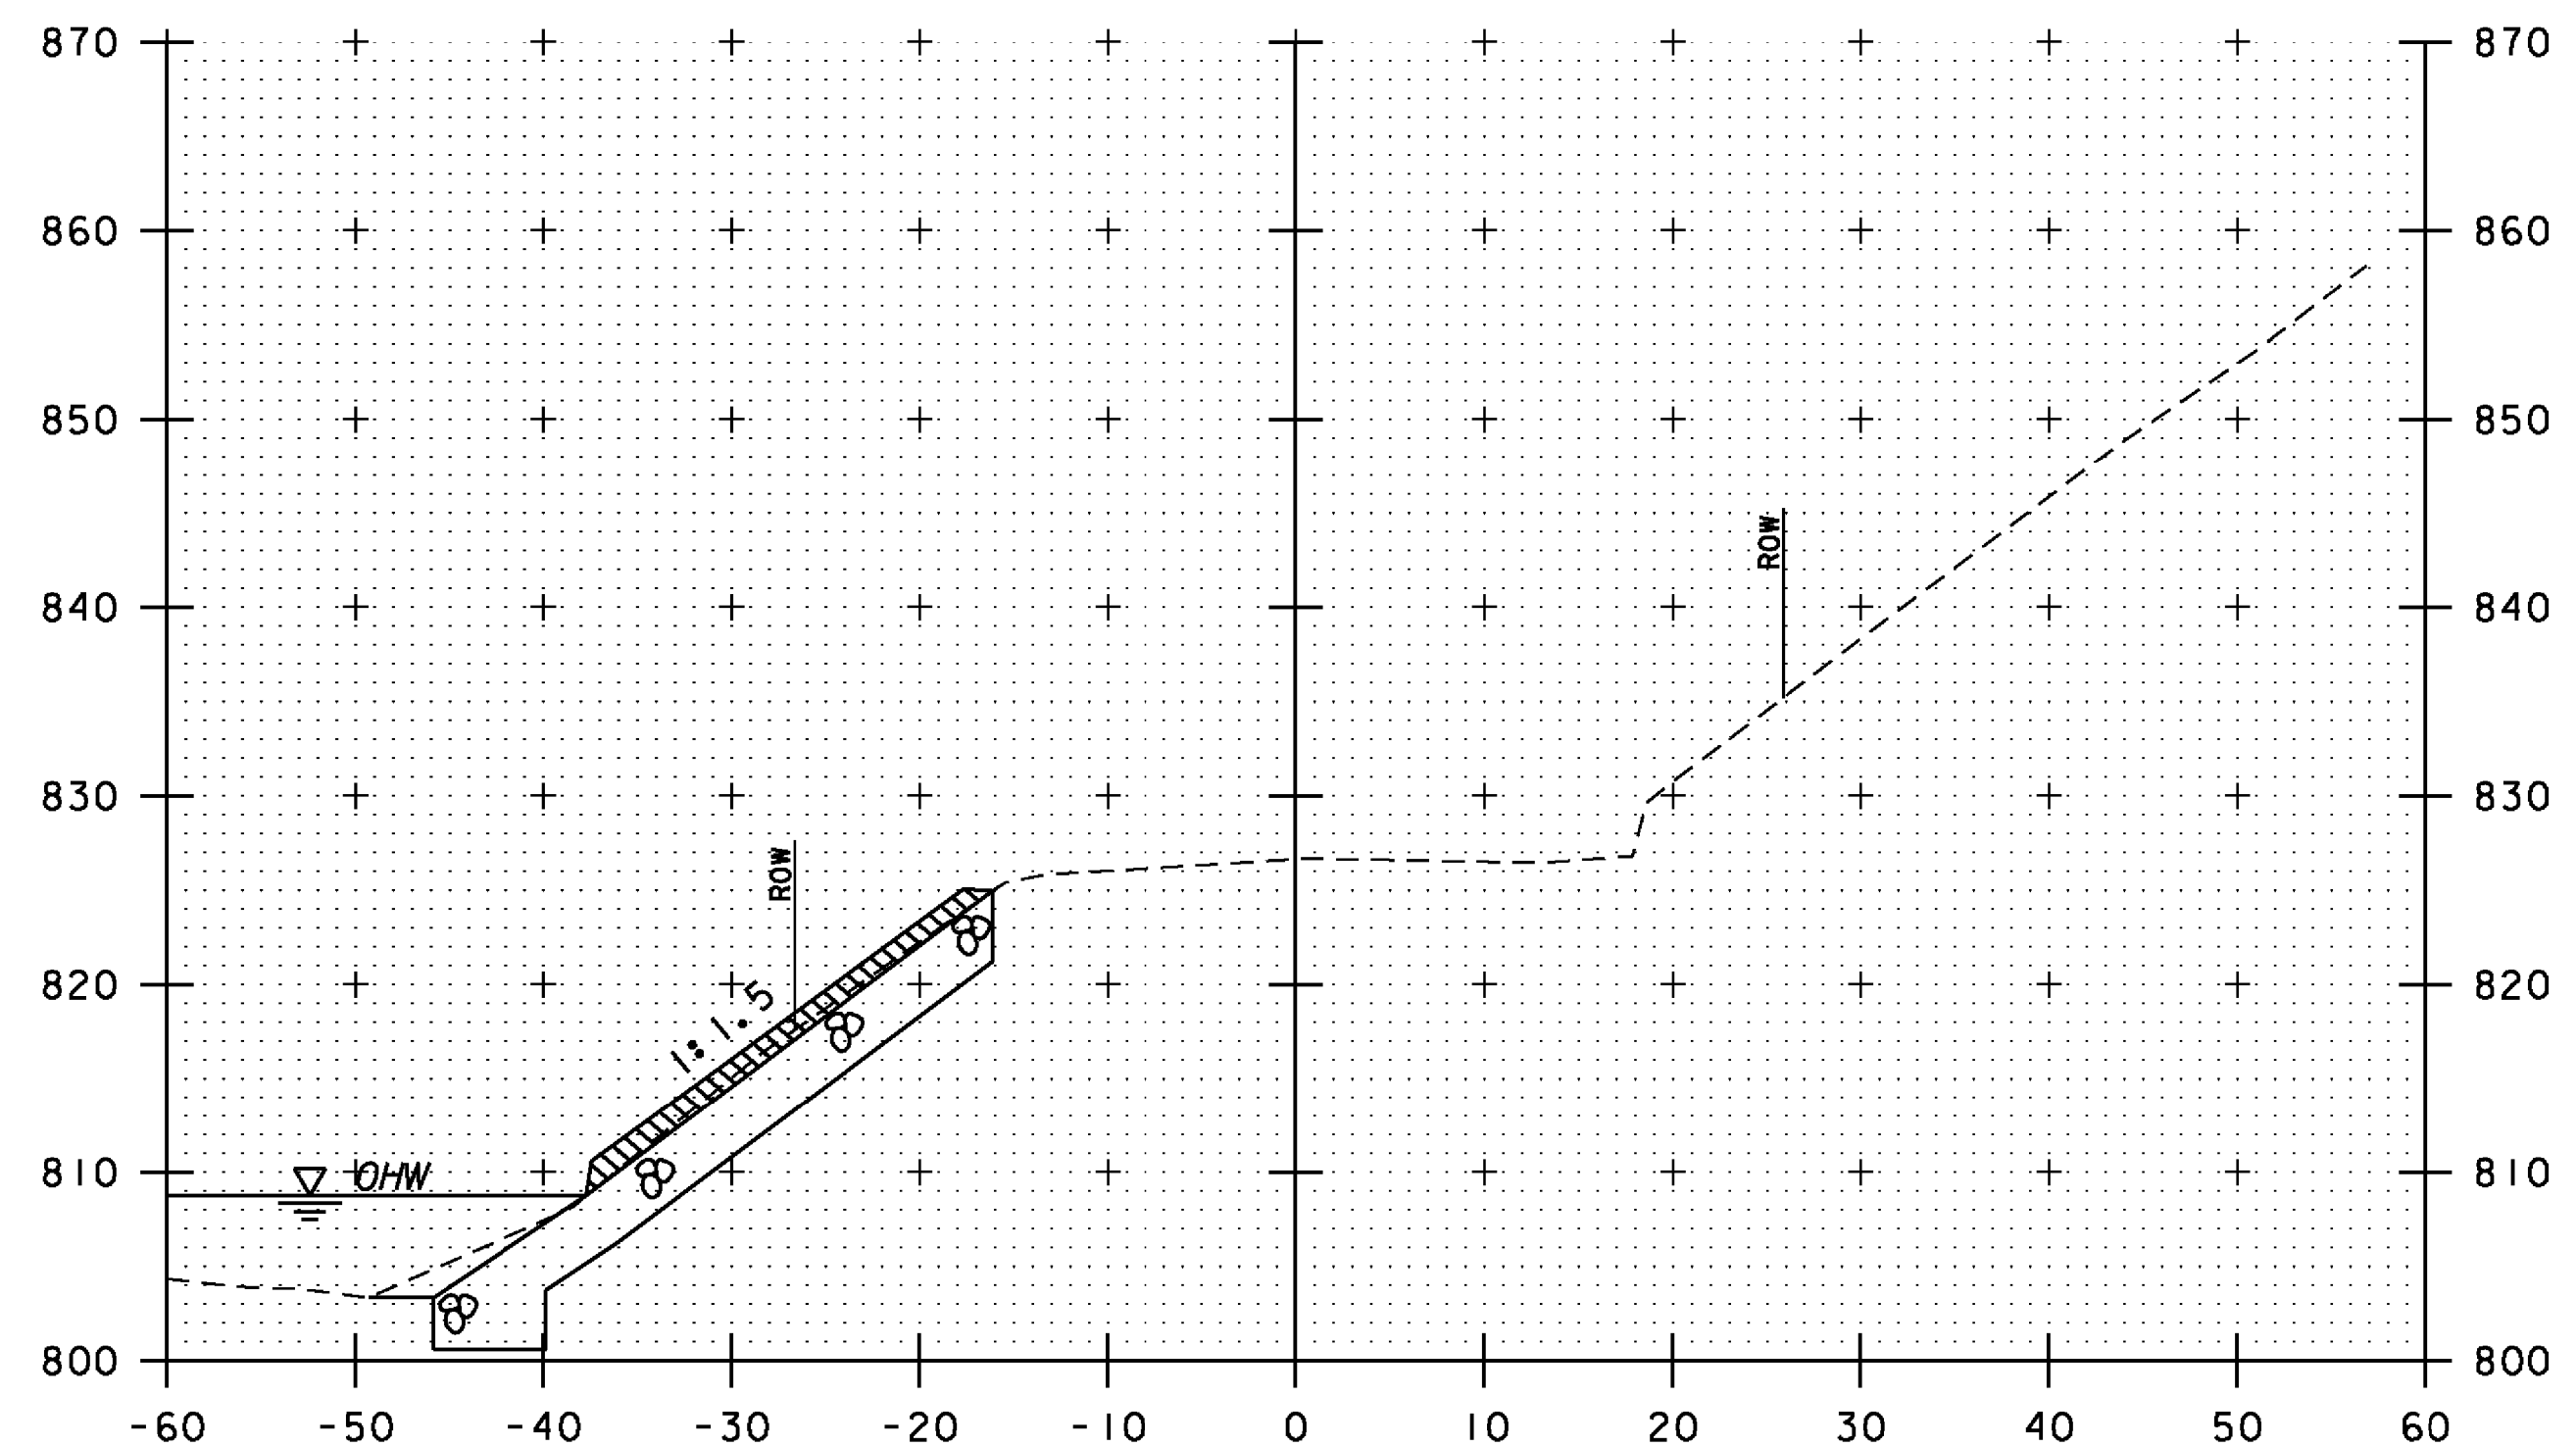

237+50

* - STONE FILL, TYPE III
 MATCH EXISTING STONE SLOPE (TYP)

VT 100 CROSS SECTIONS

STA 237+00 TO STA 237+75

END APPROACH
 237+70.00



PROJECT NAME: ROCHESTER	PLOT DATE: 8/19/2013
PROJECT NUMBER: ER BRF 0162(18)	DRAWN BY: C.L. CILLEY
FILE NAME: zllc332xsl.dgn	CHECKED BY: D.M. PECK
PROJECT LEADER: S.E. BURBANK	SHEET 221 OF 238
DESIGNED BY: C.L. CILLEY	
BR 19 VT 100 CROSS SECTIONS (3 OF 4)	