


238+20

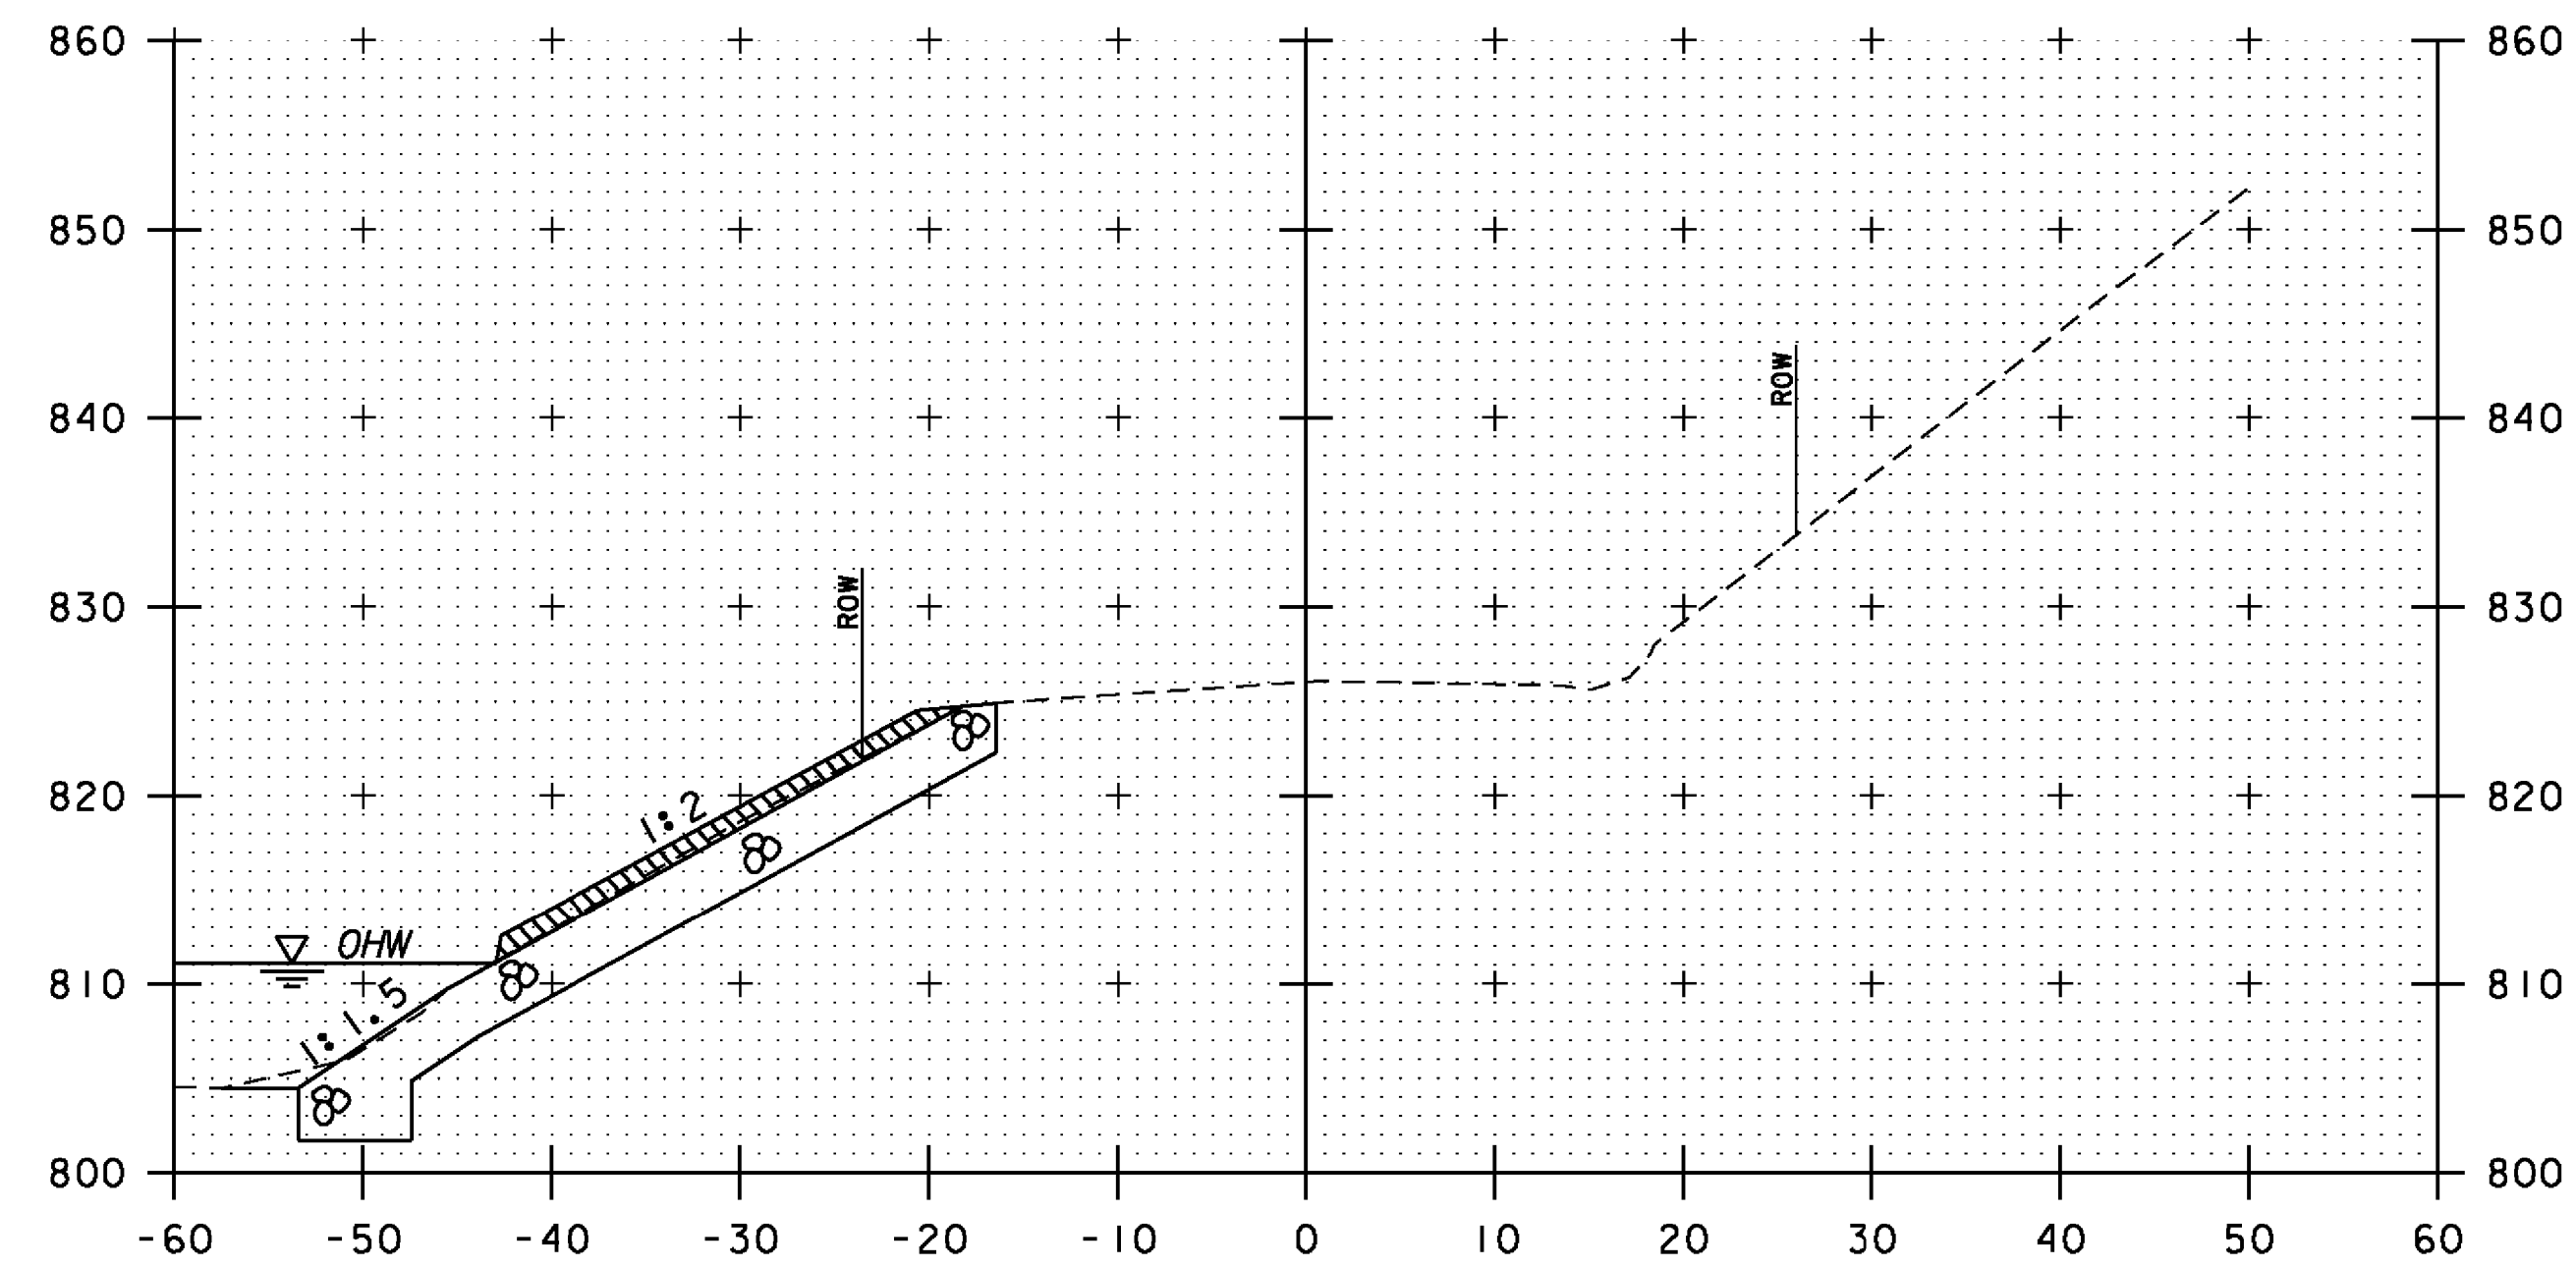

238+00

~~LIMIT OF WORK~~

VT 100 CROSS SECTIONS

STA 238+00 TO STA 238+20



PROJECT NAME: ROCHESTER	
PROJECT NUMBER: ER BRF 0162(18)	
FILE NAME: zllc332xsl.dgn	PLOT DATE: 8/19/2013
PROJECT LEADER: S.E. BURBANK	DRAWN BY: C.L. CILLEY
DESIGNED BY: C.L. CILLEY	CHECKED BY: D.M. PECK
BR 19 VT 100 CROSS SECTIONS (4 OF 4)	SHEET 222 OF 238