


207+75

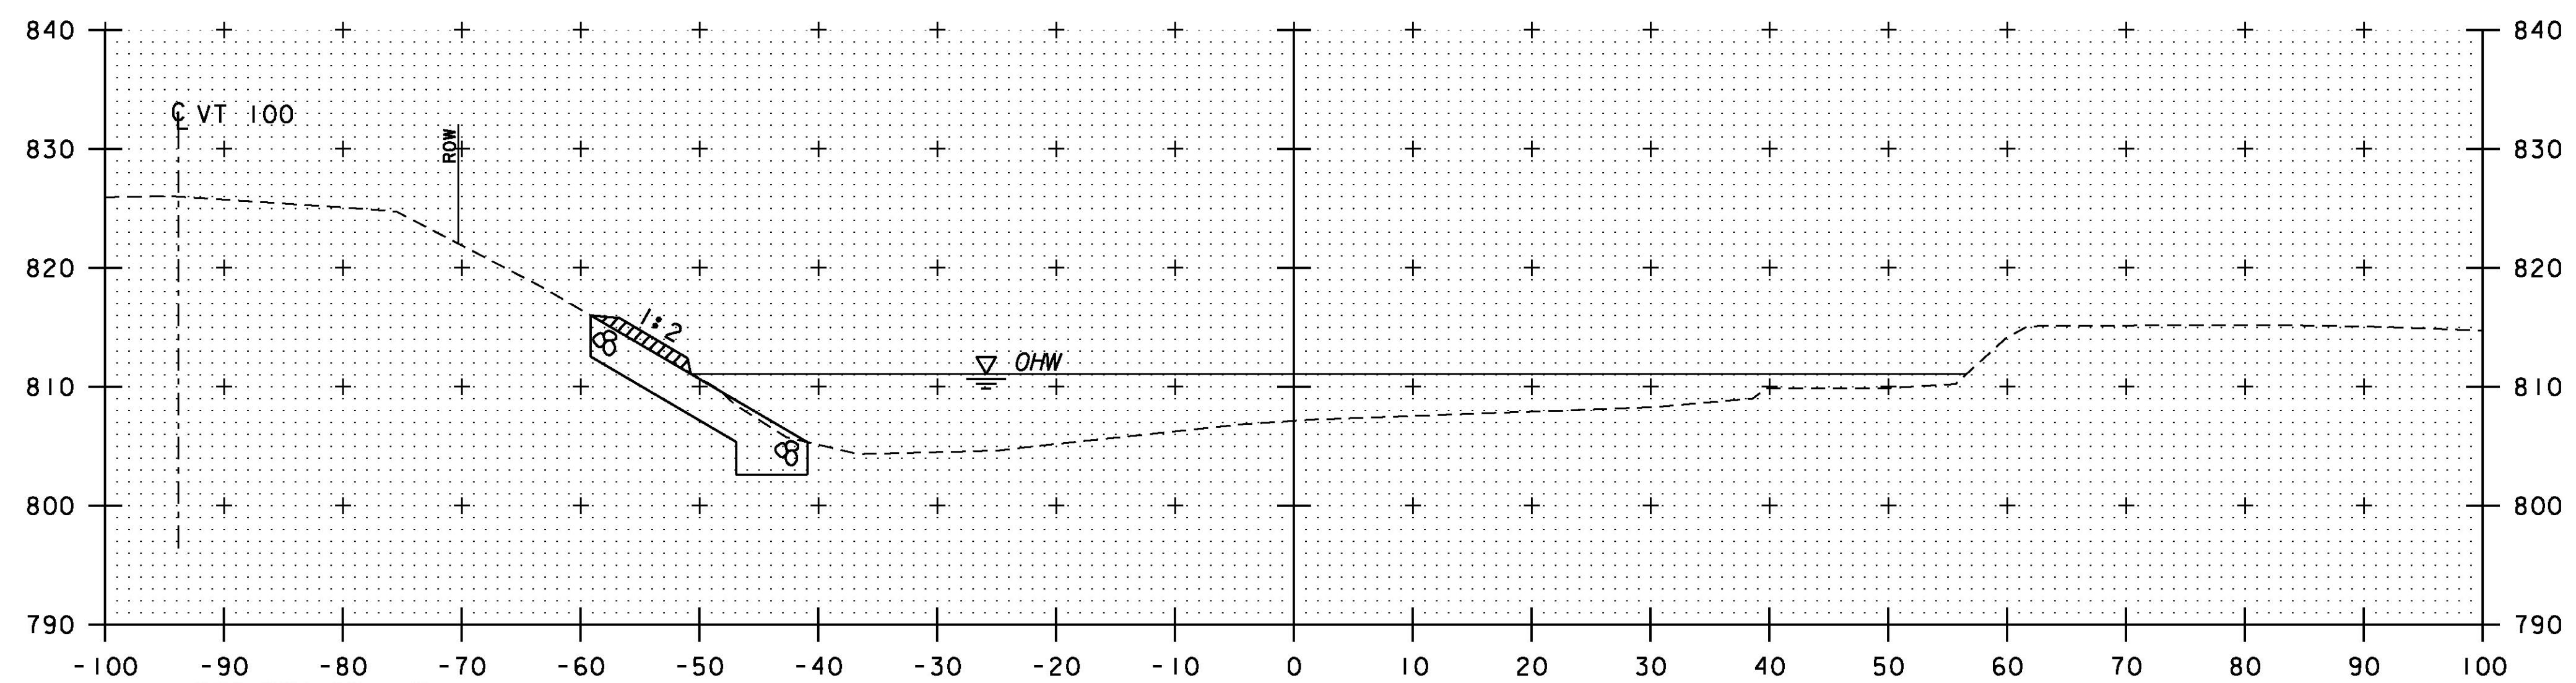

STA 207+48, LT
 BEGIN UNCLASSIFIED CHANNEL EXCAVATION
 GEOTEXTILE UNDER STONE FILL
 STONE FILL, TYPE III
 GRUBBING MATERIAL

207+50

CHANNEL CROSS SECTIONS

STA 207+50 TO STA 207+75



PROJECT NAME: ROCHESTER	PLOT DATE: 8/19/2013
PROJECT NUMBER: ER BRF 0162(18)	DRAWN BY: C.L. CILLEY
FILE NAME: zllc332xsl.dgn	CHECKED BY: G.S. GOODRICH
PROJECT LEADER: S.E. BURBANK	SHEET 223 OF 238
DESIGNED BY: C.L. CILLEY	
BR 19 CHANNEL CROSS SECTIONS (1 OF 6)	