


STA 209+23, LT
BEGIN GRUBBING MATERIAL

STA 209+24, RT
BEGIN GRUBBING MATERIAL

209+25

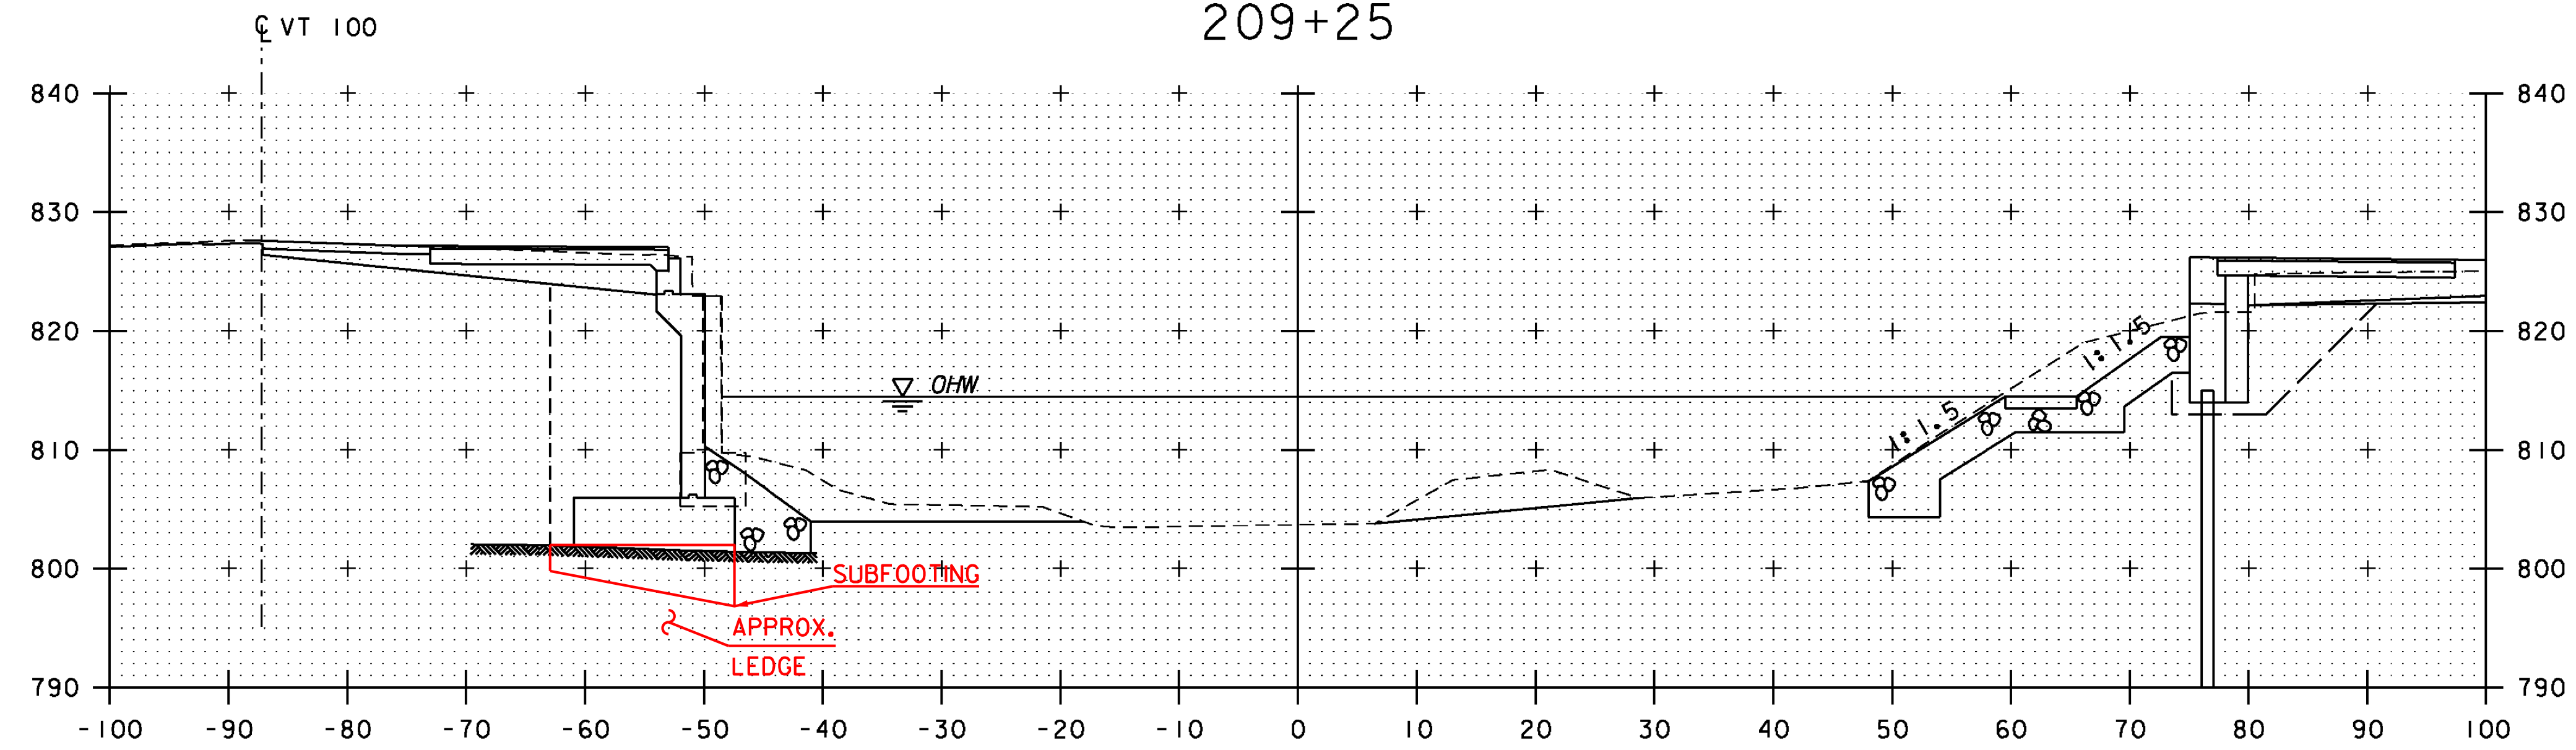

STA 208+87, LT
END GRUBBING MATERIAL

STA 208+90, RT
END GRUBBING MATERIAL

209+00

CHANNEL CROSS SECTIONS

STA 209+00 TO STA 209+25



PROJECT NAME: ROCHESTER	PLOT DATE: 8/19/2013
PROJECT NUMBER: ER BRF 0162(18)	DRAWN BY: C.L. CILLEY
FILE NAME: zllc332xsl.dgn	CHECKED BY: G.S. GOODRICH
PROJECT LEADER: S.E. BURBANK	DESIGNED BY: C.L. CILLEY
BR 19 CHANNEL CROSS SECTIONS (4 OF 6)	SHEET 226 OF 238