


STA 209+60, RT  
END BENCH

2" AGGREGATE SURFACE COURSE  
4" SUBBASE OF DENSE GRADED CRUSHED STONE  
GEOTEXTILE UNDER STONE FILL

STA 209+62, RT  
END

UNCLASSIFIED CHANNEL EXCAVATION  
GEOTEXTILE UNDER STONE FILL  
STONE FILL, TYPE II  
GRUBBING MATERIAL

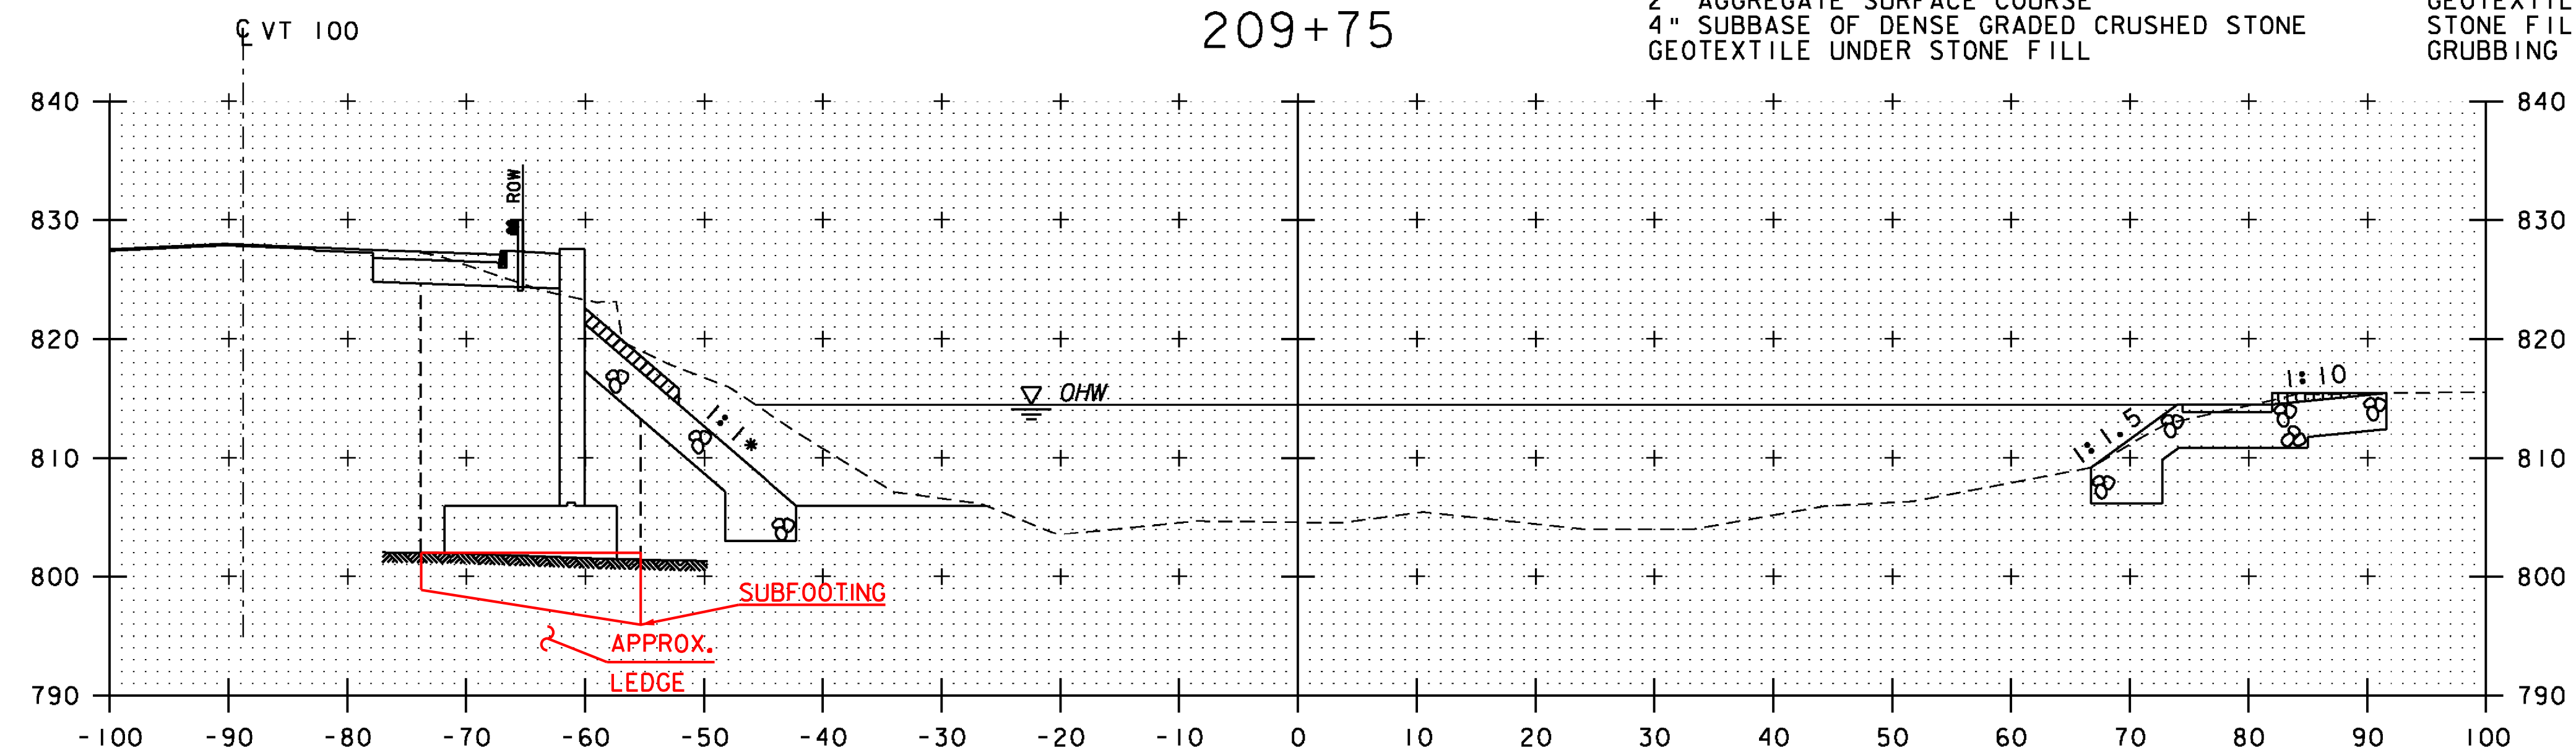

209+50

CHANNEL CROSS SECTIONS

STA 209+50 TO STA 209+75

\* - STONE FILL, TYPE III  
MATCH EXISTING STONE SLOPE (TYP)

PROJECT NAME: ROCHESTER  
PROJECT NUMBER: ER BRF 0162(18)

FILE NAME: zllc332xsl.dgn  
PROJECT LEADER: S.E. BURBANK  
DESIGNED BY: C.L. CILLEY  
BR 19 CHANNEL CROSS SECTIONS (5 OF 6)

PLOT DATE: 8/19/2013  
DRAWN BY: C.L. CILLEY  
CHECKED BY: G.S. GOODRICH  
SHEET 227 OF 238

