


~~STA 210+21, LT
 END UNCLASSIFIED CHANNEL EXCAVATION
 GEOTEXTILE UNDER STONE FILL
 STONE FILL, TYPE III
 GRUBBING MATERIAL~~

SEE ROUTE 100 AS BUILT
 FOR EXTENDED STONE FILL

210+25

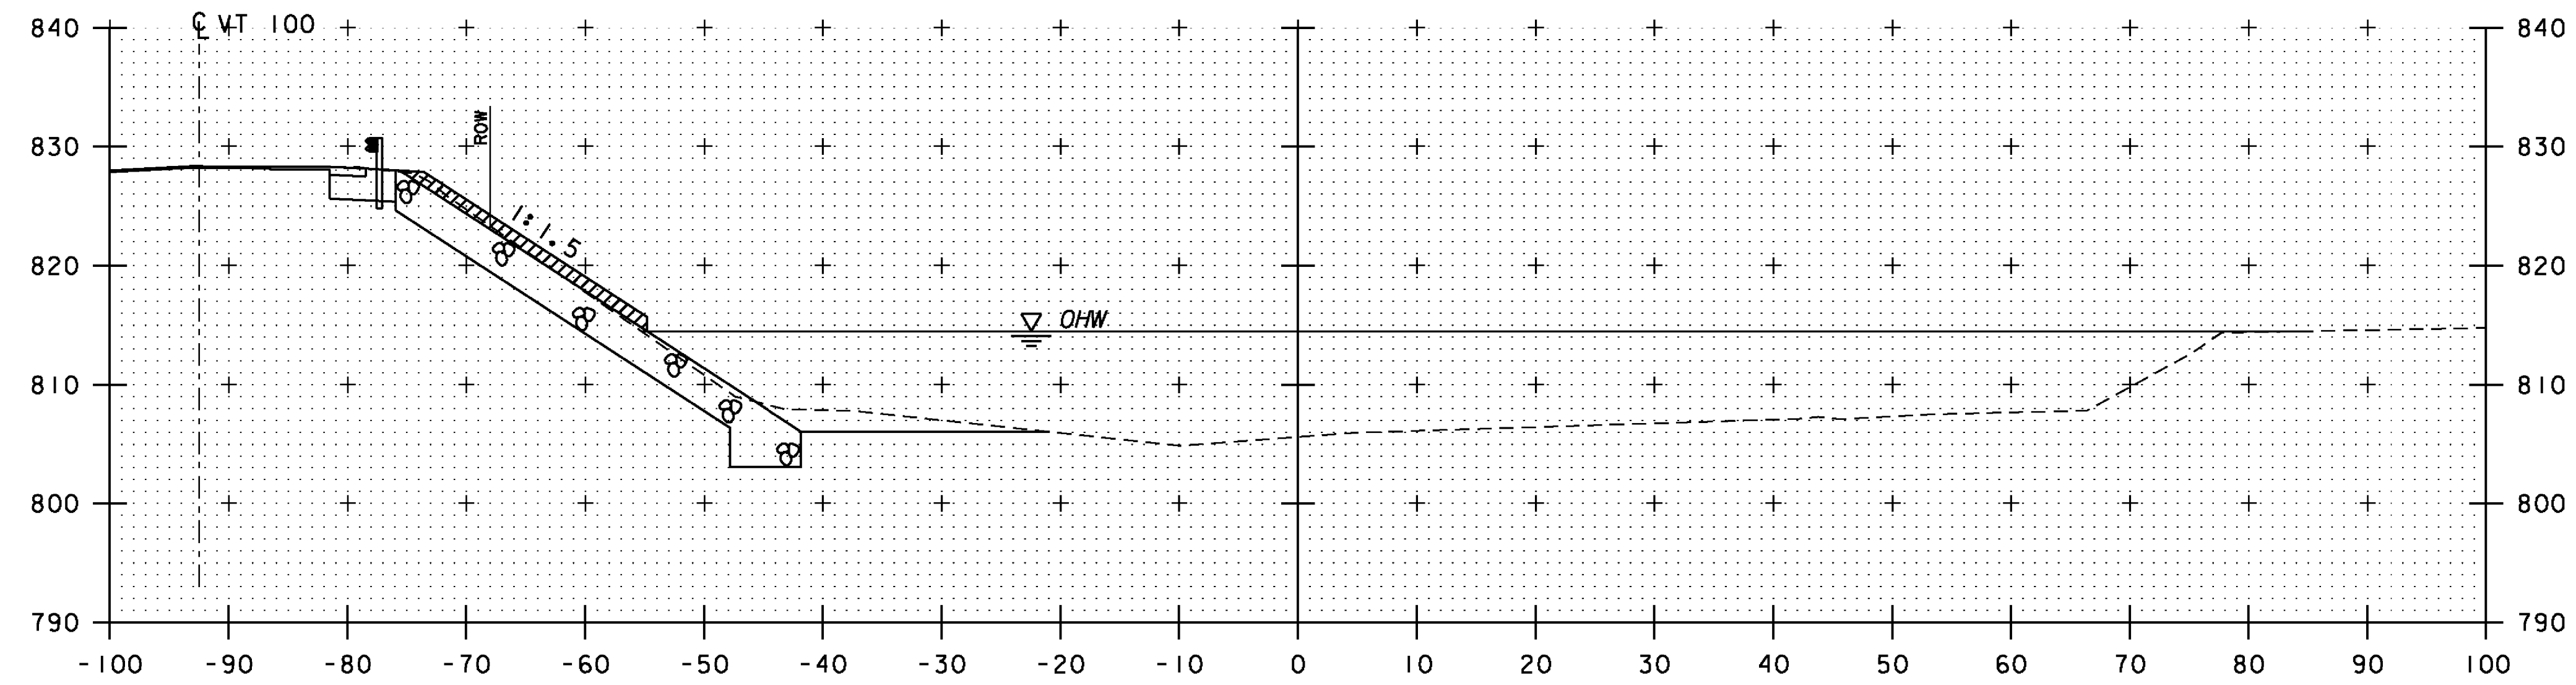

* - STONE FILL, TYPE III
MATCH EXISTING STONE SLOPE (TYP)

210+00

CHANNEL CROSS SECTIONS

STA 210+00 TO STA 210+25



PROJECT NAME: ROCHESTER	PLOT DATE: 8/19/2013
PROJECT NUMBER: ER BRF 0162(18)	DRAWN BY: C.L. CILLEY
FILE NAME: zllc332xsl.dgn	CHECKED BY: G.S. GOODRICH
PROJECT LEADER: S.E. BURBANK	BR 19 CHANNEL CROSS SECTIONS (6 OF 6)
DESIGNED BY: C.L. CILLEY	SHEET 228 OF 238