



NOTE: SEE BR 19 EROSION CONTROL
DETAILS FOR SYMBOLLOGY

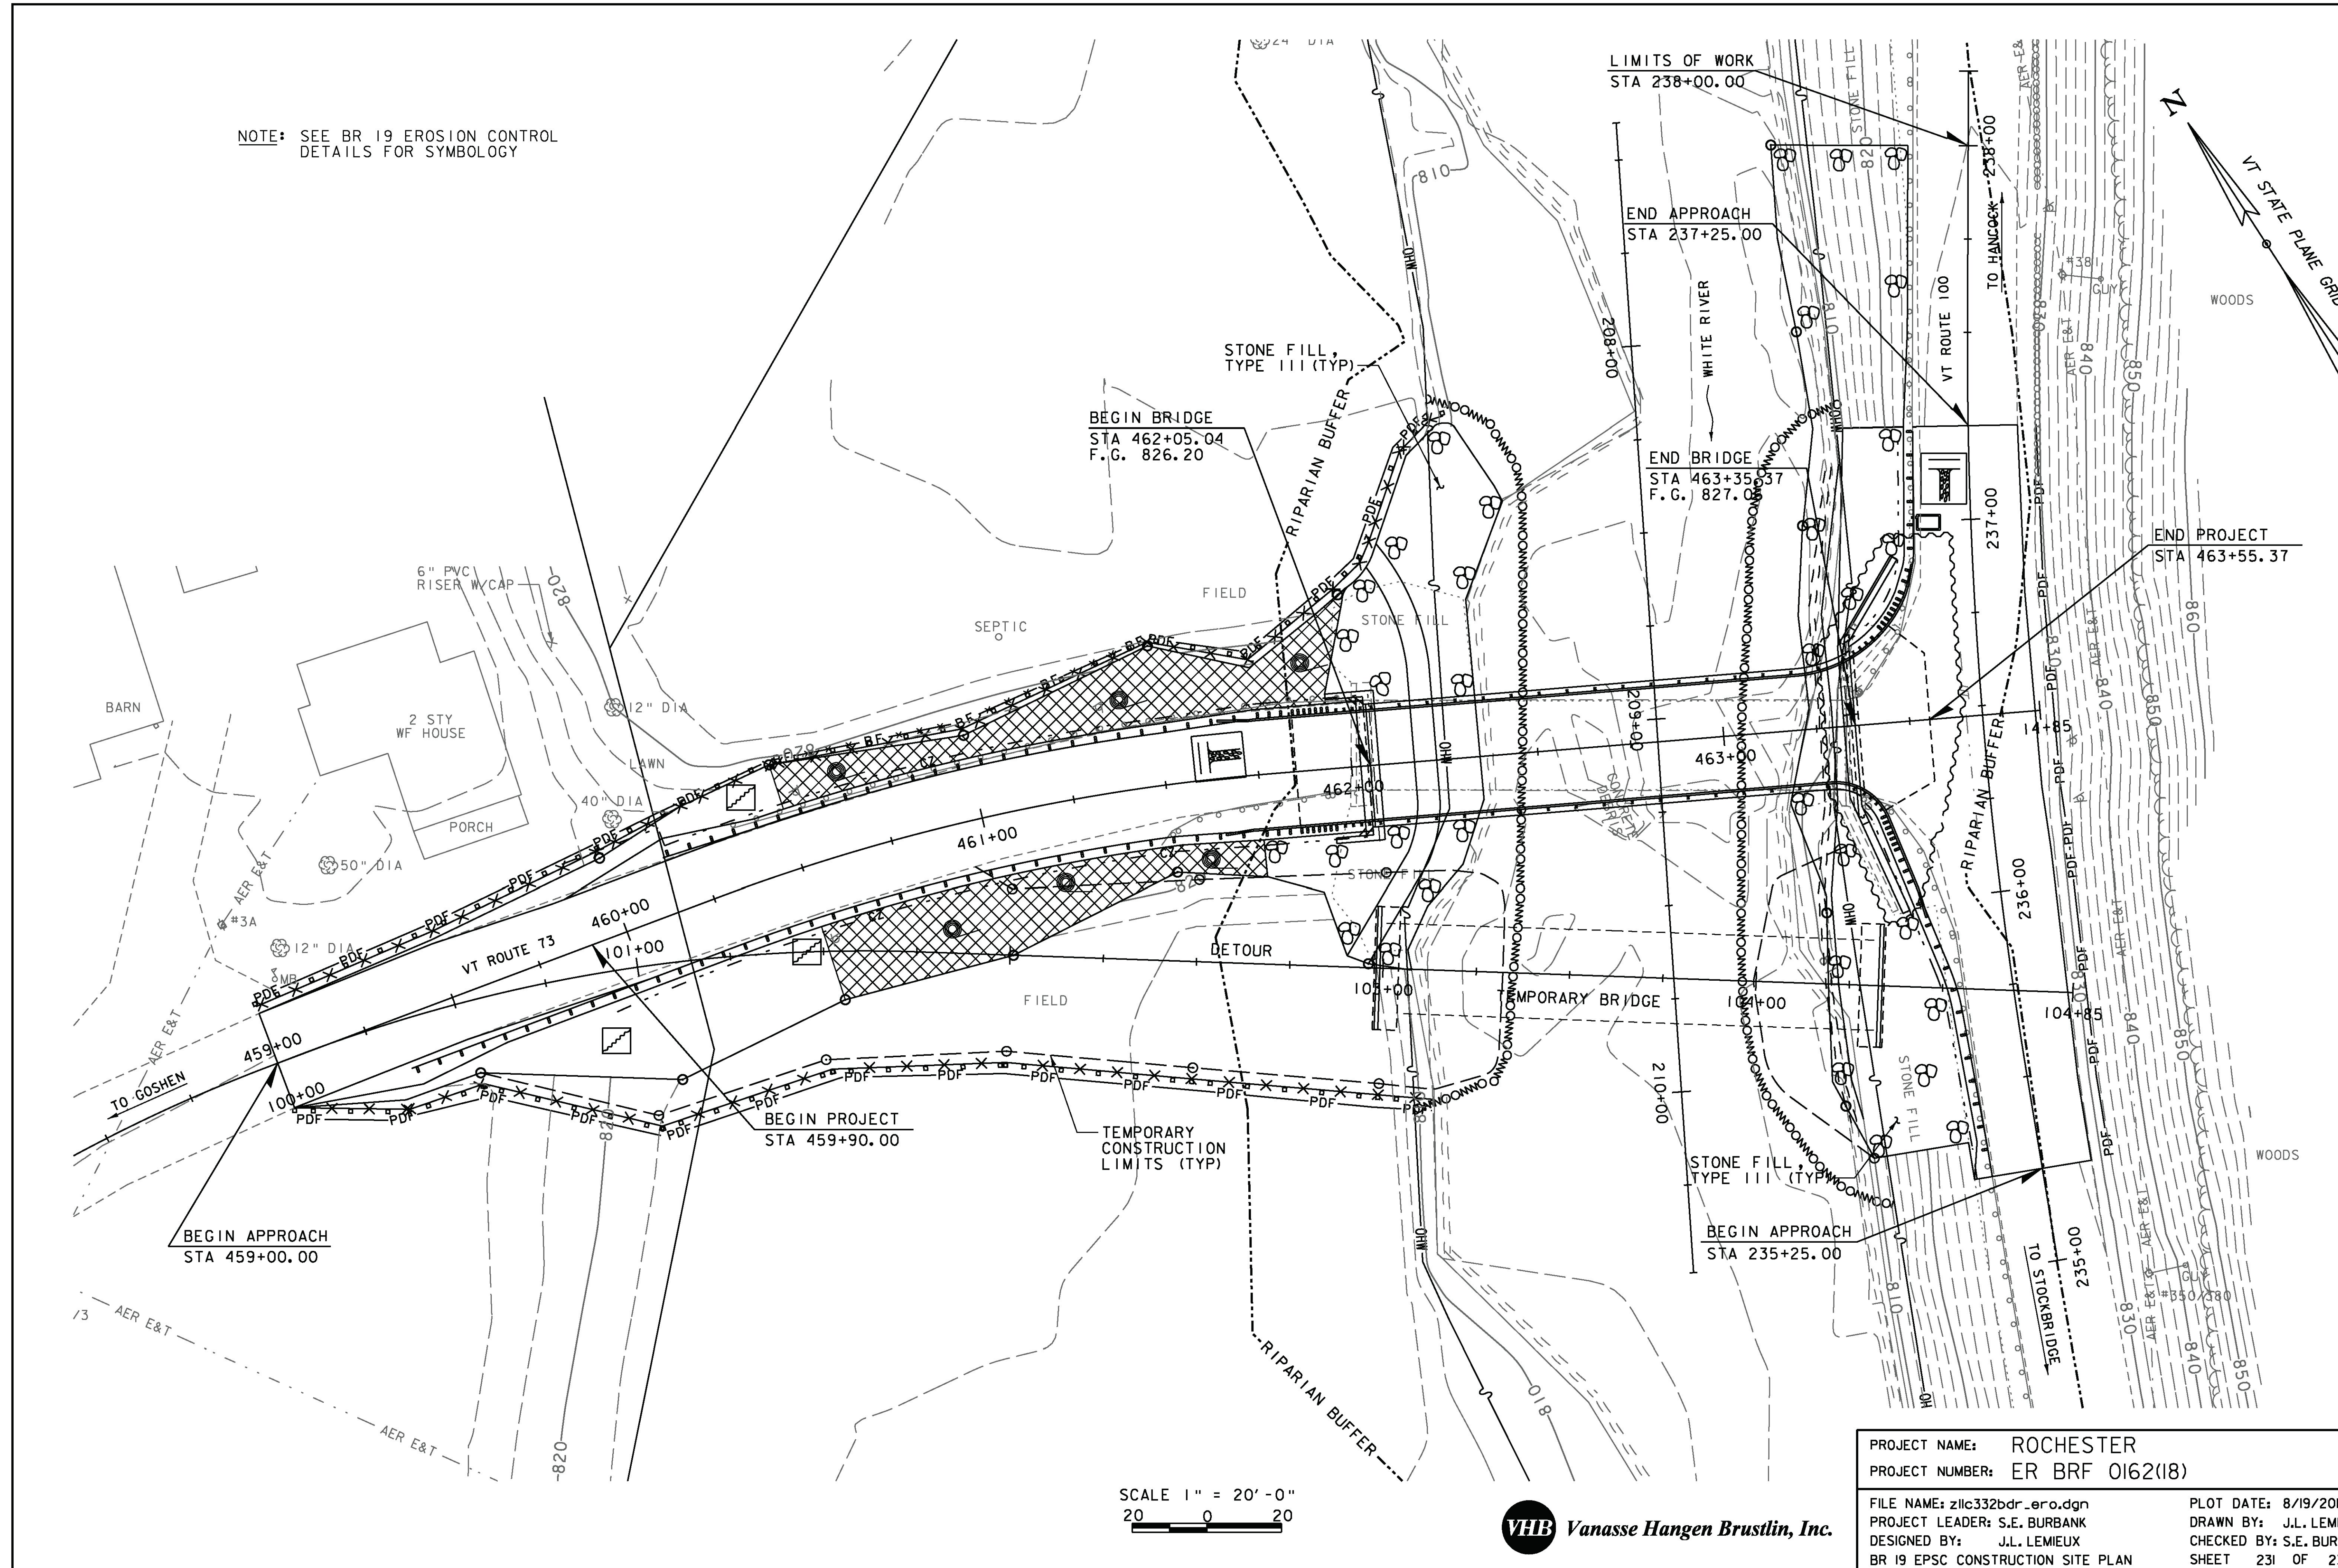

SCALE 1" = 20' - 0"
20 0 20

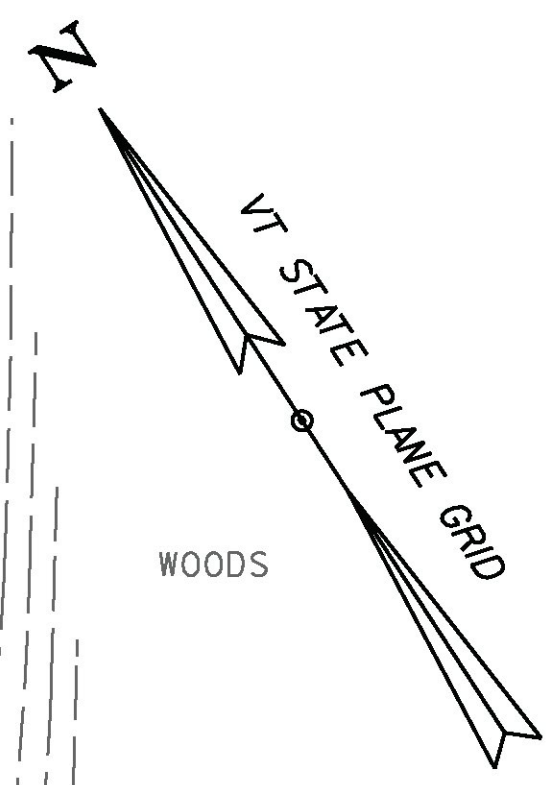

PROJECT NAME:	ROCHESTER	PLOT DATE:	8/19/2013
PROJECT NUMBER:	ER BRF 0162(18)	DRAWN BY:	J.L. LEMIEUX
FILE NAME:	zlic332bdr_ero.dgn	CHECKED BY:	S.E. BURBANK
PROJECT LEADER:	S.E. BURBANK	SHEET	231 OF 238
DESIGNED BY:	J.L. LEMIEUX		
BR 19 EPSC CONSTRUCTION SITE PLAN			