


ONE WEB PLATE W103

WA103 = PL 5/16"
WB103 = PL 5/16"

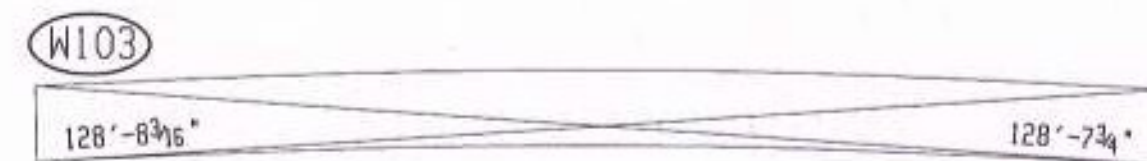

SHOP DRAWING REVIEW

REVIEWED AS REQUIRED BY THE CONSTRUCTION CONTRACT DOCUMENTS AND APPROVED, BUT ONLY FOR CONFORMANCE TO THE DESIGN CONCEPT OF THE WORK, AND SUBJECT TO FURTHER LIMITING AND REQUIREMENTS CONTAINED IN THE CONSTRUCTION CONTRACT DOCUMENTS.

REJECTED REVISE AND RESUBMIT FINISH AS CORRECTED

CORRECTIONS OR COMMENTS MADE ON THE SHOP DRAWINGS DURING THIS REVIEW DO NOT RELIEVE CONTRACTOR FROM COMPLIANCE WITH REQUIREMENTS OF THE DRAWINGS AND SPECIFICATIONS. THIS CHECK IS ONLY FOR REVIEW OF GENERAL CONFORMANCE WITH THE DESIGN CONCEPT OF THE PROJECT AND GENERAL COMPLIANCE WITH THE INFORMATION GIVEN IN THE CONTRACT DOCUMENTS. THE CONTRACTOR IS RESPONSIBLE FOR CONFIRMING AND CORRELATING ALL QUANTITIES AND DIMENSIONS, SELECTING FABRICATION PROCESSES AND TECHNIQUES OF CONSTRUCTION, COORDINATING HIS WORK WITH THAT OF ALL OTHER TRADES, AND PERFORMING HIS WORK IN A SAFE AND SATISFACTORY MANNER.

VHB
Vannoy-Hampton-Brunell, Inc.

Job Number: 57577.00
Reviewed By: R. Malone
Date: 2-28-14

No.	DESCRIPTION	DATE	BY	CHK
B	FOR 2nd APPROVAL	Feb 25 2014	LN	CG
A	FOR APPROVAL	Feb 5 2014	LN	CG

NOTE: BOLT 1 WASHER: 1 WASHER UNDER NUT U.N.
BOLT 2 WASHERS: 1 WASHER UNDER HEAD U.N.
1 WASHER UNDER NUT U.N.



PROJECT: VERMONT RTE 73
BRIDGE NO 19
TOWN OF ROCHESTER

TITLE: WEB GIRDER G103

REFERENCE: PROJECT NUMBER: ER-BRF-0162 (18)

DATE	BY	REVISION
LN	JANUARY 2014	000540
CG	JANUARY 2014	103-01

35x45 - PRINTED ON 35x45 PAPER 2014 AT 15:14:24 BY TRUSTEES