

GPS CONTROL POINTS

HVCTRL #1

ROXRIM

NORTH = 559539.567
EAST = 1573126.562
ELEV. = 890.320

DESCRIBED BY VERMONT AGENCY OF TRANSPORTATION 1996 (DJM)
GENERAL LOCATION, ROXBURY, VT. ABOUT 9.5 MI (15.3 KM) SOUTHWEST OF 'NORTHFIELD, ABOUT 8.5 MI (13.7 KM) NORTH OF RANDOLPH, AND ABOUT 21 MI , (33.8 KM) EAST OF MIDDLEBURY. TO REACH FROM THE INTERSECTION OF VT ROUTES 12 AND 12A IN RANDOLPH VILLAGE GO NORTH ALONG VT ROUTE 12A FOR 10.4 MI (16.7 KM) TO THE MARK ON THE LEFT IN THE TOP OF THE NORTH END OF A MASSIVE LEDGE OUTCROP, JUST SOUTH OF AN OLD ROAD GRADE. IT IS 0.6 MI (1.0 KM) SOUTH ALONG VT ROUTE 12A FROM THE CENTRAL VERMONT RAILWAY BRIDGE OVER VT ROUTE 12A AND THE THIRD BRANCH OF THE WHITE RIVER. TO REACH FROM THE INTERSECTION OF VT ROUTES 12 AND 12A IN NORTHFIELD GO SOUTH ALONG VT ROUTE 12A FOR 10.8 MI (17.4 KM) TO THE MARK ON THE RIGHT. THE MARK IS 16.5 M (54.1 FT) WEST OF AND ABOUT 5 M, (16.4 FT) HIGHER THAN THE CENTERLINE OF VT ROUTE 12A. TH MARK IS 13.3 M (43.6-FT) NORTH OF POLE NO. 6/282, 10.7 M (35.1-FT) EAST OF THE EAST EDGE OF A QUARRY HOLE. 7.8 M (25.6 FT) EAST OF A 30-CM TRIPLE-TRUNK SPRUCE, AND 1.2 M (3.9 FT) EAST OF A FIBERGLASS WITNESS POST.

HVCTRL #2

ROXRIM AZ MK


NORTH = 561370.541
EAST = 1574485.923
ELEV. = 875.294

DESCRIBED BY VERMONT AGENCY OF TRANSPORTATION 1996 (DJM)
GENERAL LOCATION, ROXBURY, VT. ABOUT 9 MI (14.5 KM) SOUTHWEST OF 'NORTHFIELD, ABOUT 9 MI (14.5 KM) NORTH OF RANDOLPH, AND ABOUT 21 MI, (33.8 KM) EAST OF MIDDLEBURY. TO REACH FROM THE INTERSECTION OF VT, ROUTES 12 AND 12A IN RANDOLPH VILLAGE GO NORTH ALONG VT ROUTE 12A FOR 10.8 MI (17.4 KM) TO THE MARK ON THE LEFT. IT IS 0.15 MI (0.24 KM) SOUTH ALONG VT ROUTE 12A FROM THE CENTRAL VERMONT RAILROAD BRIDGE OVER VT ROUTE 12A AND THE THIRD BRANCH OF THE WHITE RIVER. TO REACH FROM THE INTERSECTION OF VT ROUTES 12 AND 12A IN NORTHFIELD GO SOUTH ALONG VT ROUTE 12A FOR 10.3 MI (16.6 KM) TO THE MARK ON THE RIGHT. THE MARK IS 7.2 M (23.6 FT) NORTHWEST OF AND ABOUT 0.3 M (1.0 FT) LOWER THAN THE CENTERLINE OF VT ROUTE 12. 15.6 M (51.2 FT) SOUTH OF POLE NO. 291, 24.7 M (81.0 FT) SOUTHWEST OF A YELLOW IRON PROPERTY PIPE WHICH PROJECTS ABOUT 0.8 M (2.6 FT) ABOVE GROUND SURFACE. THE MARK IS 57.0 M (187.0-FT) SOUTHWEST OF THE CENTERLINE OF GRAVEL DRIVE, AND 0.35-M (1.15-FT) SOUTHEAST OF A FIBERGLASS WITNESS POST. IT IS A CAST ALUMINUM DISK IN THE TOP OF A CAST ALUMINUM MONUMENT SET FLUSH WITH GROUND SURFACE.

TRAVERSE TIES

HVCTRL #3


NORTH = 561687.033
EAST = 1575121.154
ELEV. = 879.342

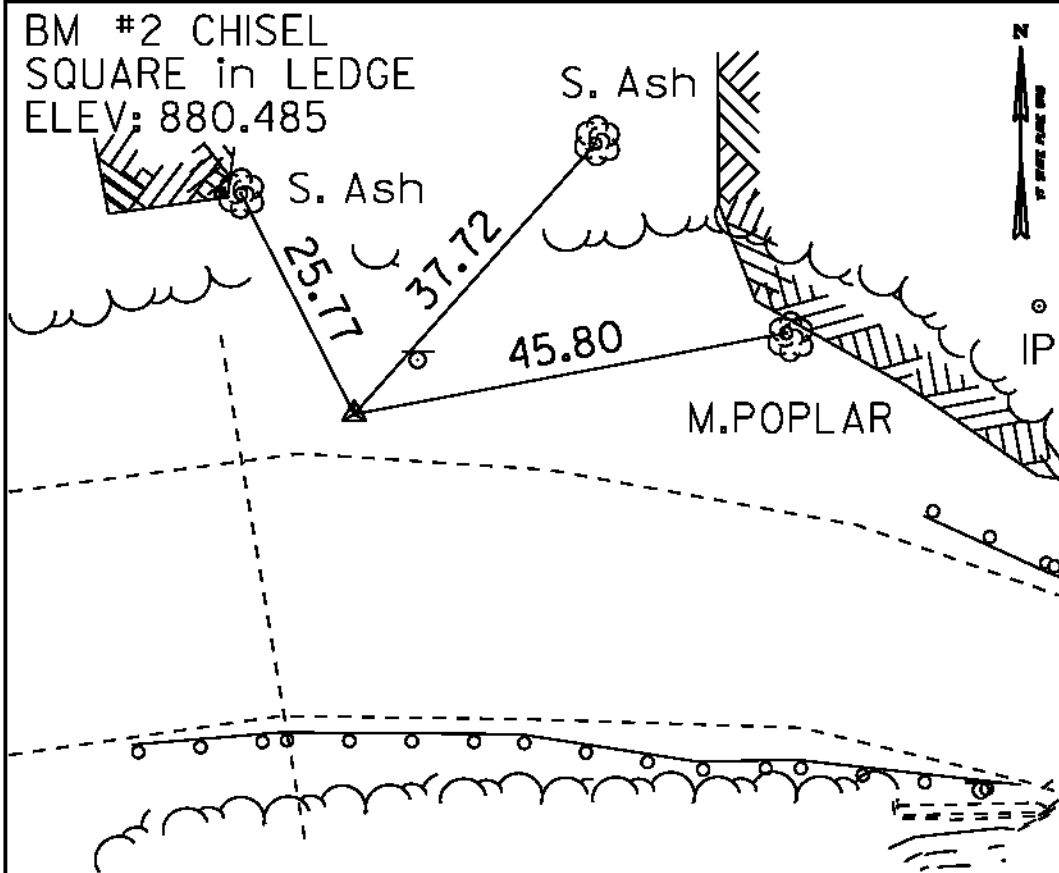

• MAIN TRAVERSE COMPLETED Aug. 24,1998 by L.Orvis P.C. & R.Bullock


HVCTRL #4

NORTH = 561562.843
EAST = 1575491.445
ELEV. = 878.456

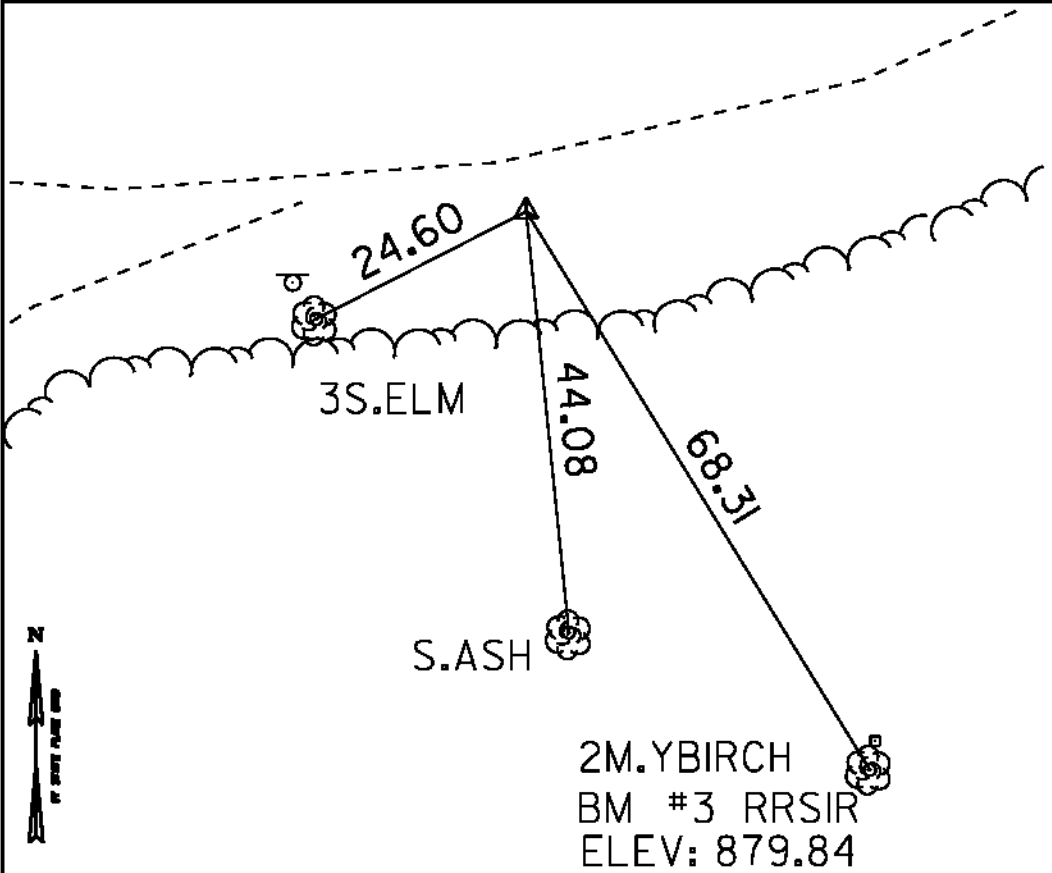

HVCTRL #5

NORTH = 561883.089
EAST = 1575968.541
ELEV. = 881.967

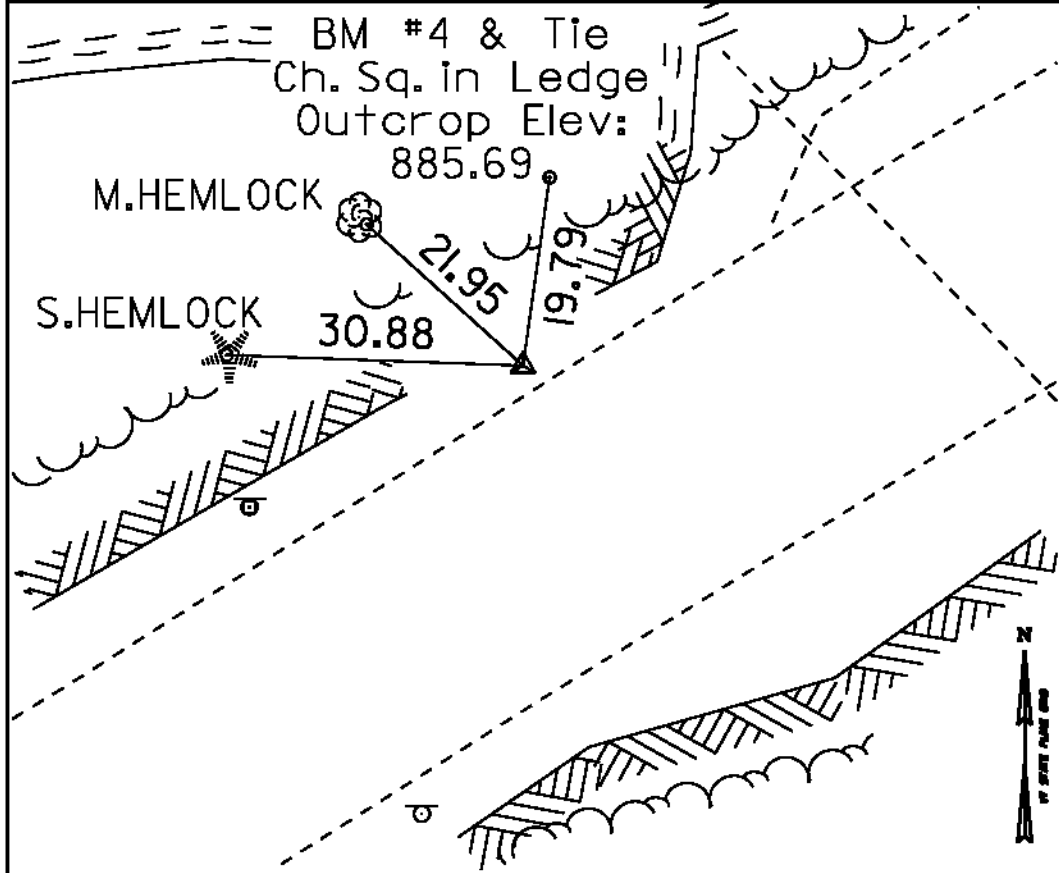

ALIGNMENT COORD

	STATION	NORTHING	EASTING
POB	1+00.00	561605.9485	1574935.8958
PC	1+85.46	561645.4116	1575011.6966
Tangent Direction: N 62°29'52.17" E			
Tangent Length: 85.46			
PI	2+87.44	561692.5071	1575102.1577
PT	3+77.45	561657.0833	1575197.7943
Radius: 230.00			
Delta: 47°49'36.42" Right			
Degree of Curvature (Arc): 24°54'40.35"			
Length: 191.99			
Tangent: 101.99			
Chord: 186.46			
Middle Ordinate: 19.74			
External: 21.60			
PT	3+77.45	561657.0833	1575197.7943
PC	5+62.68	561592.7464	1575371.4903
Tangent Direction: S 69°°40'31.41" E			
Tangent Length: 185.23			

PI 6+71.44 561554.9684 1575473.4828

	STATION	NORTHING	EASTING
PT	7+65.87	561609.8318	1575567.3959
Radius: 230.00			
Delta: 50°°37'04.04" Left			
Degree of Curvature (Arc): 24°°54'40.35"			
Length: 203.19			
Tangent: 108.76			
Chord: 196.65			
Middle Ordinate: 22.08			
External: 24.42			
PT	7+65.87	561609.8318	1575567.3959
POE	8+00.00	561627.0486	1575596.8671
Tangent Direction: N 59°42'24.55" E			
Tangent Length: 34.13			

DATUM	
VERTICAL	NAVD 88
HORIZONTAL	NAD 83 (96)
ADJUSTMENT	Least Sq.

PROJECT NAME: ROXBURY
PROJECT NUMBER: BHF 0187(8)

FILE NAME: survey\xl0c420+1.dgn
PROJECT LEADER: WILLIAMS
DESIGNED BY:
TIE SHEET

PLOT DATE: 21-SEP-2011
DRAWN BY: R. BULLOCK
CHECKED BY:
SHEET 12 OF 54