



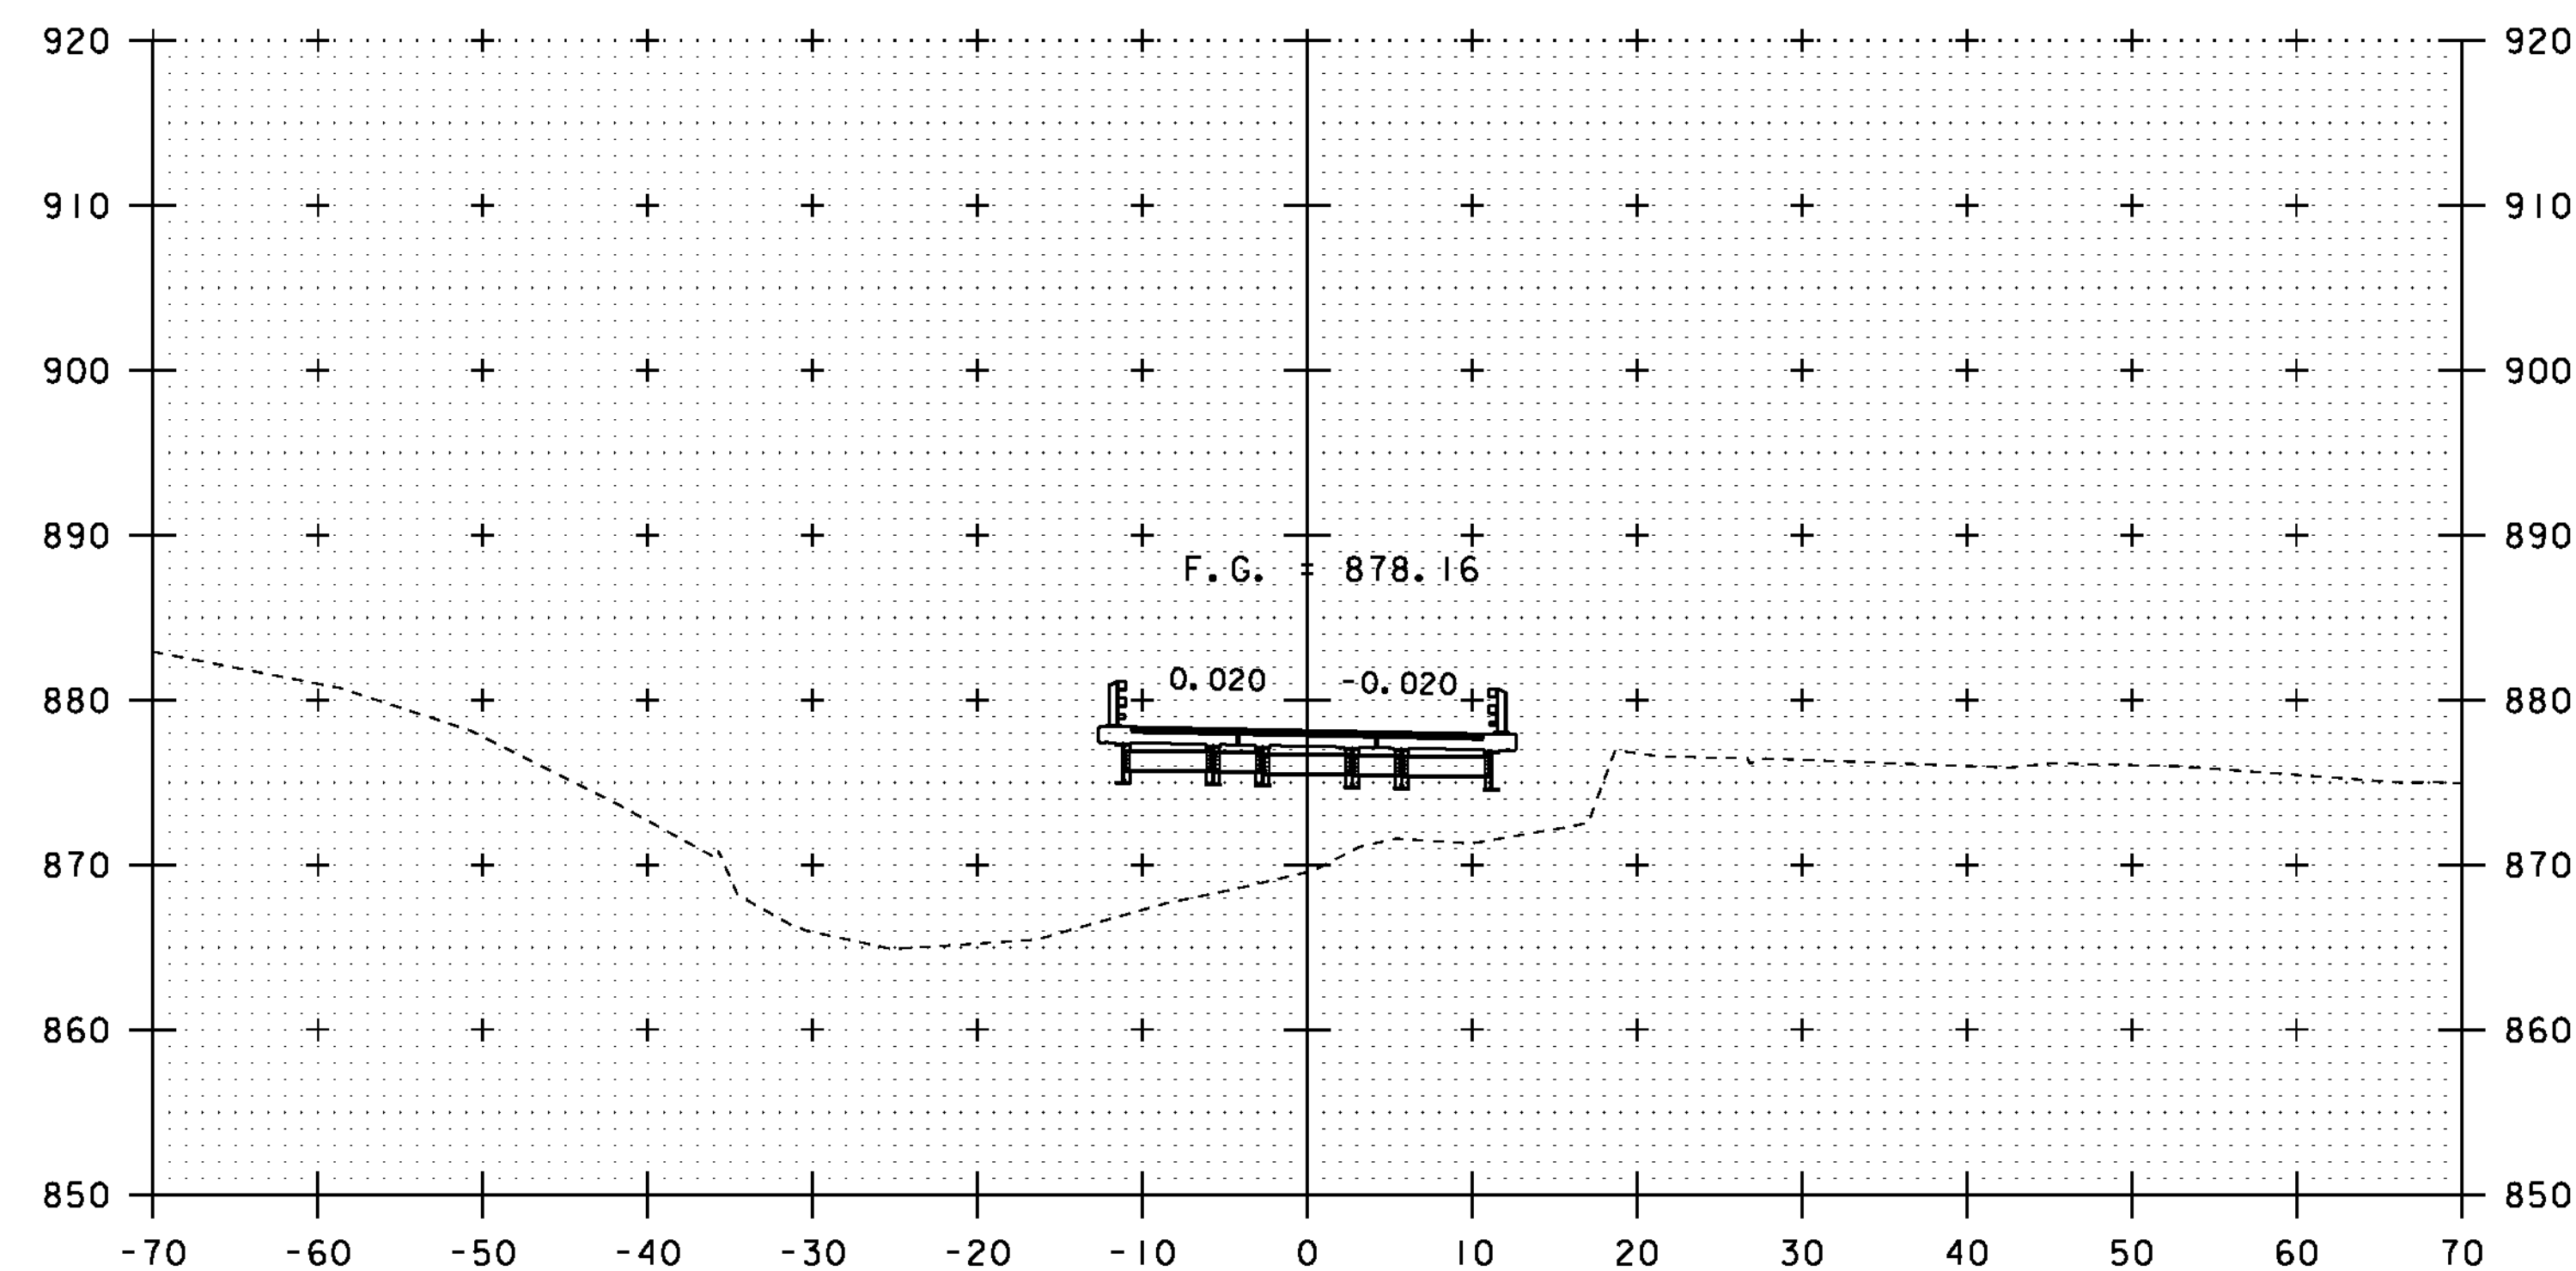


4+25

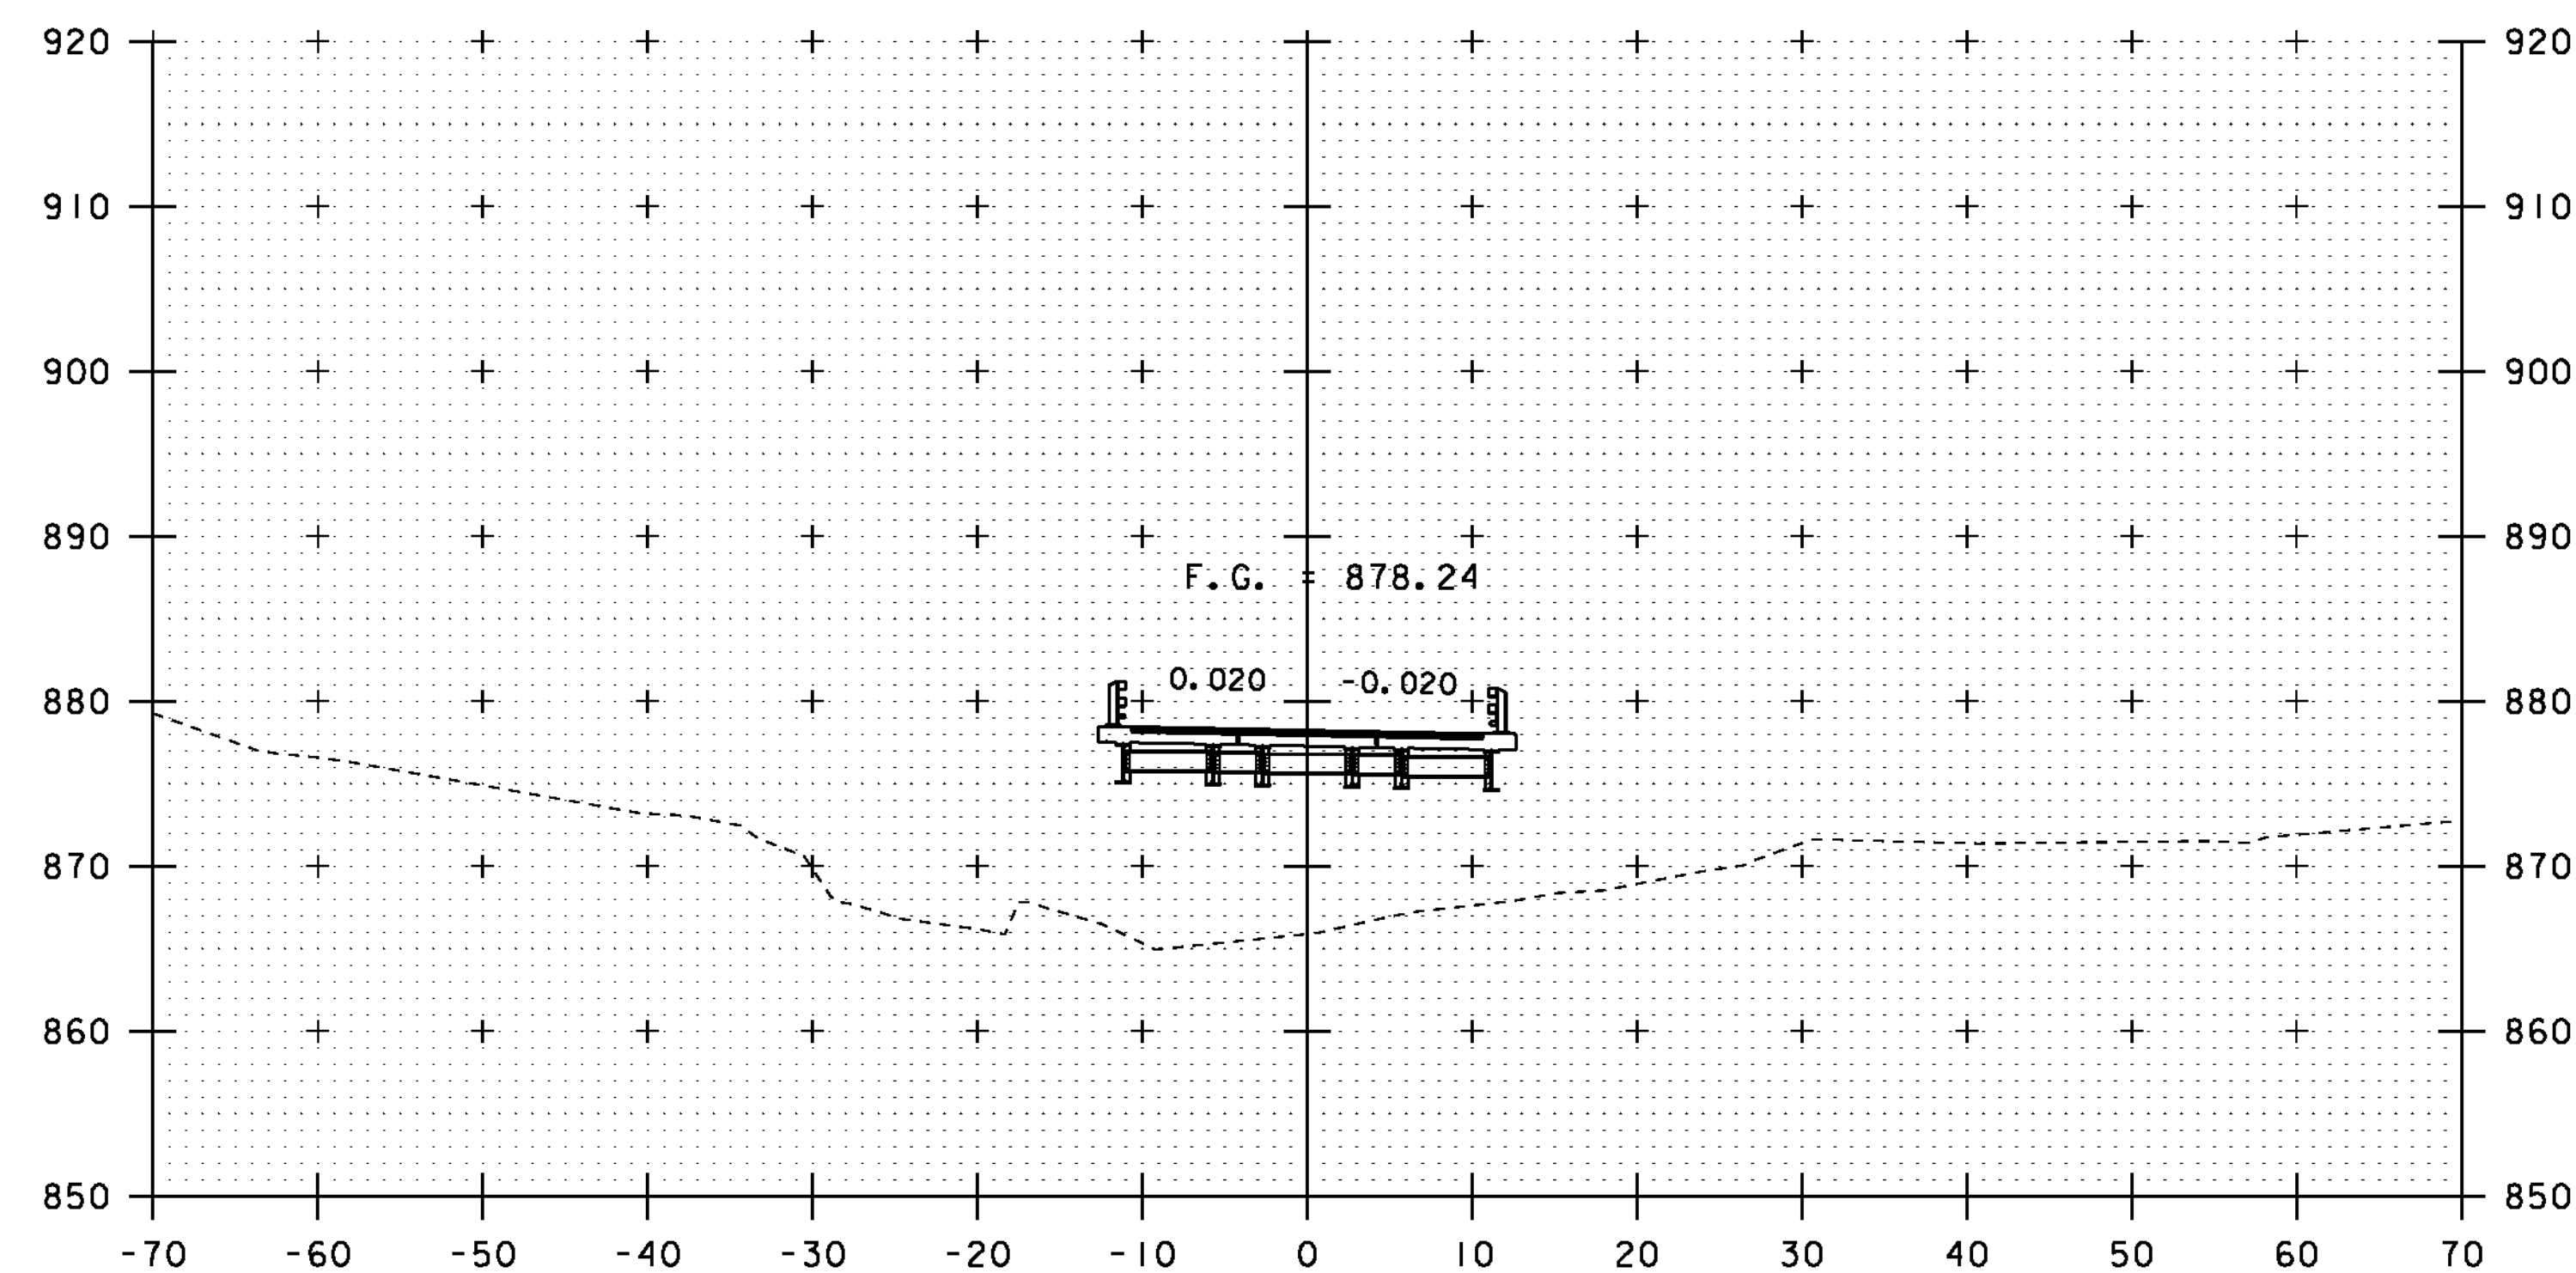


4+00

BEGIN BRIDGE
STA 3+81.32

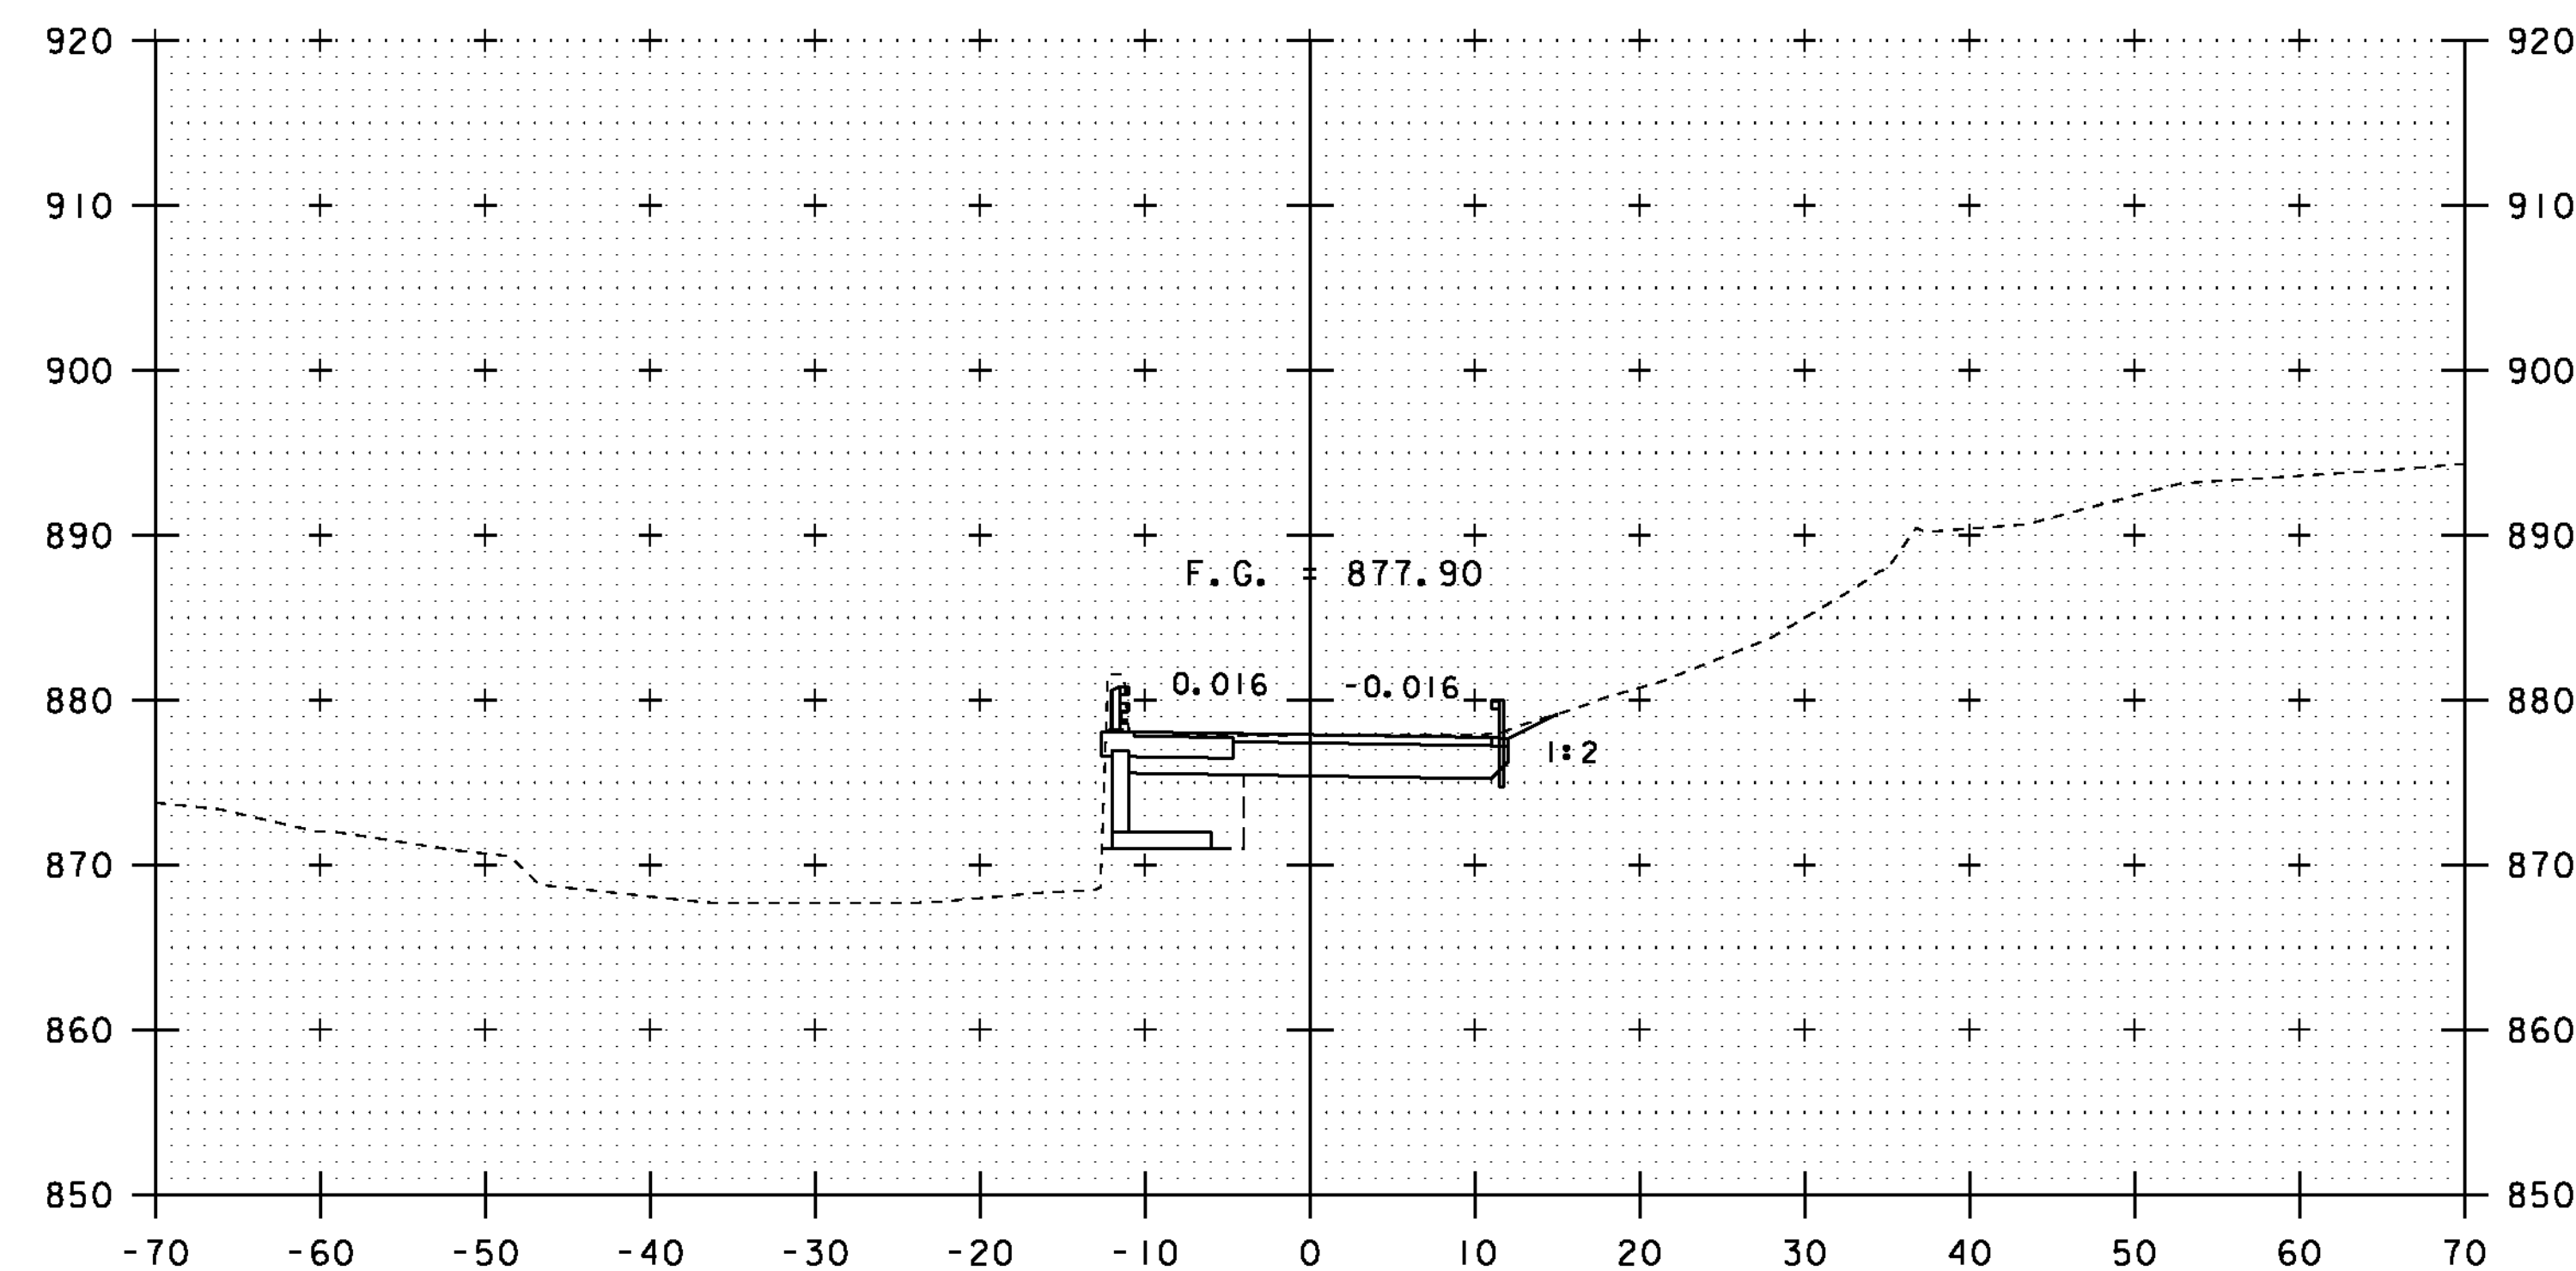

4+75

BEGIN PRECAST CONCRETE STRUCTURE (WINGWALL NO. 3)
STA 4+64.91 LT

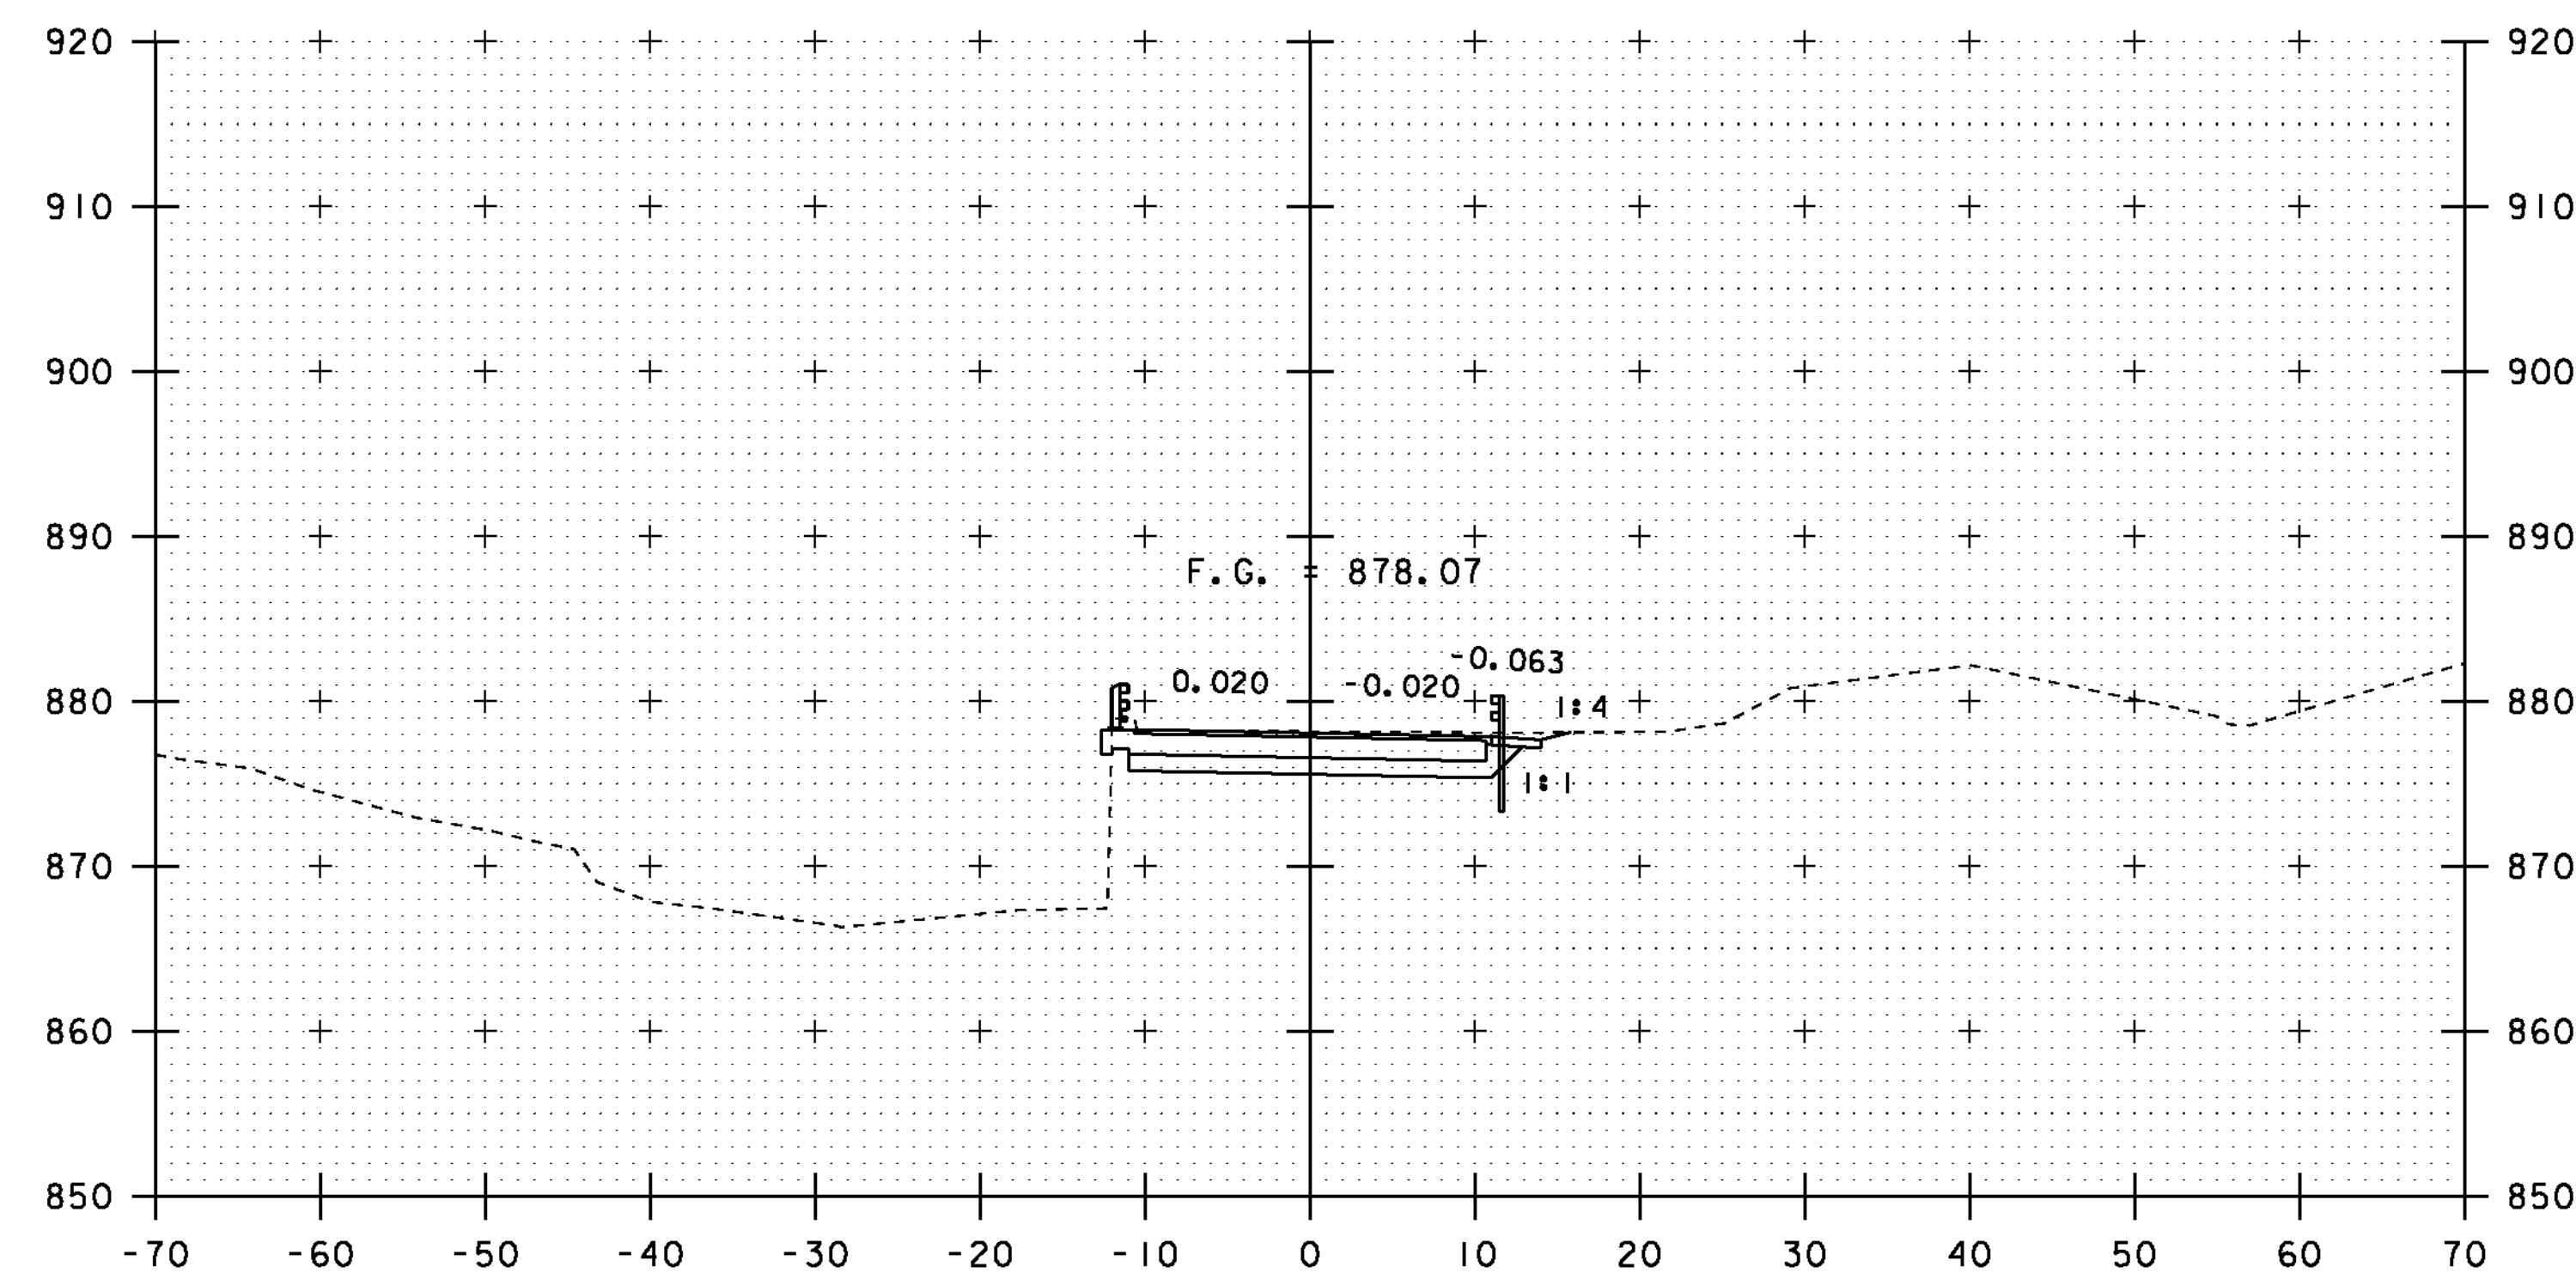

4+50

END BRIDGE
STA 4+37.98



STA. 4+00 TO STA. 4+75

PROJECT NAME: ROXBURY	
PROJECT NUMBER: BHF 0187(8)	
FILE NAME: sl0c420xsl.dgn	PLOT DATE: 21-SEP-2011
PROJECT LEADER: C. P. WILLIAMS	DRAWN BY: G. ROY
DESIGNED BY: G. ROY	CHECKED BY: T. FILLBACH
VT 12A CROSS SECTIONS (3)	SHEET 34 OF 54