




5+25

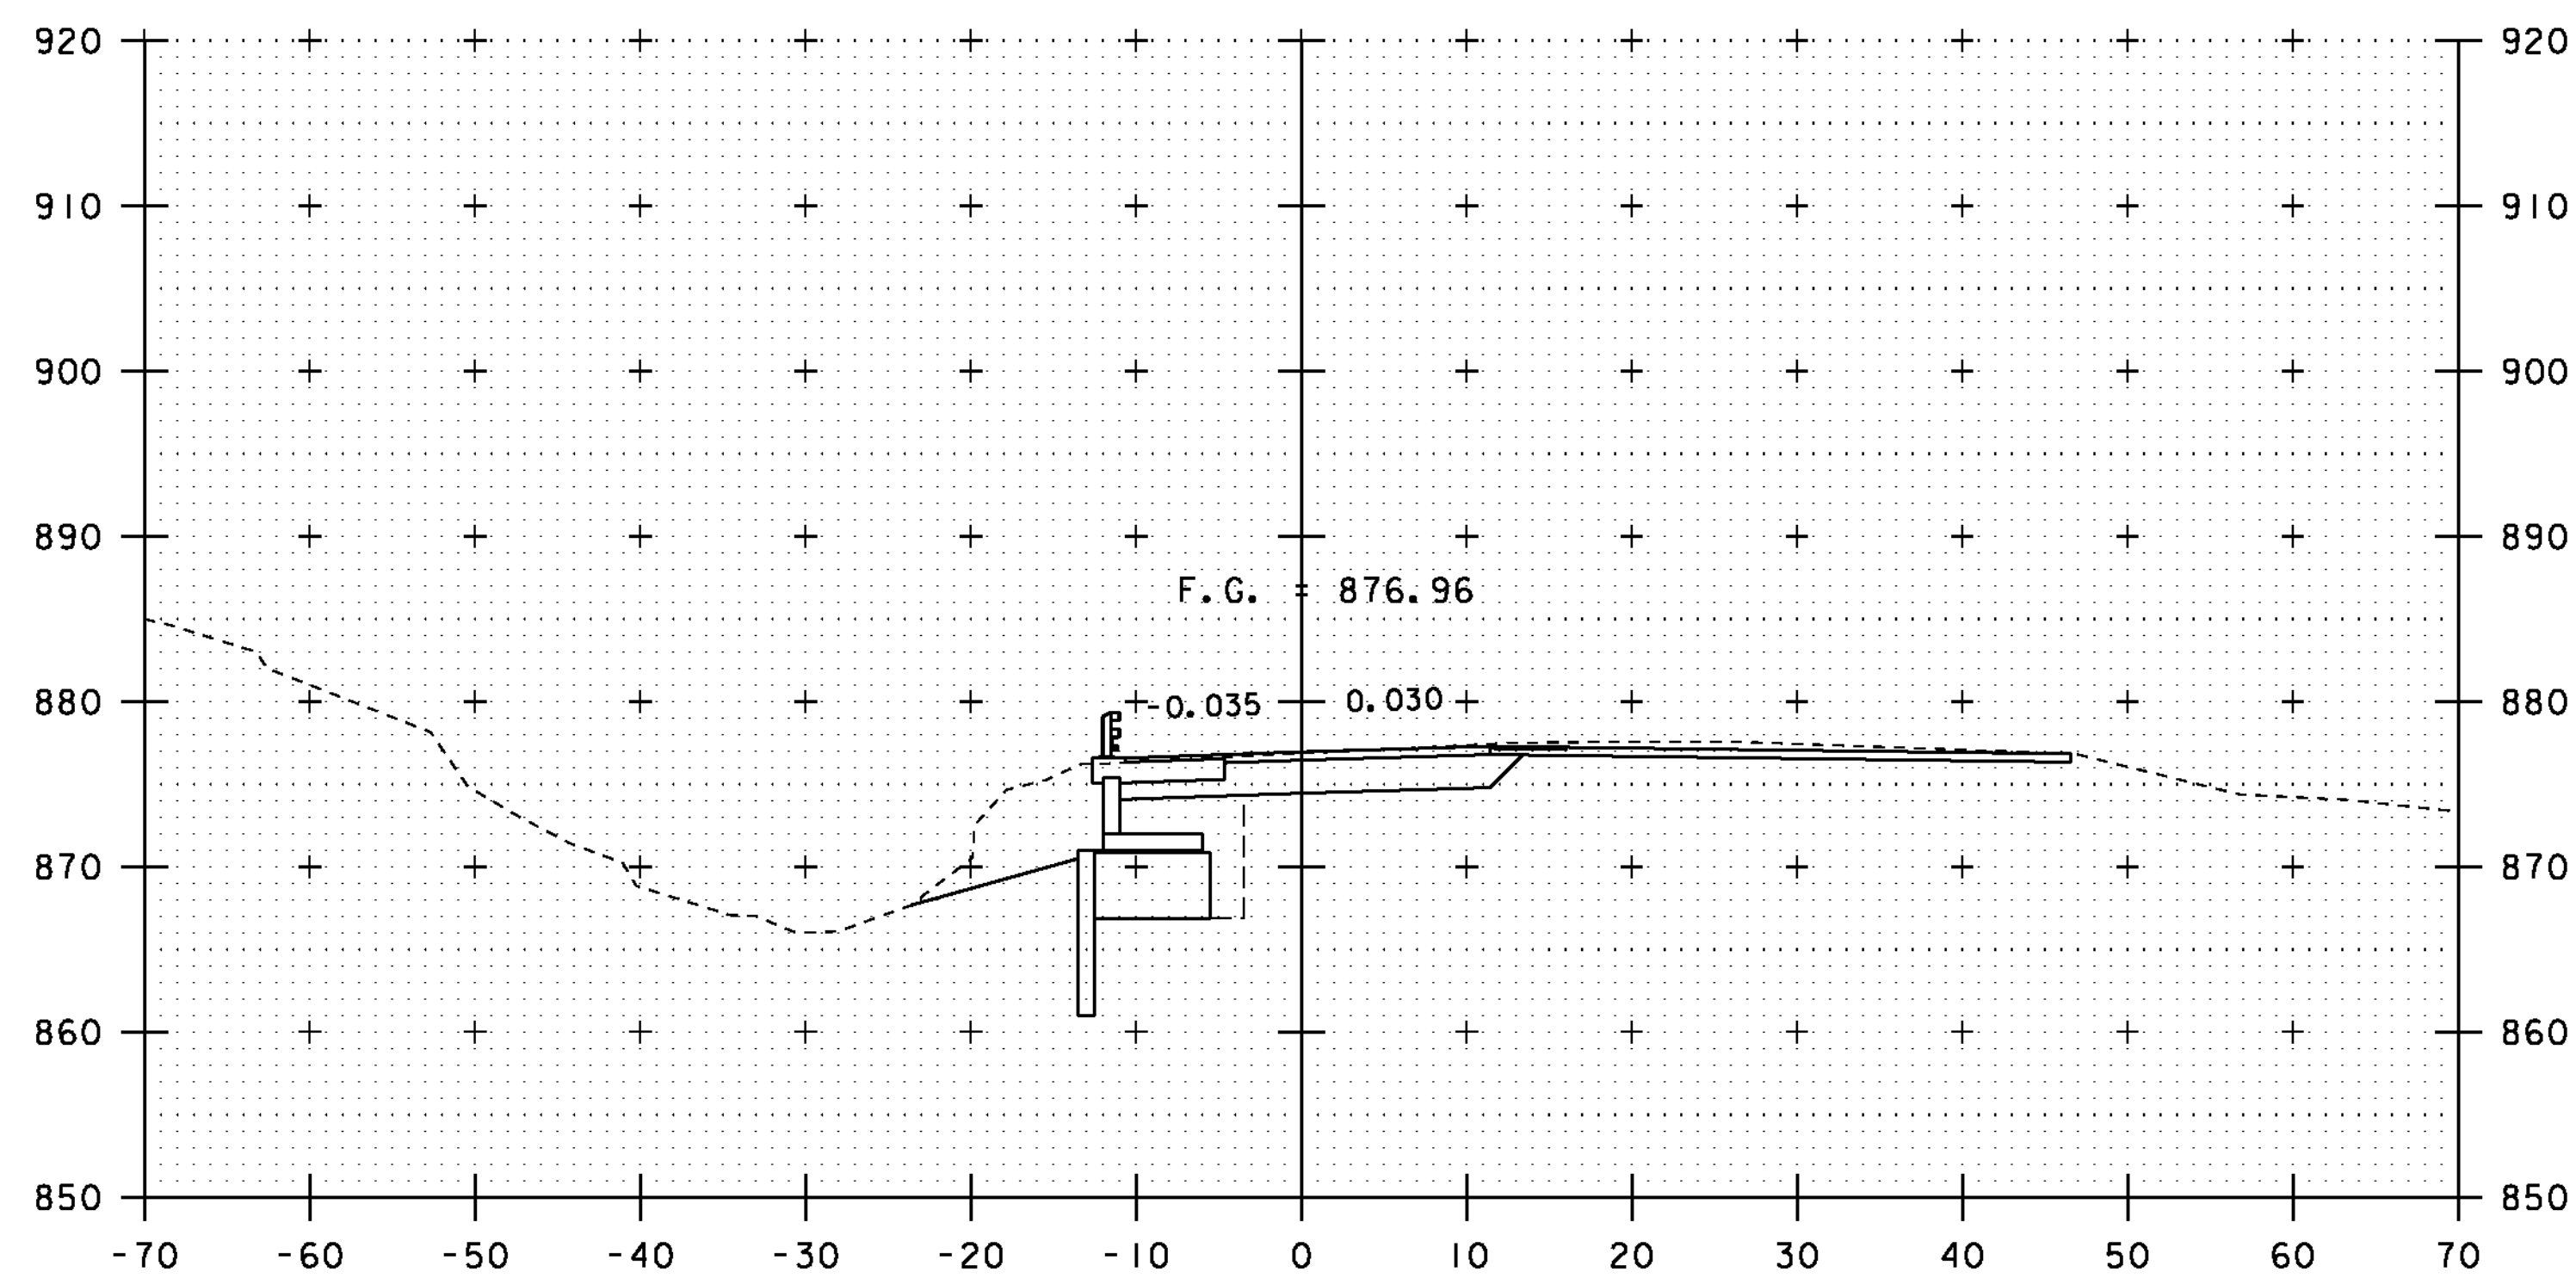

5+75

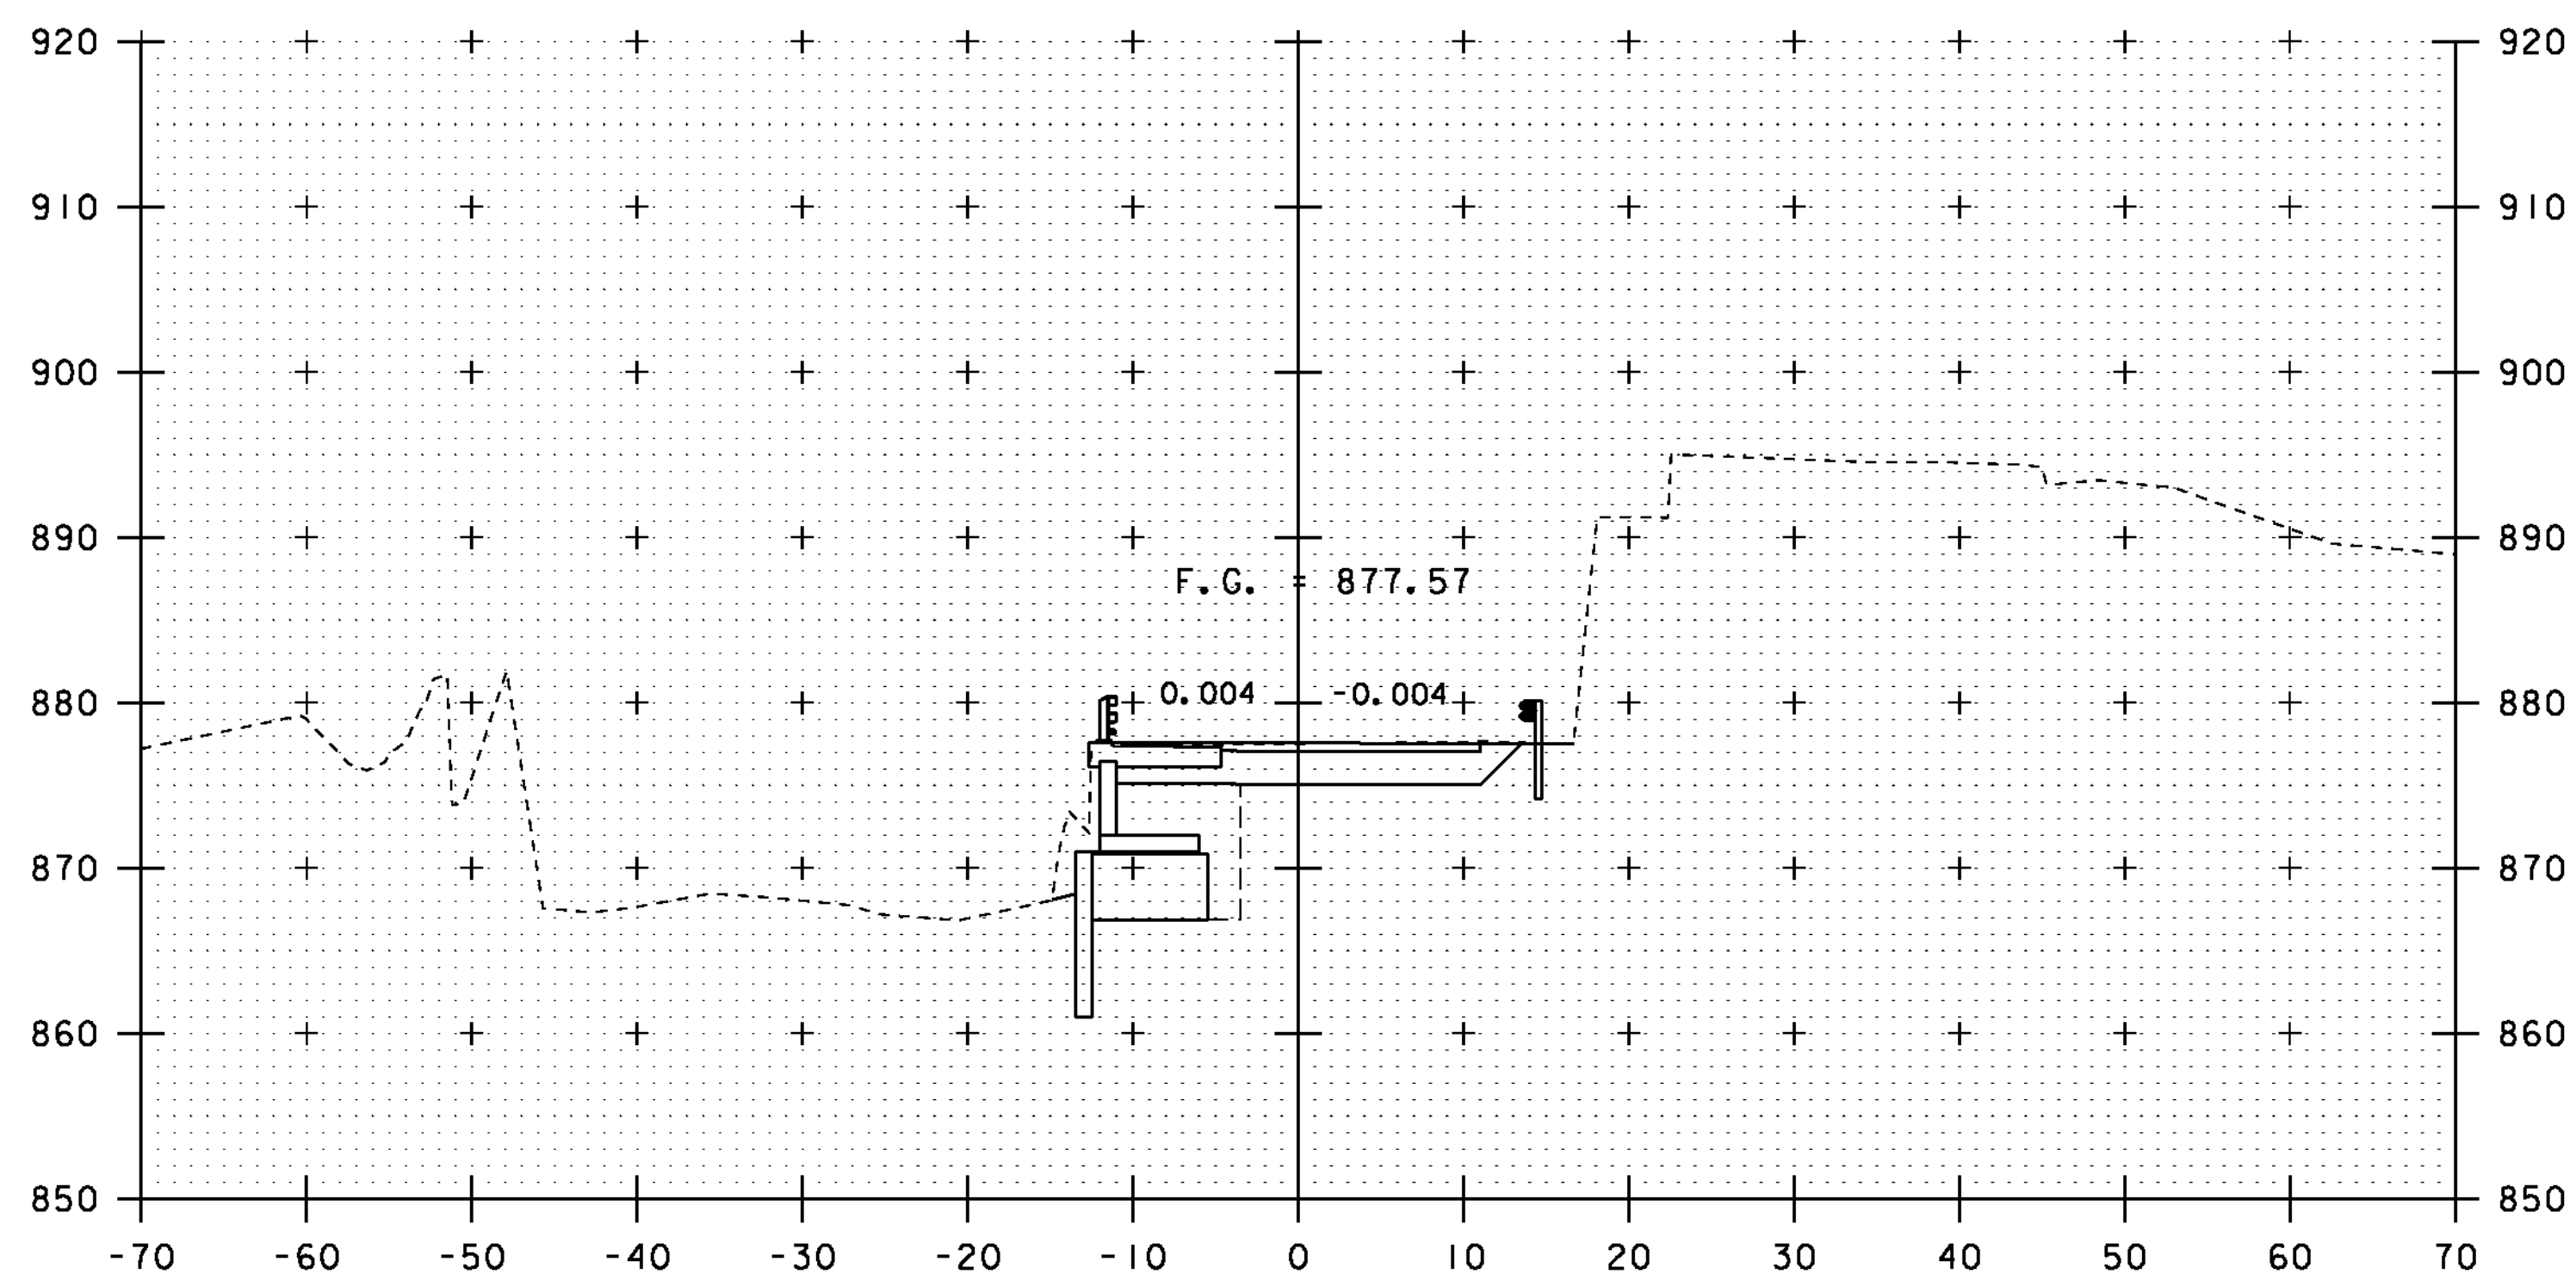

5+00

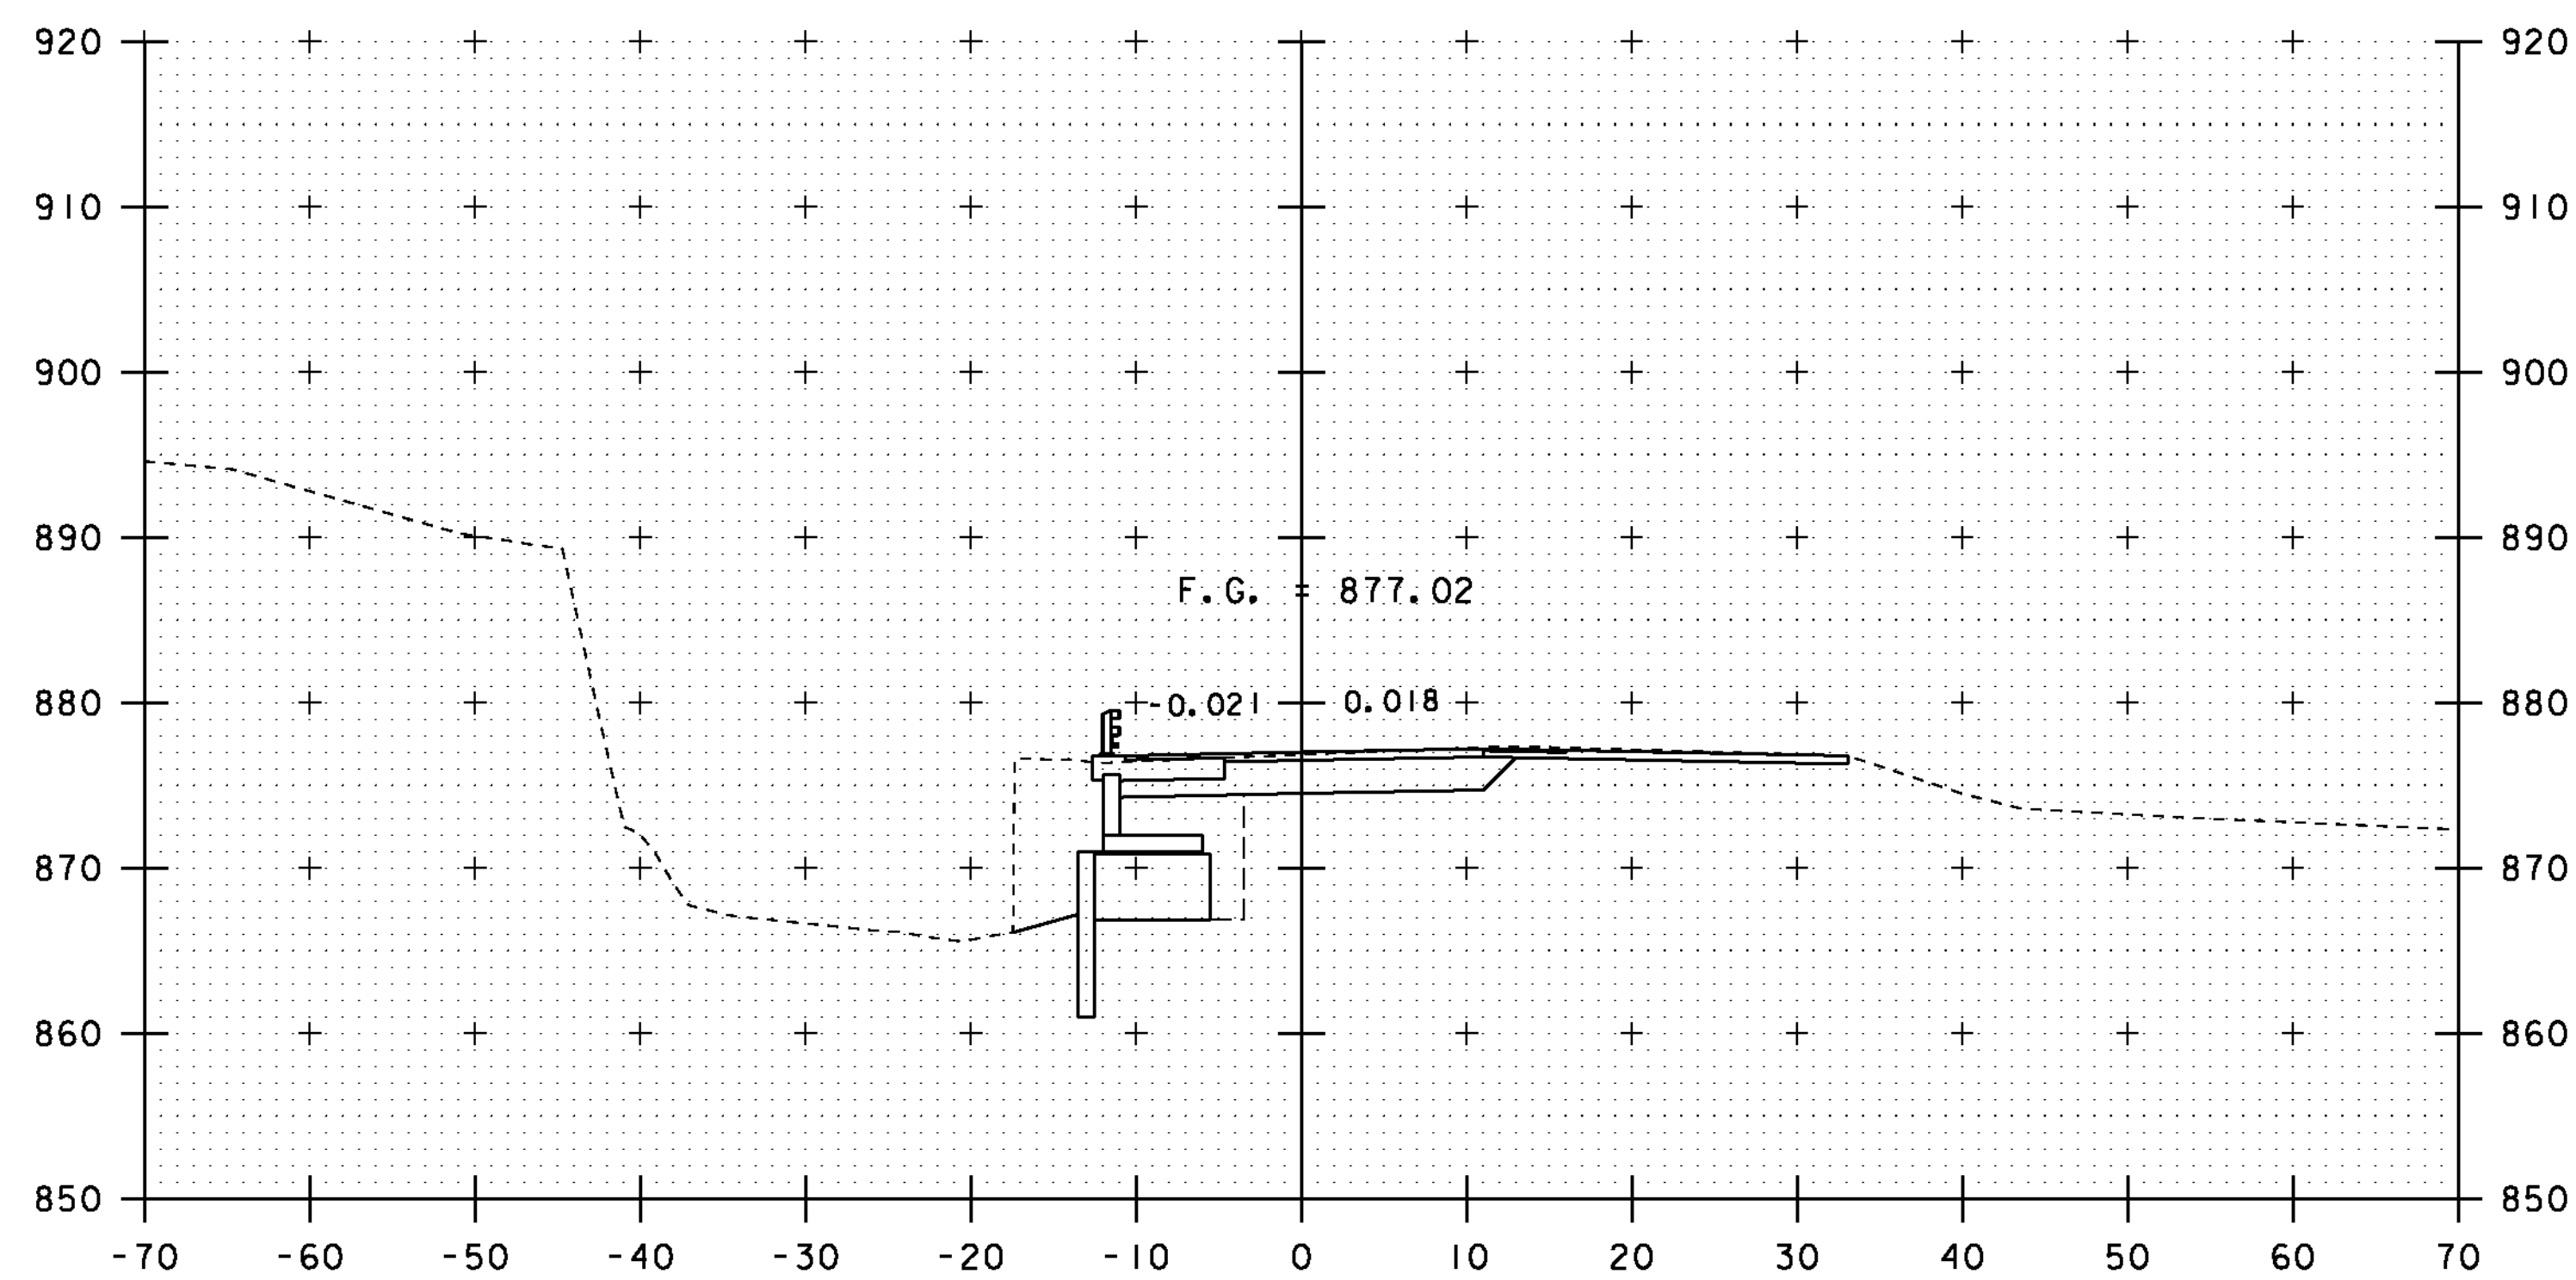

5+50

BEGIN PERMANENT STEEL SHEET PILING
STA 4+90.0 LT

PROJECT NAME: ROXBURY	PLOT DATE: 21-SEP-2011
PROJECT NUMBER: BHF 0187(8)	DRAWN BY: G. ROY
FILE NAME: sl0c420xsl.dgn	CHECKED BY: T. FILLBACH
PROJECT LEADER: C. P. WILLIAMS	SHEET 35 OF 54
DESIGNED BY: G. ROY	
VT I2A CROSS SECTIONS (4)	

STA. 5+00 TO STA. 5+75