



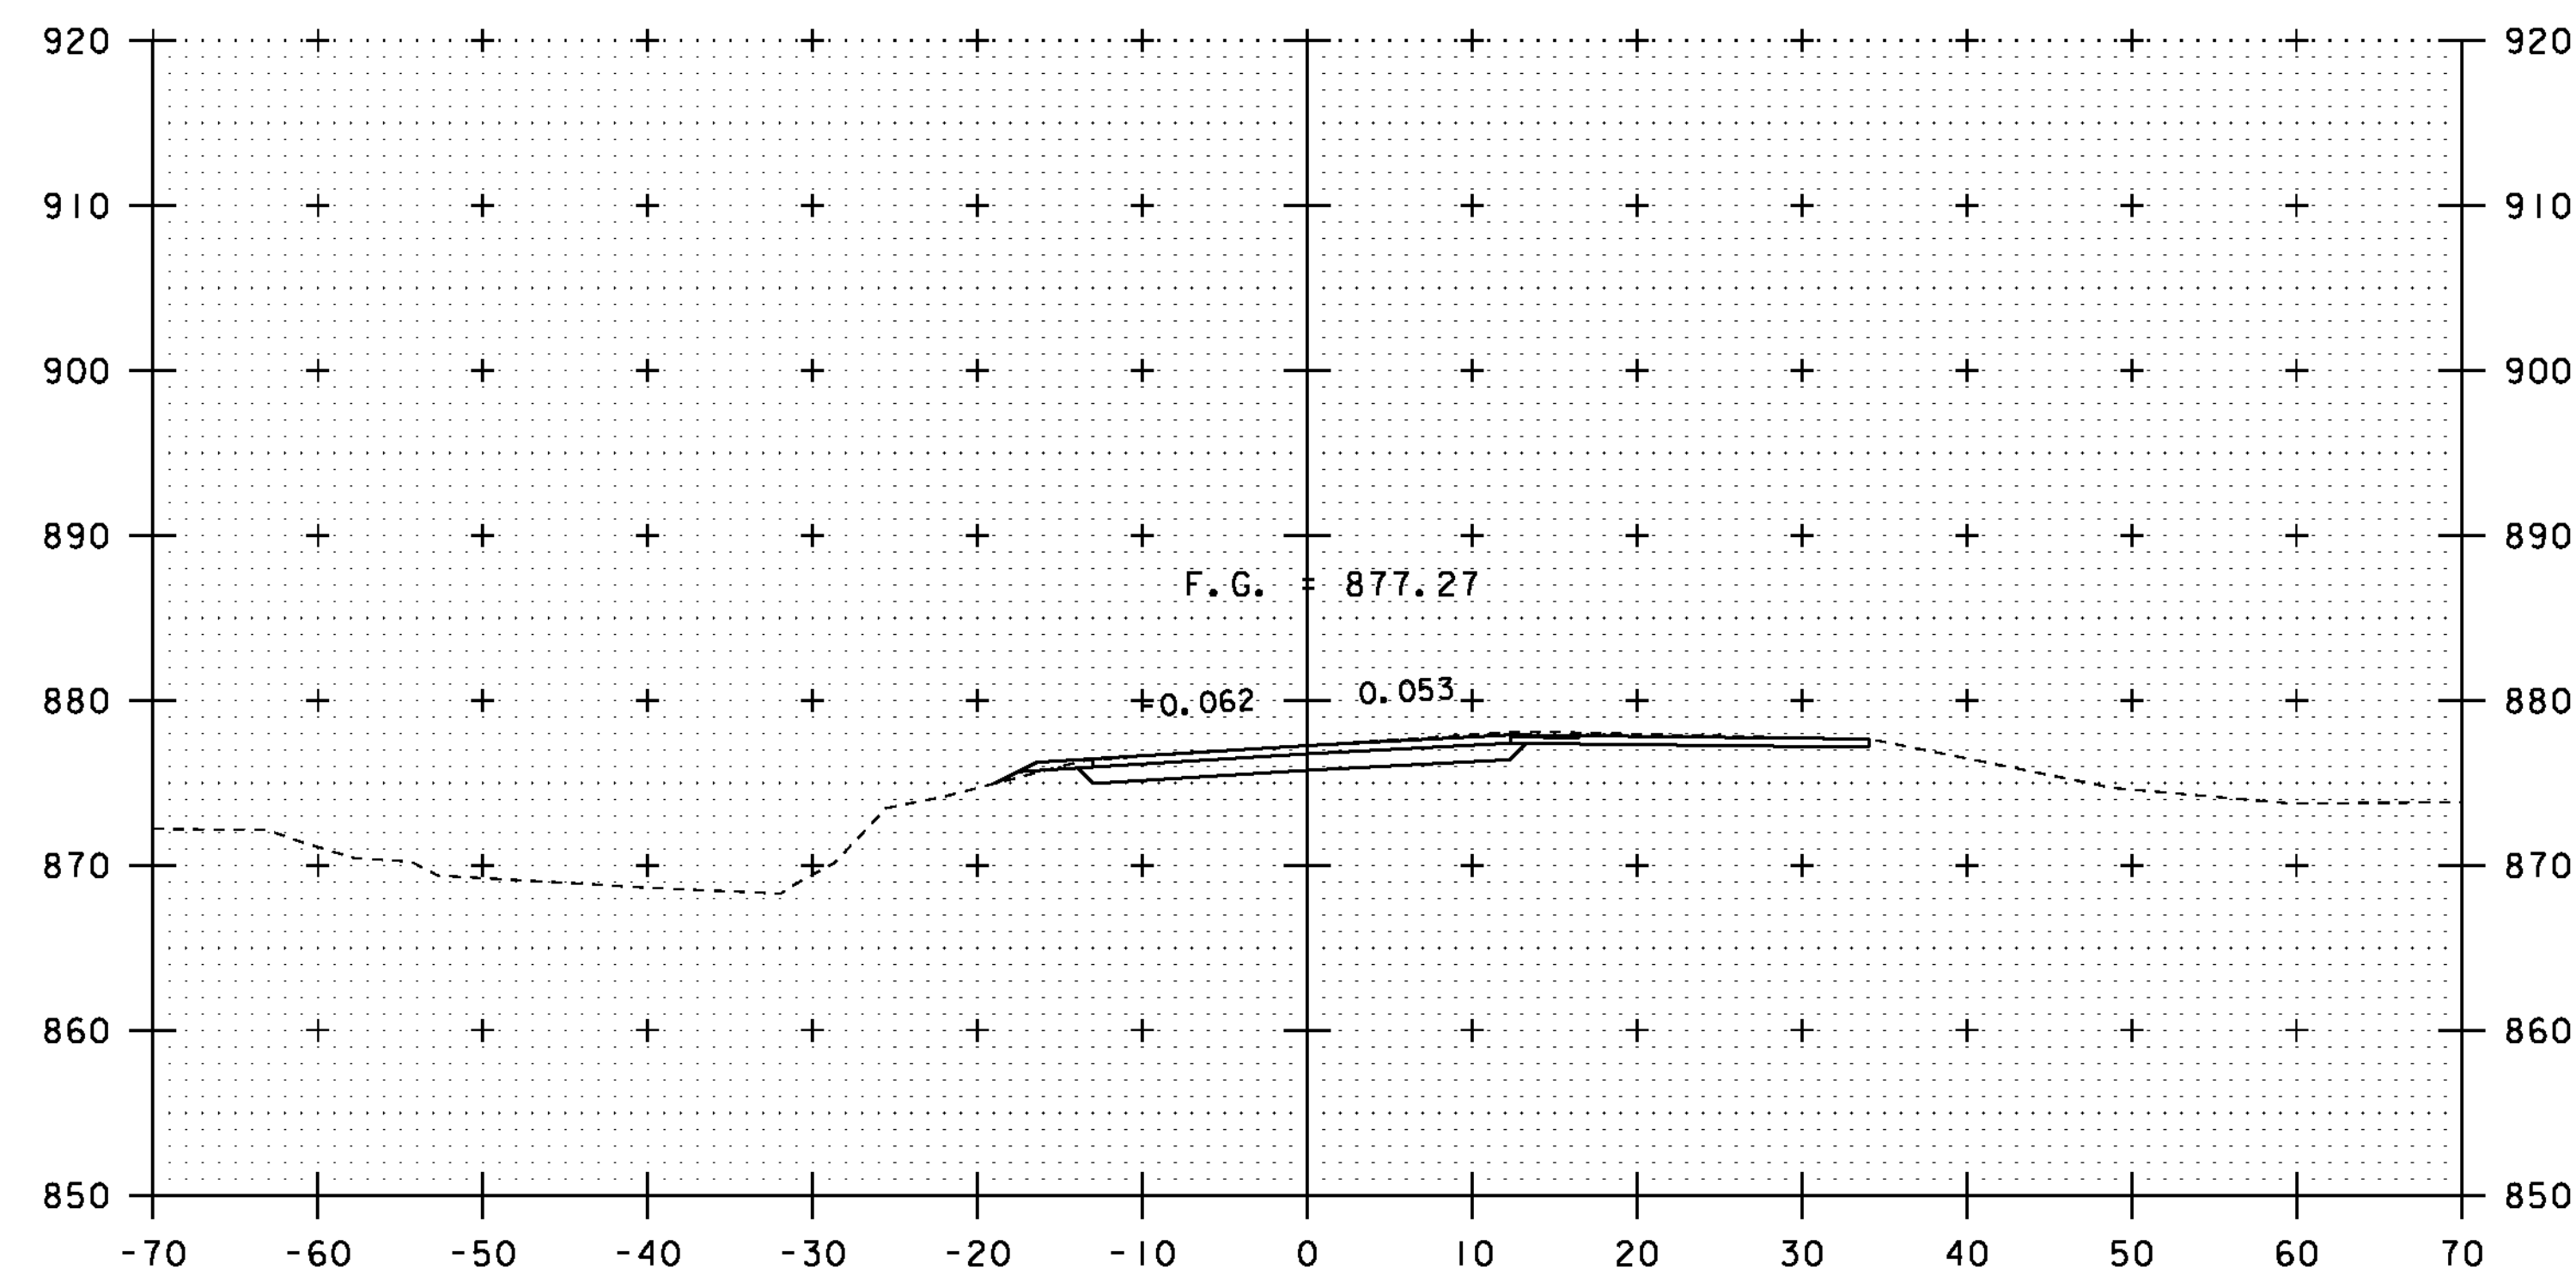


6+25

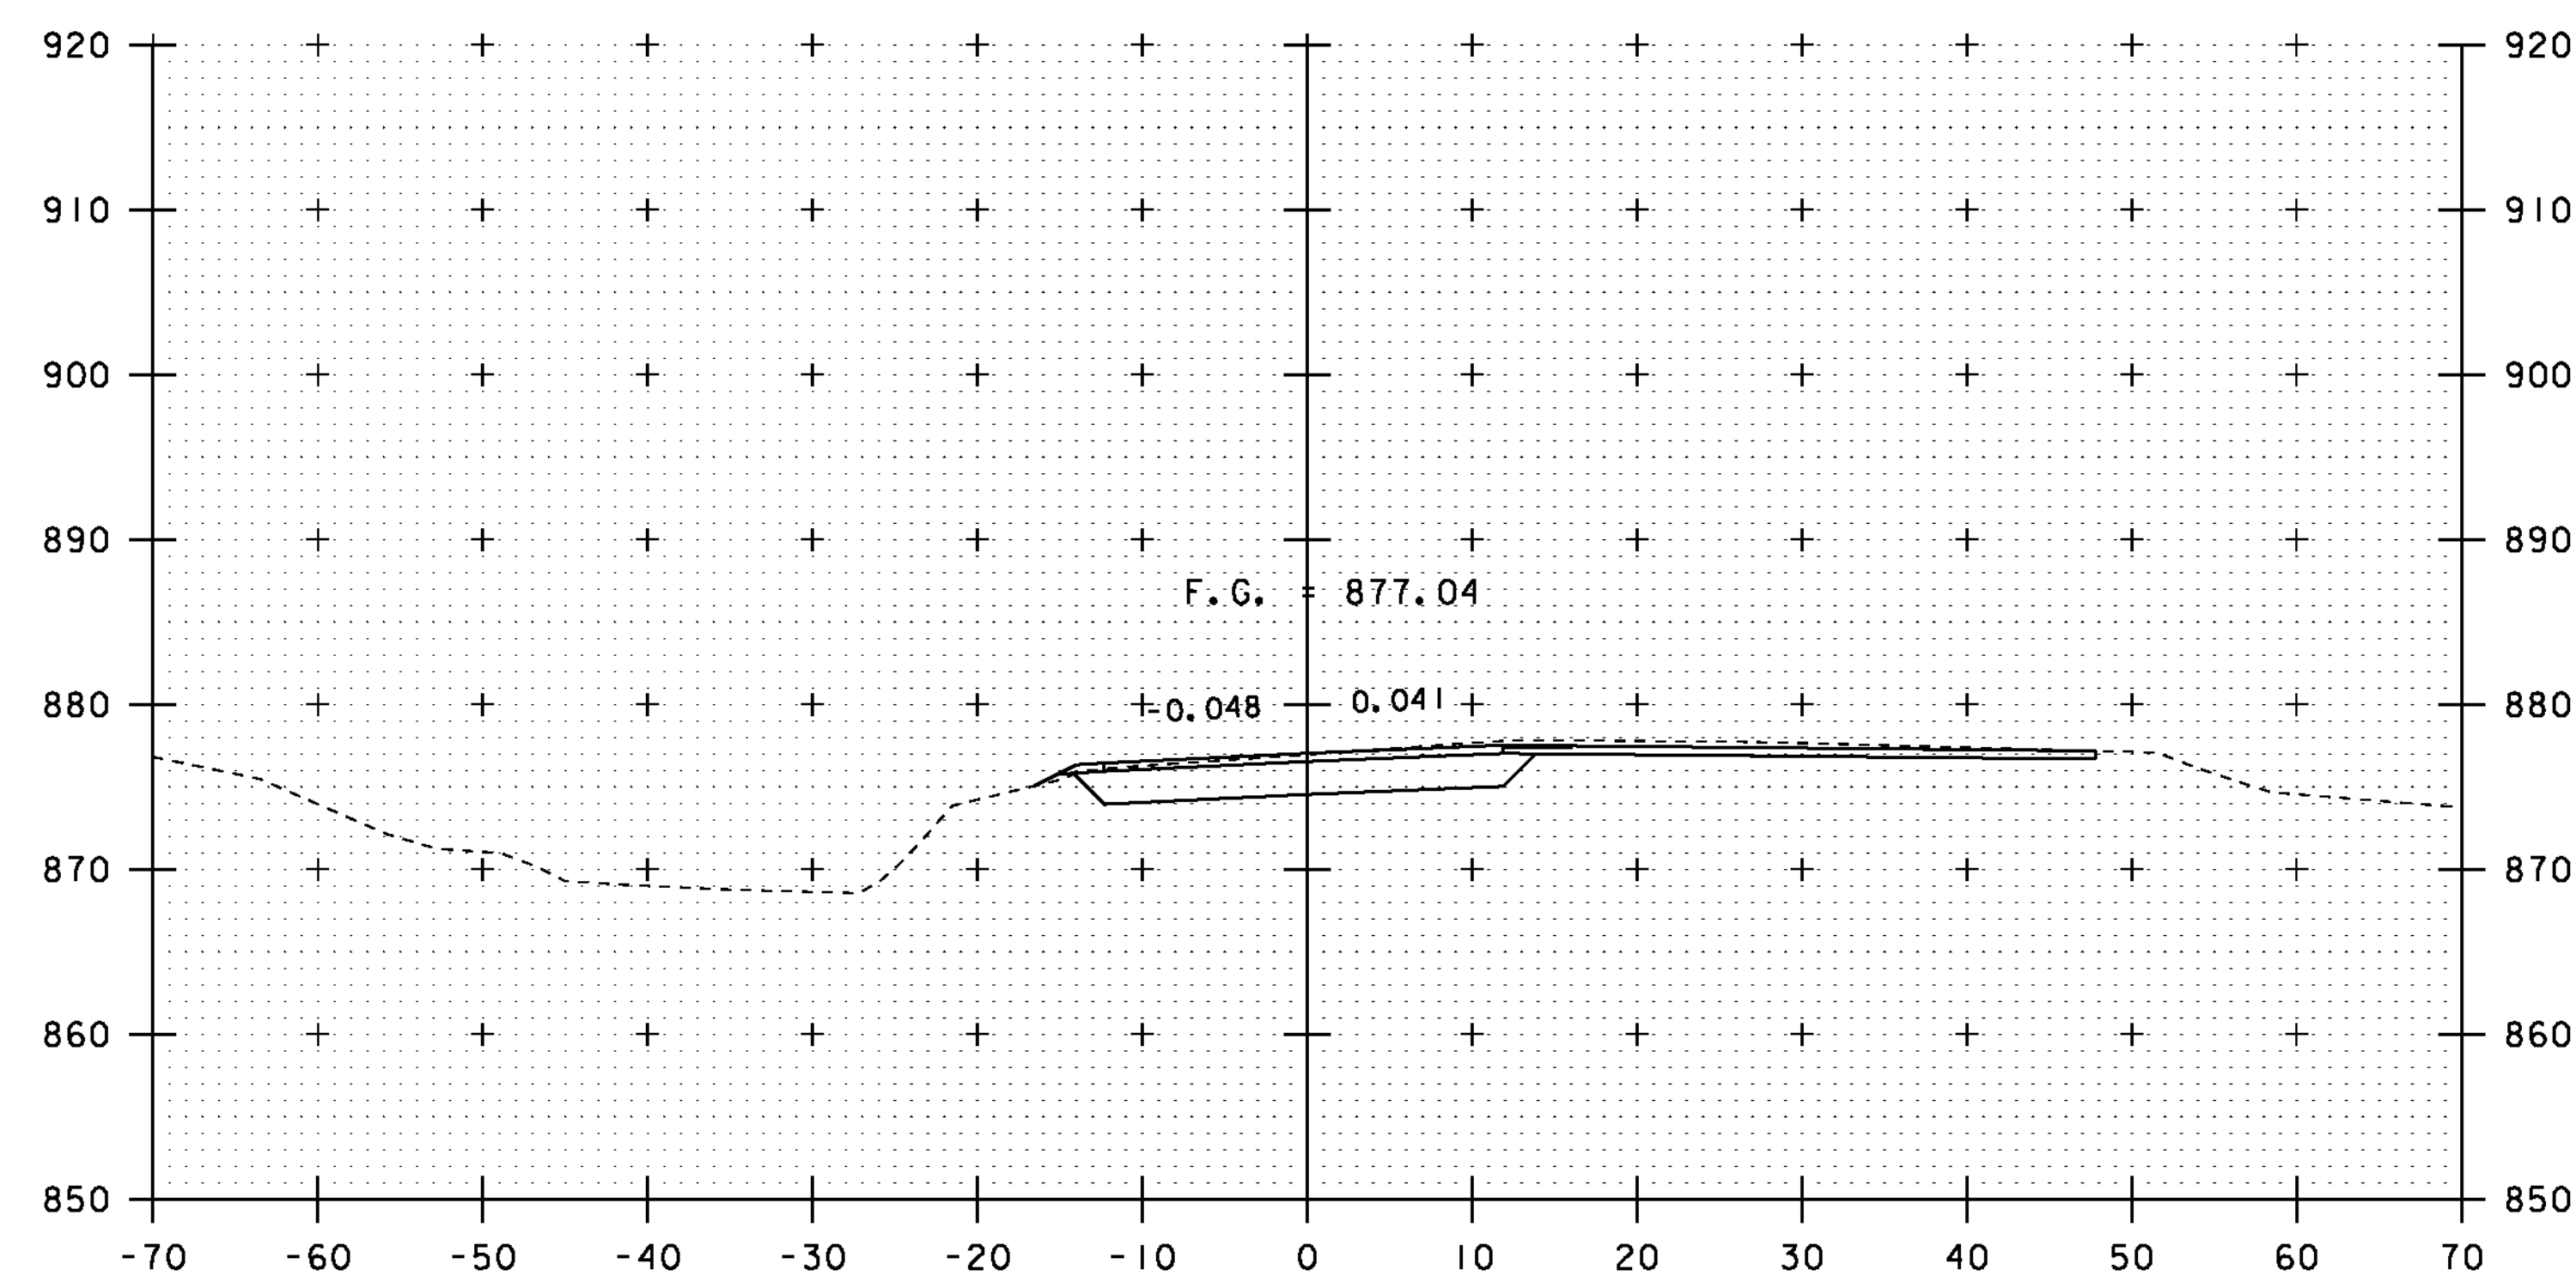


6+00

END PRECAST CONCRETE STRUCTURE (WINGWALL NO.3)
STA 5+99.30 LT
END PERMANENT STEEL SHEET PILING
STA 6+00.0 LT

END PROJECT
BEGIN APPROACH
STA 6+00.00

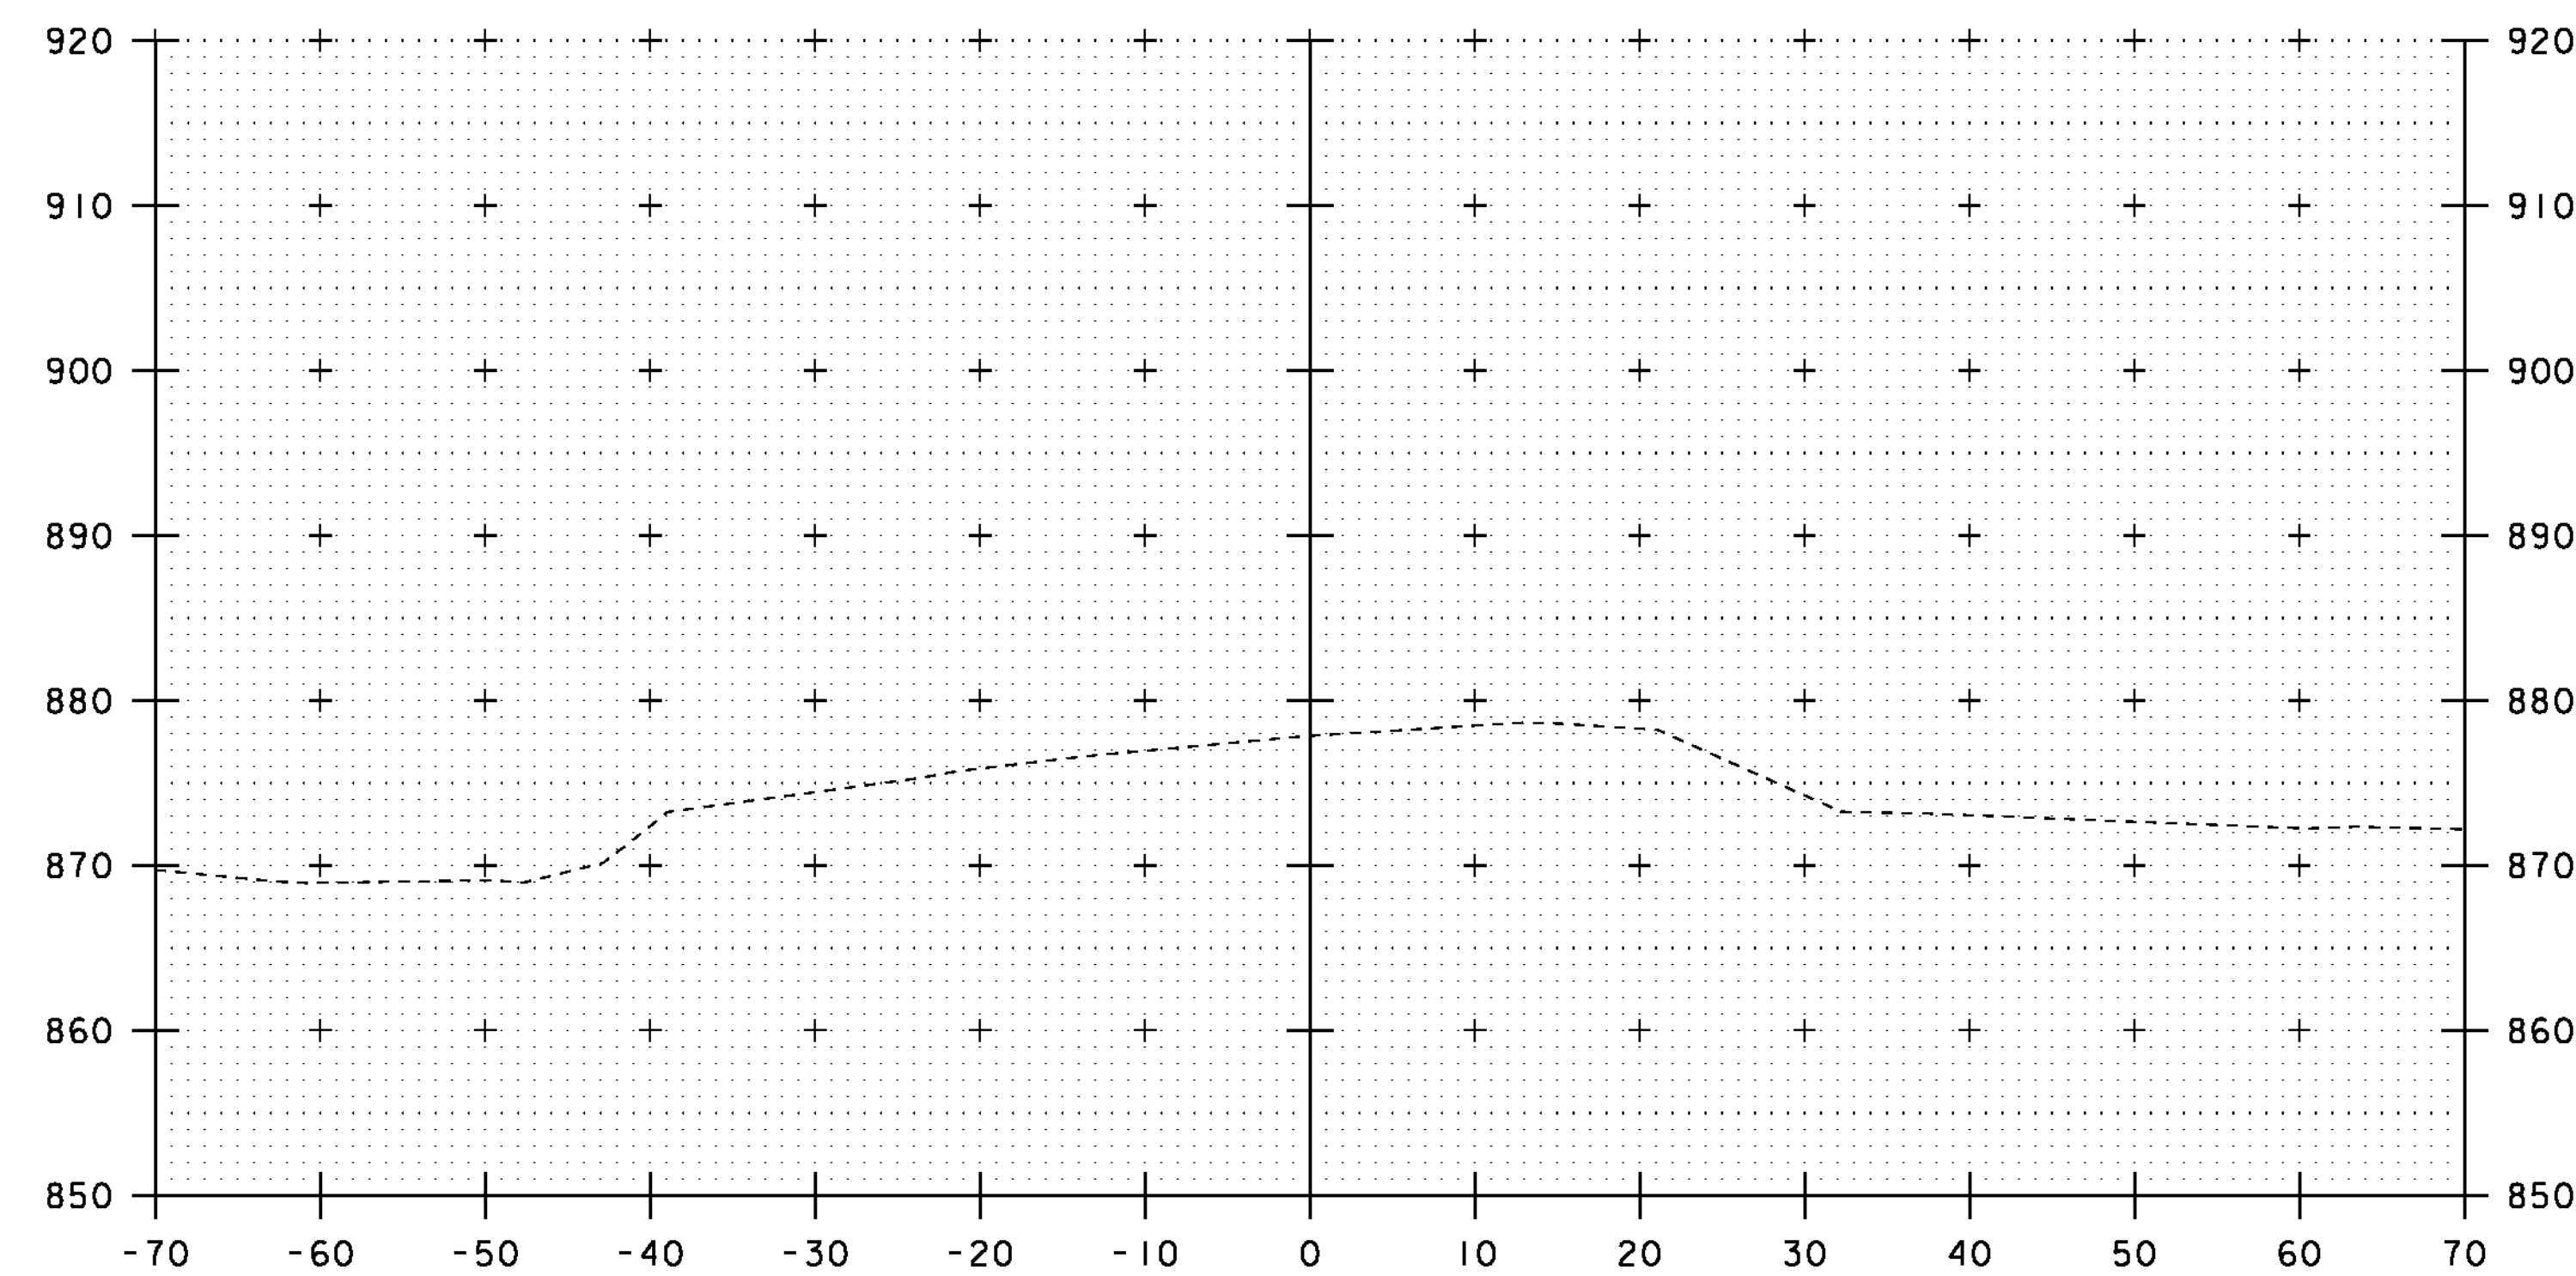

6+75

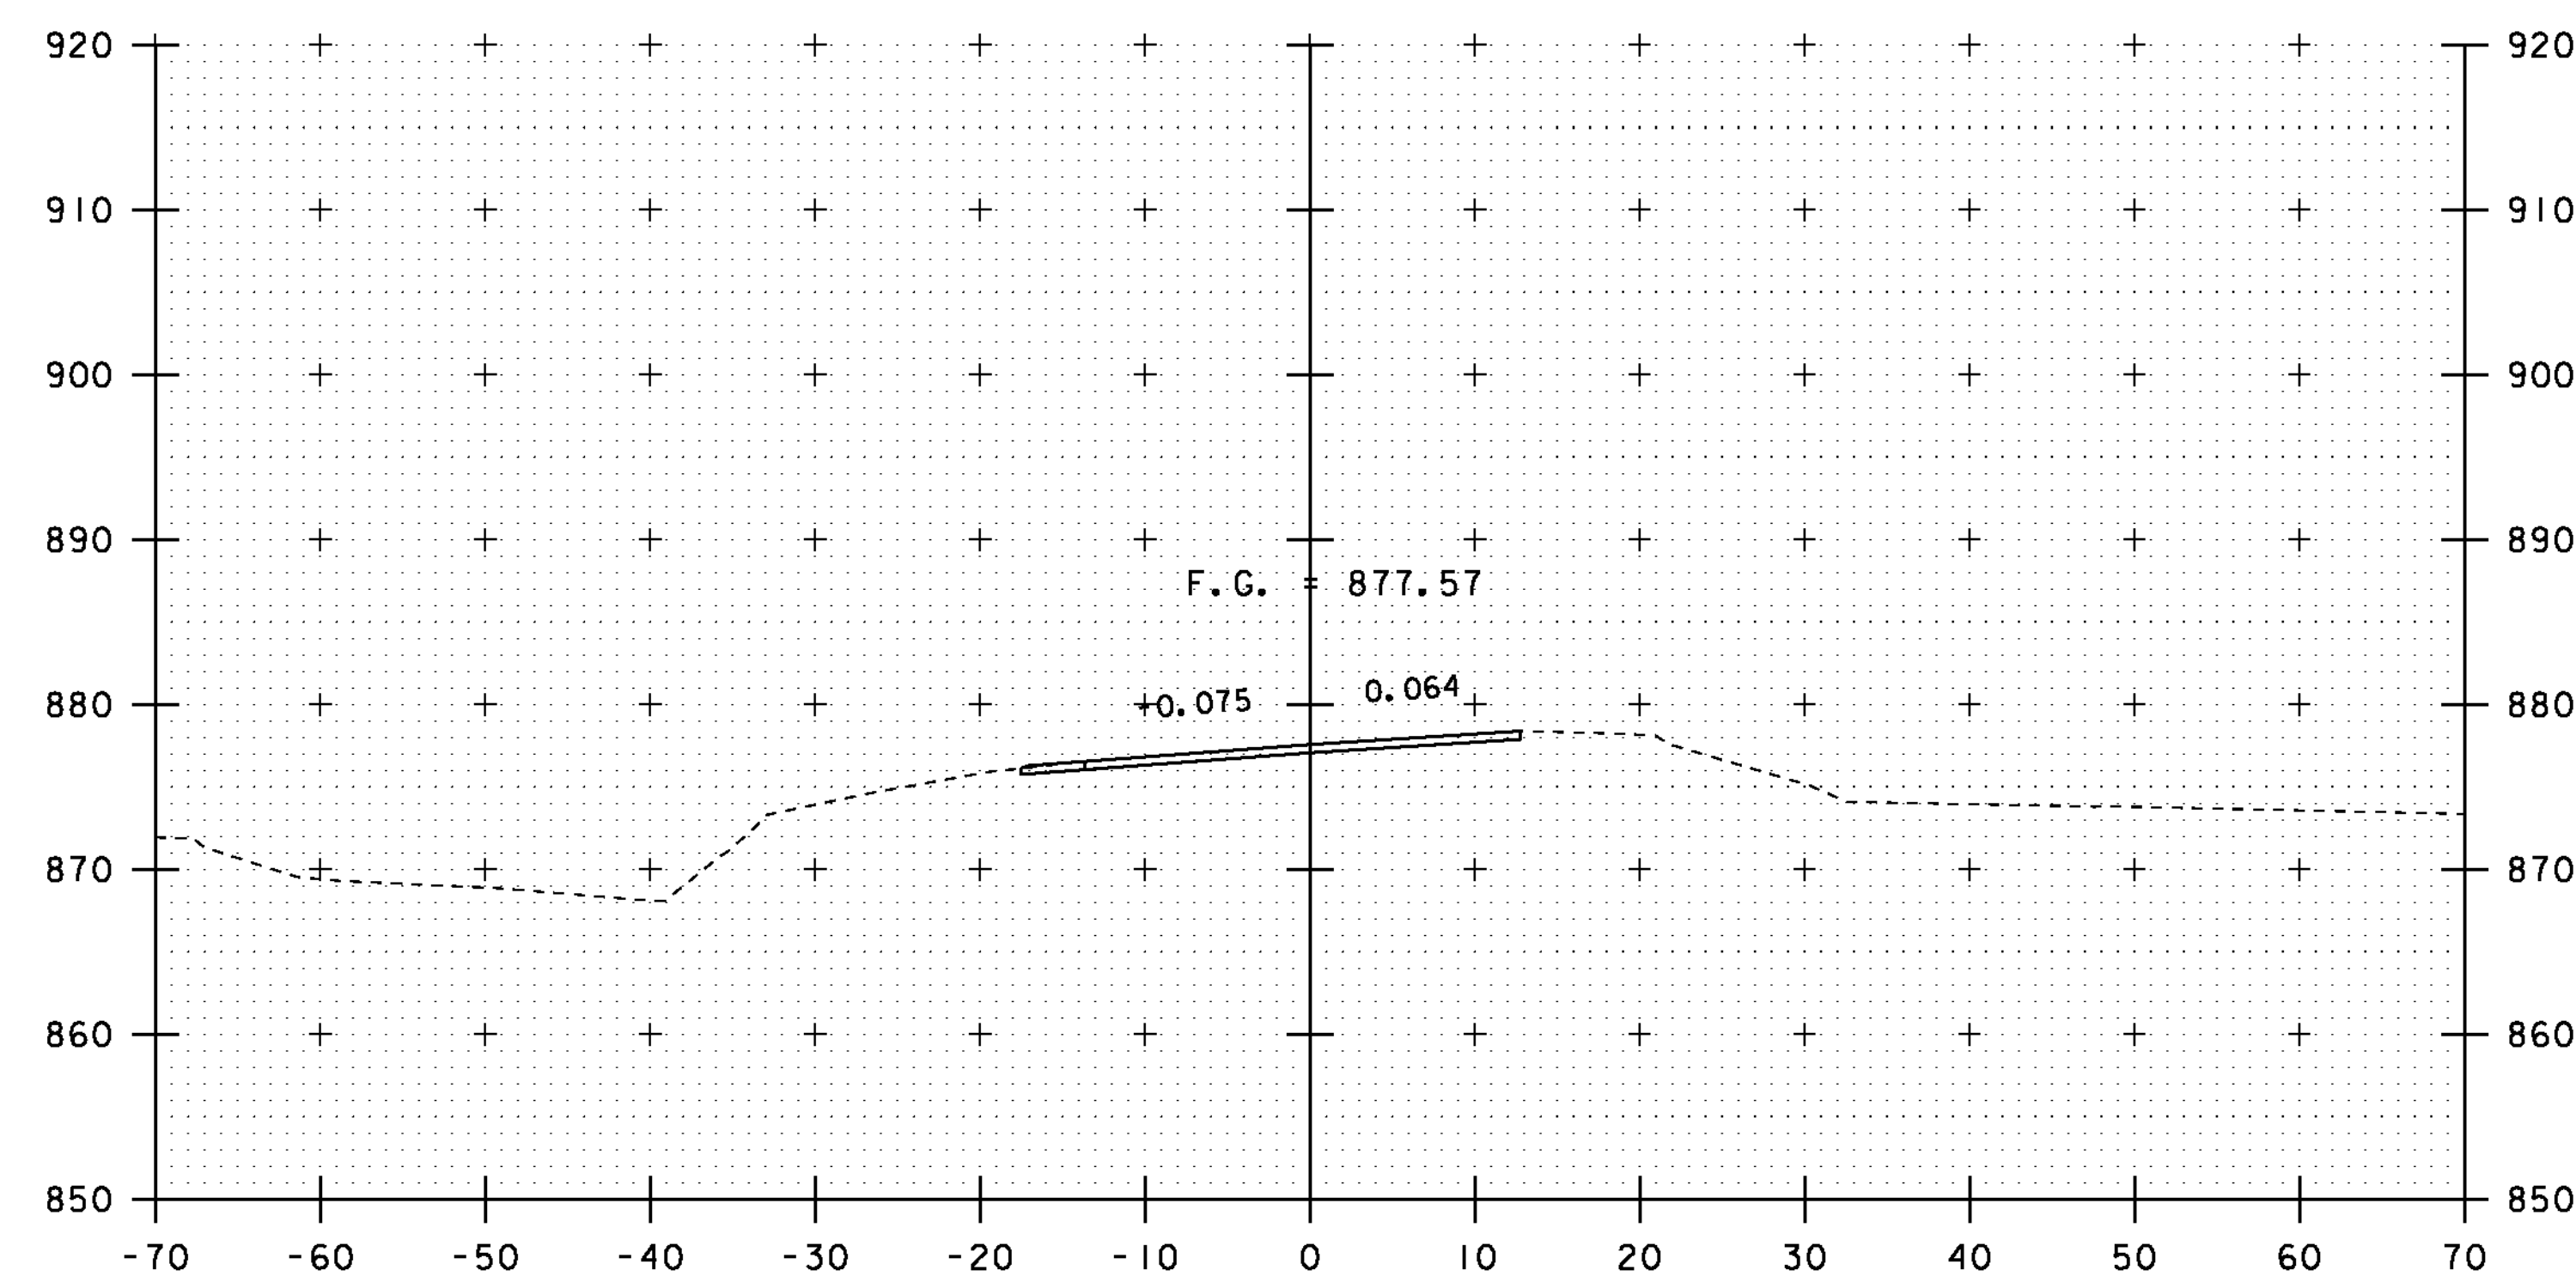

6+50

END APPROACH
MATCH EXISTING
STA 6+50.00

PROJECT NAME: ROXBURY	
PROJECT NUMBER: BHF 0187(8)	
FILE NAME: sl0c420xsl.dgn	PLOT DATE: 21-SEP-2011
PROJECT LEADER: C. P. WILLIAMS	DRAWN BY: G. ROY
DESIGNED BY: G. ROY	CHECKED BY: T. FILLBACH
VT 12A CROSS SECTIONS (5)	SHEET 36 OF 54

STA. 6+00 TO STA. 6+75