




50+40

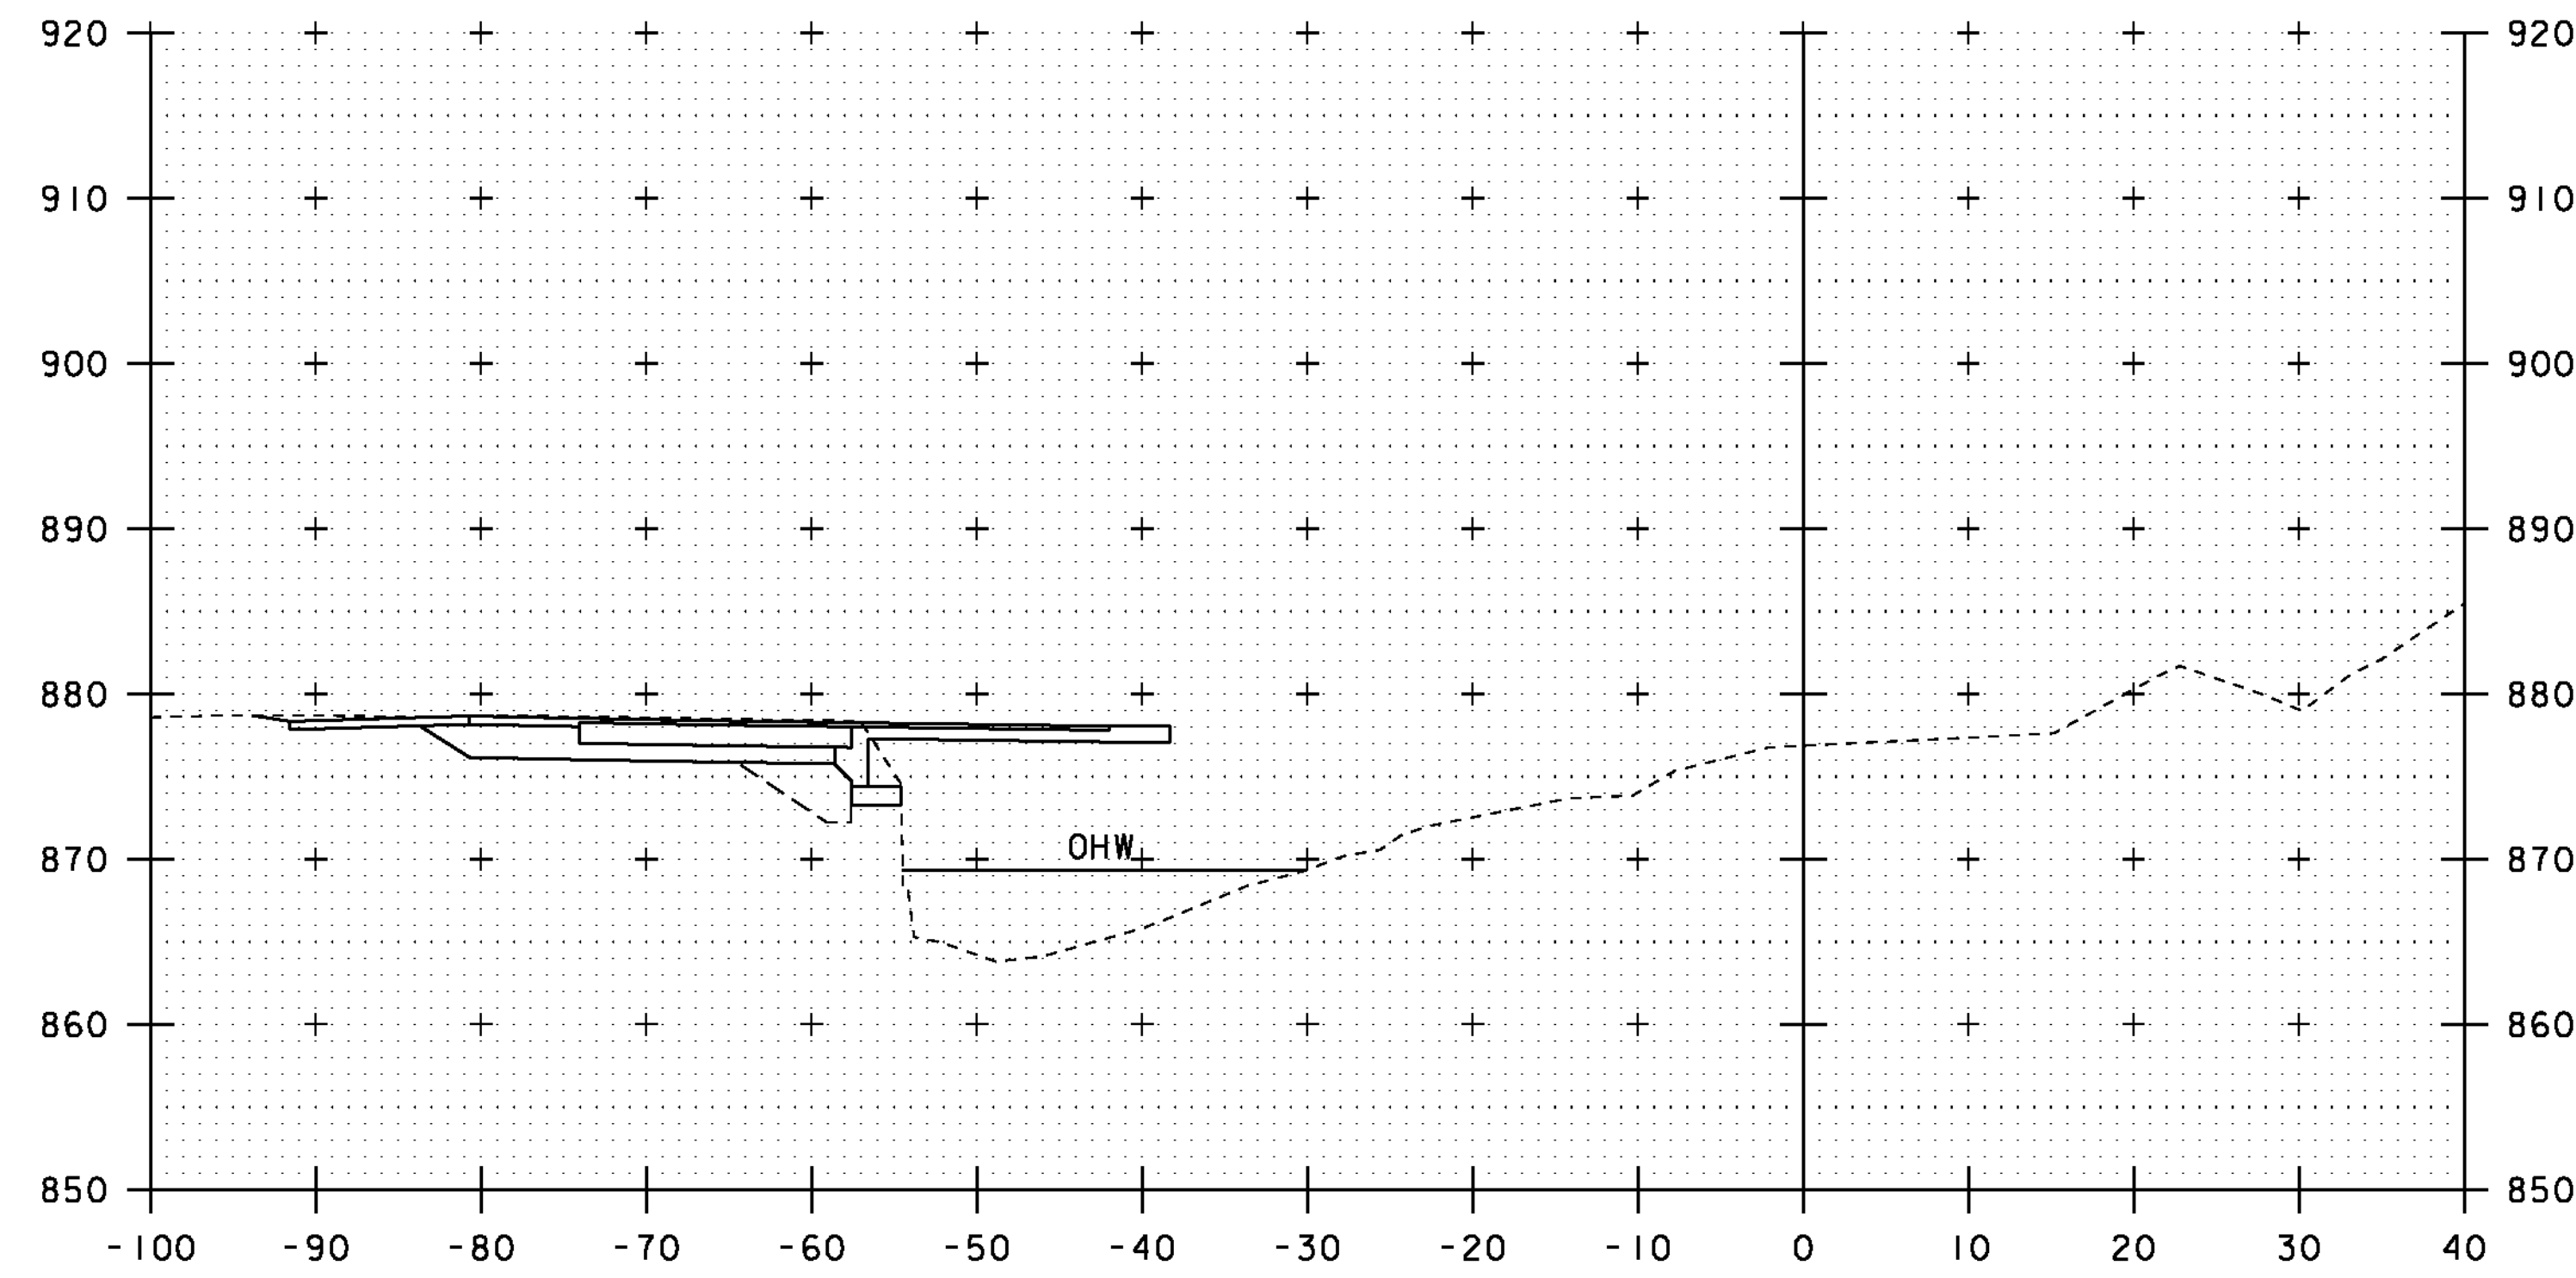


50+60

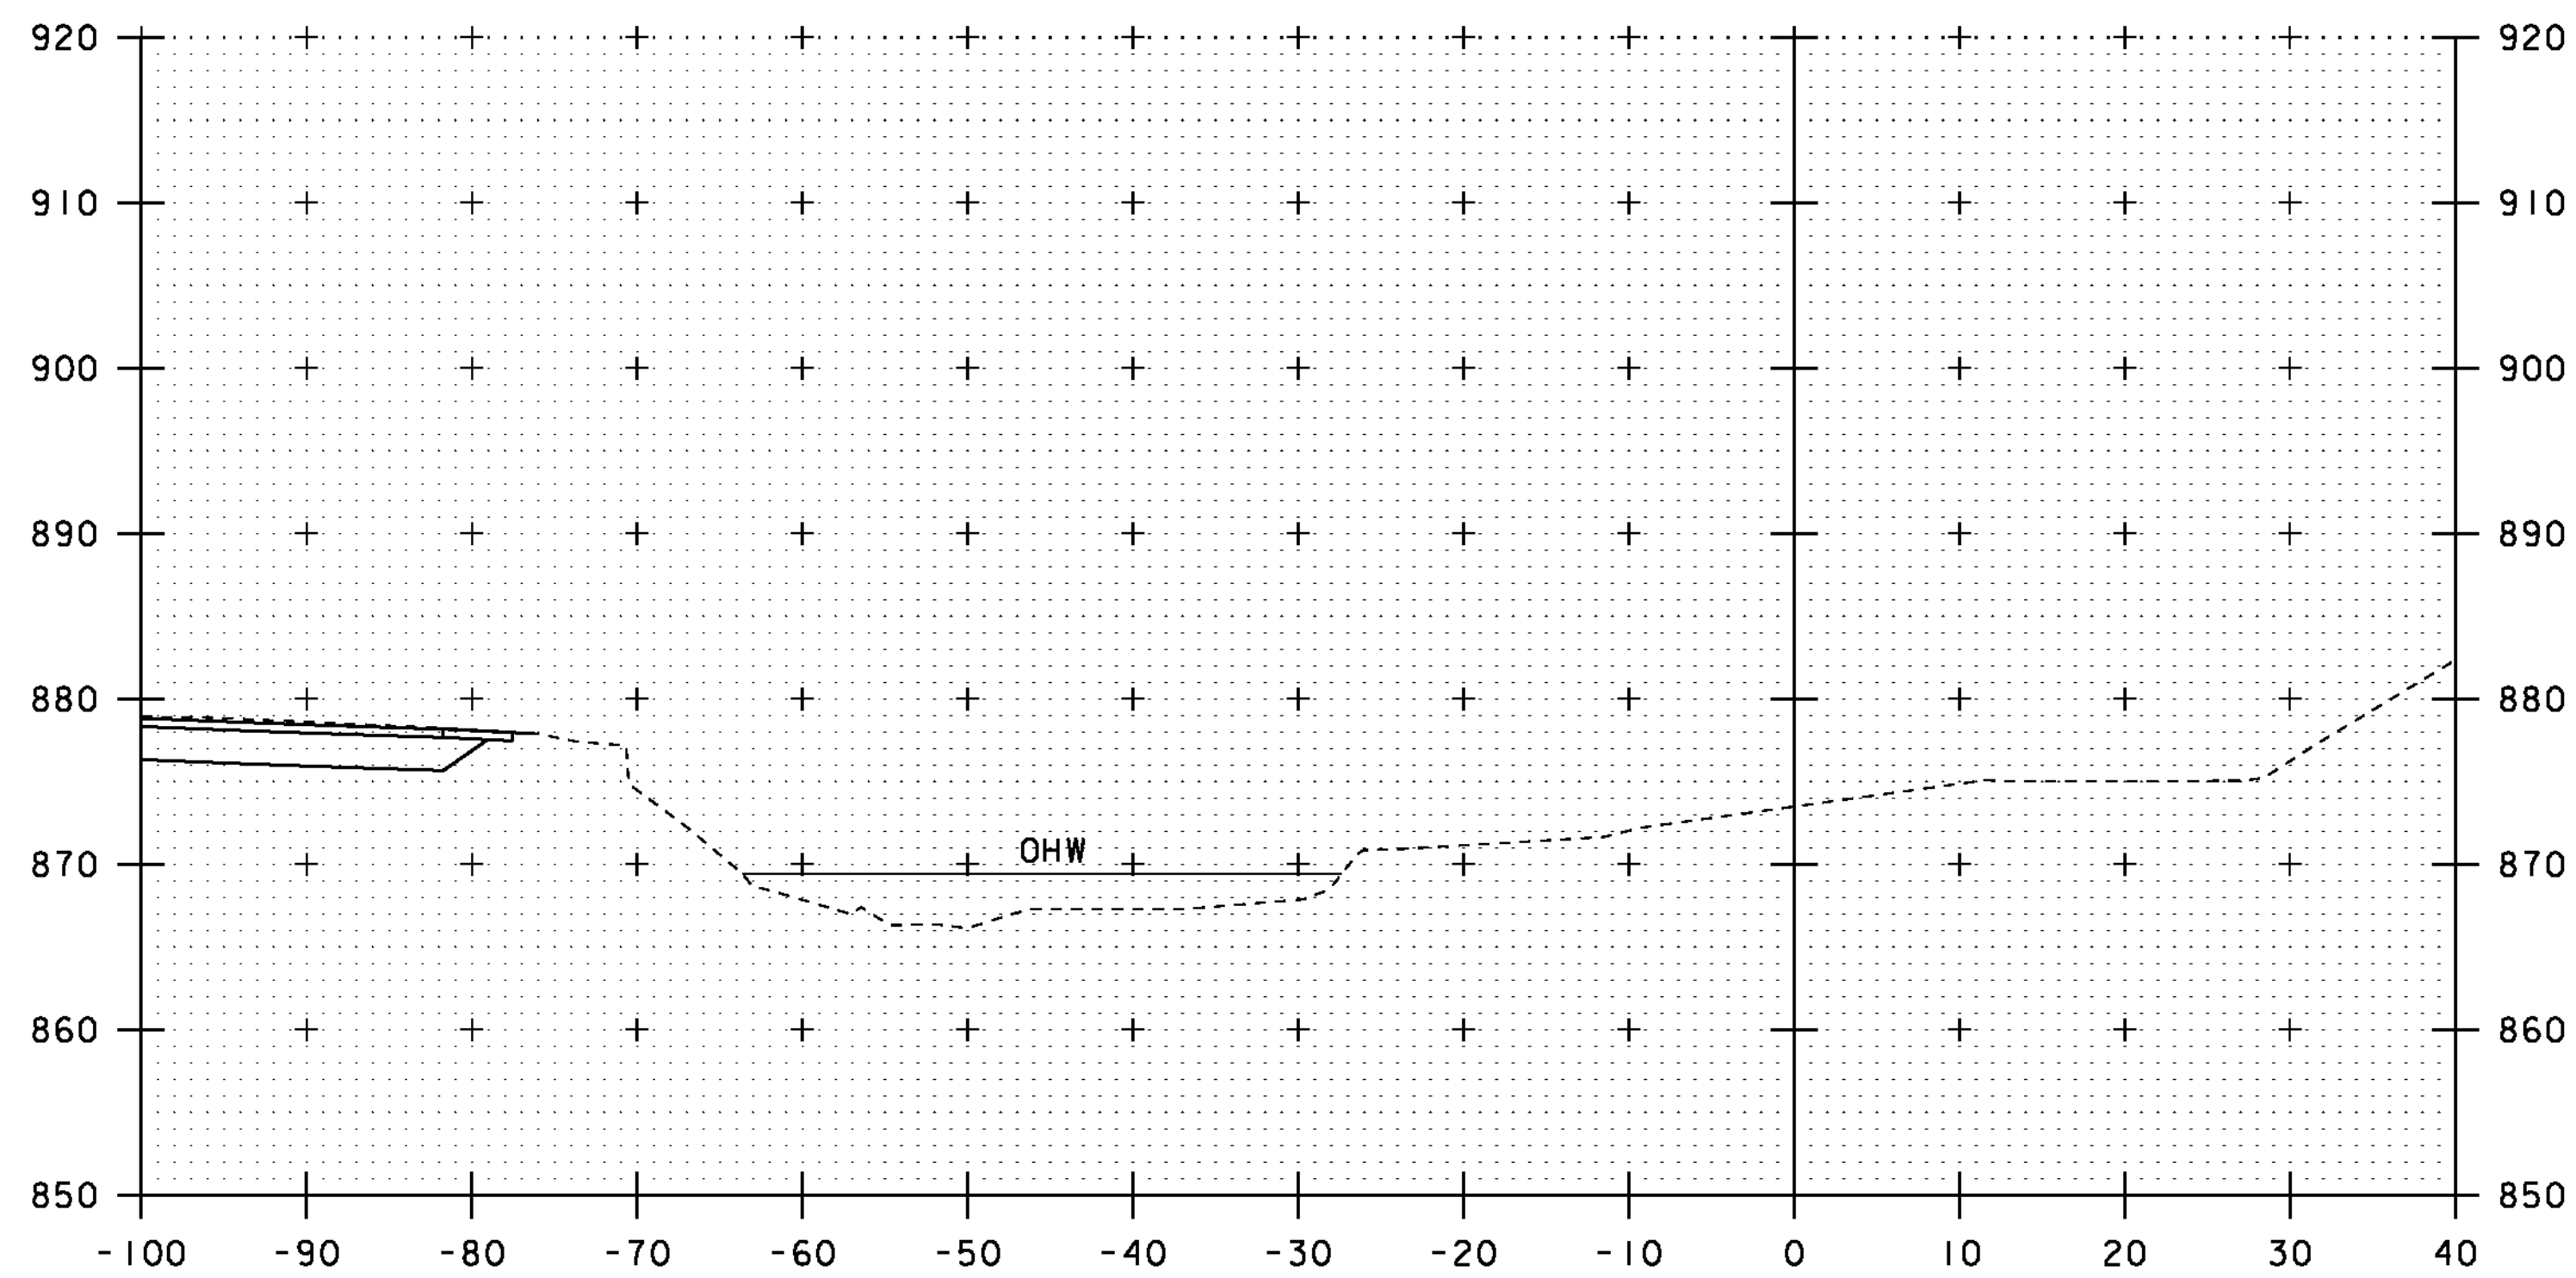

50+30

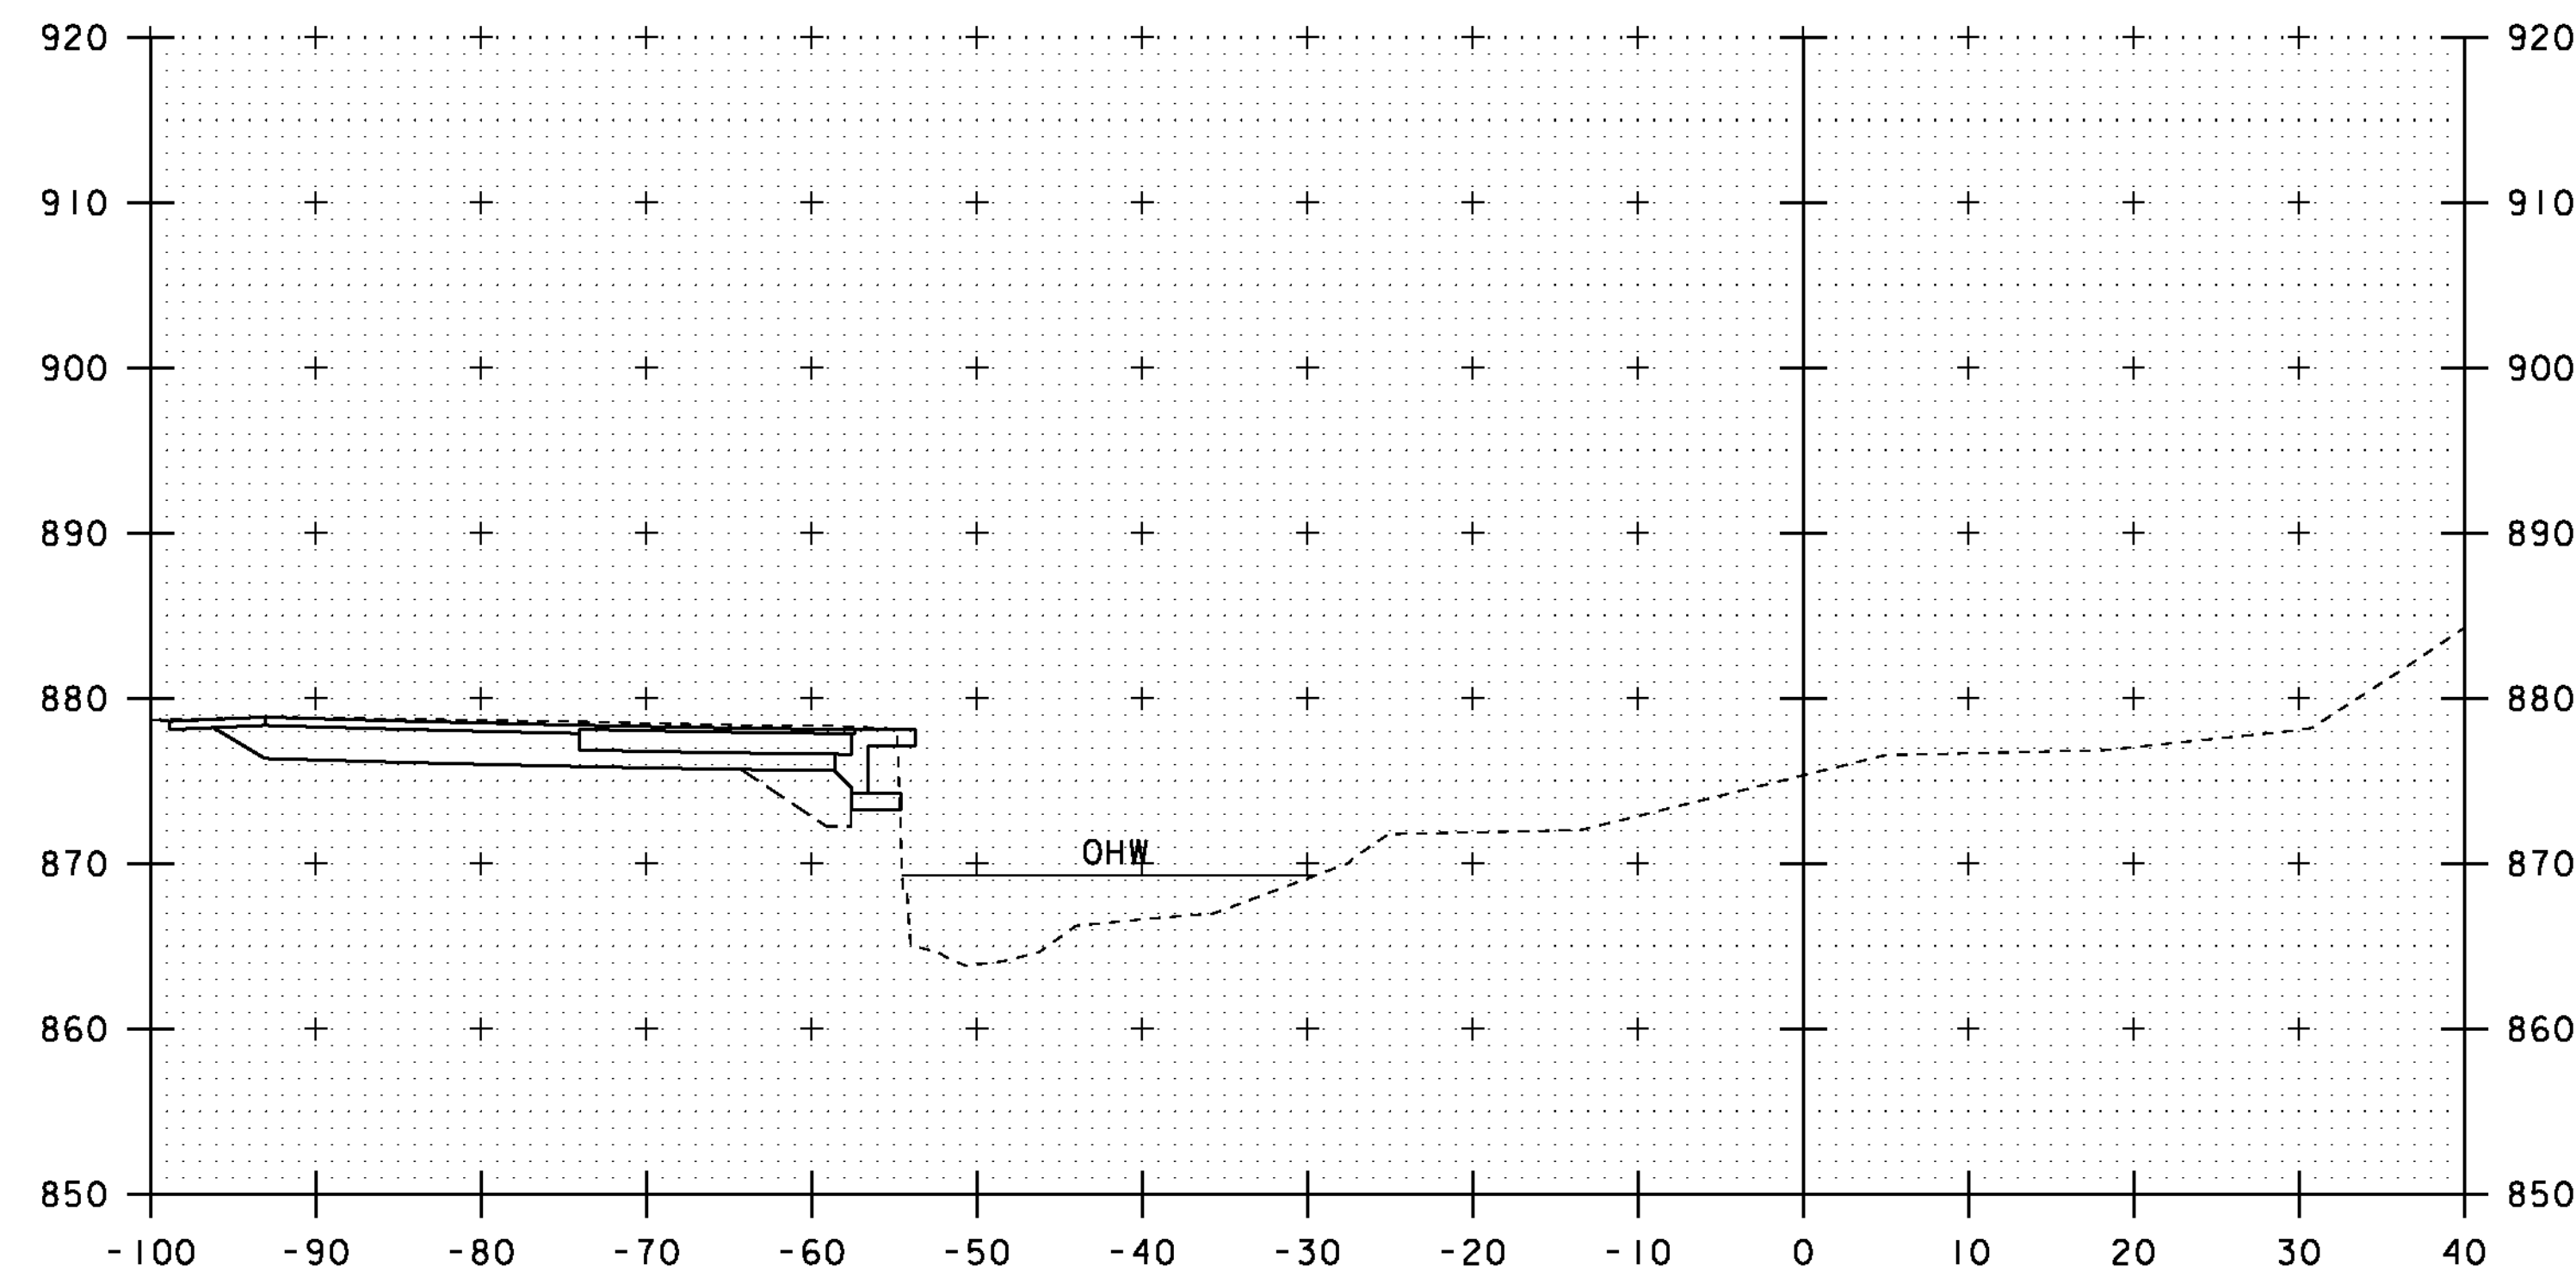

50+50

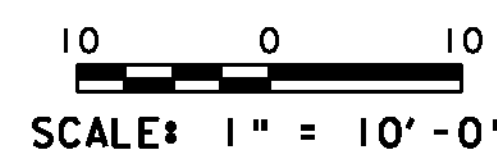

STA. 50+30 TO STA. 50+60

PROJECT NAME: ROXBURY	PLOT DATE: 21-SEP-2011
PROJECT NUMBER: BHF 0187(8)	DRAWN BY: G. ROY
FILE NAME: sl0c420xsl.dgn	CHECKED BY: T. FILLBACH
PROJECT LEADER: C. P. WILLIAMS	SHEET 38 OF 54
DESIGNED BY: G. ROY	
CHANNEL LINE CROSS SECTIONS (1)	