




50+80

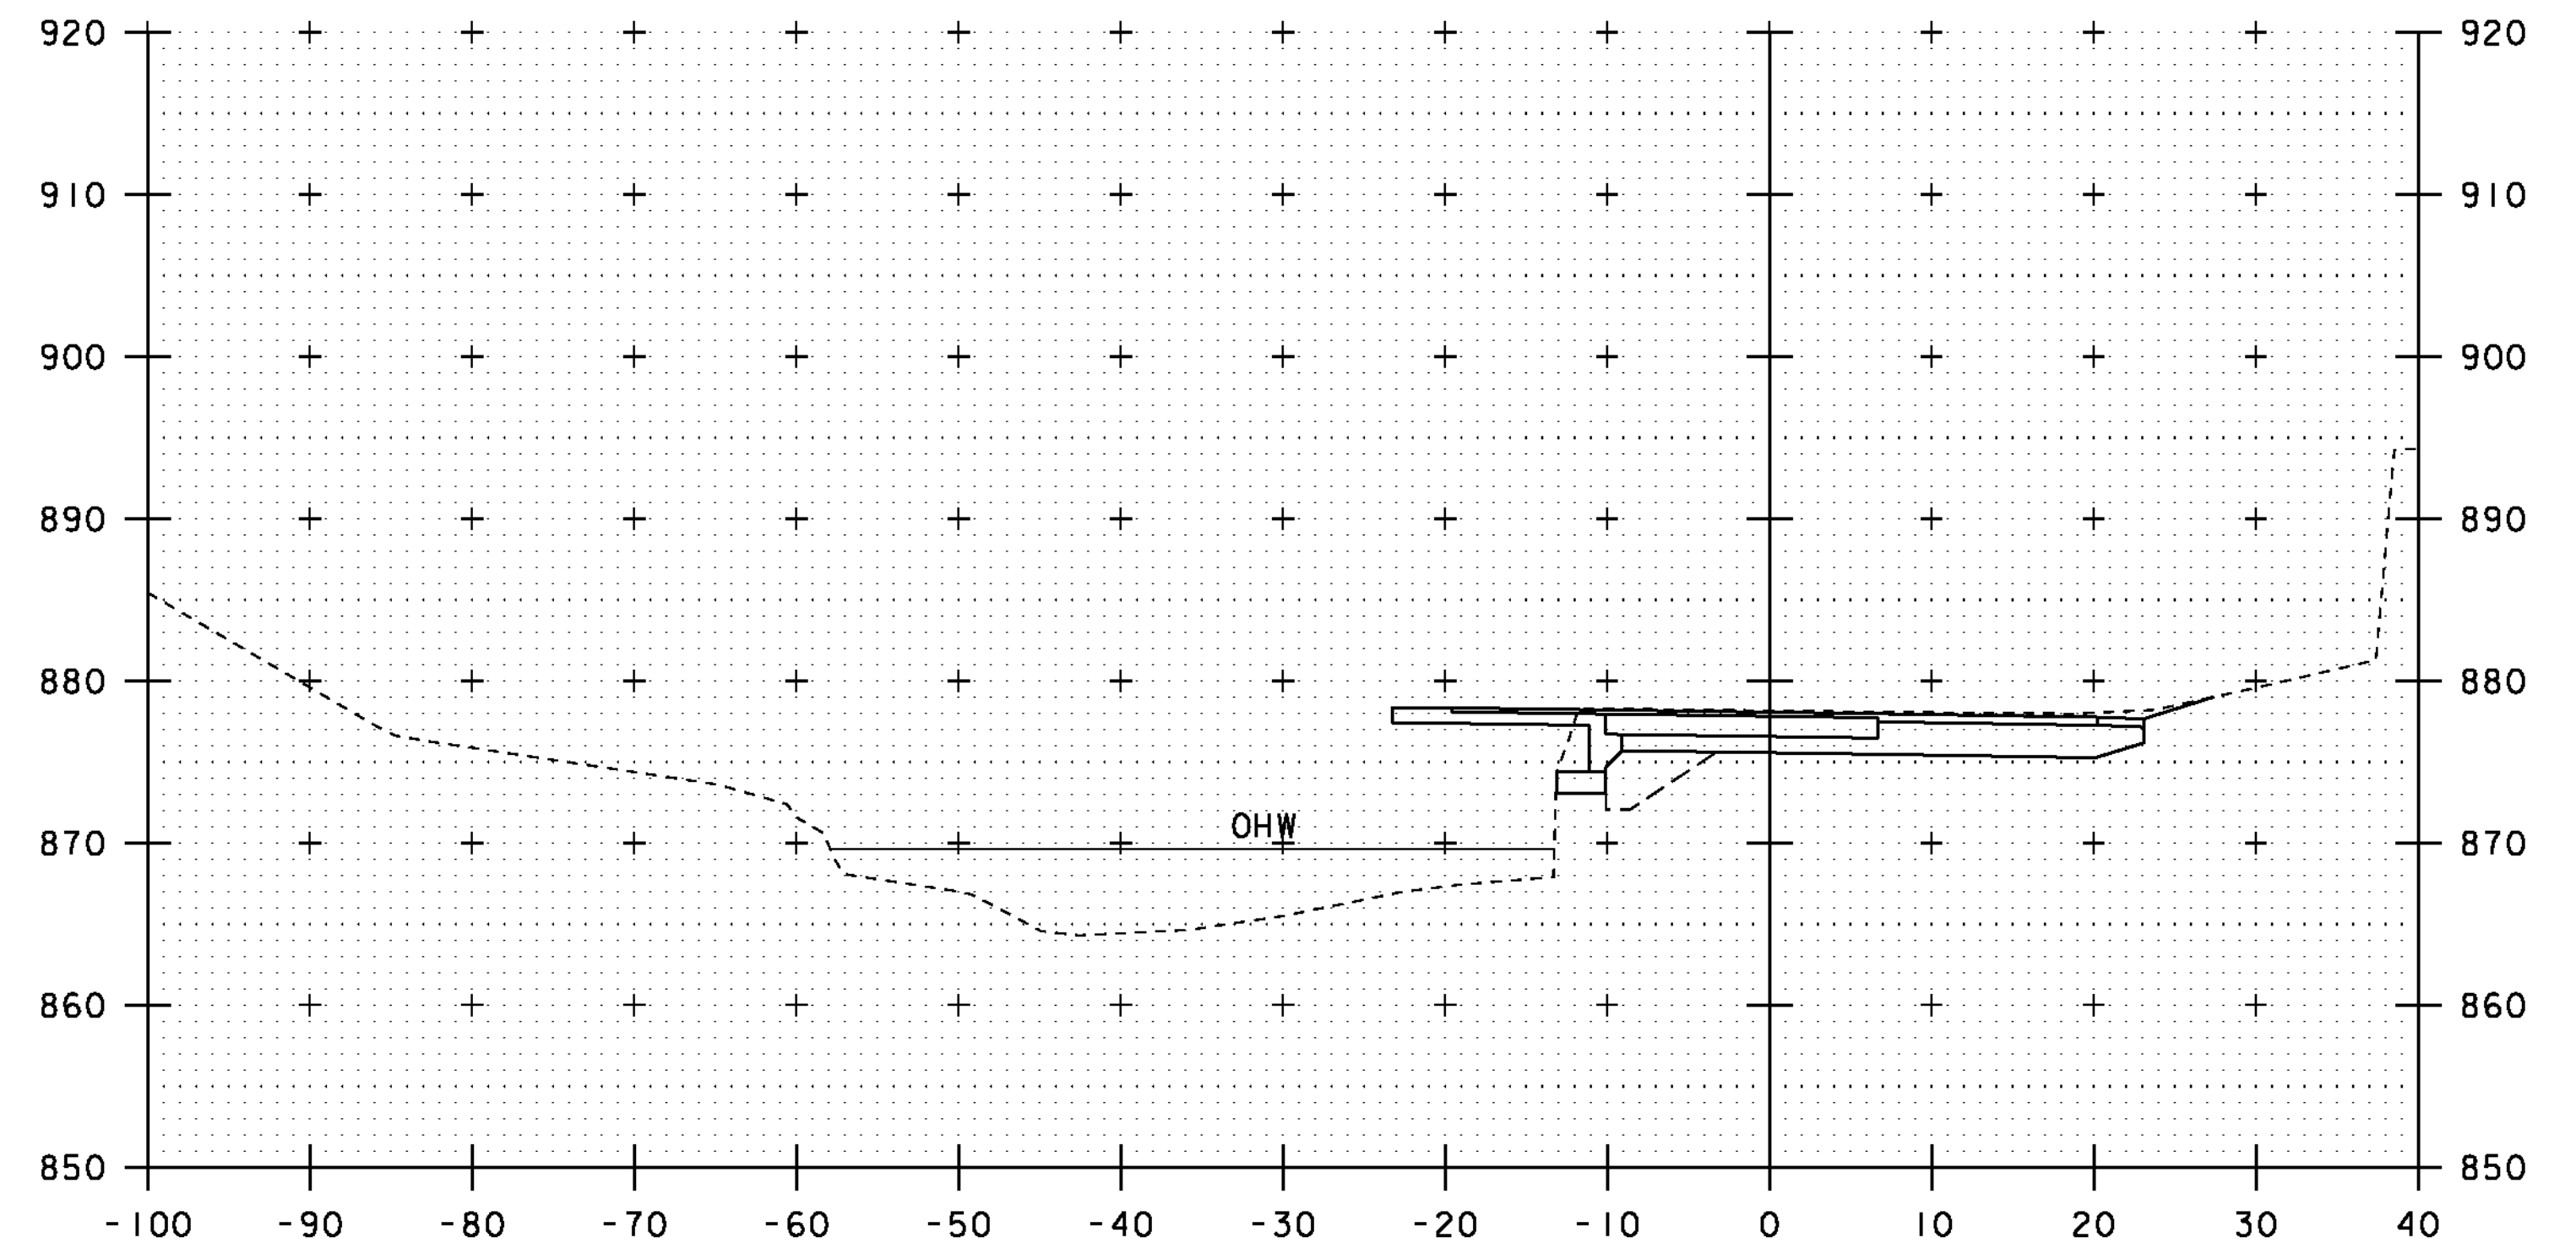

51+00

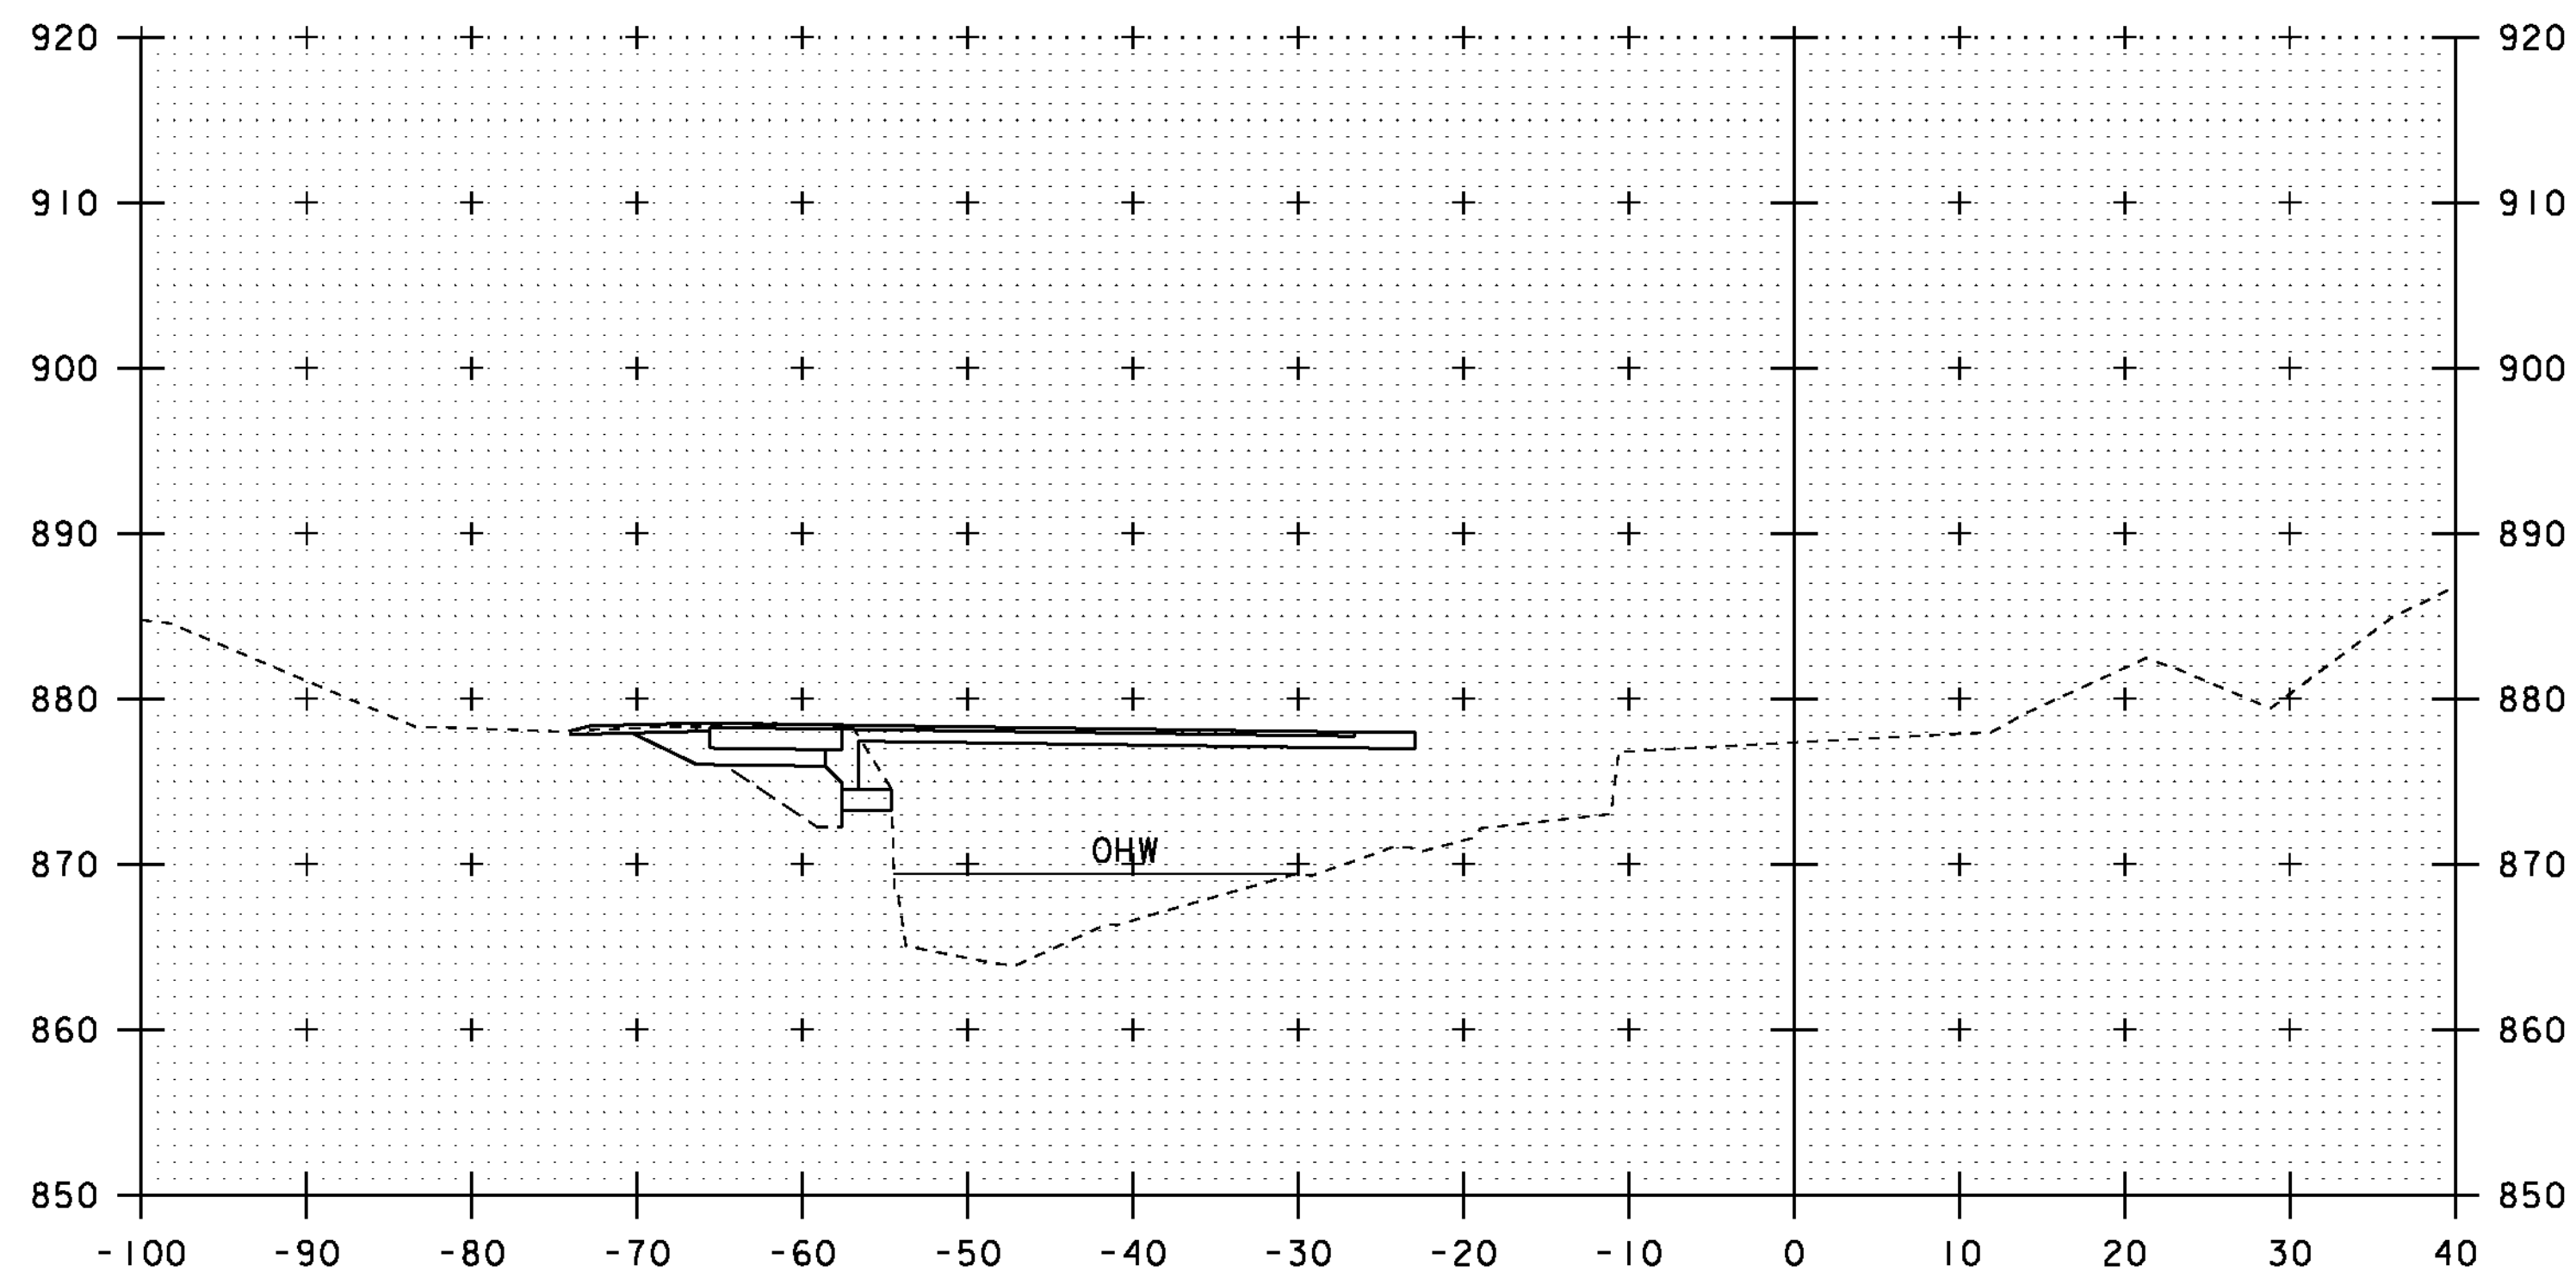

50+70

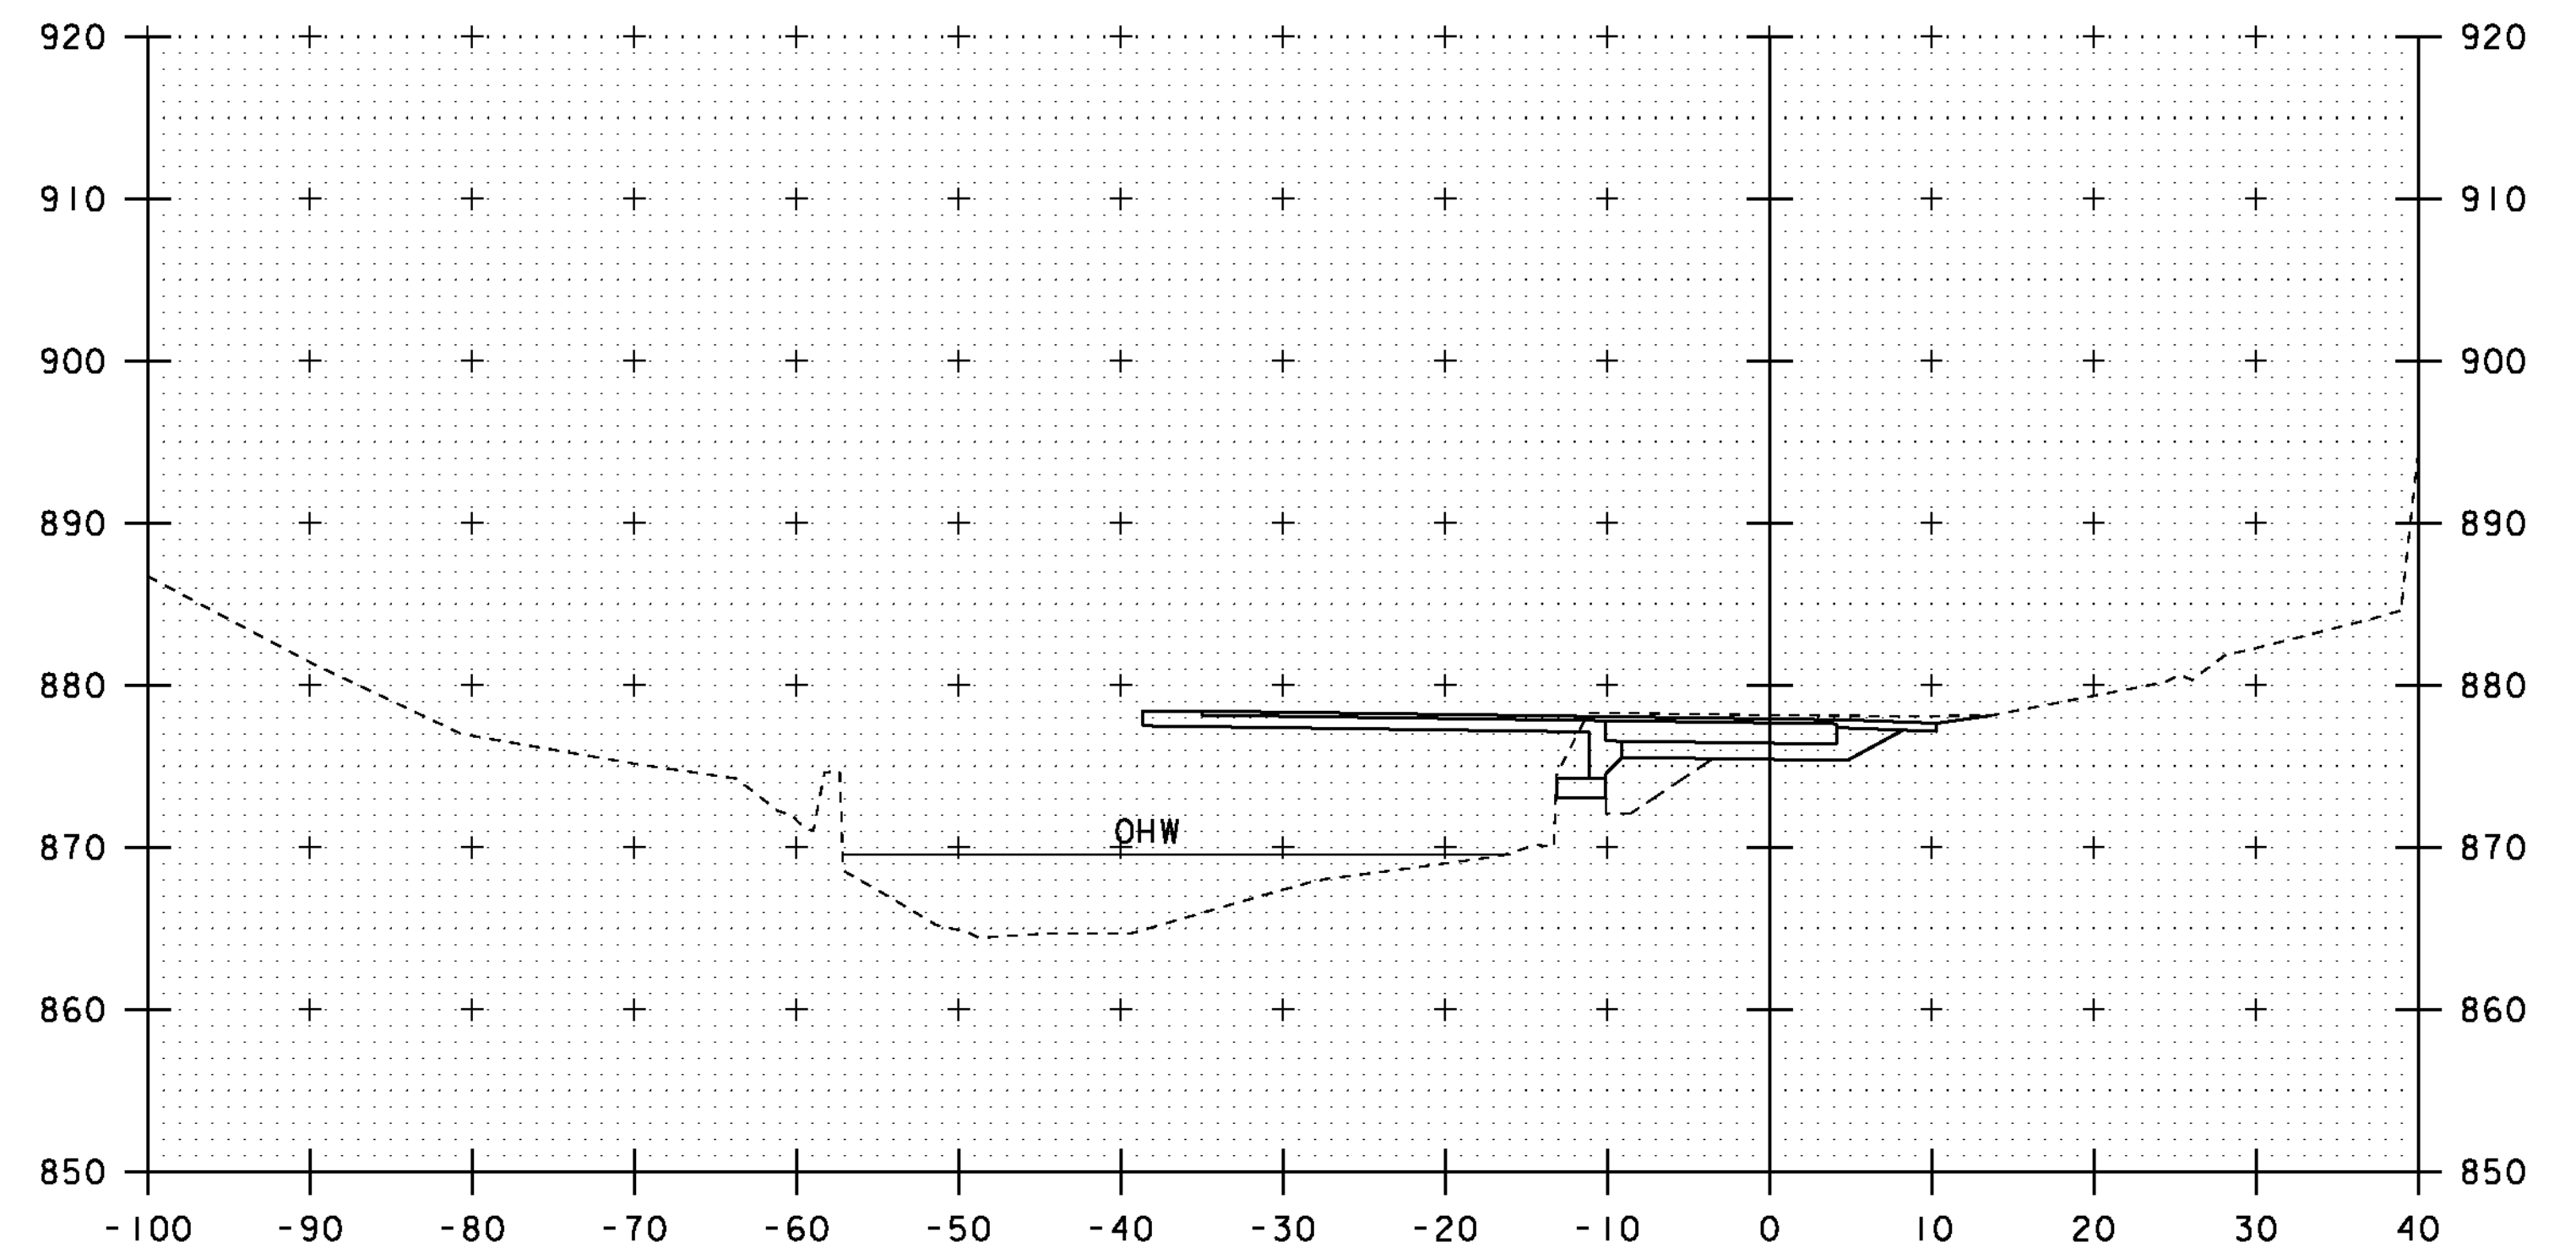

50+90



STA. 50+70 TO STA. 51+00

PROJECT NAME: ROXBURY	PLOT DATE: 21-SEP-2011
PROJECT NUMBER: BHF 0187(8)	DRAWN BY: G. ROY
FILE NAME: sl0c420xsl.dgn	CHECKED BY: T. FILLBACH
PROJECT LEADER: C. P. WILLIAMS	SHEET 39 OF 54
DESIGNED BY: G. ROY	
CHANNEL LINE CROSS SECTIONS (2)	