




51+20

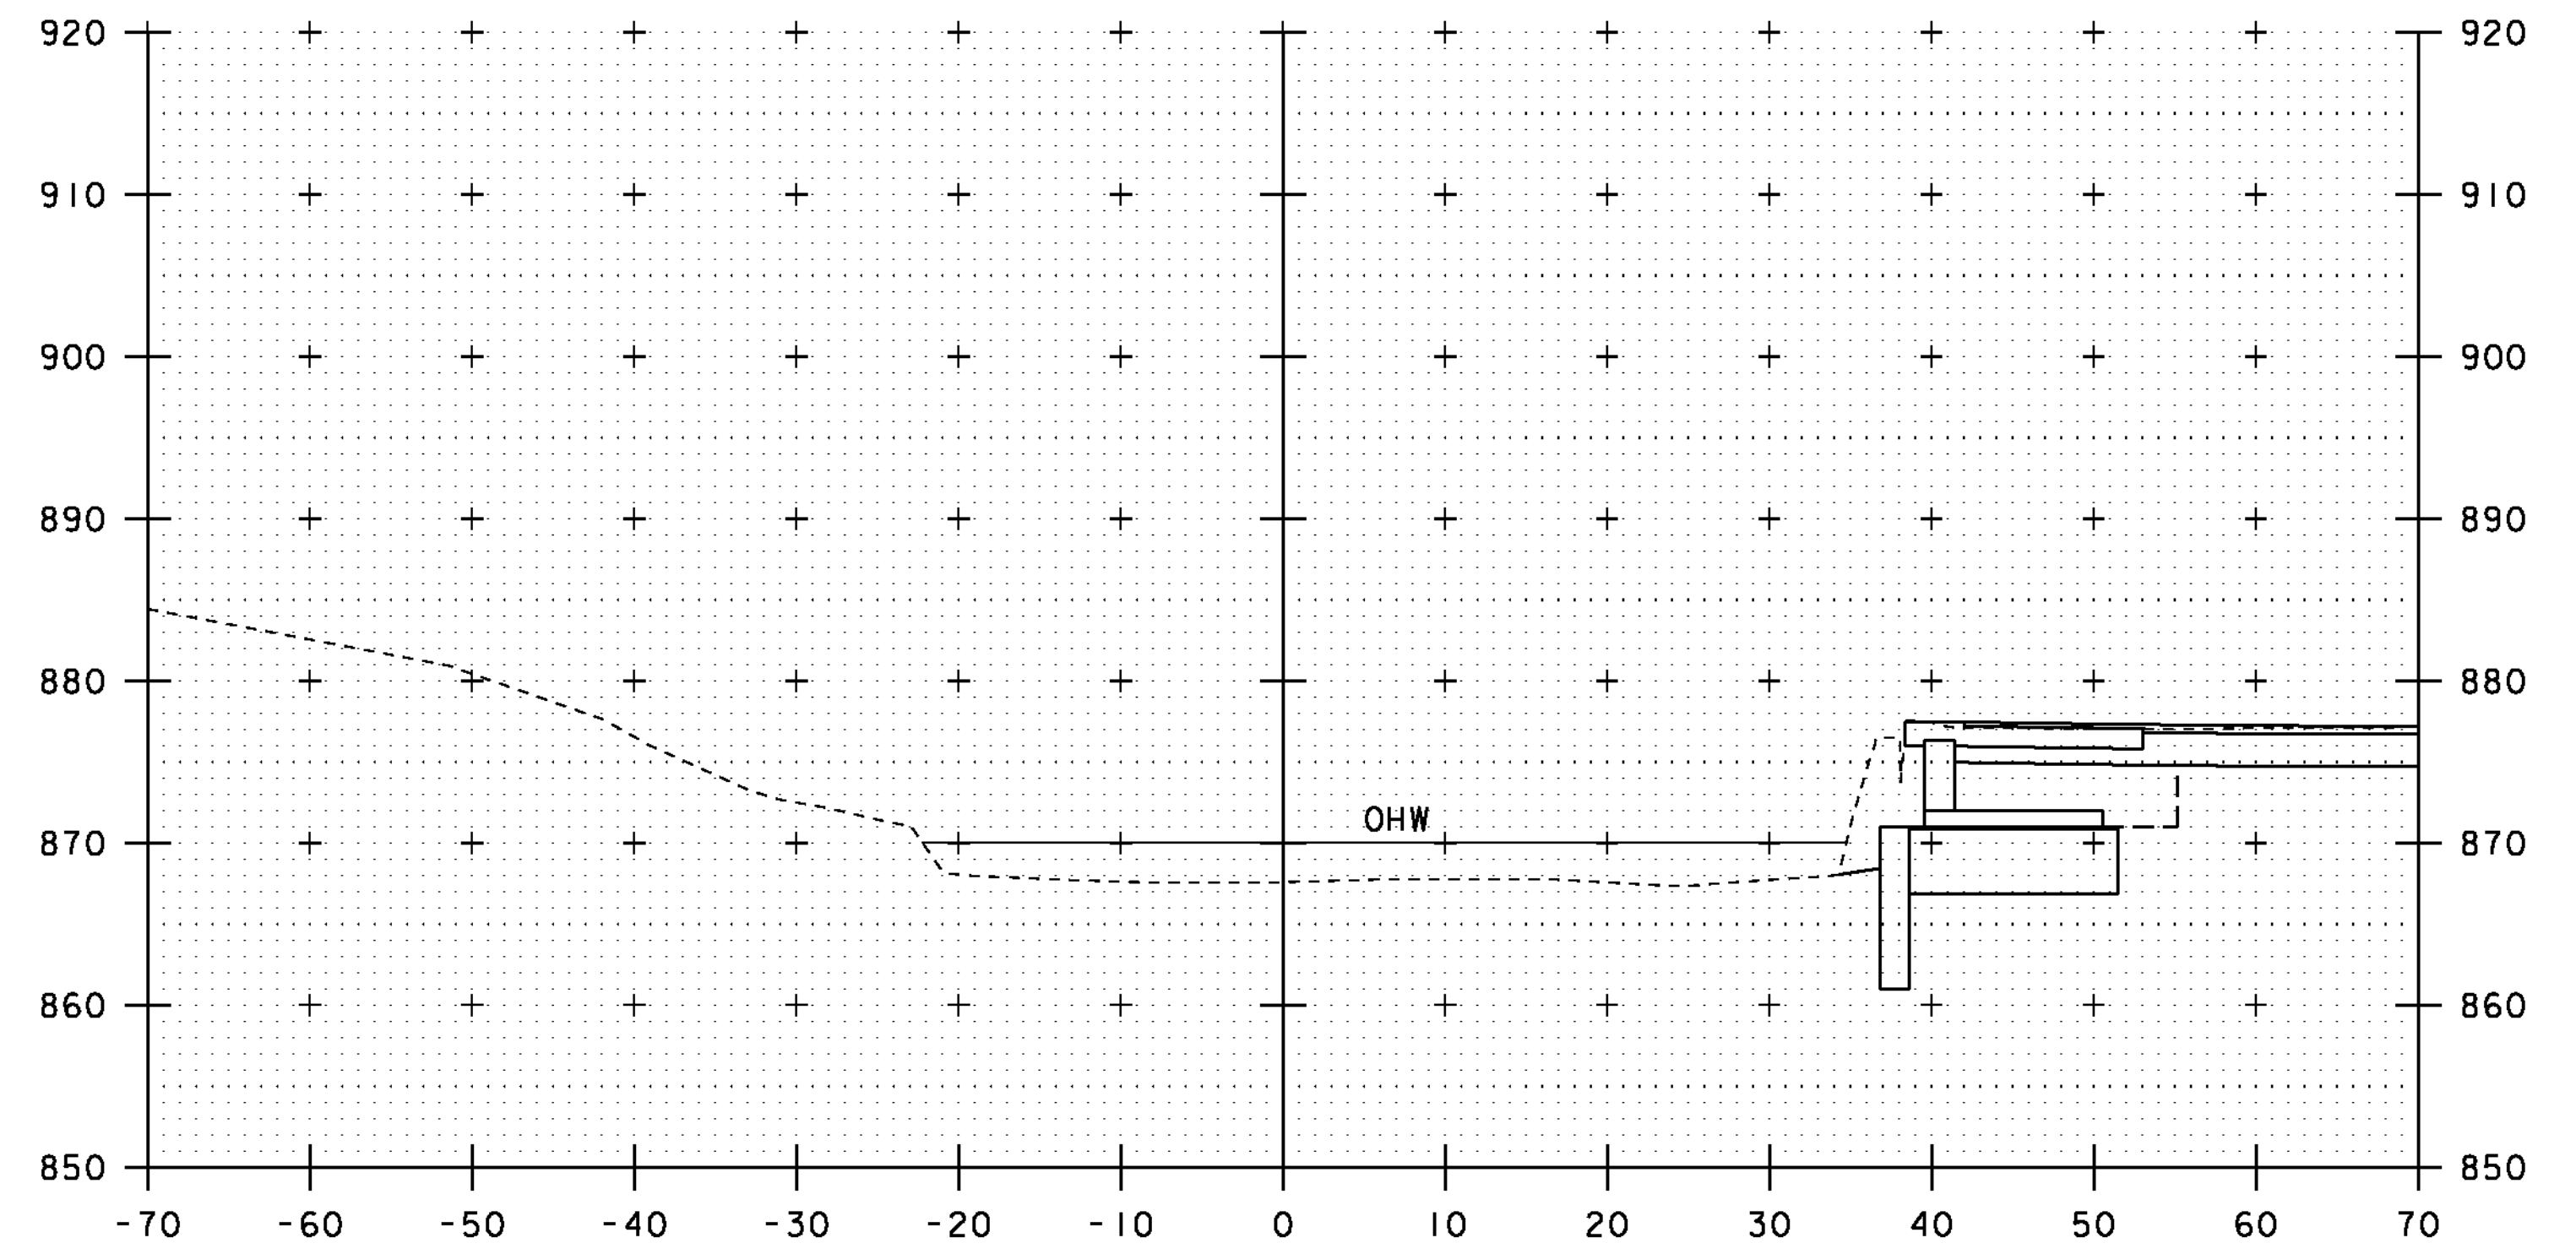


51+40

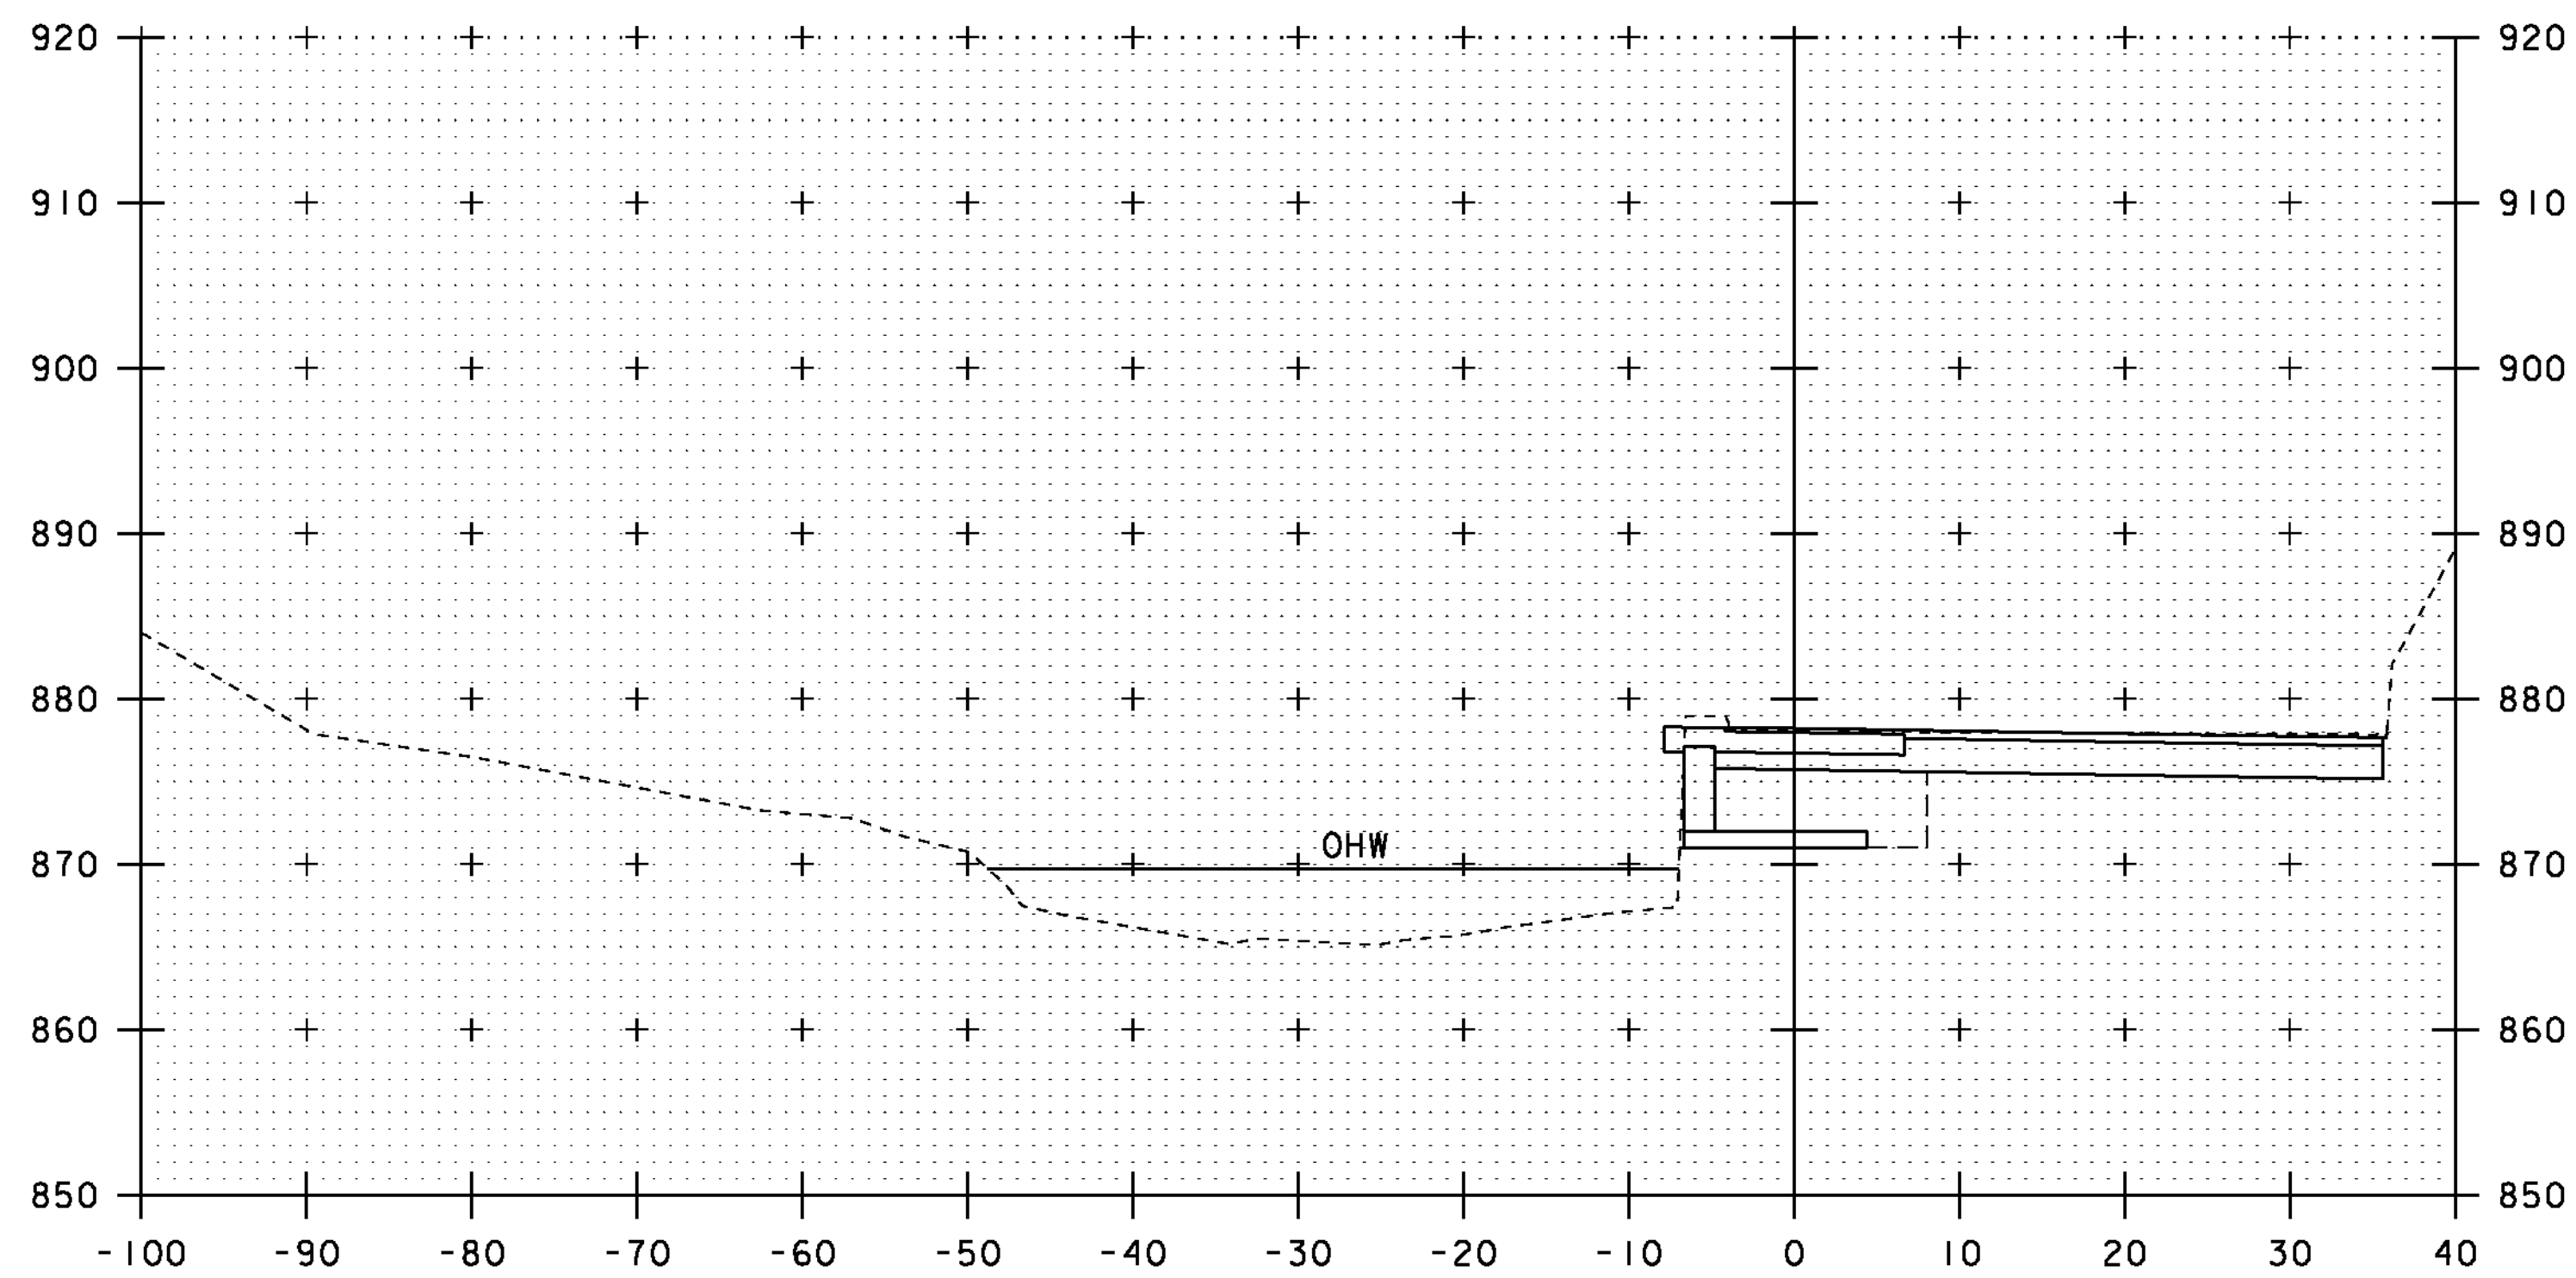

51+10

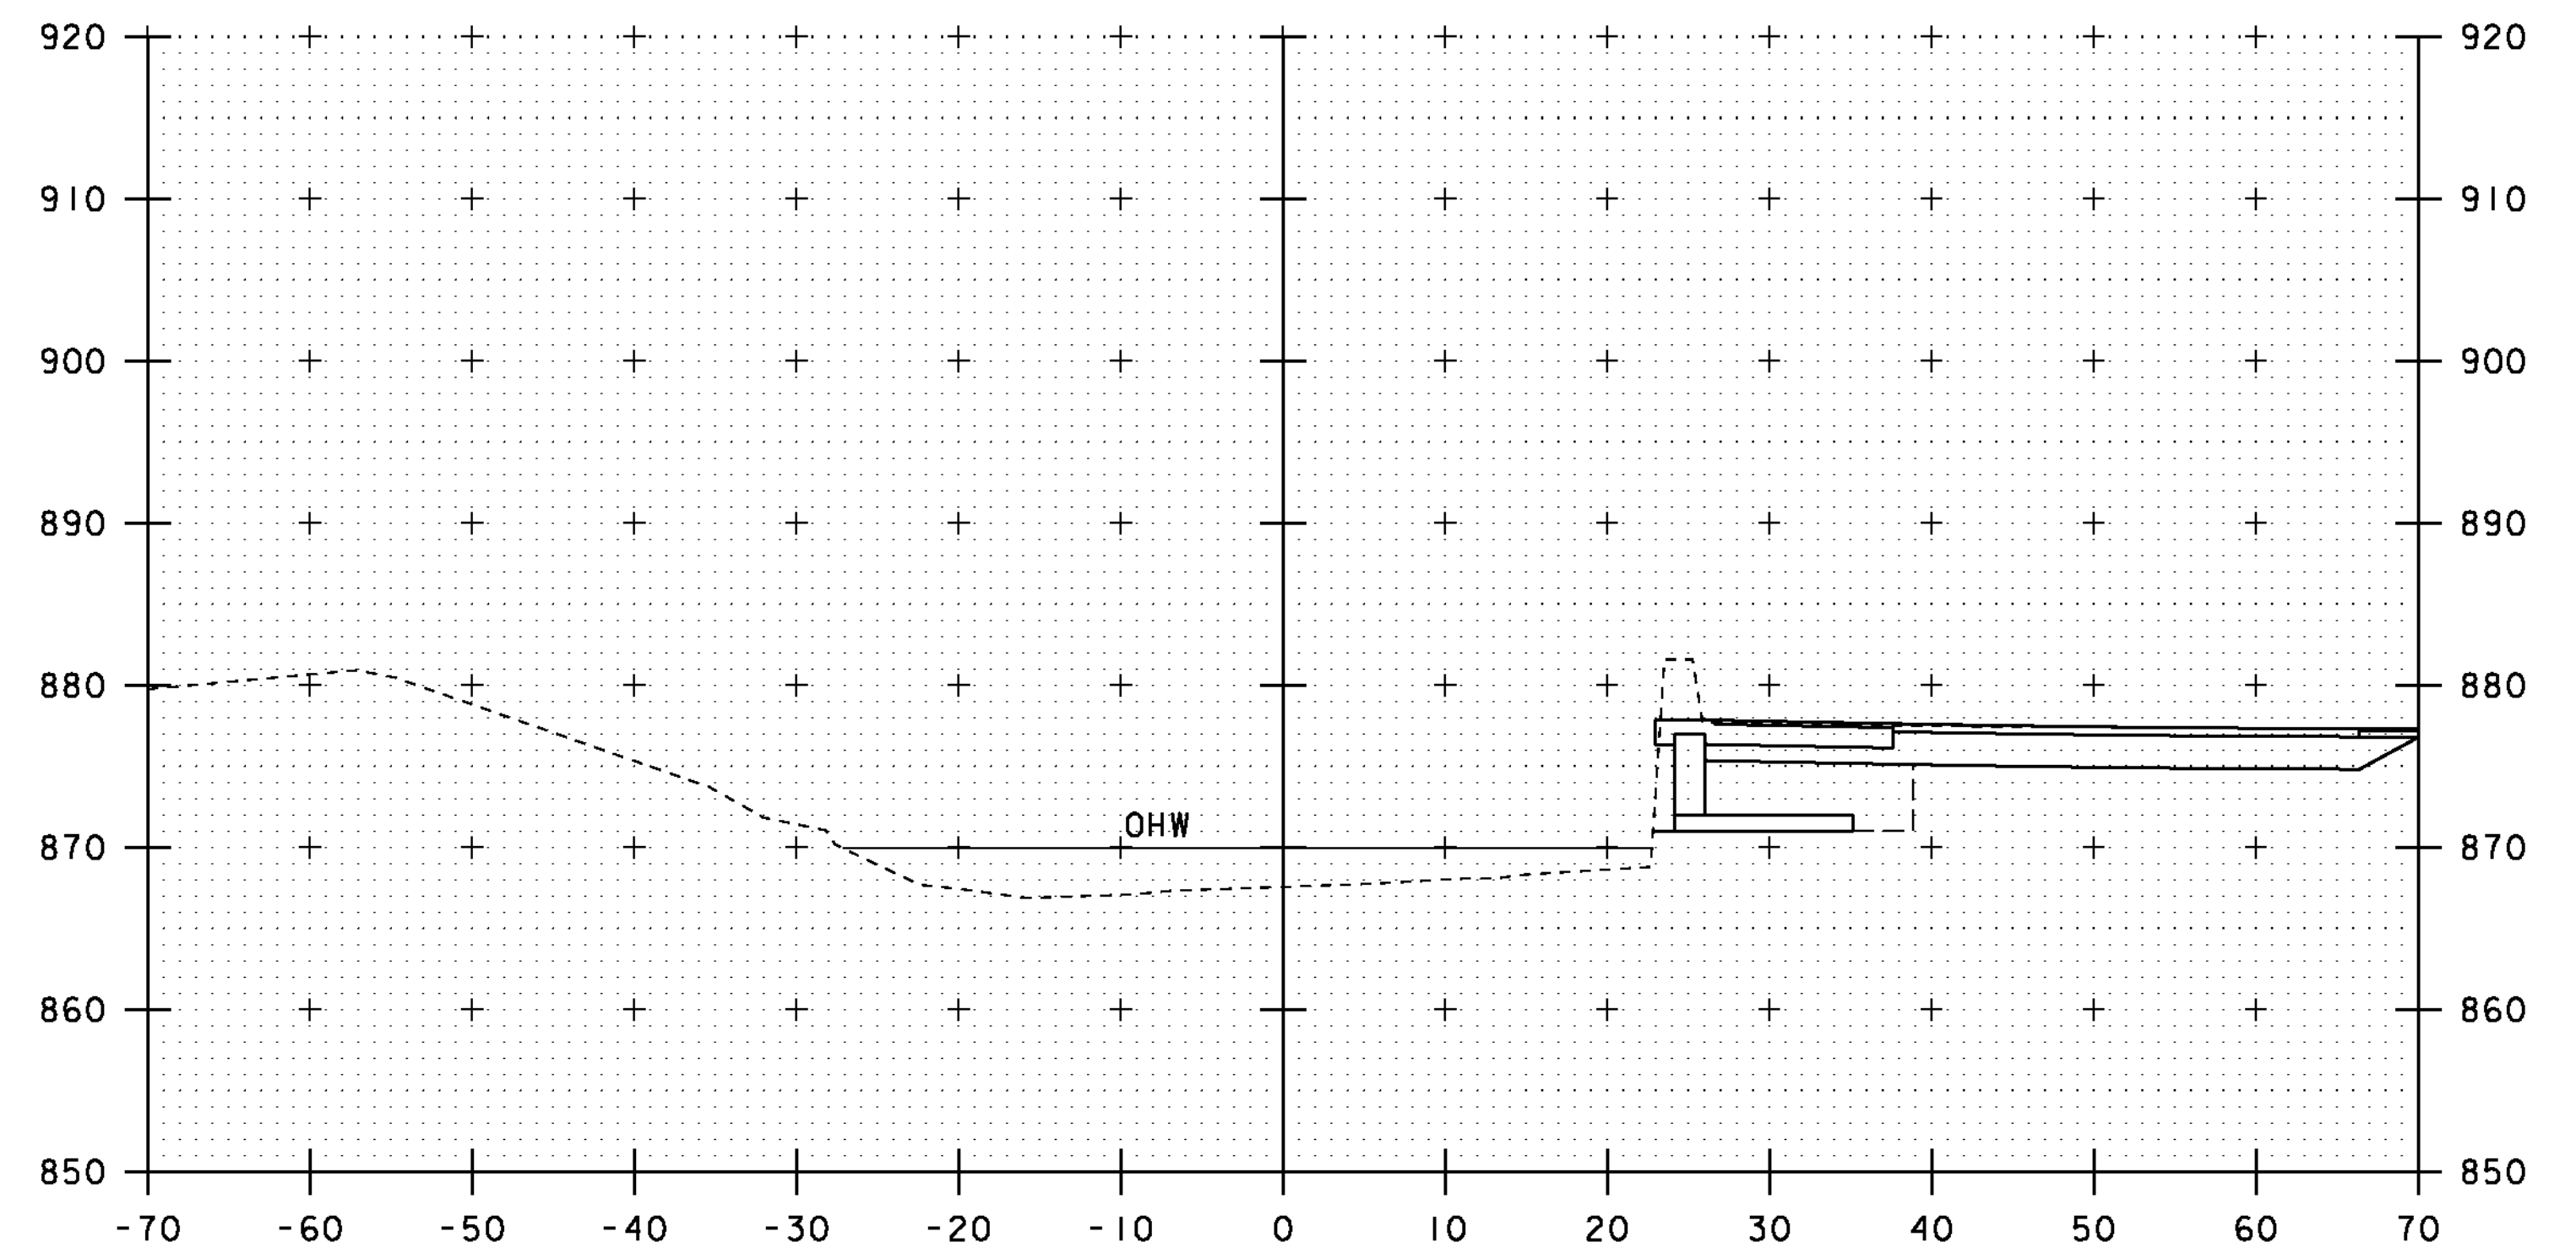

51+30

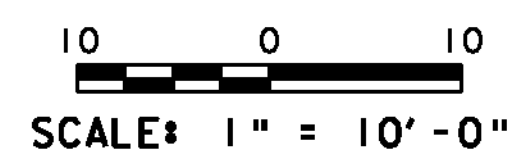

STA. 51+10 TO STA. 51+40

PROJECT NAME: ROXBURY	PLOT DATE: 21-SEP-2011
PROJECT NUMBER: BHF 0187(8)	DRAWN BY: G. ROY
FILE NAME: sl0c420xsl.dgn	CHECKED BY: T. FILLBACH
PROJECT LEADER: C. P. WILLIAMS	SHEET 40 OF 54
DESIGNED BY: G. ROY	
CHANNEL LINE CROSS SECTIONS (3)	