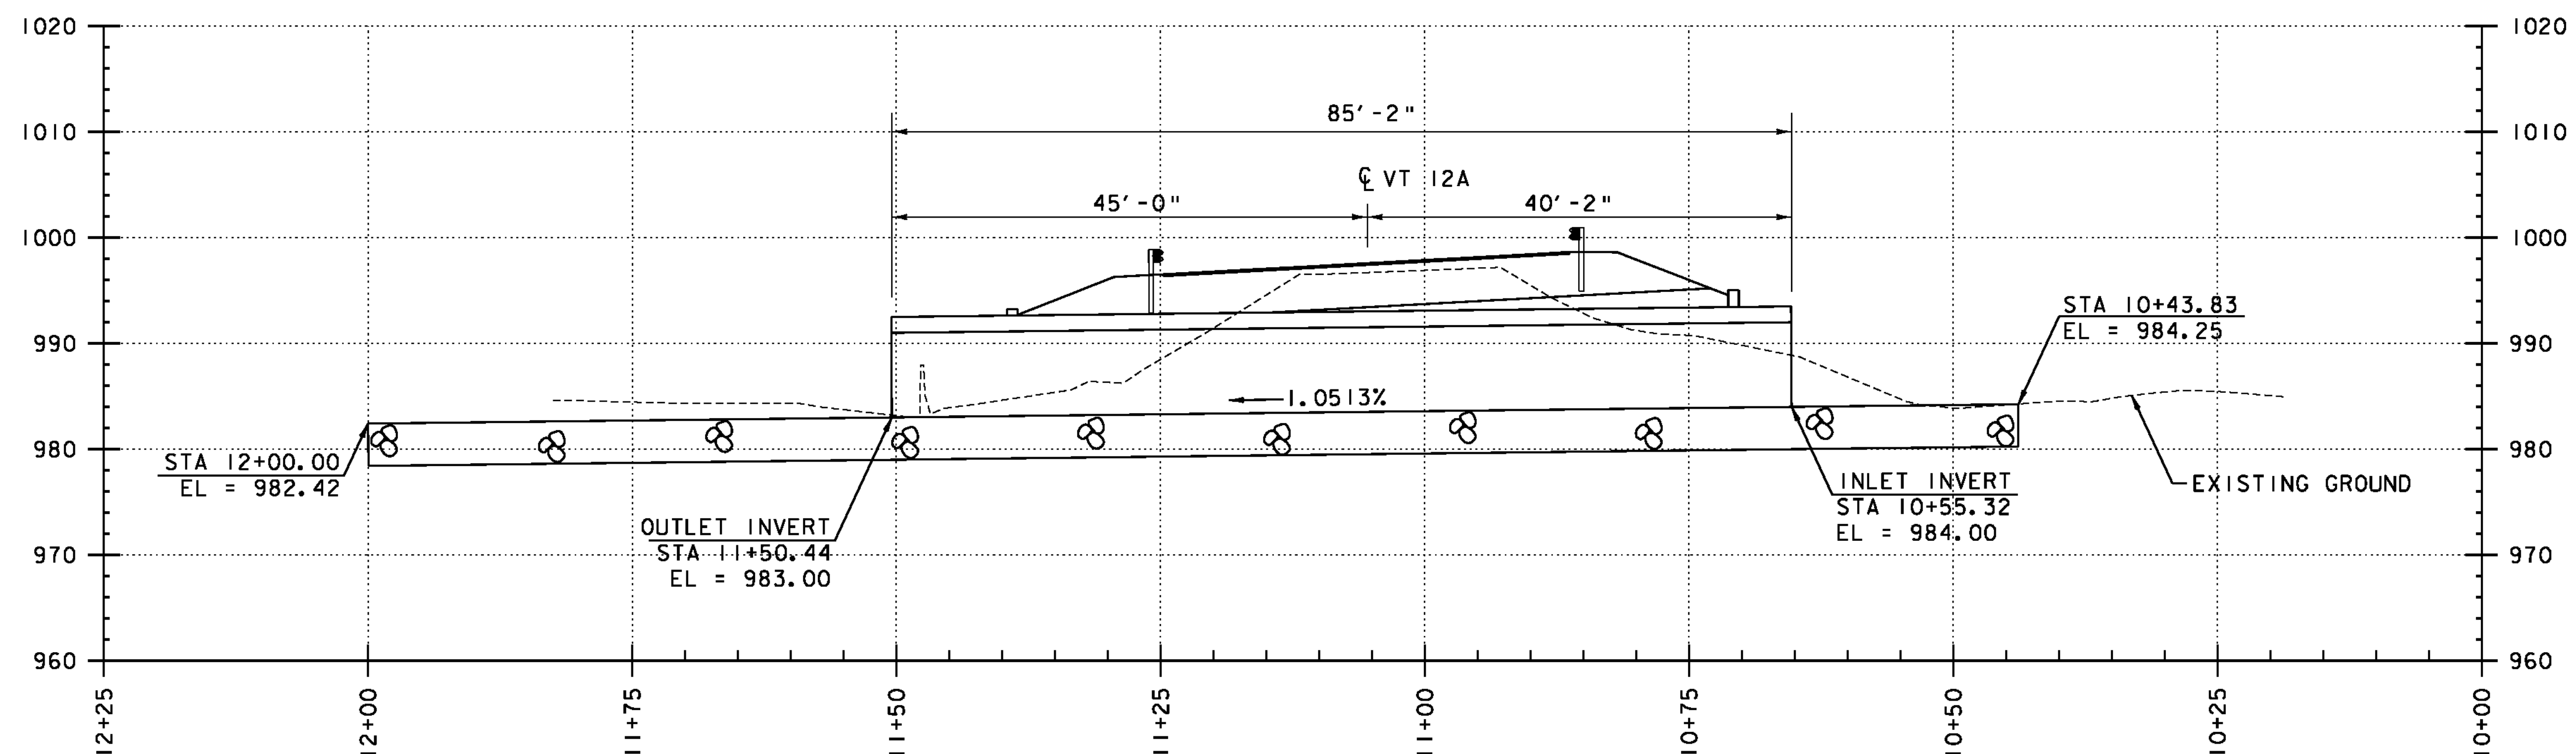
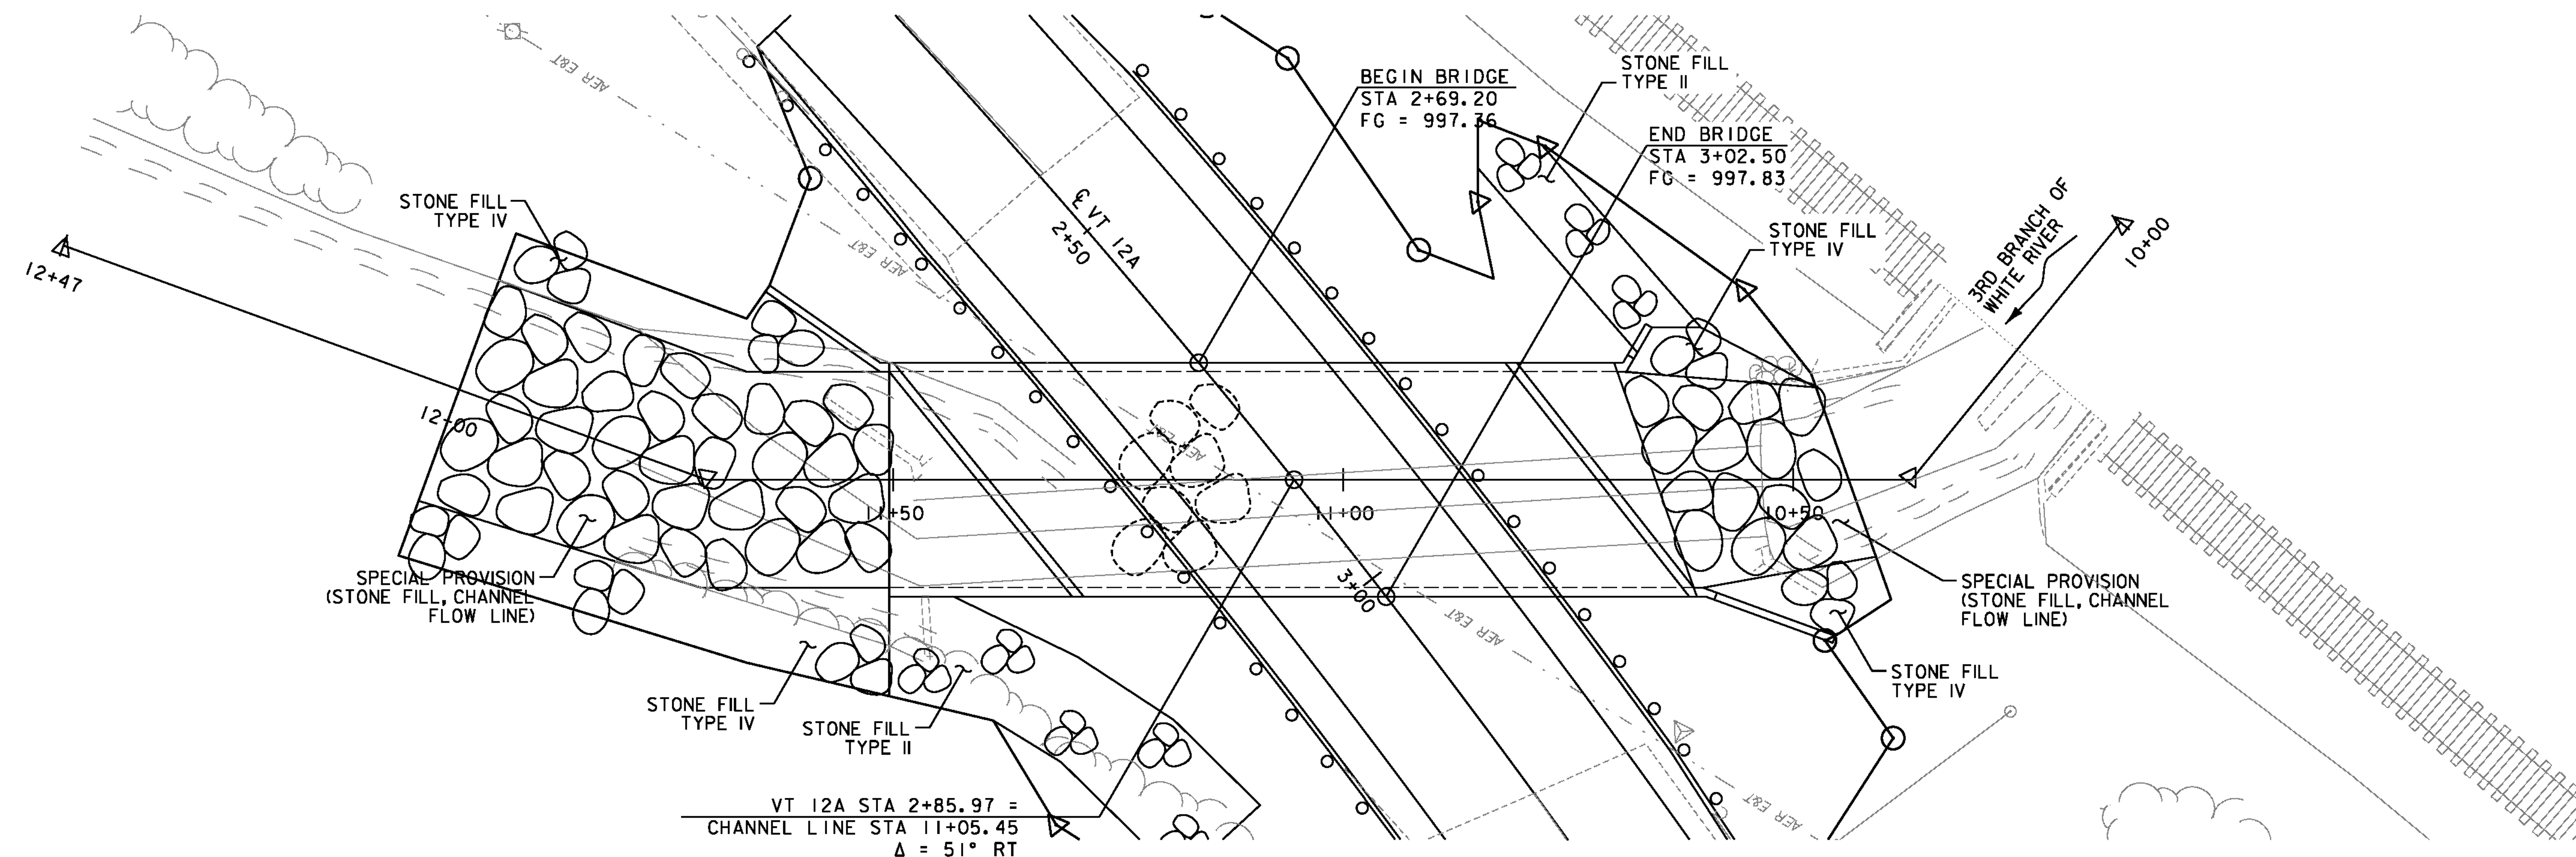


PROJECT NAME: ROXBURY
PROJECT NUMBER: ER 0187(9)

FILE NAME: ...plotfiles\Plan-Profile.dgn
PROJECT LEADER: G. BOGUE
DESIGNED BY: M. CHENETTE
PLAN AND PROFILE

PLOT DATE: 9/21/2011
DRAWN BY: JTS/ISM
CHECKED BY: G. BOGUE
SHEET 46 OF 54