


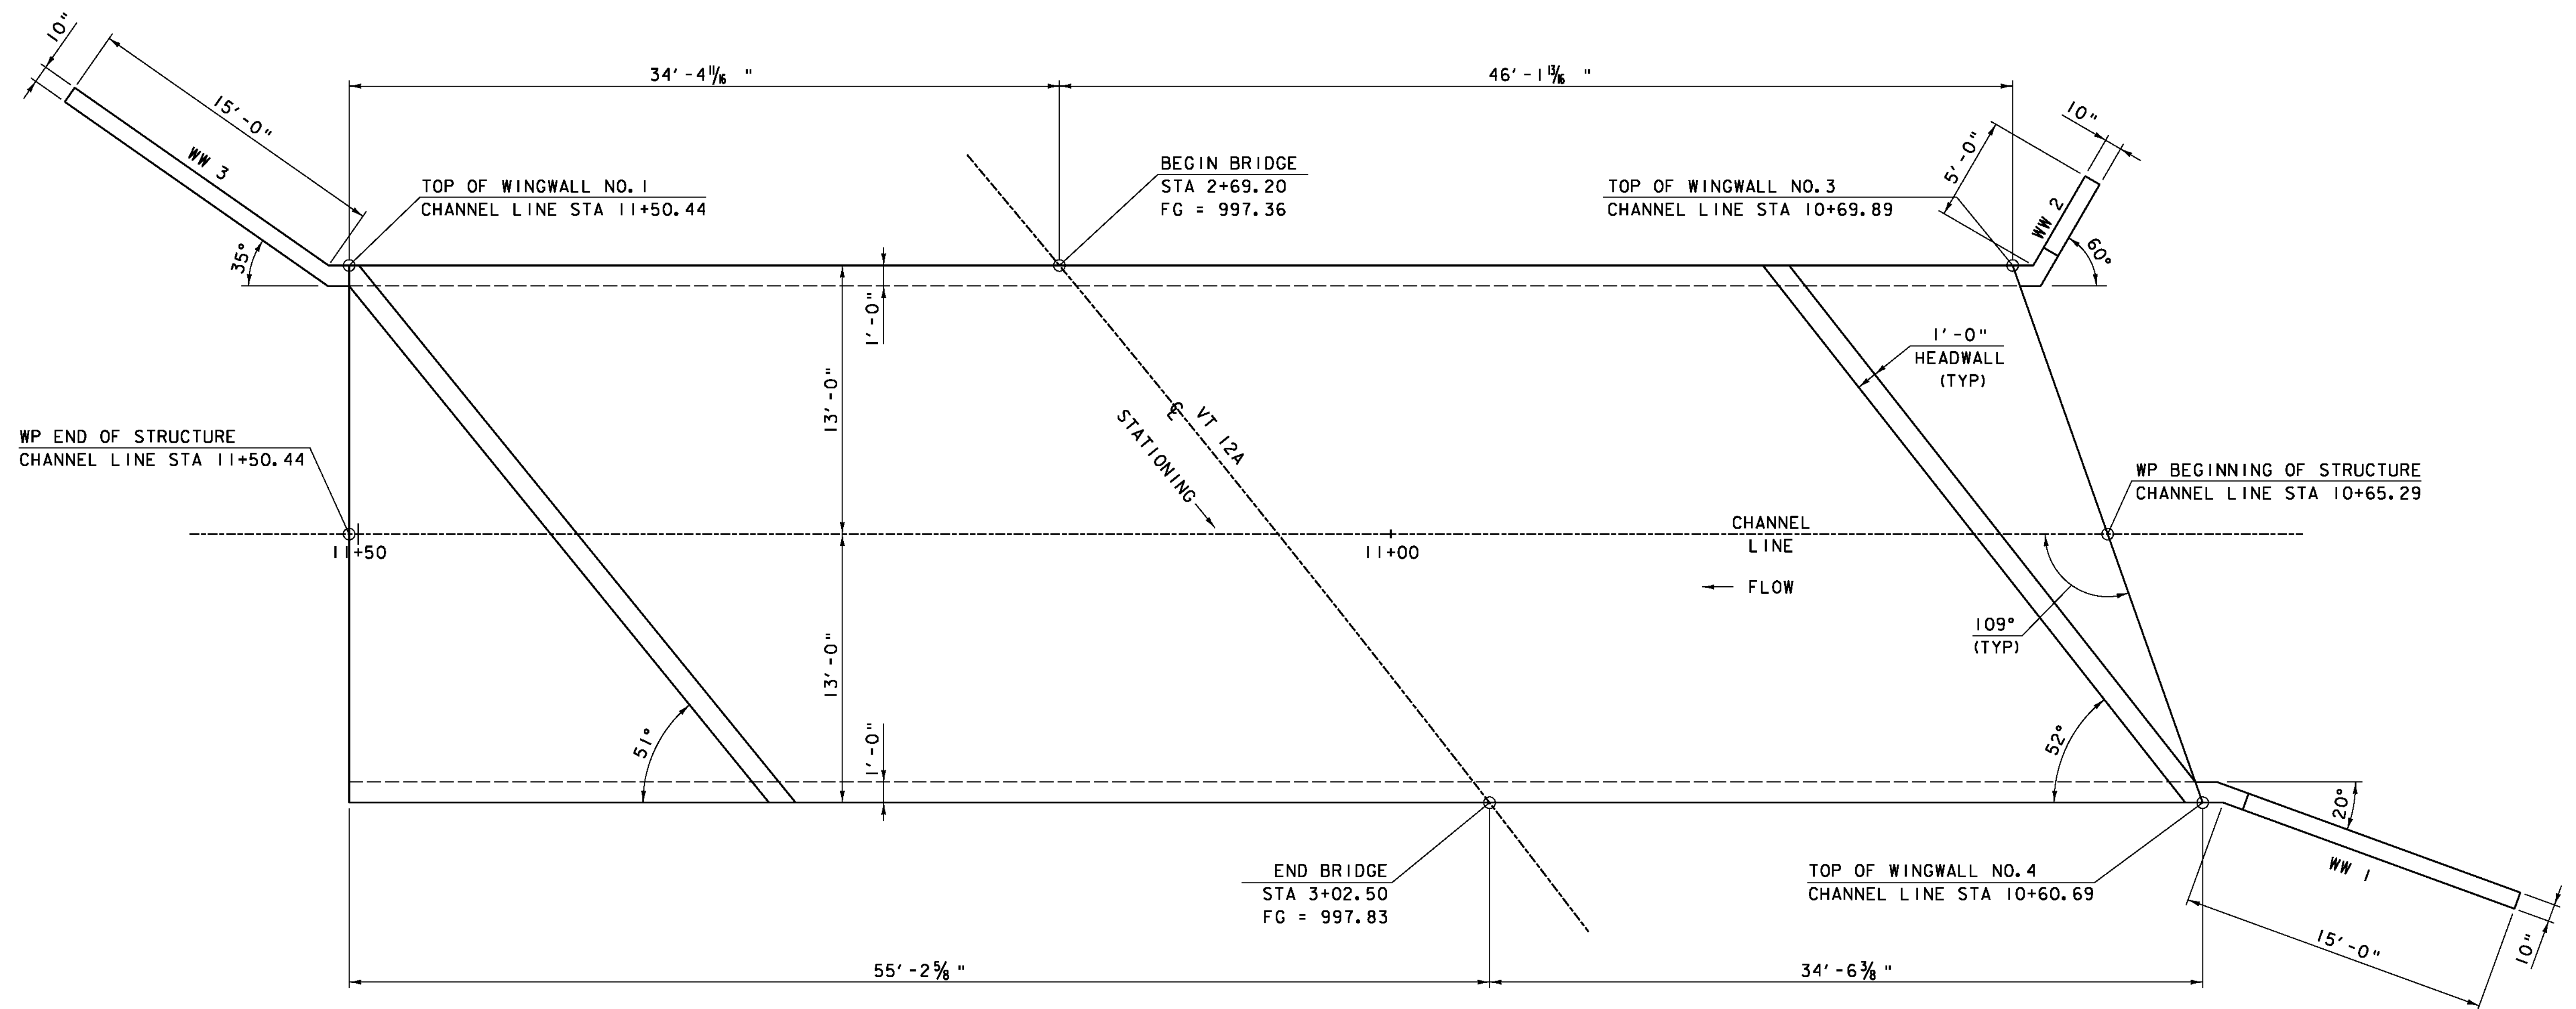

# PRECAST CONCRETE STRUCTURE PLAN

SCALE: 1/4" = 1'-0"

| WP OF STRUCTURE           | NORTHING  | EASTING    |
|---------------------------|-----------|------------|
| CHANNEL LINE STA 11+50.44 | 574107.89 | 1576390.76 |
| CHANNEL LINE STA 10+65.29 | 574192.95 | 1576394.81 |

1 0 1 2 3 4 5 6  
SCALE: 1/4" = 1'-0"



|                 |            |                                 |                                 |             |           |
|-----------------|------------|---------------------------------|---------------------------------|-------------|-----------|
| PROJECT NAME:   | ROXBURY    | FILE NAME:                      | ...drawing\struct_plan.dets.dgn | PLOT DATE:  | 9/21/2011 |
| PROJECT NUMBER: | ER 0187(9) | PROJECT LEADER:                 | G. BOGUE                        | DRAWN BY:   | J. SOTER  |
|                 |            | DESIGNED BY:                    | M. CHENETTE                     | CHECKED BY: | G. BOGUE  |
|                 |            | PRECAST CONCRETE STRUCTURE PLAN |                                 | SHEET       | 48 OF 54  |