


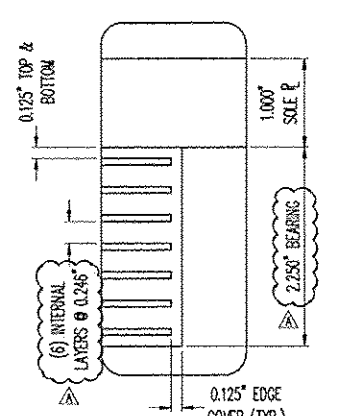

3	KEY DRG. HEIGHT FROM 1.25 TO 2.25, DRG. MATERIAL & ANCHOR ROD	10/10/71	DA	ANN
4	DISCRIPTION	DATE	DET	DOD
5	LOCATION - RACE VALLEY BRIDGE 35.65 MILES W OF SHAWNEE/ROBURY TOWNE LINE	34574-1104-1	ITEM	QUANTITY
6	GRADE - 15			6 OF 6
7	PROJECT NO. - DMF (0187)8			
8	PROJECT NAME - ROBURY			
9	DESIGNER - VT DOT			
10	CUSTOMER - LUXK BROS. INC.			
11				
12				
