

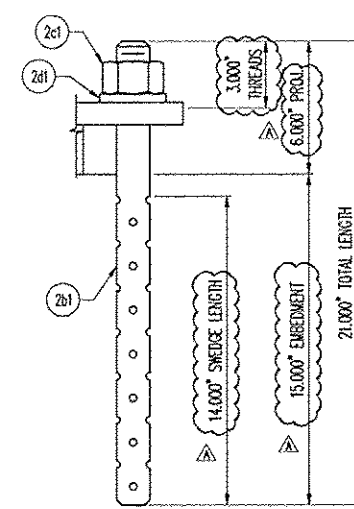


PLAN VIEW
ELASTOMERIC BEARING
(6) REQ'D @ ABUT. 2

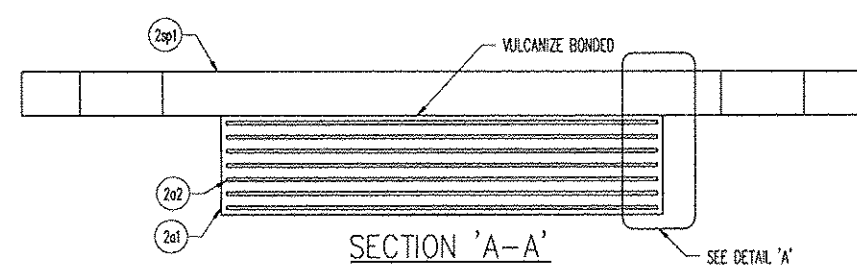

ANCHOR ROD DETAIL

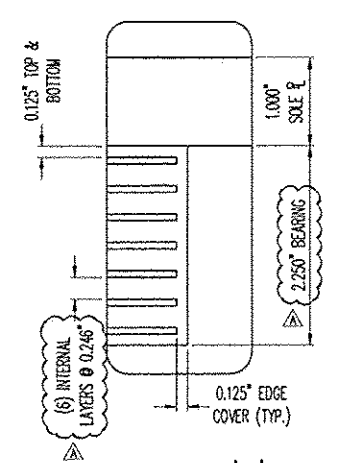

DETAIL 'A'

LOAD TABLE	
LIVE LOAD (KIPS)	60.0
DEAD LOAD (KIPS)	20.0

NO.	QTY	DESCRIPTION	MATERIAL	LENGTH	REMARKS
2A	6	ELASTOMERIC BEARING			
2a1	6	1.500\"/>			

SEE SH1, QNT FOR GENERAL NOTES.

REV.	DESCRIPTION	DATE	BY	CHK'D BY
1	REV. BRG. HEIGHT FROM 1.25 TO 2.25, BRG. MATERIAL, & ANCHOR ROD	10/10/19	DA	ANK

ITEM	QUANTITY
34074-1104-2	6 OF 6

LOCATION	BRIDGE	PROJECT NO.	DESIGNER	CUSTOMER
15	15	0187(18)	VT DOT	LUCK BROS. INC.

N.T.S.	DATE	SCALE	NO.
34574	1104	1	02

RECEIVED
OCT 12 2011
APPROVED
DATE 10/13/2011

