



FRAMING PLAN

FIELD BOLT SUMMARY				NOTE: 4% ADDITIONAL BOLTS ADDED + 3 FOR TESTING	
LINE NO.	QTY	TYPE	BOLT LENGTH	ACTUAL COUNT	REMARKS
1	87	A325 TYPE 3	2"	80	+ 7 FLAT WASHER
2	1				
3	1				
4	1				

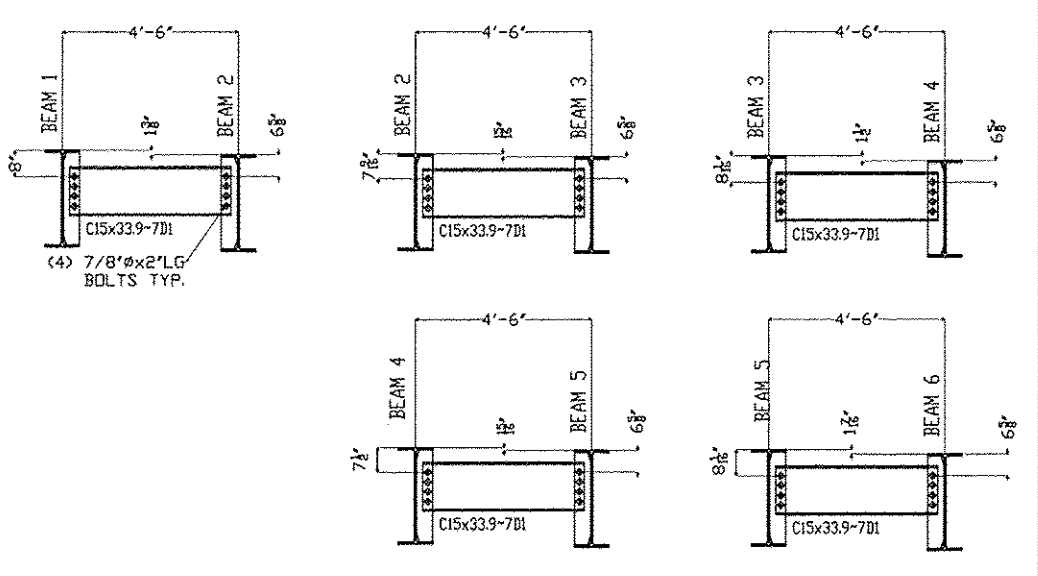


SECTION B-B

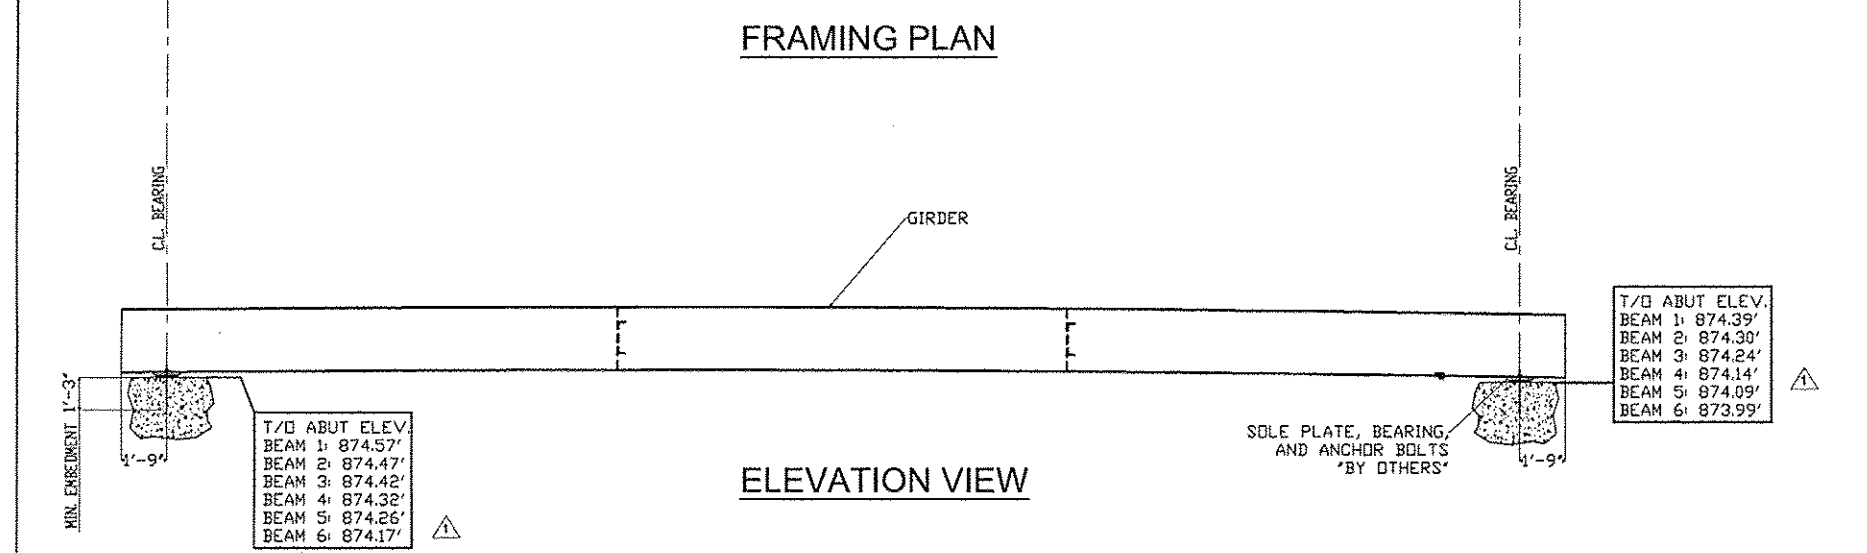

ELEVATION VIEW

RECEIVED  
 OK'D BY: RCY  
 OCT 17 2011  
 RESUBMIT:  APPROVED:   
 BY: \_\_\_\_\_ DATE: 10/18/2011

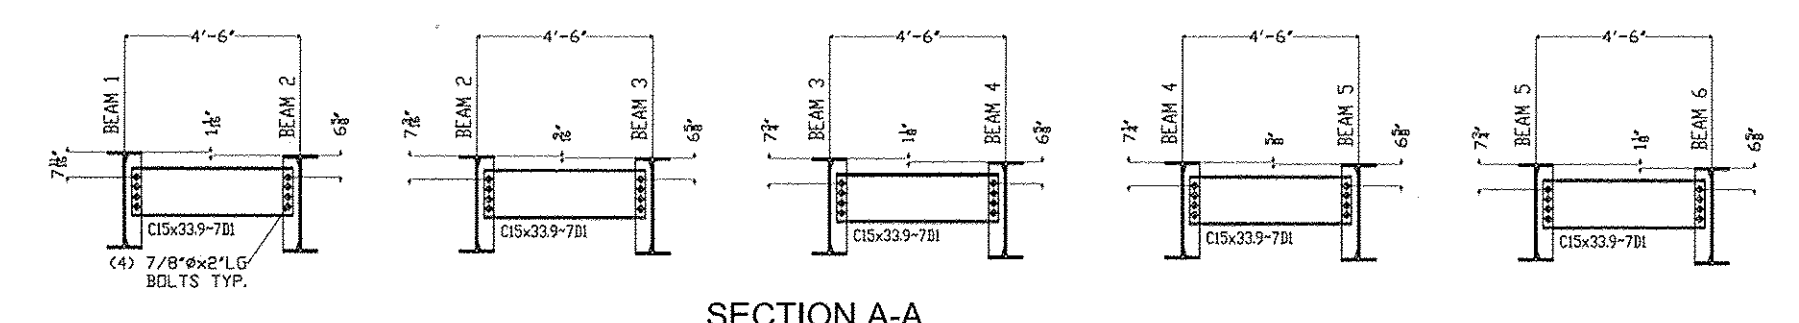

SECTION A-A

SHOP NOTES  
 HOLES: 15/16" UNF  
 BOLTS: PER GIN  
 PAINT: HD PAINT  
 WELDS: N/A  
 MATERIAL: A36 / 50 / 60 / 70 / 990 / 1000

PRECISE STRUCTURAL PRODUCTS  
 3 FARM LANE  
 GEORGETOWN, MA 01833  
 (978) 852-2991  
 OWNER: VT AGENCY OF TRANSPORTATION  
 CONTRACTOR: LOCK BROTHERS INC.  
 DRAWN BY: \_\_\_\_\_ CHECKED BY: \_\_\_\_\_ DATE: 10/18/2011  
 SCALE: 3/8" = 1'-0" SHEET NO. E1