


CAMBER DETAIL

TYP. DIAPHRAGM STIFFENER
WELD DETAIL


* NO WELD FOR $\frac{3}{8}$ " MIN.
OR $\frac{7}{8}$ " MAX.

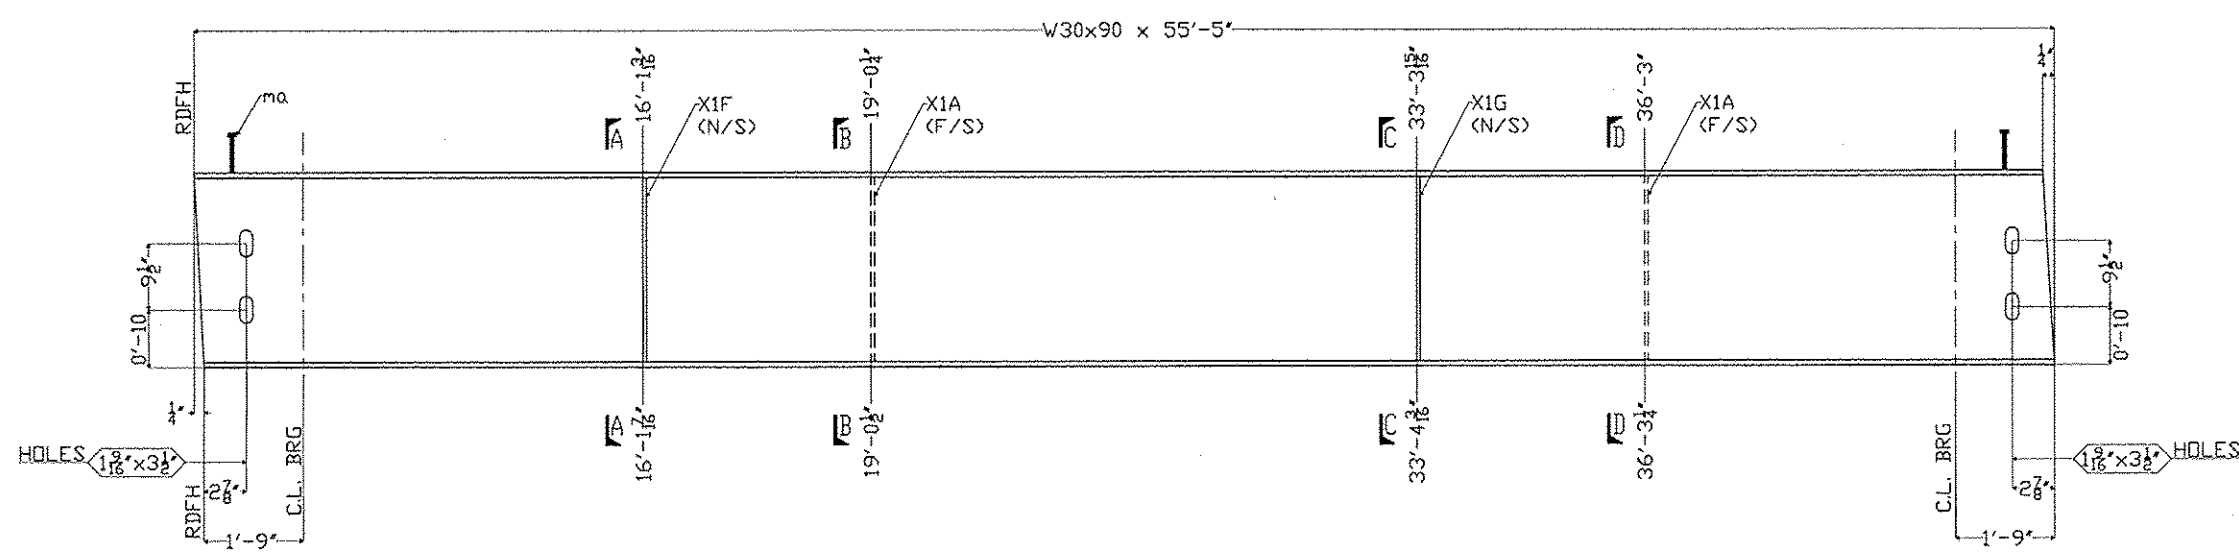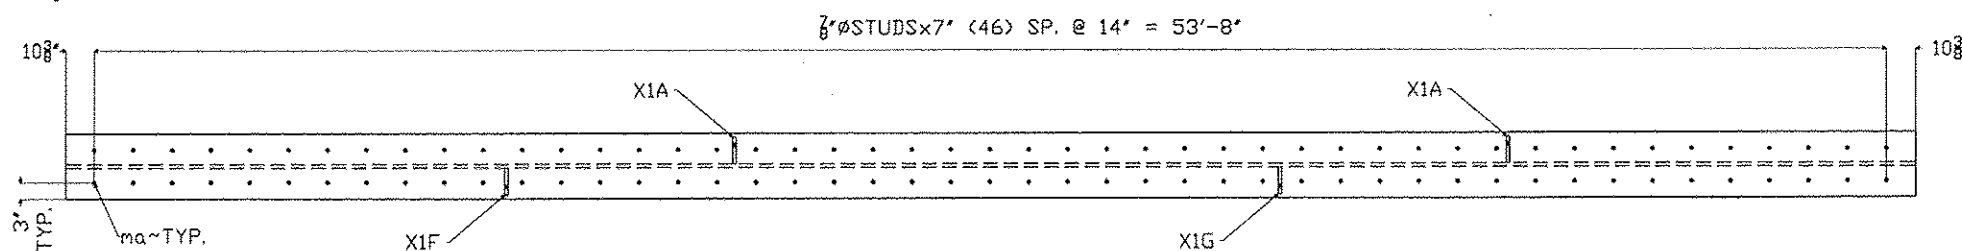


ONE ~ GIRDER DETAIL ~ 3B1

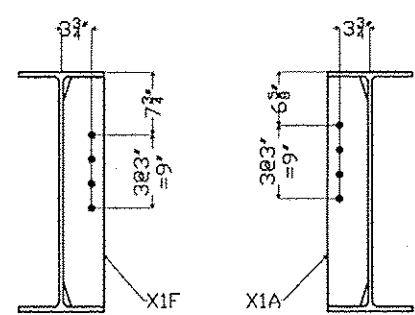


SECTION A-A

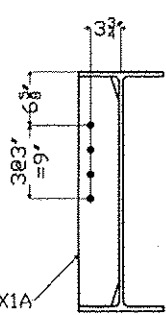

SECTION B-B

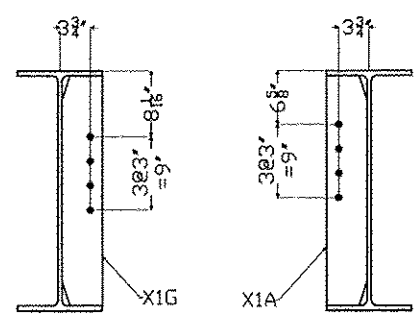

SECTION C-C

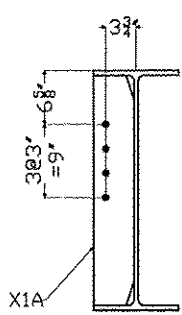

SECTION D-D

SHIPPER		BILL OF MATERIAL					ITEM	QTY
NO.	MARK	NO.	MARK	SIZE	LENGTH	REMARKS		
I	3BI			W/30"x90"	55'-5"	CVN		
		2	XIA	PL 4"x6"	2'-6"	CVN		
		1	XIF	PL 4"x6"	2'-6"	CVN		
		1	XIG	PL 4"x6"	2'-6"	CVN		
		94	no	3" STUB	0'-7"			

RECEIVED
CK'D BY _____ OK'D BY RSY
OCT 17 2011
RESUBMIT _____ APPROVED ☒
BY _____ DATE 10/18/2011

REVISION								
GIRDER DETAIL								
TOWN OF ROXBURY, WASHINGTON COUNTY, VT								
PROJECT NUMBER: BH# 0187(B)								
VT 12A, MAJOR COLLECTOR - BRIDGE 15								
PRECISE STRUCTURAL PRODUCTS								
3 FARM LANE GEORGETOWN, MA 01833								
OWNER: VT AGENCY OF TRANSPORTATION CONTRACTOR: LUCK THROBERS INC								
DESIGNED BY	CHECKED BY	APP.	SHOP	DEST.	CONTRACT NO.	SHEET NO.		
KC	ML	06/01/11			3590	3		