



* NO WELD FOR 3' MIN
OR 2' MAX.

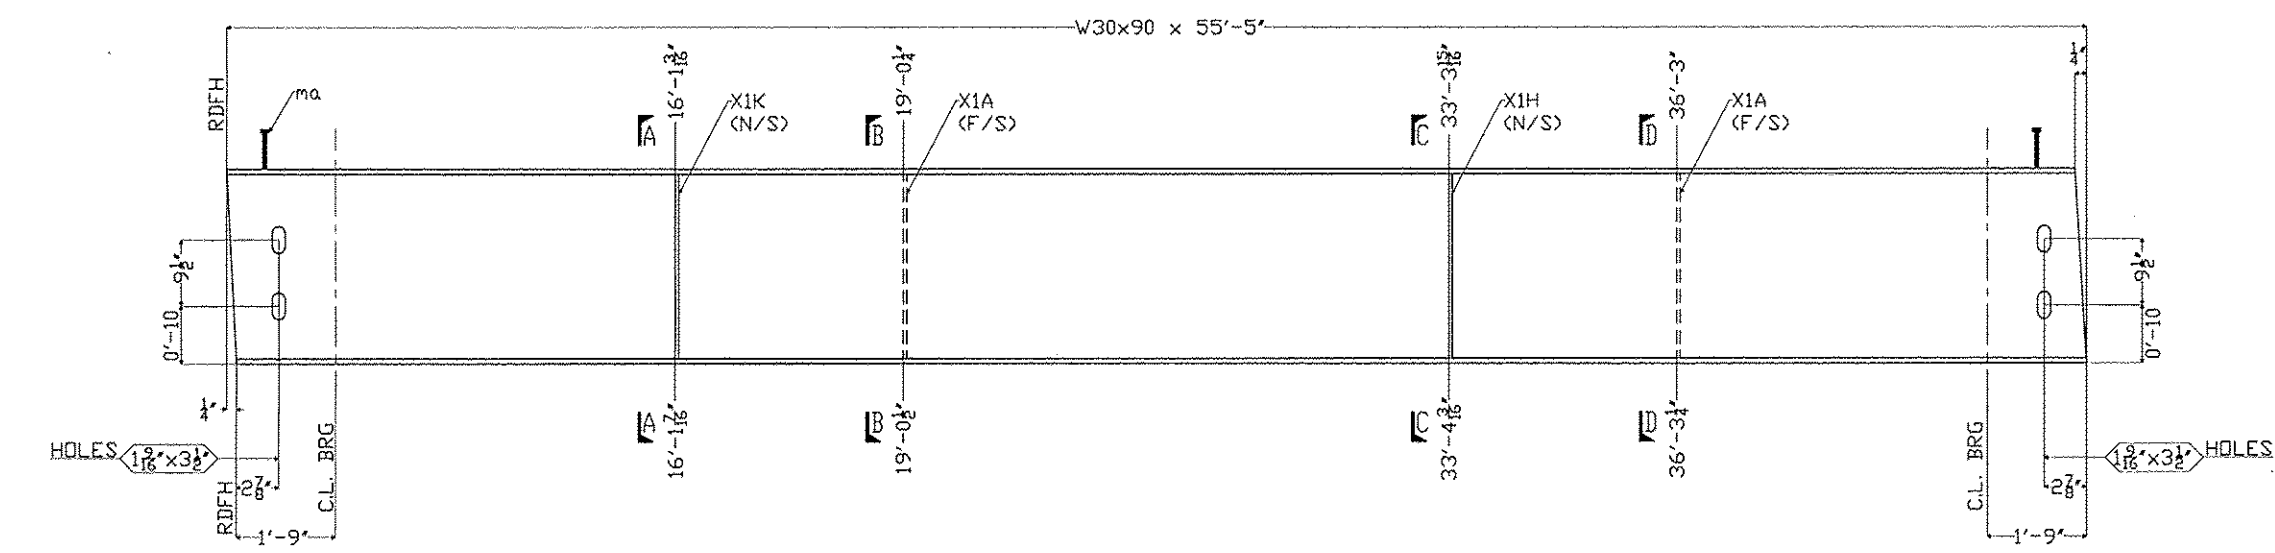

ONE ~ GIRDER DETAIL ~ 4B1

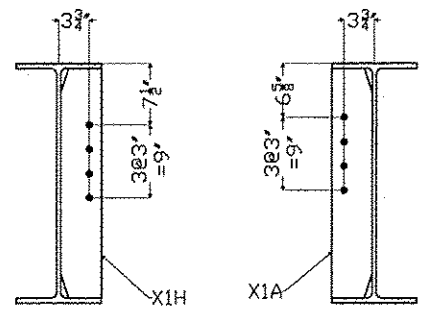

SECTION D-D

SHIPPER		BILL OF MATERIAL						
NO.	MARK	NO.	MARK	SIZE	LENGTH	REMARKS	ITEM	WEIGHT
1	431			W30x90	55'-5"	CVN		
		2	XIA	PL 4x5	2'-4 1/2"	CVN		
		1	XIH	PL 4x5	2'-4 1/2"	CVN		
		1	XIK	PL 4x5	2'-4 1/2"	CVN		
		94	no	2" STUD	0'-7"			

RECEIVED
OK'D BY _____ OK'D BY RSY
OCT 17 2011
RESUBMIT _____ APPROVED ☒
BY _____ DATE 10/18/2011

									
REV. NO.		DATE		=		REVISION			
GIRDER DETAIL									
TOWN OF ROXBURY, WASHINGTON COUNTY, VT									
PROJECT NUMBER: BH# 0187(8)									
VT 12A, MAJOR COLLECTOR - BRIDGE 15									
PRECISE STRUCTURAL PRODUCTS									
		3 FARM LAKE GEORGETOWN, MA 01833 978-252-2591							
OWNER: VT AGENCY OF TRANSPORTATION									
CONTRACTOR: LUCK BROTHERS INC									
DRAWN BY	CHECKED BY	APP.	SEAL	DATE	CONTRACT NO.	SHEET NO.			
10/27/97	WE	10/16/11			3590	4			