



Table of Units					
Name	Qty	Length	Vol (CY)	Wt (lbs)	**
RF-1	1	7'-11 1/2"	15.43	65,710	
RF-2	8	7'-11 1/2"	15.20	66,790	
RF-3	1	7'-11 1/2"	12.51	50,050	
RF-4	1	7'-11 1/2"	12.59	50,370	
WW-1	1	16'-3 1/2"	7.98	31,900	
WW-2	1	6'-2 1/2"	2.77	11,085	
WW-3	1	16'-4 1/2"	7.98	31,915	
FT-1	1	14'-4 1/2"	9.84	39,380	
FT-2	1	11'-5 1/2"	7.47	29,890	
FT-3	1	15'-5 1/2"	10.04	40,150	
FT-4	1	16'-0"	11.68	46,725	
FT-5	8	16'-0"	12.25	48,990	
FT-6	1	15'-0"	7.22	28,890	
FT-7	1	12'-0"	5.78	23,111	



* Headwalls Not Included (By Others) ** May Vary

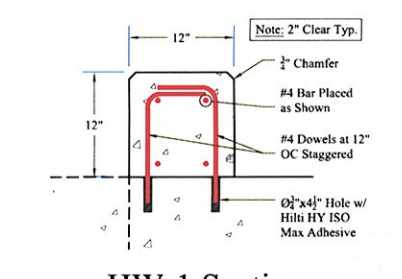

HW-1 Section
Cut to Face by Contractor

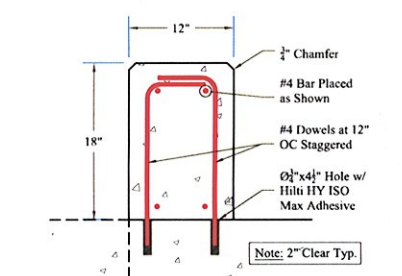

HW-2 Section
Cut to Face by Contractor

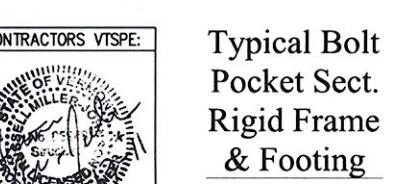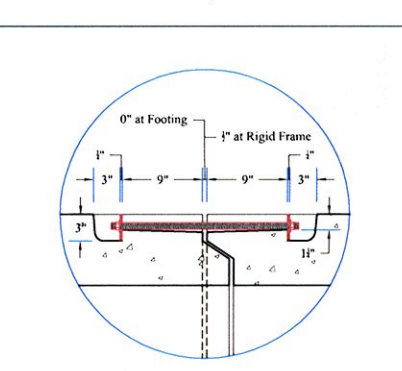

Typical Bolt Pocket Sect. Rigid Frame & Footing

