


WITH GUARDRAIL

ROADWAY TYPICAL SECTION


*2 LIFTS OF 1½" BITUM. CONC. PAVEMENT TYPE IIIS OVER 1 LIFT OF 3" BITUM. CONC. PAVEMENT TYPE IS OR IIS PAID UNDER SPECIAL PROVISION (BITUMINOUS CONCRETE PAVEMENT, SMALL QUANTITY).

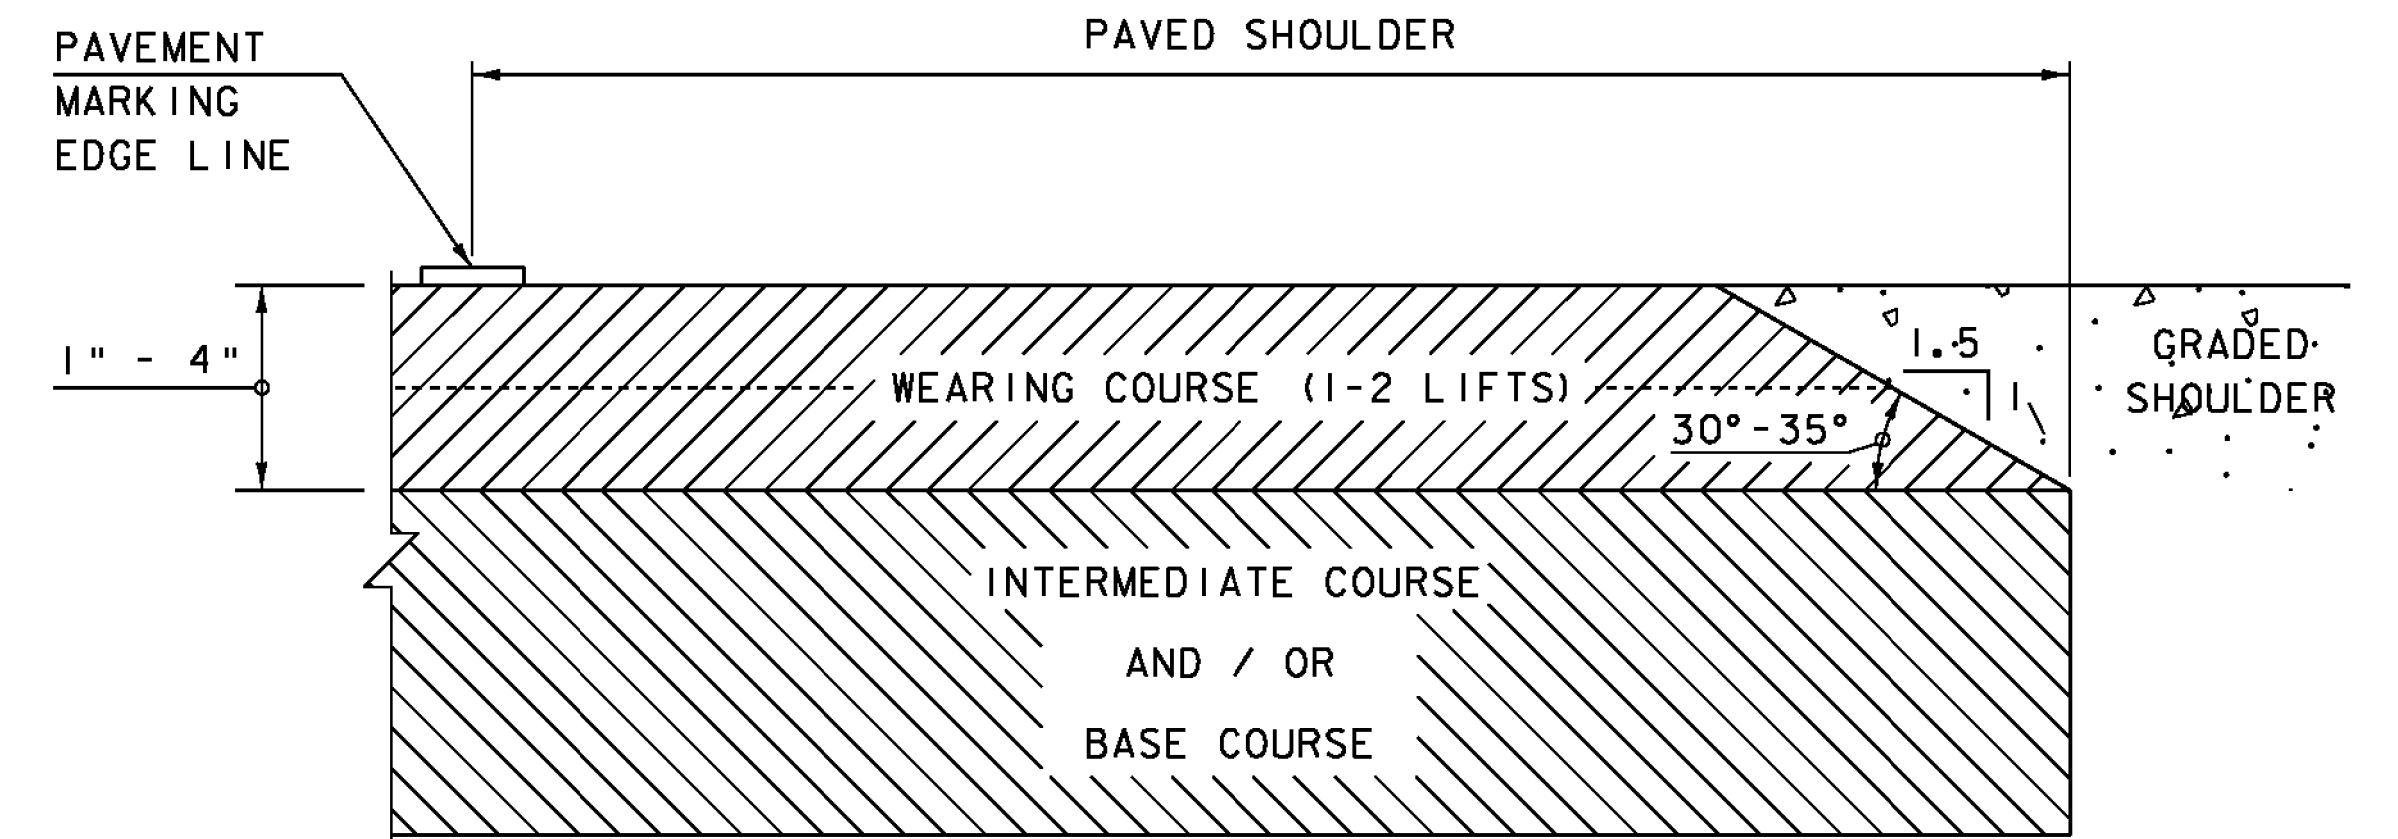

SAFETY EDGE DETAIL

NOT TO SCALE

NOTE: LEVELING COURSE MAY INCLUDE THE "SAFETY EDGE" AT THE CONTRACTOR'S CHOICE.

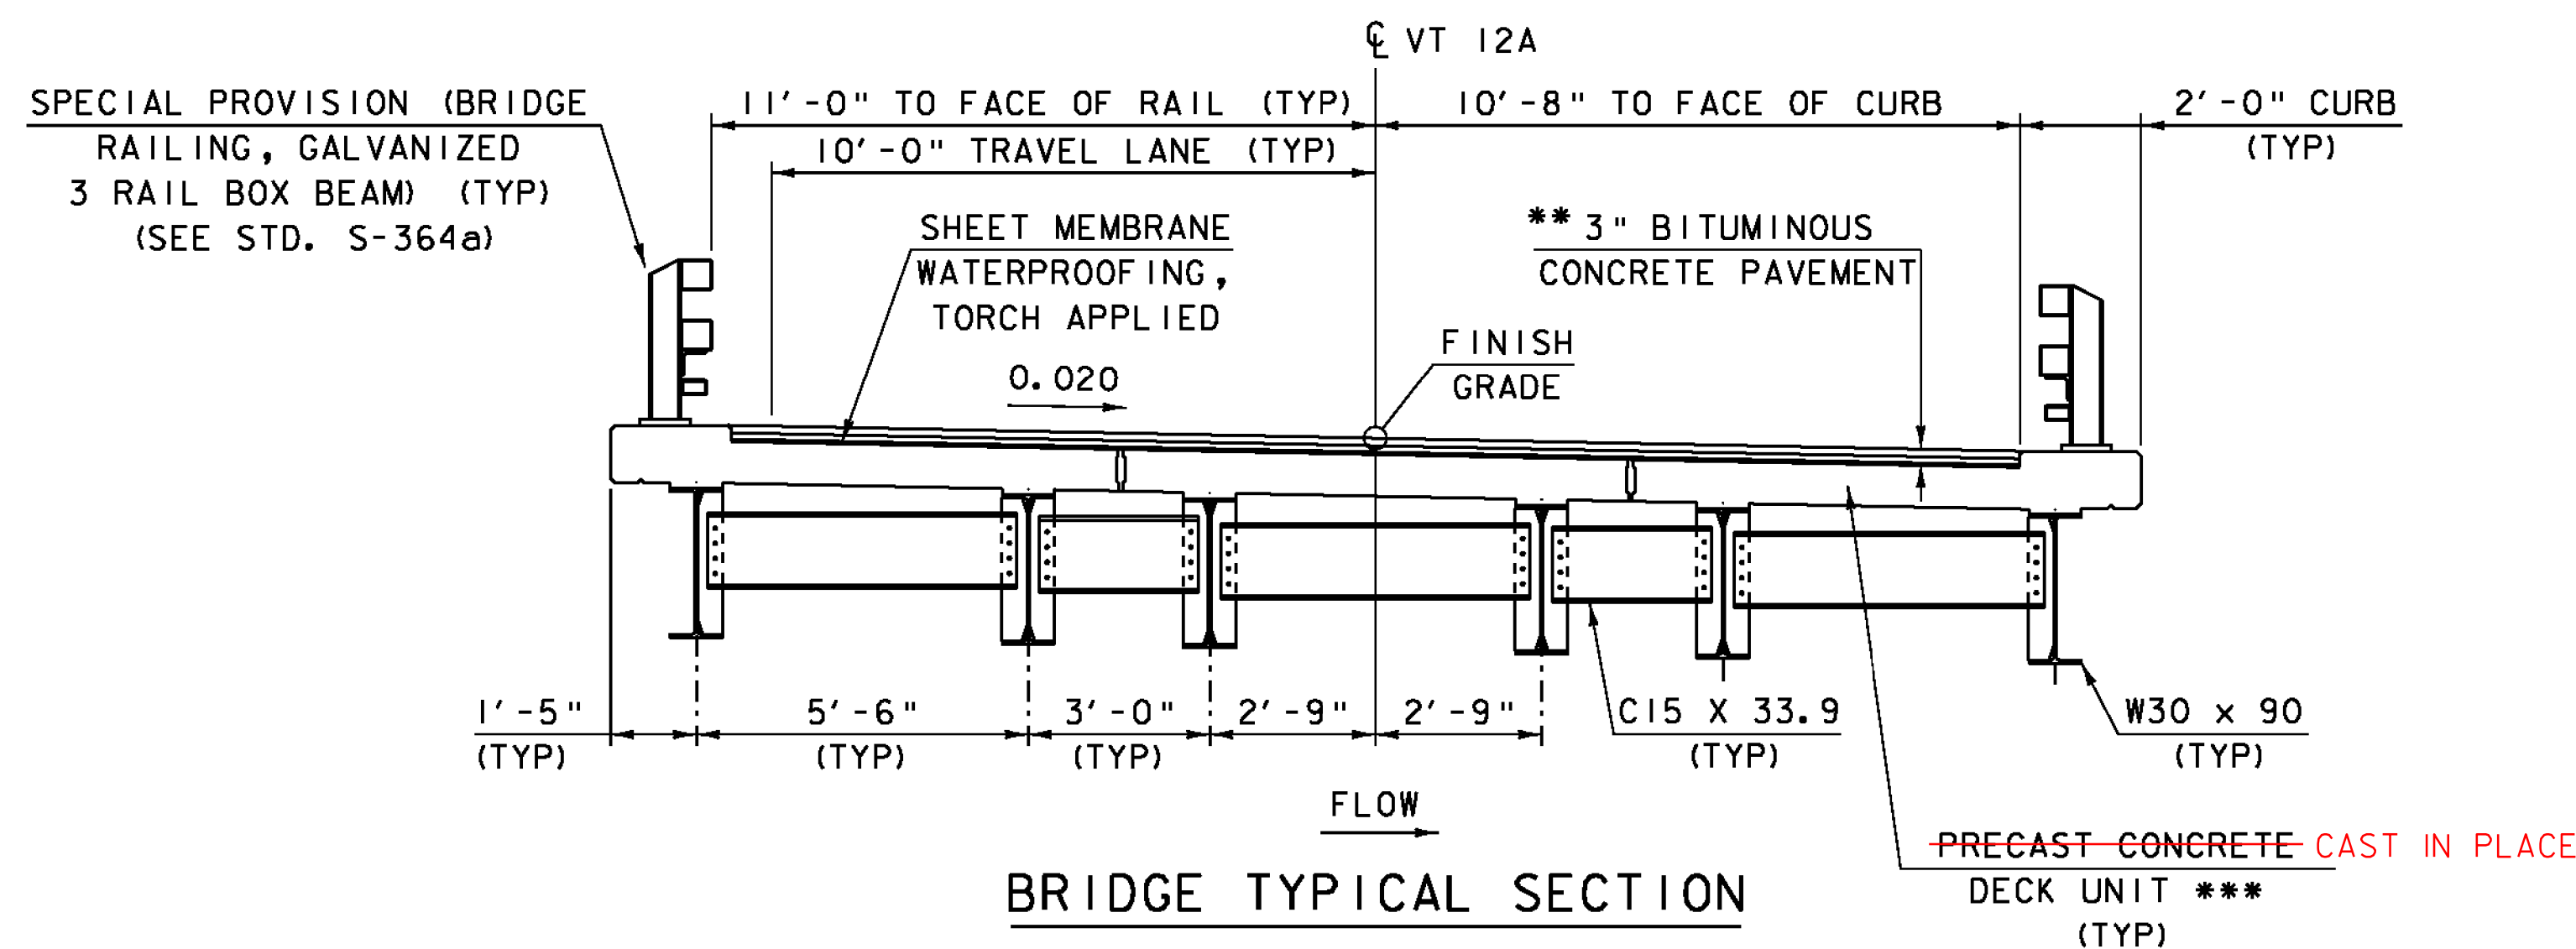

BRIDGE TYPICAL SECTION

** 2 LIFTS OF 1½" BITUM. CONC. PAVEMENT TYPE IIIS PAID UNDER SPECIAL PROVISION (BITUMINOUS CONCRETE PAVEMENT, SMALL QUANTITY).
 *** SEE PRECAST CONCRETE/STEEL COMPOSITE SUPERSTRUCTURE OF SECTION 900 OF THE SPECIAL PROVISIONS.

MATERIAL TOLERANCES

(IF USED ON PROJECT)

SURFACE	
- PAVEMENT (TOTAL THICKNESS)	+/- ¼"
- AGGREGATE SURFACE COURSE	+/- ½"
SUBBASE	+/- 1"
SAND BORROW	+/- 1"
GRANULAR BORROW	+/- 1"

PROJECT NAME: ROXBURY
 PROJECT NUMBER: BHF 0187(8)

FILE NAME: sl0c420typ.dgn PLOT DATE: 21-SEP-2011
 PROJECT LEADER: C. P. WILLIAMS DRAWN BY: G. ROY
 DESIGNED BY: G. ROY CHECKED BY: T. FILLBACH
 PROJECT TYPICAL SECTIONS SHEET 13 OF 54