



PLAN
SCALE: 1" = 10'-0"

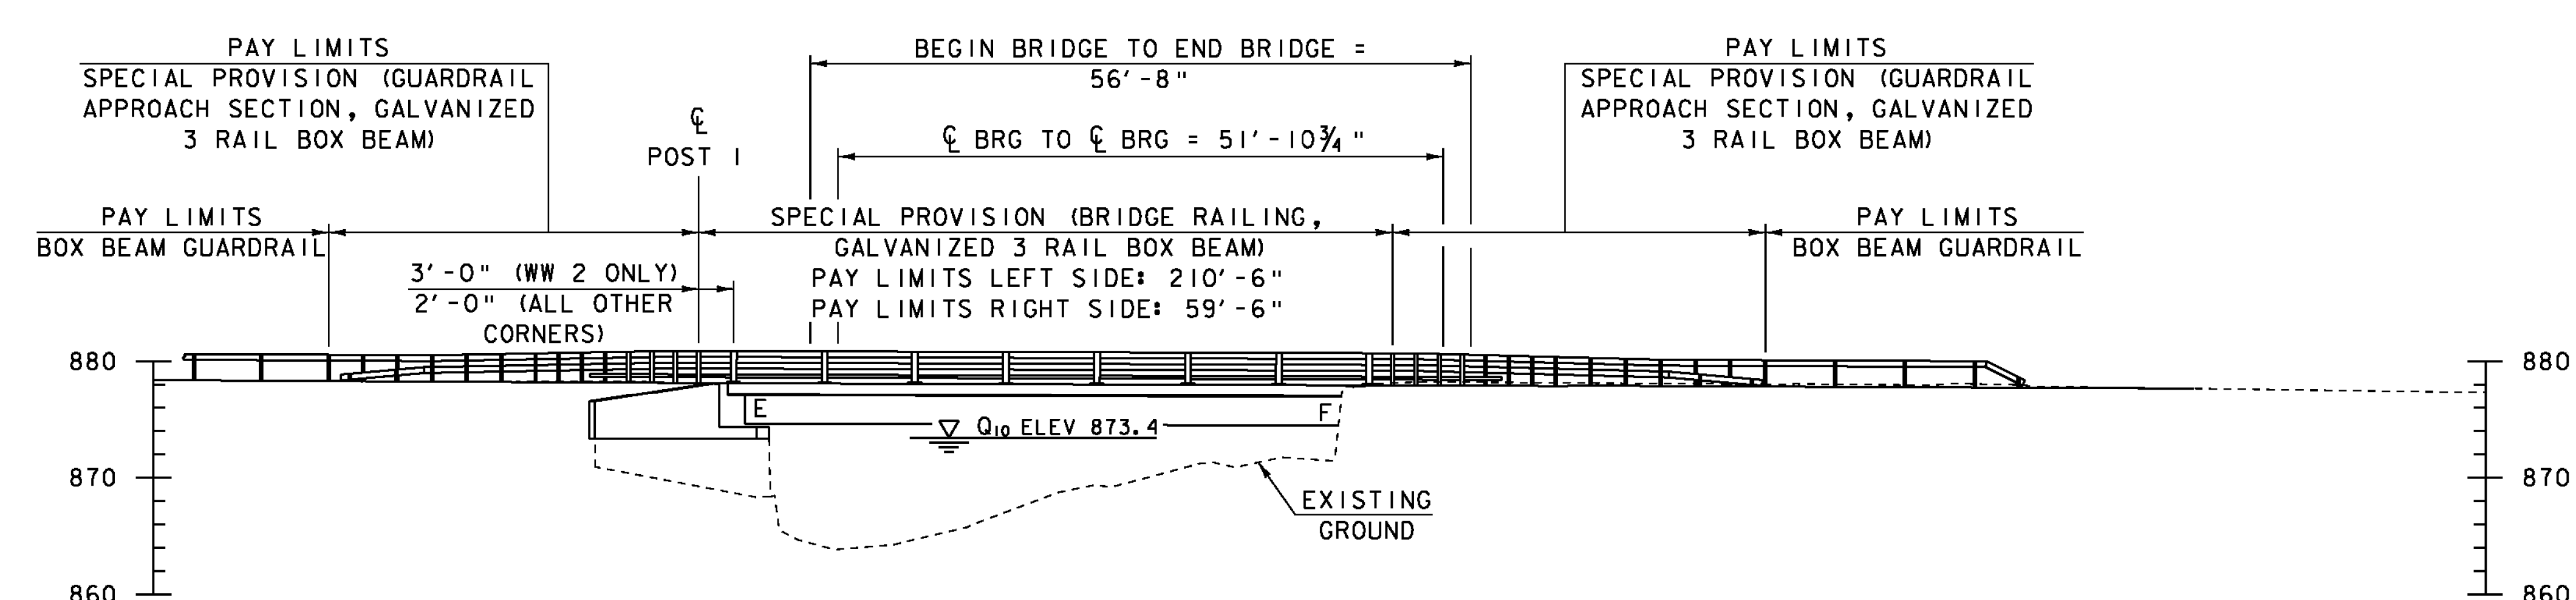

ELEVATION
SCALE: 1" = 10'-0"

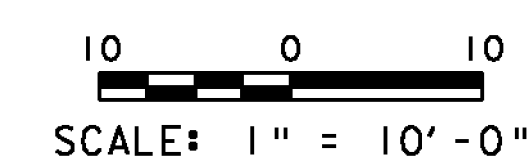

PROJECT NAME: ROXBURY	PLOT DATE: 21-SEP-2011
PROJECT NUMBER: BHF 0187(8)	DRAWN BY: G. ROY
FILE NAME: s10c420pe.dgn	CHECKED BY: T. FILLBACH
PROJECT LEADER: C. P. WILLIAMS	SHEET 16 OF 54
DESIGNED BY: G. ROY	
PLAN AND ELEVATION	