
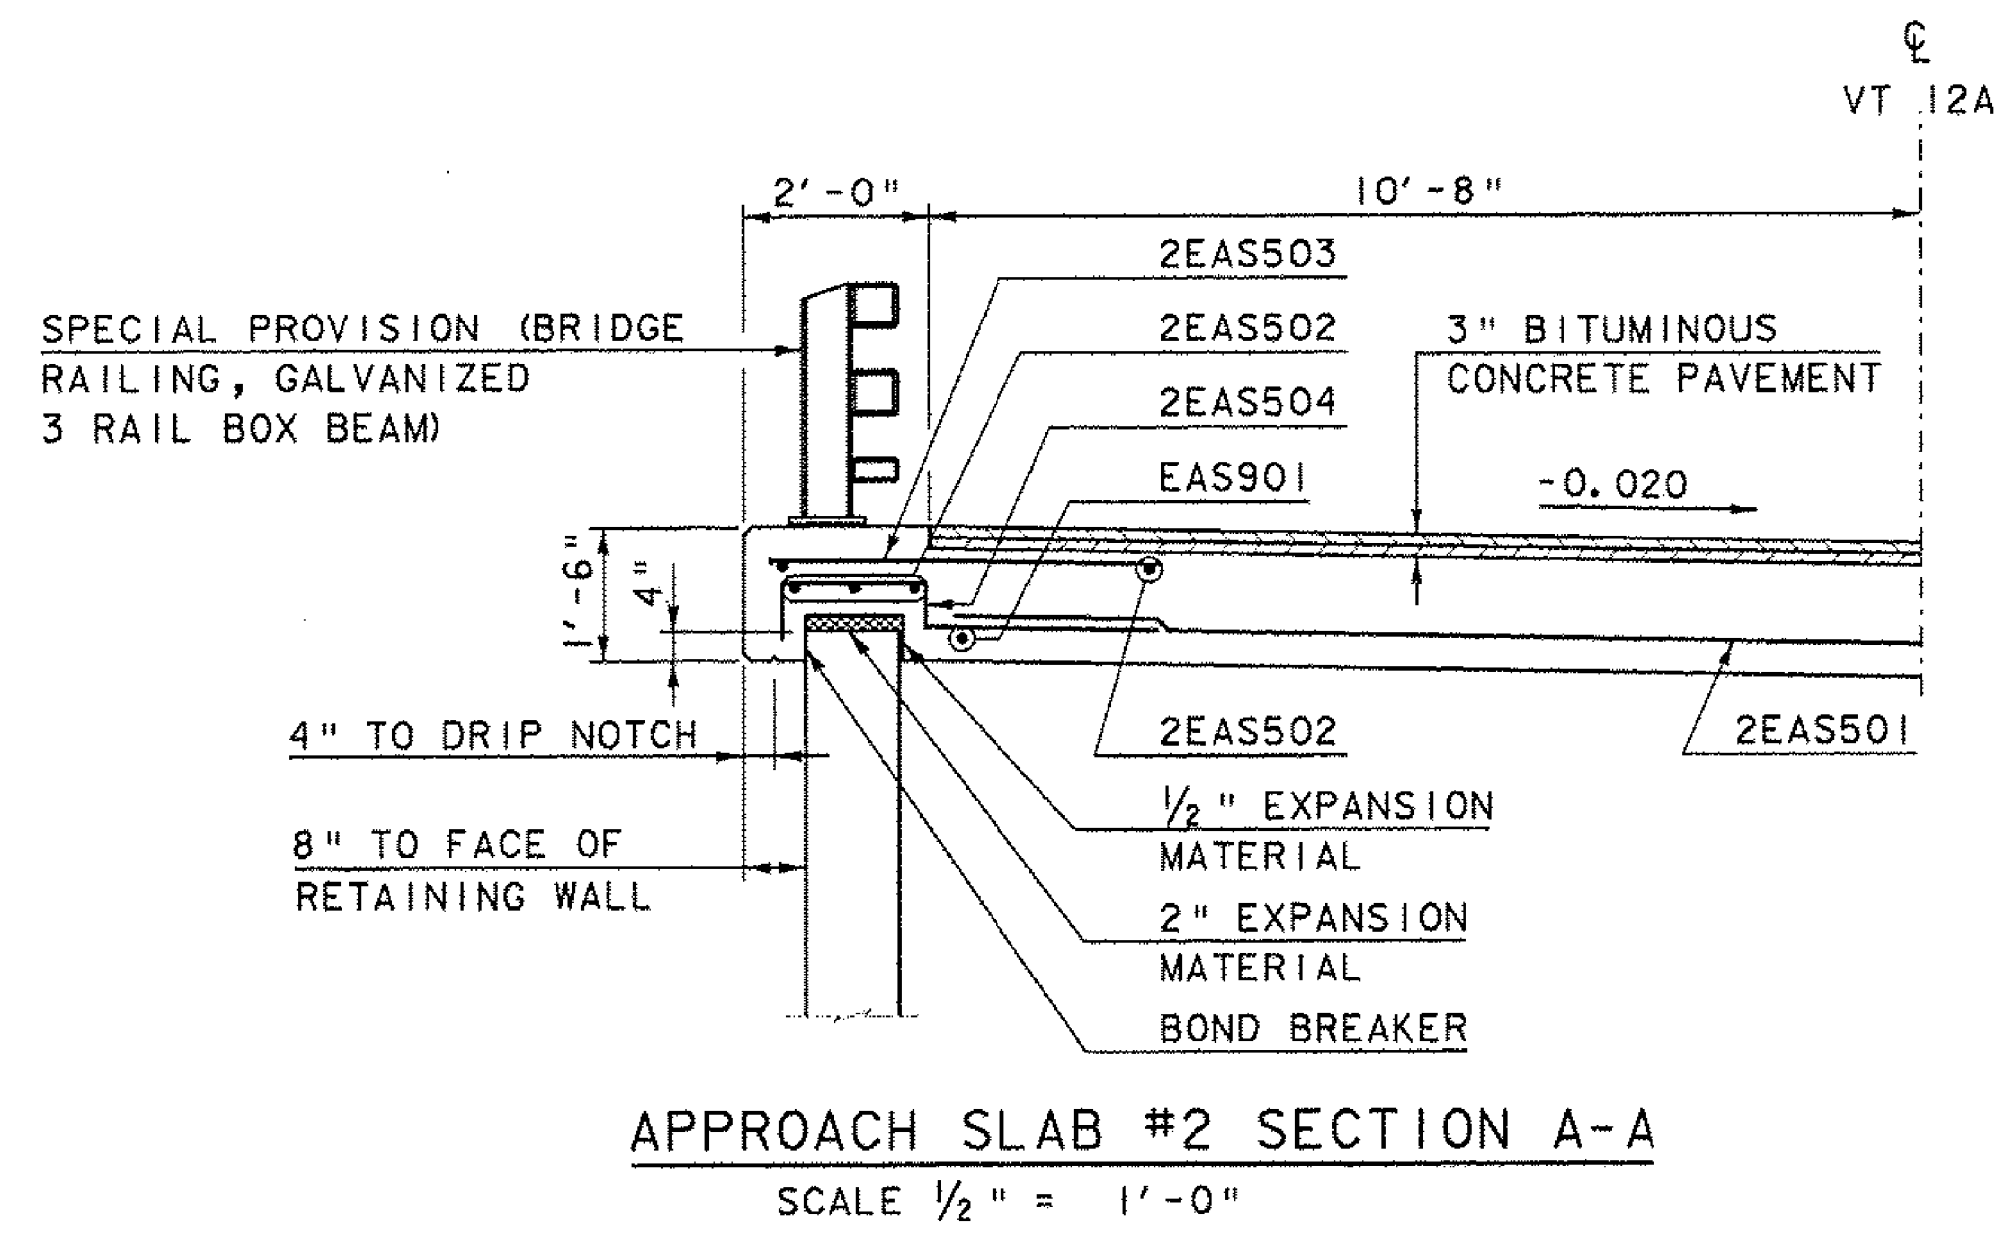


NOTE:

- NF = NEAR FACE
- FF = FAR FACE
- EF = EACH FACE
- ▲ = CUT TO FIT IN FIELD
- 3" CLEAR, UNLESS OTHERWISE SPECIFIED ON THE PLANS.
- 3'-0" BAR LAP UNLESS OTHERWISE SPECIFIED ON THE PLANS.
- E - EPOXY

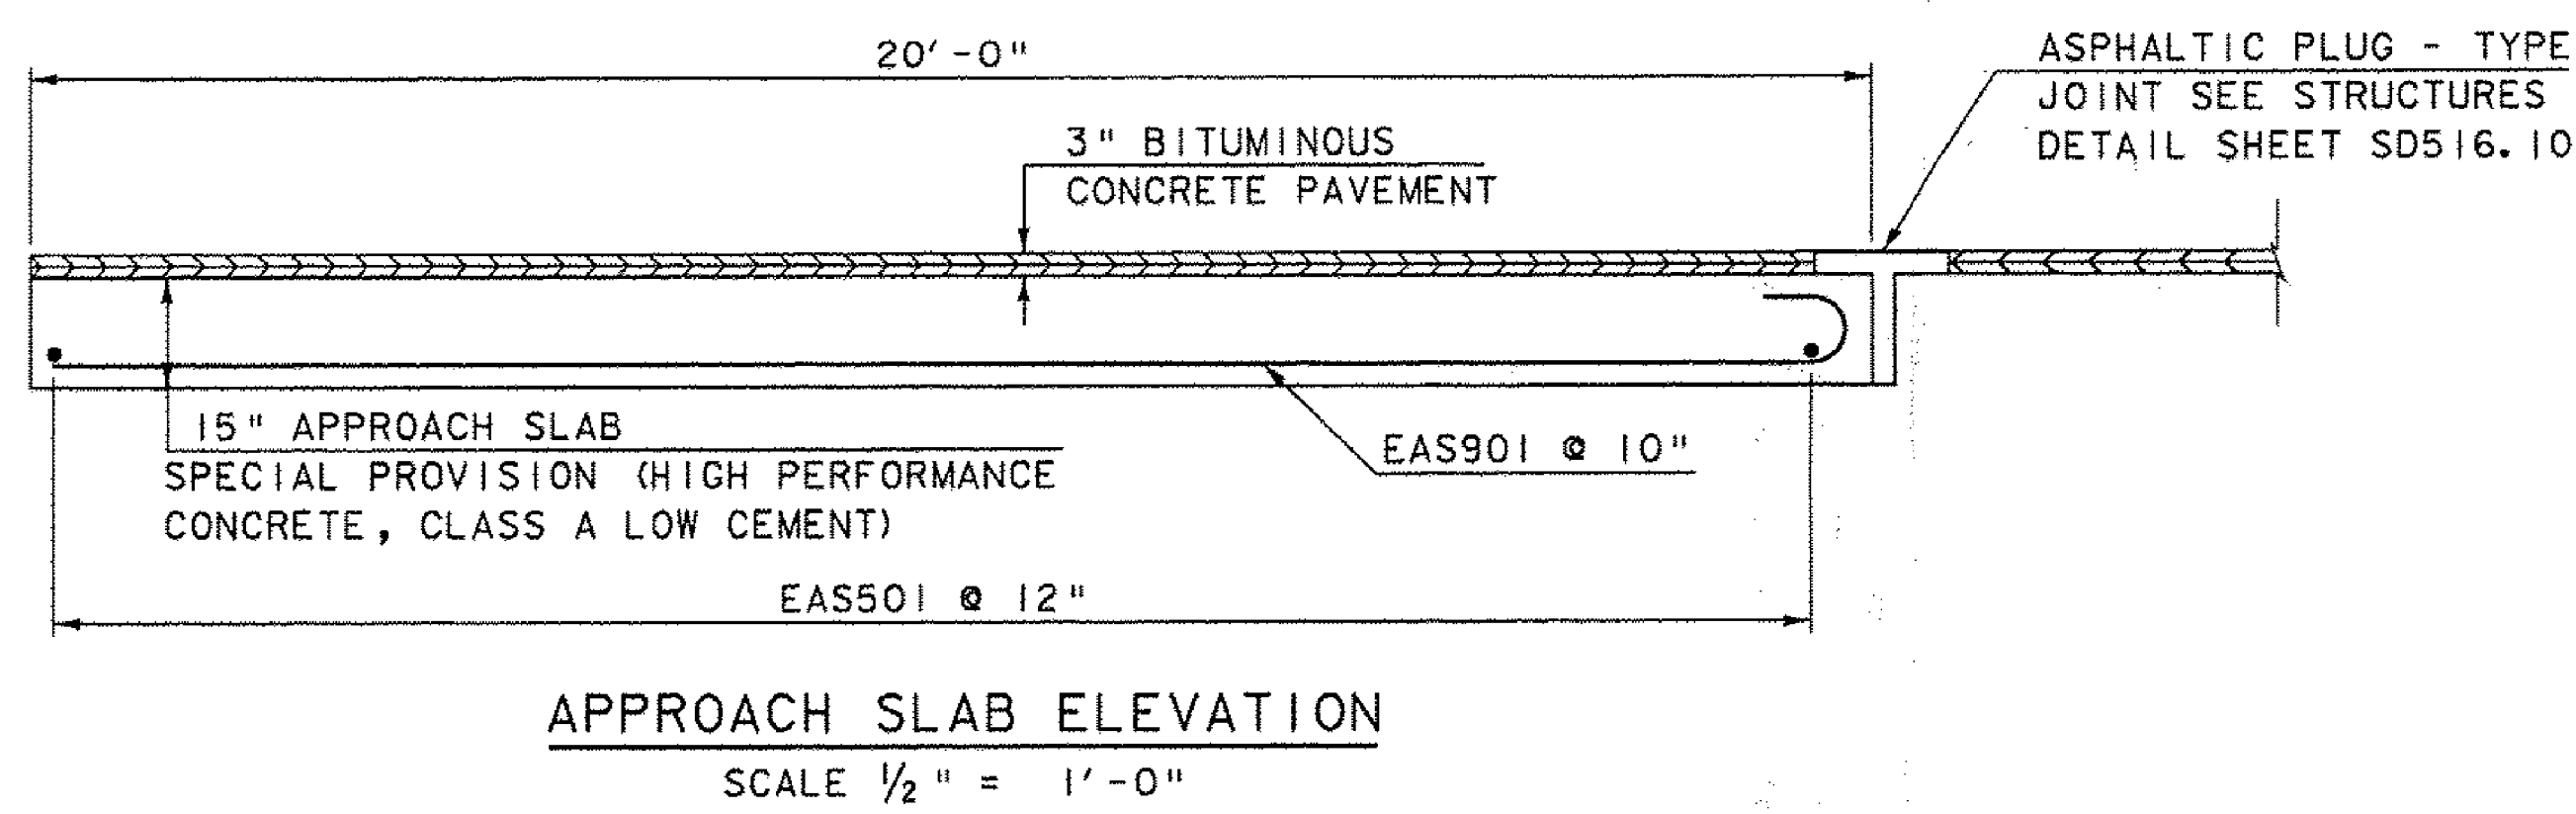

PROJECT NAME: ROXBURY
 PROJECT NUMBER: BHF 0187(8)

FILE NAME: s10c420slab.dgn PLOT DATE: 07-NOV-2011
 PROJECT LEADER: C. WILLIAMS DRAWN BY: J. SALVATORI
 DESIGNED BY: R. YOUNG CHECKED BY: E. CHARBONNEAU
 APPROACH SLAB DETAILS SHEET 17 OF 38 54

REVISION	DATE	DESCRIPTION	BY
△	11-7-2011	DIMENSION APPROACH SLAB WIDTH	MCL