


**JOINT DETAIL A**

SCALE: 1" = 1'-0"

TYPICAL WINGWALL TO ABUTMENT CAP JOINT DETAIL AT ABUTMENT FACE.

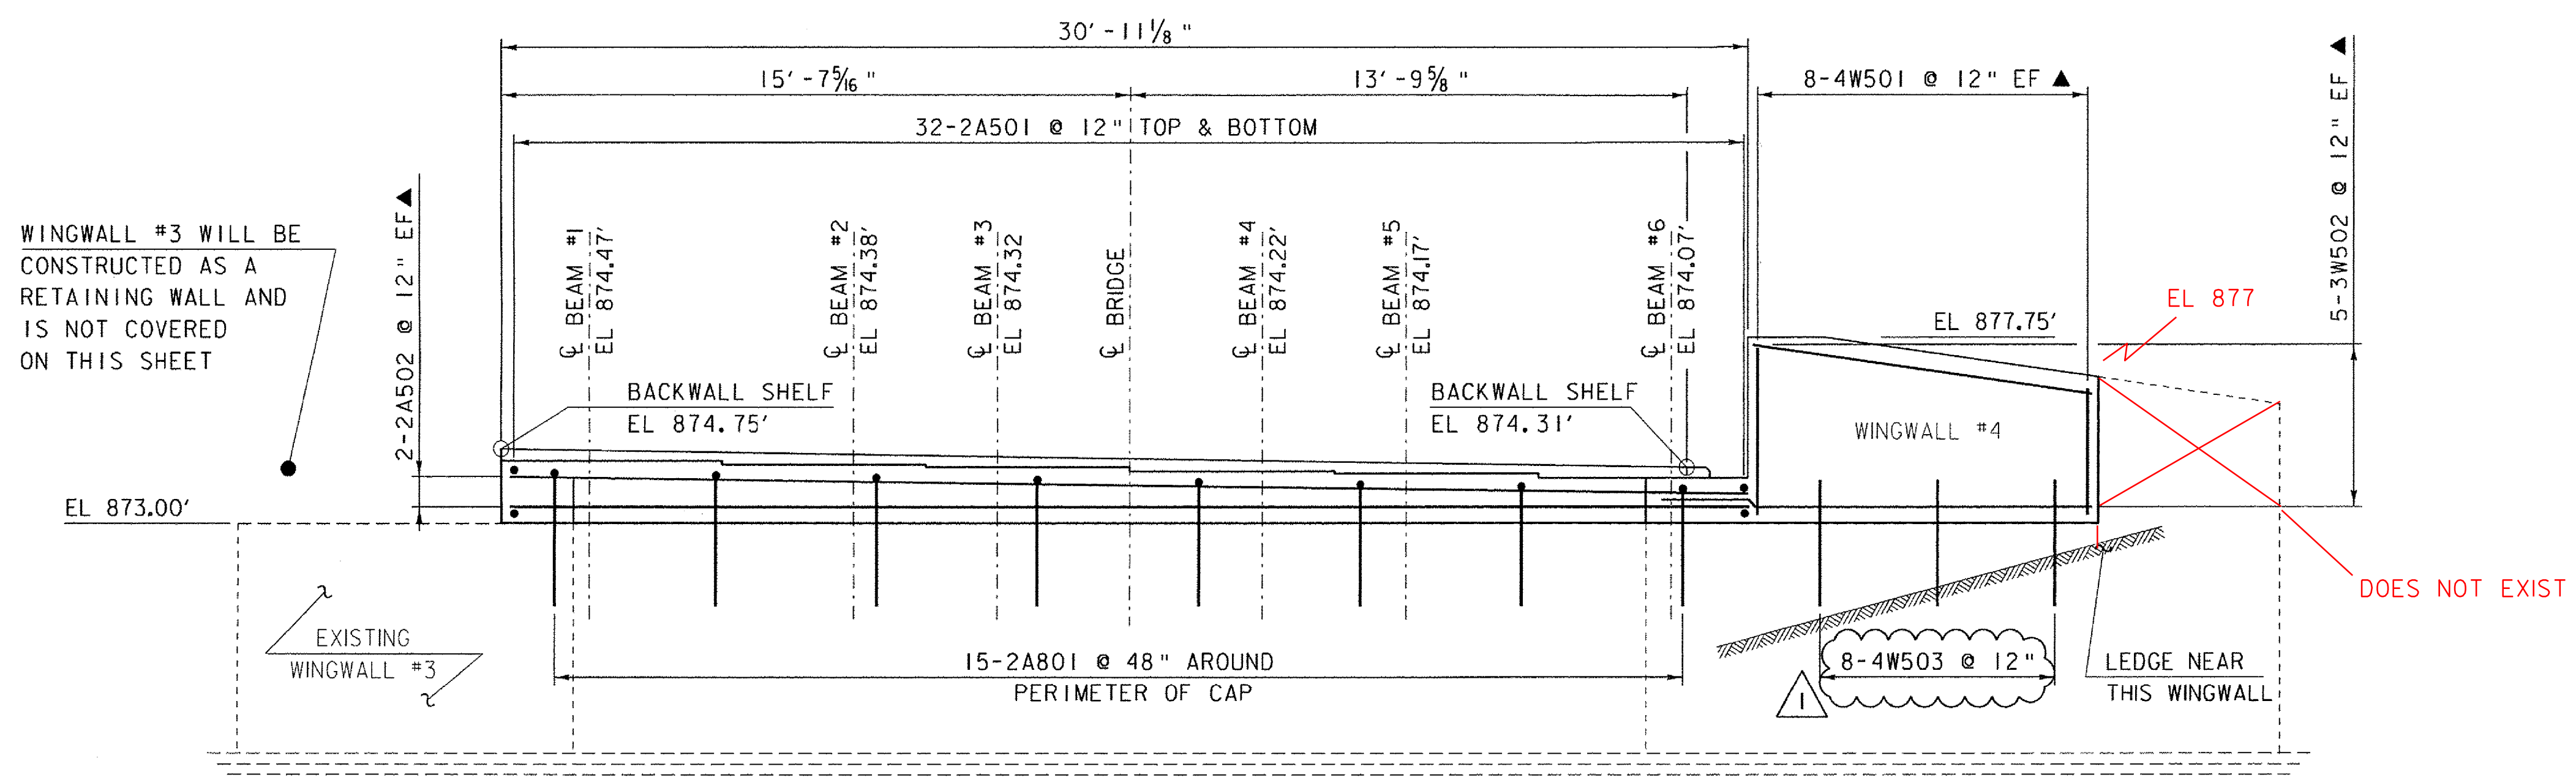

**NOTE:**

NF = NEAR FACE  
 FF = FAR FACE  
 EF = EACH FACE  
 ▲ = CUT TO FIT IN FIELD  
 3" CLEAR, UNLESS OTHERWISE SPECIFIED ON THE PLANS.  
 2'-2" BAR LAP UNLESS OTHERWISE SPECIFIED ON THE PLANS.

**ABUTMENT 2 ELEVATION**

SCALE: 3/8" = 1'-0"

REVISION	DATE	DESCRIPTION	BY
1	11-7-2011	WW REBAR REV. AND DIMENSION CL EXTERIOR BEAM BEARING LOCATION	MCL

PROJECT NAME: ROXBURY	PLOT DATE: 07-NOV-2011
PROJECT NUMBER: BHF 0187 (8)	DRAWN BY: M. LONGSTREET
FILE NAME: sl0c420sub.dgn	CHECKED BY: E.R. CHARBONNEAU
PROJECT LEADER: C.P. WILLIAMS	SHEET 18 OF 35
DESIGNED BY: R.S. YOUNG	
ABUTMENT #2 PLAN & ELEVATION	