


**BASE SLAB LAYOUT**

SCALE 1" = 5'-0"  
 5 0 5

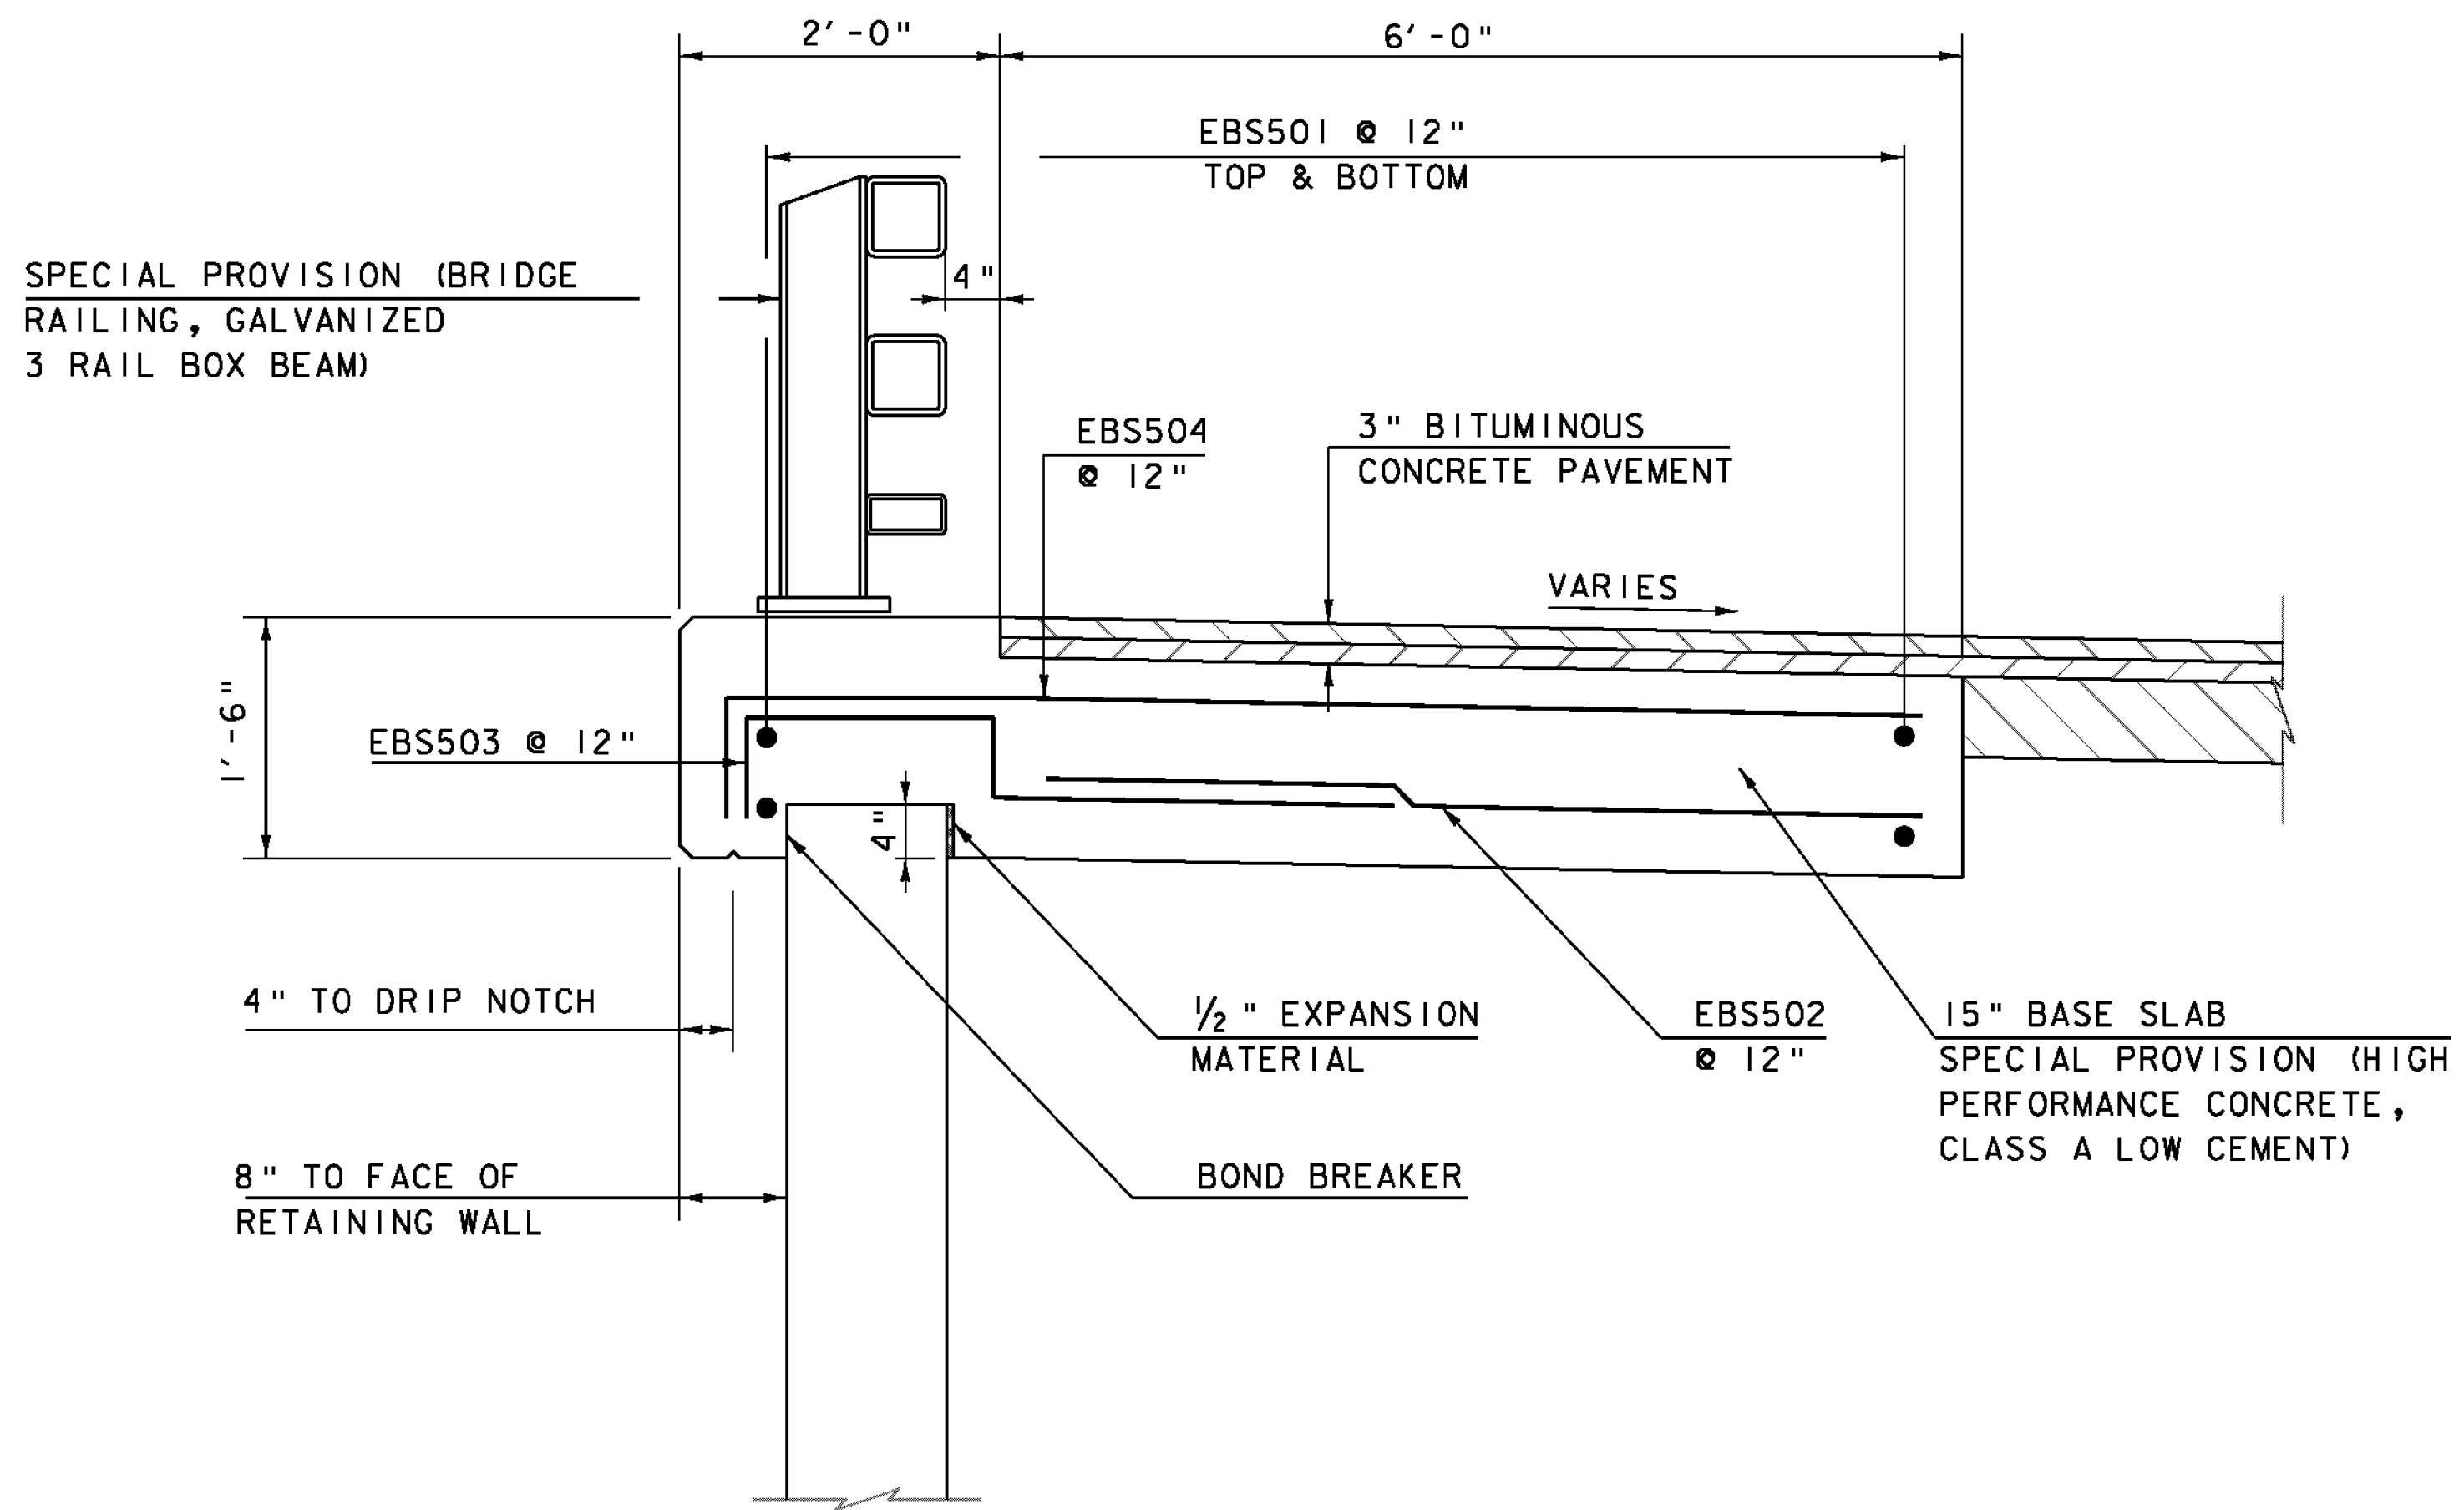

**BASE SLAB TYPICAL**

SCALE 1" = 1'-0"  
 1 9 6 3 0 2

STATION	RETAINING WALL		BASE SLAB	
	ELEVATION	OFFSET	ELEVATION	OFFSET
4+64.91	877.04	12.00 LT	878.20-09	12.67 LT
4+75.00	876.89	12.00 LT	877.09-878.06	12.67 LT
5+00.00	876.43	12.00 LT	877.59	12.67 LT
5+25.00	875.94	12.00 LT	877.10	12.67 LT
5+50.00	875.60	12.00 LT	876.76-78	12.67 LT
5+75.00	875.41	12.00 LT	876.58-61	12.67 LT
5+99.30	875.35	12.00 LT	876.52-55	12.67 LT

PROJECT NAME: ROXBURY  
 PROJECT NUMBER: BHF 0187(8)  
 FILE NAME: s10c420ret.dgn  
 PROJECT LEADER: C. WILLIAMS  
 DESIGNED BY: R. YOUNG  
 BASE SLAB LAYOUT & DETAILS  
 PLOT DATE: 21-SEP-2011  
 DRAWN BY: J. SALVATORI  
 CHECKED BY: E. CHARBONNEAU  
 SHEET 26 OF 54