




3+25

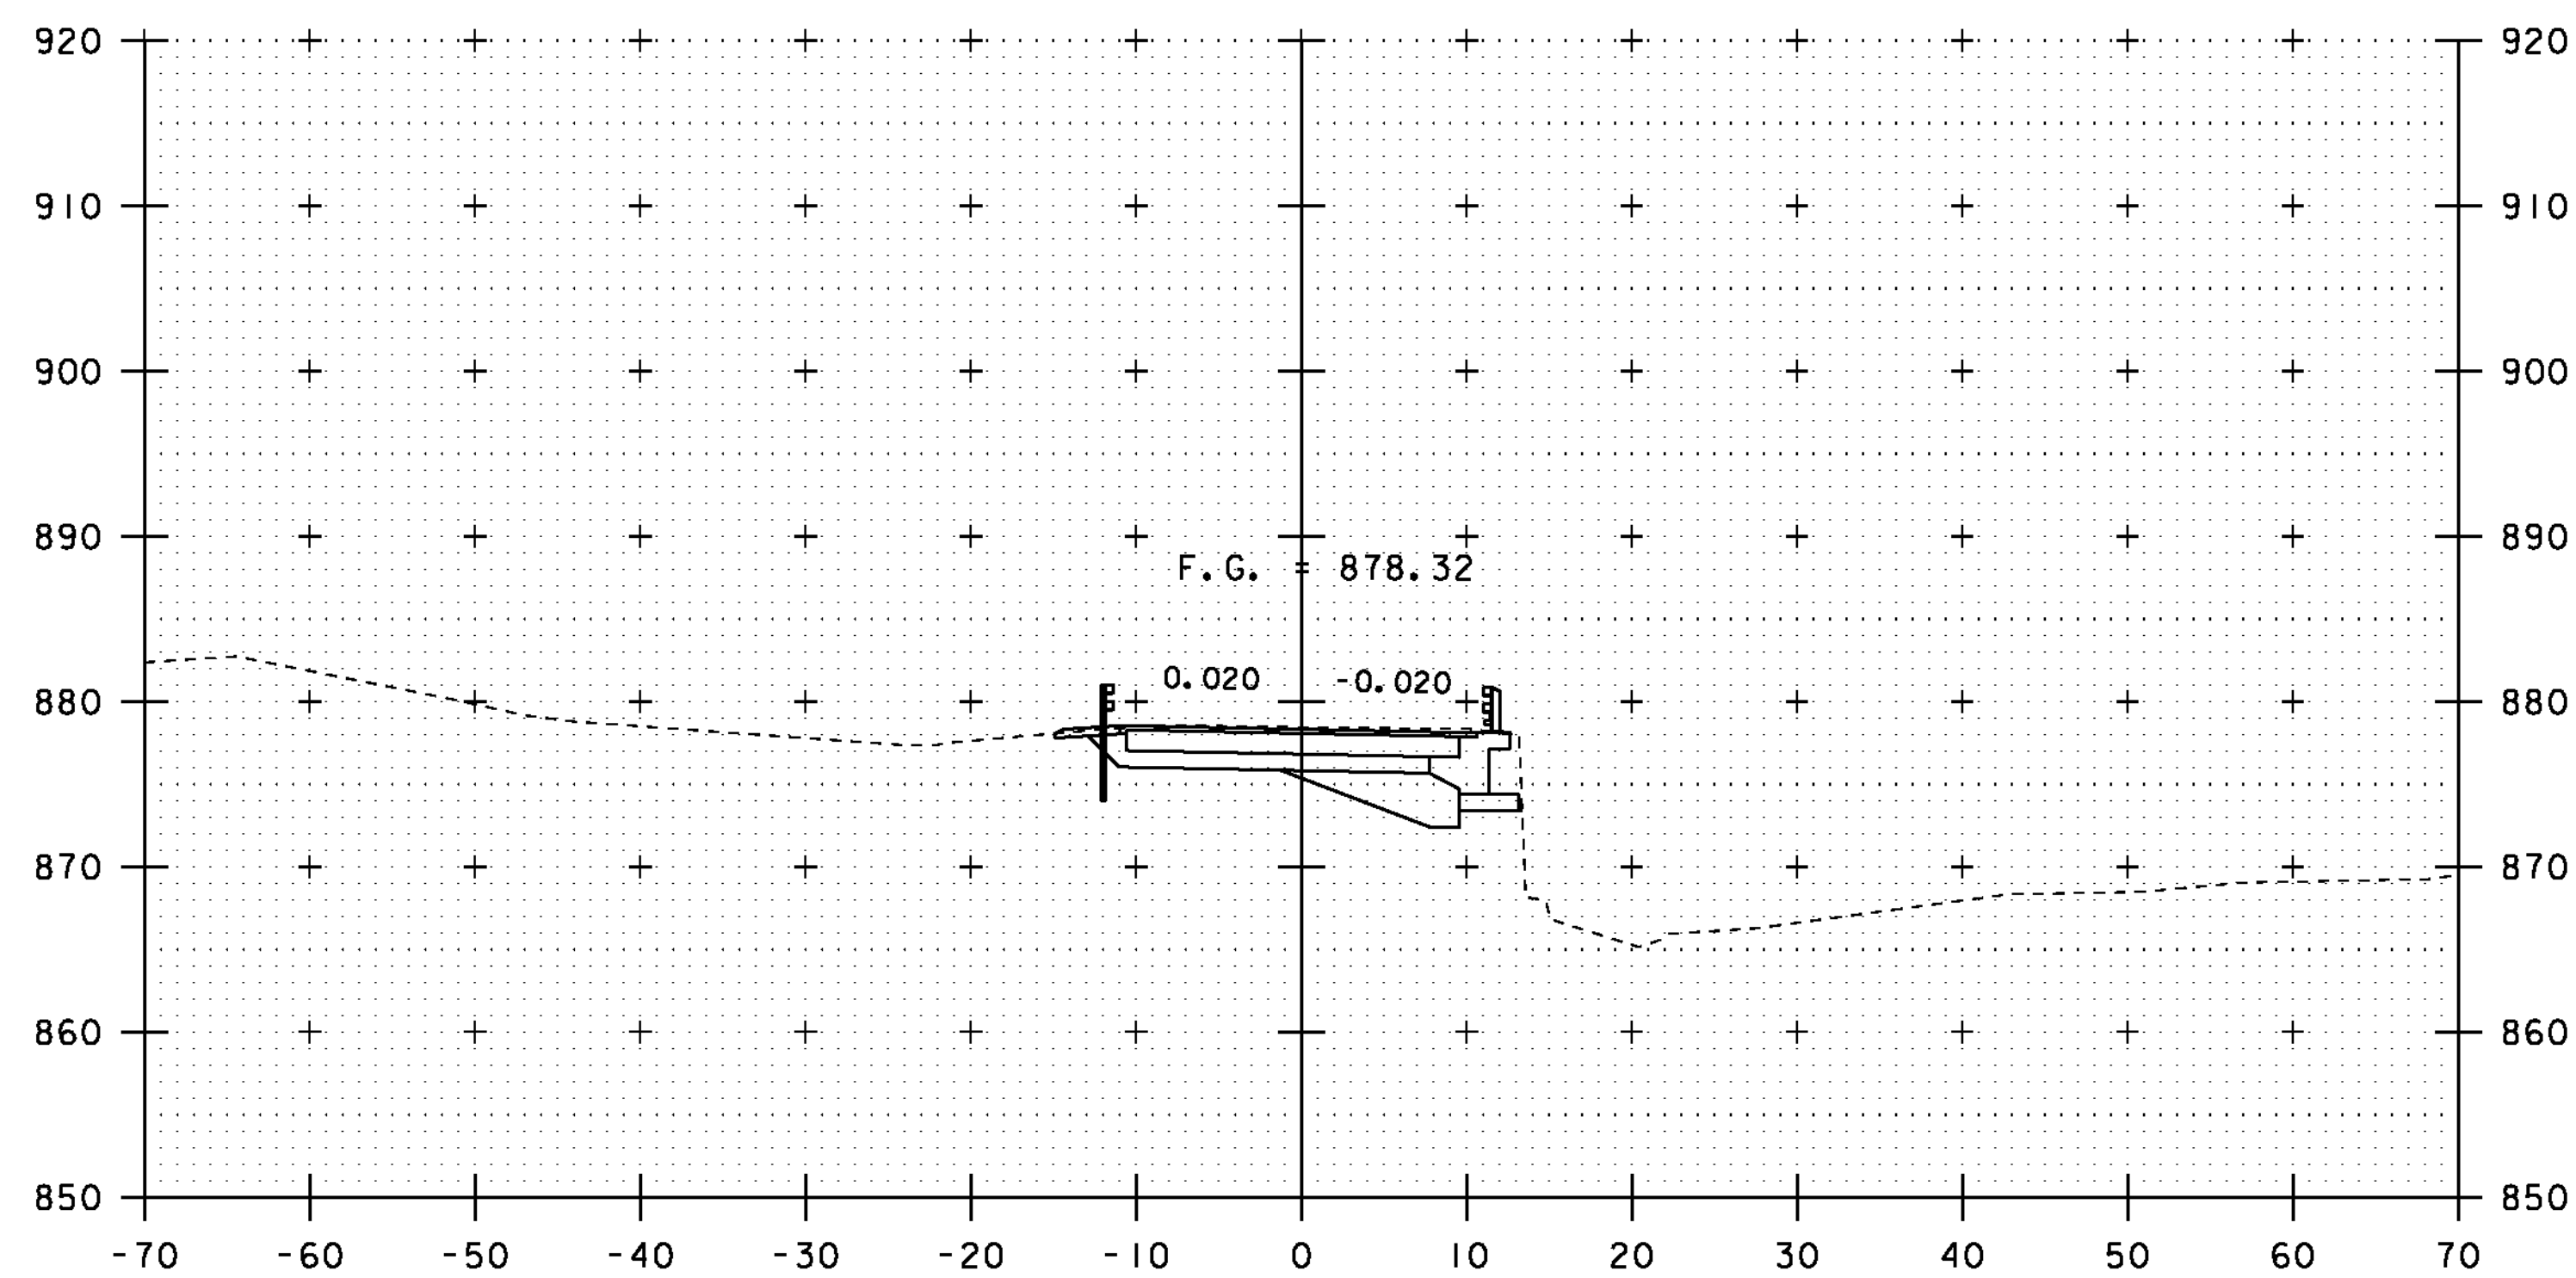

3+75

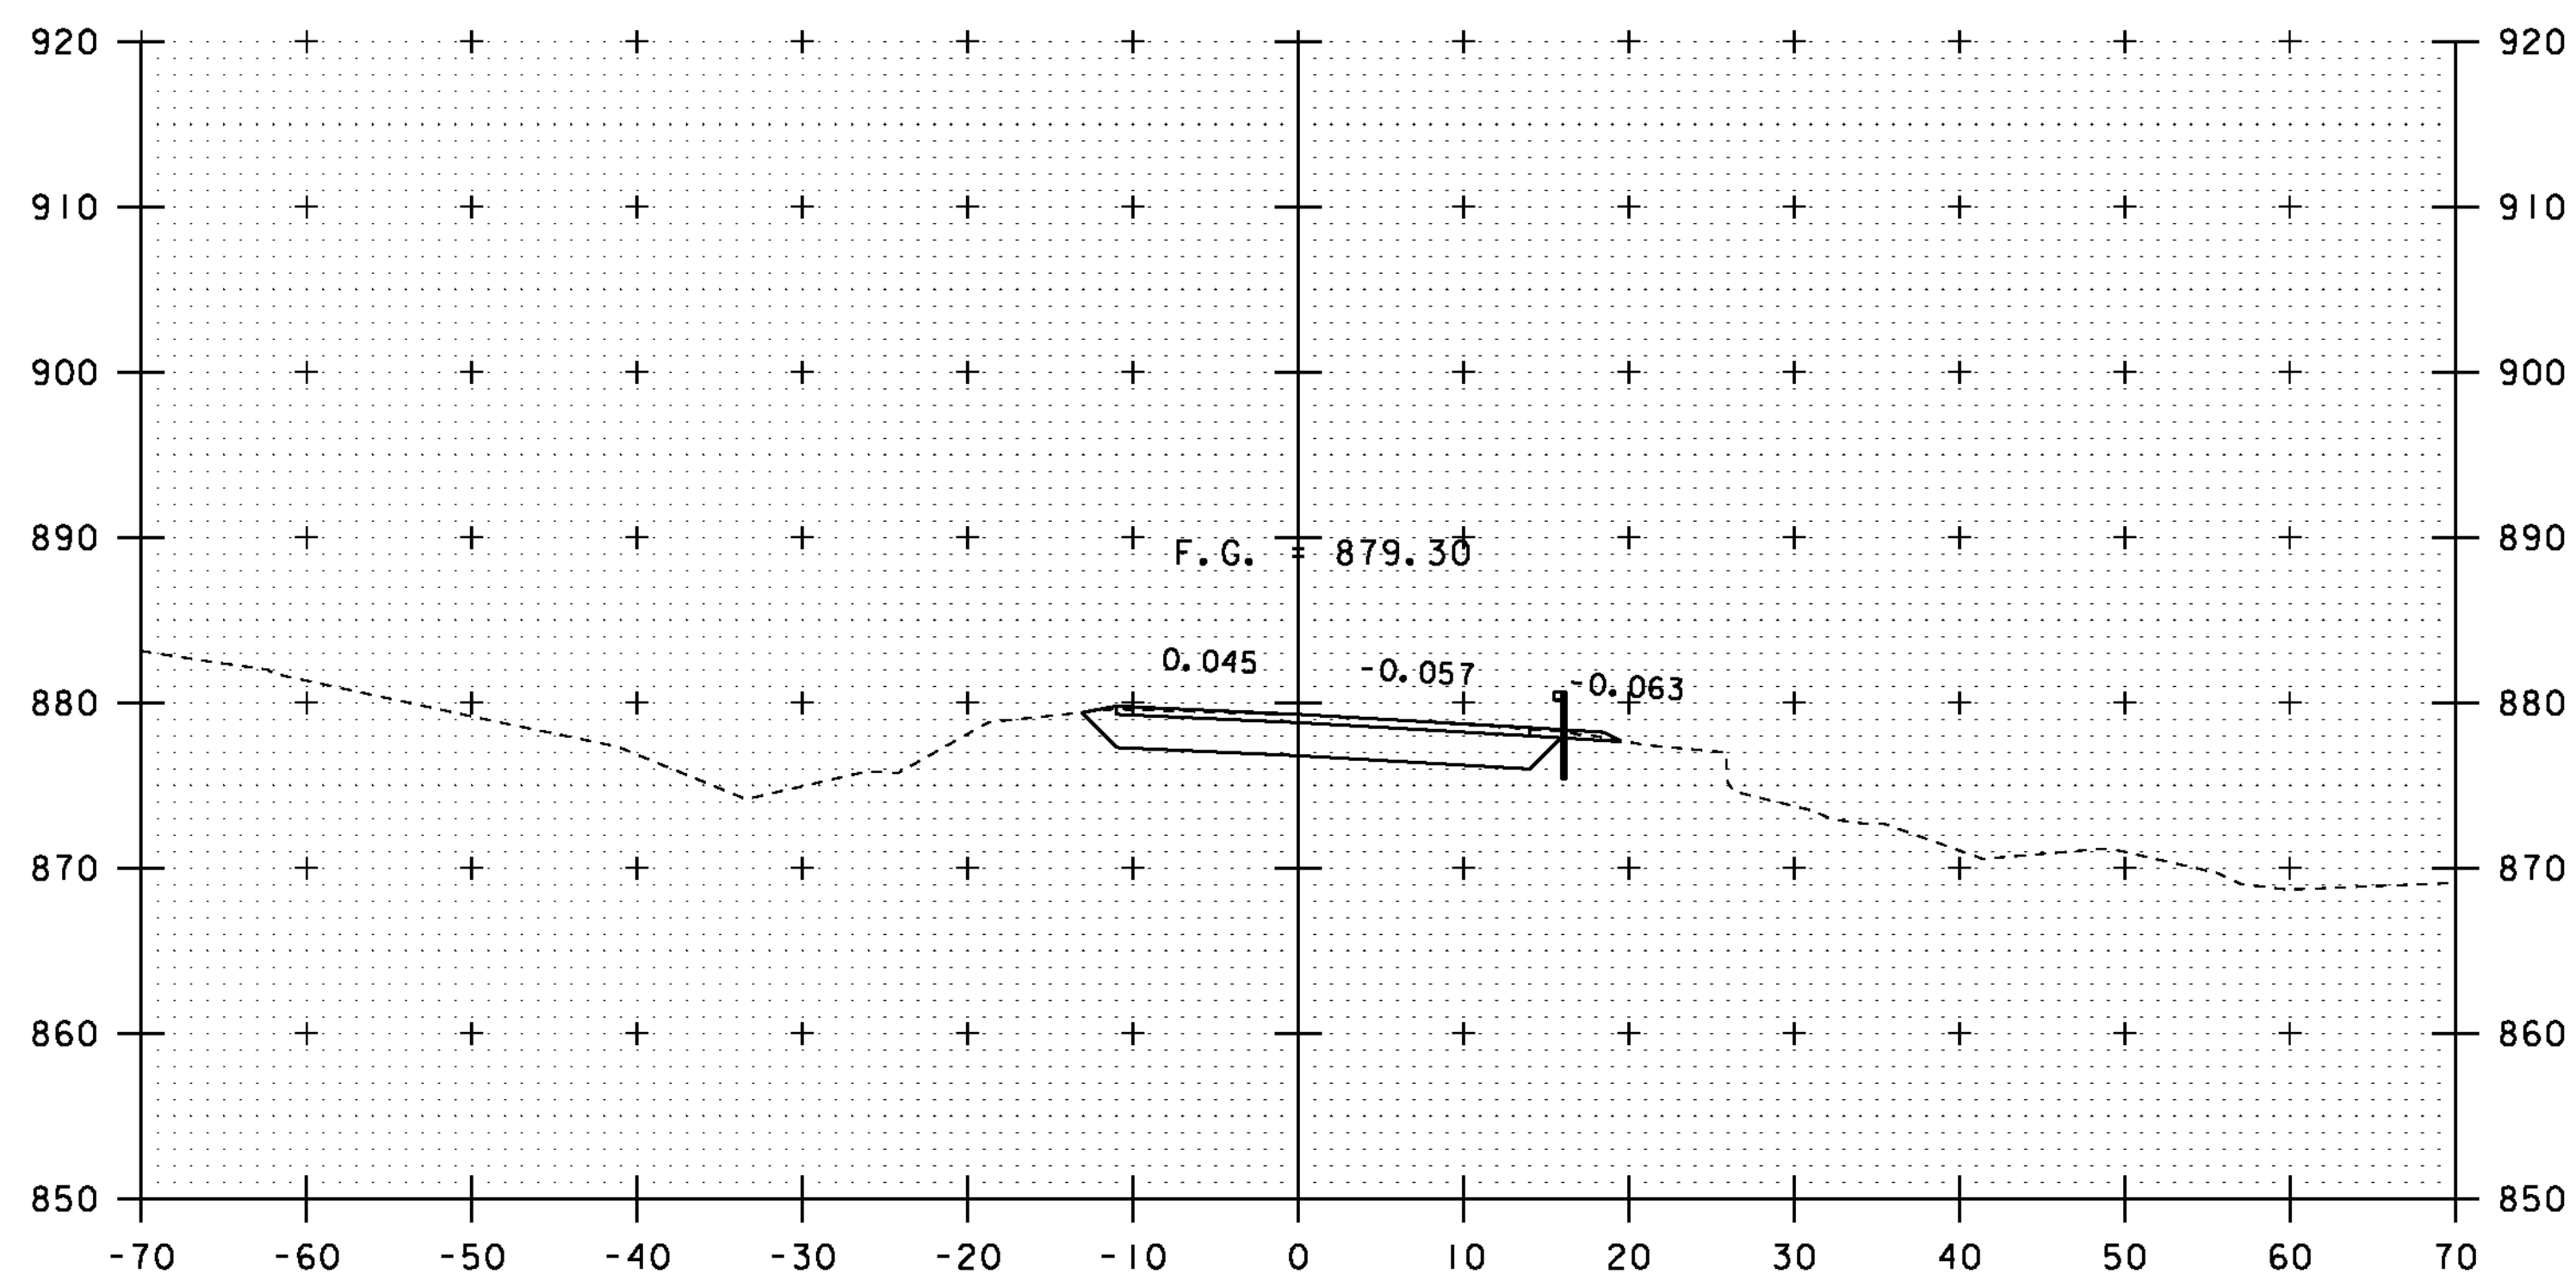


3+00

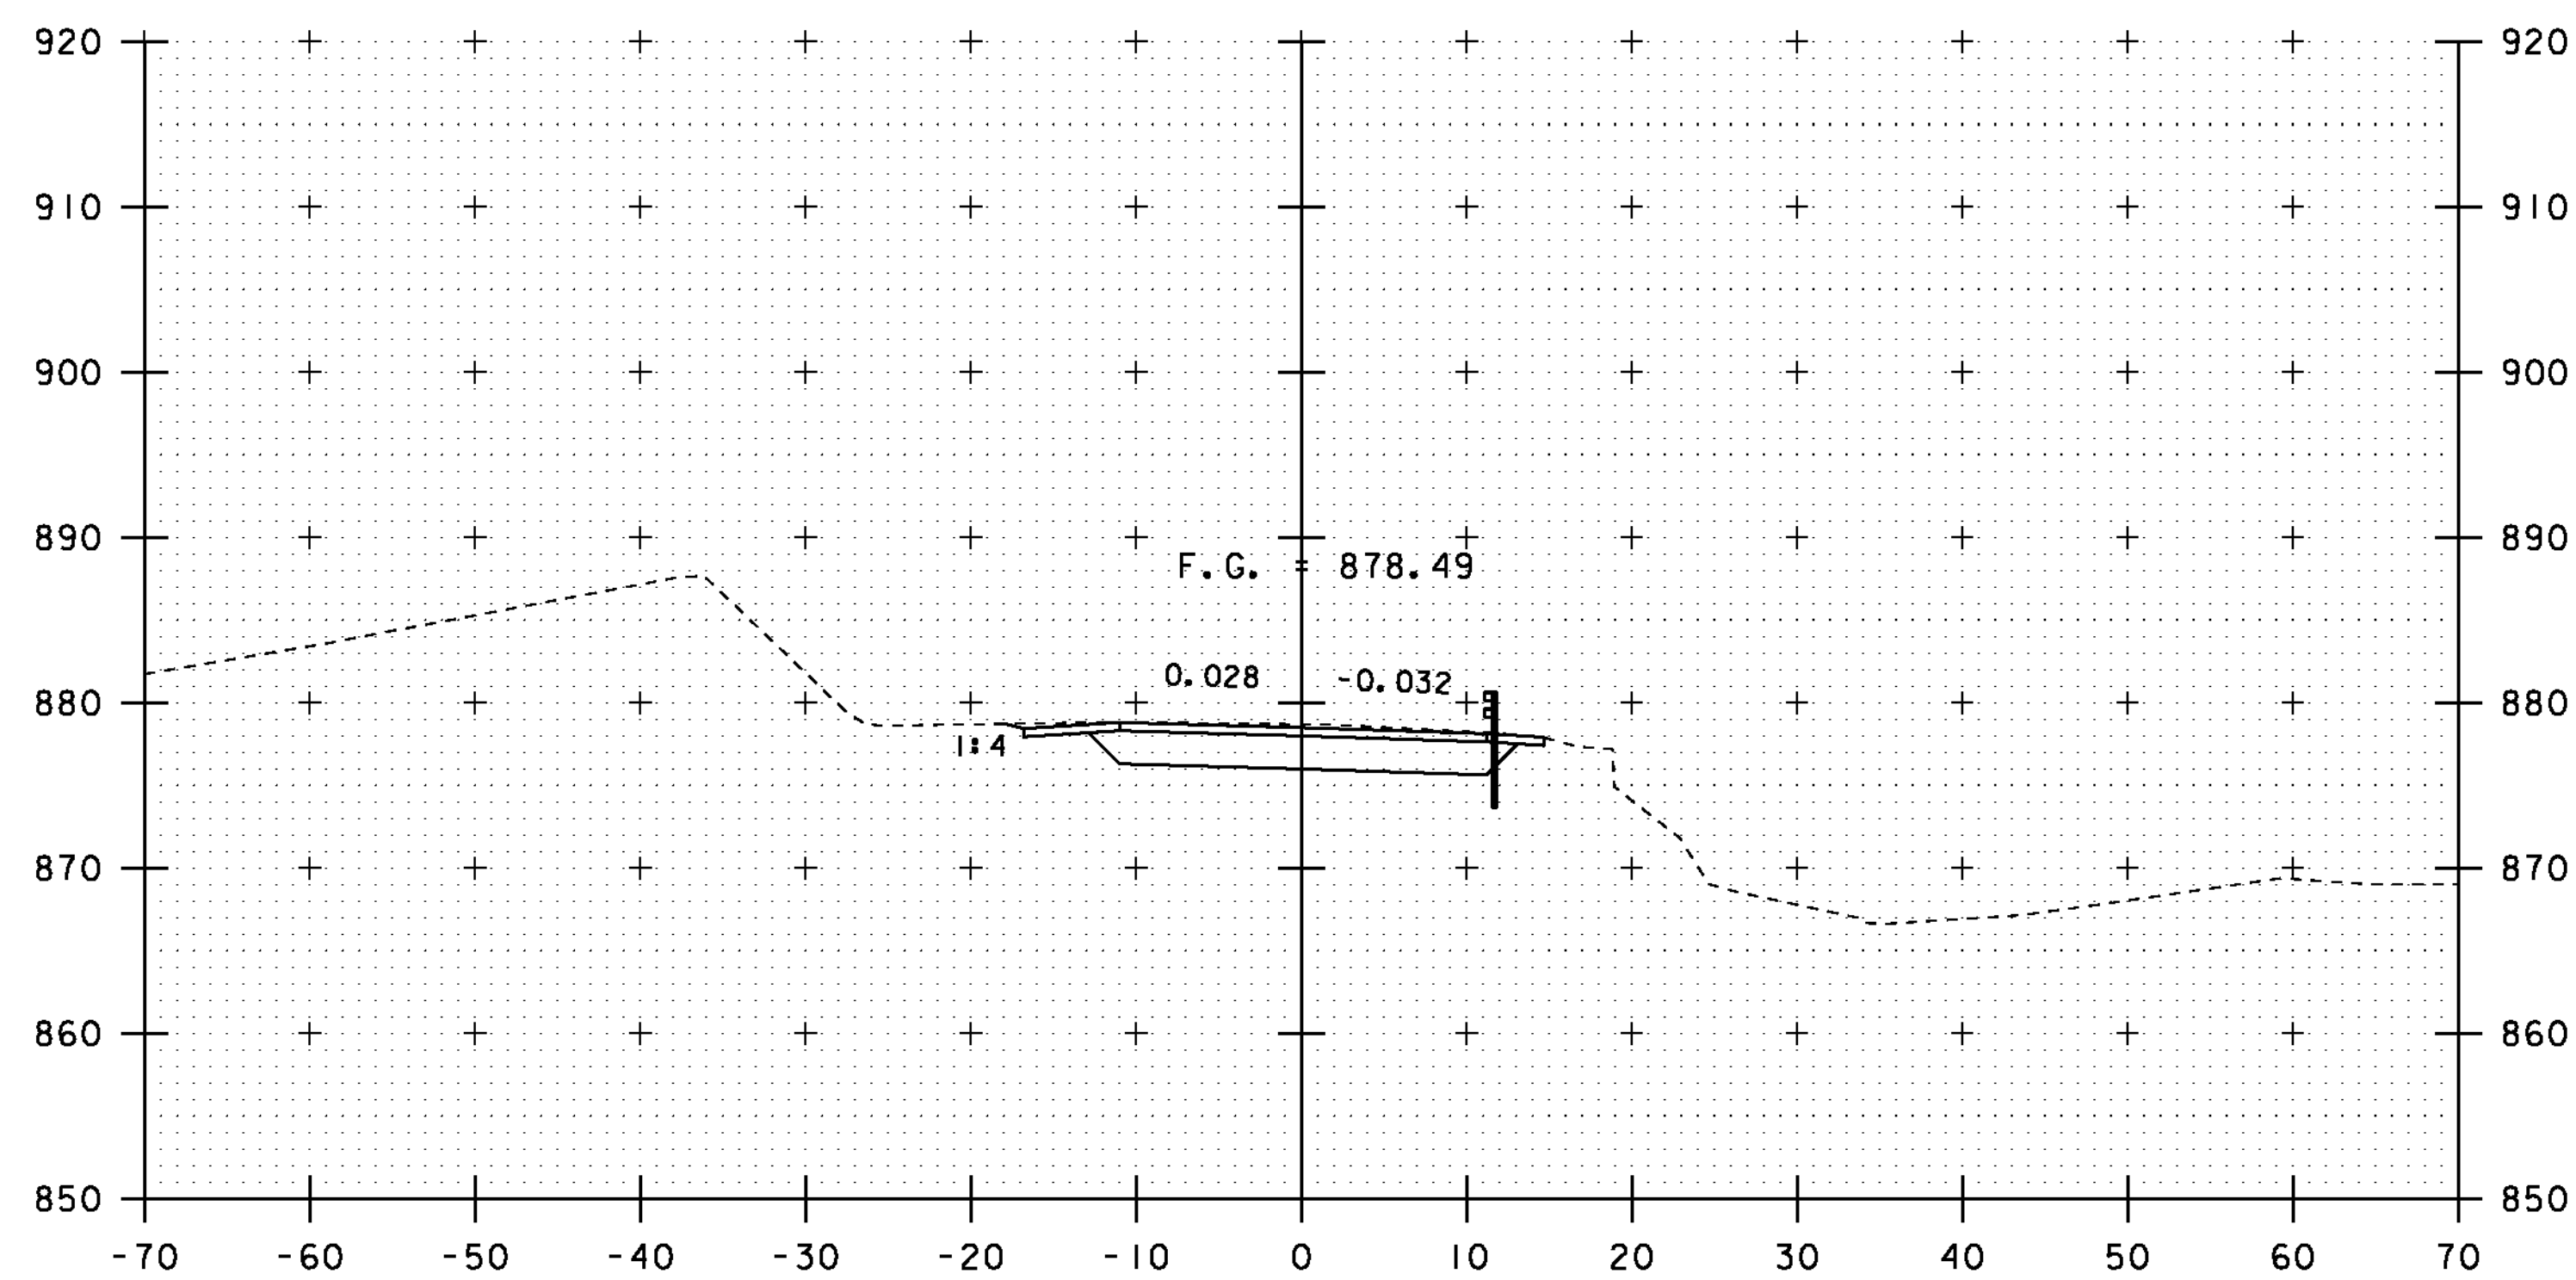

3+50

SEE SHEET 37 FOR NEW OPTION PIPE SECTION AT STA 2+89.2.

END APPROACH
BEGIN PROJECT
STA 3+00.00

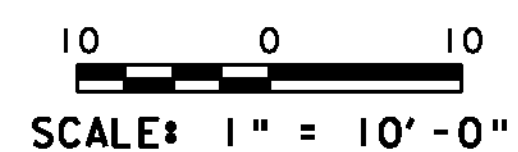

STA. 3+00 TO STA. 3+75

PROJECT NAME: ROXBURY	PLOT DATE: 21-SEP-2011
PROJECT NUMBER: BHF 0187(8)	DRAWN BY: G. ROY
FILE NAME: sl0c420xsl.dgn	CHECKED BY: T. FILLBACH
PROJECT LEADER: C. P. WILLIAMS	SHEET 33 OF 54
DESIGNED BY: G. ROY	
VT I2A CROSS SECTIONS (2)	