




6+25

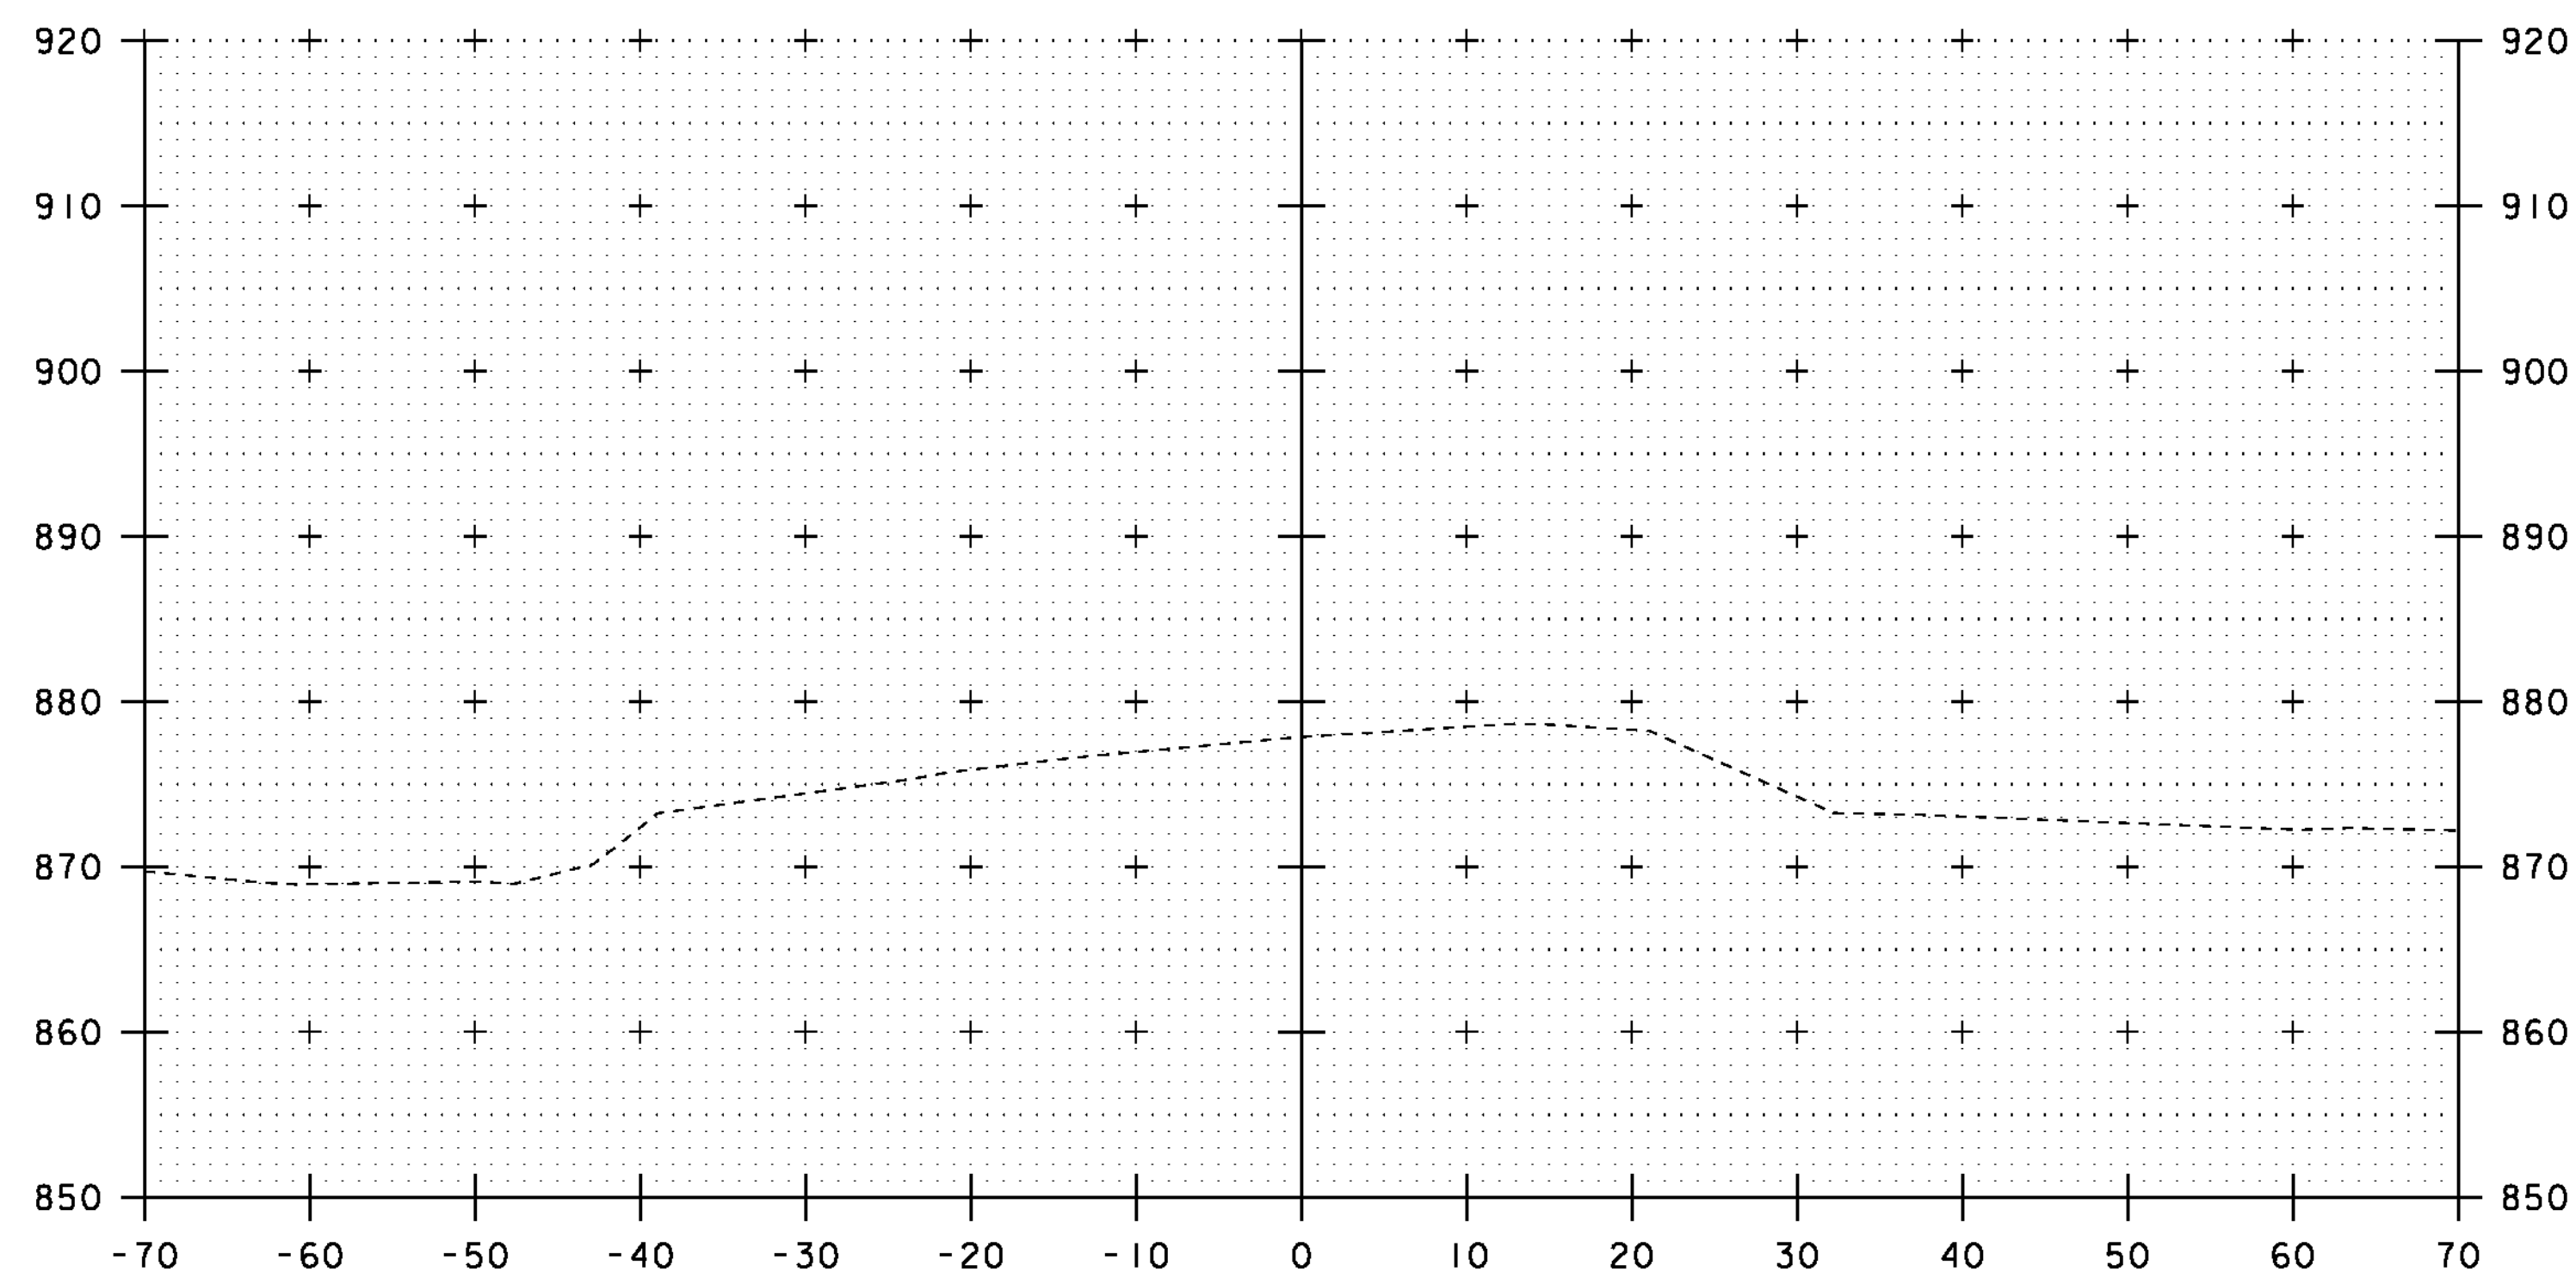

6+75

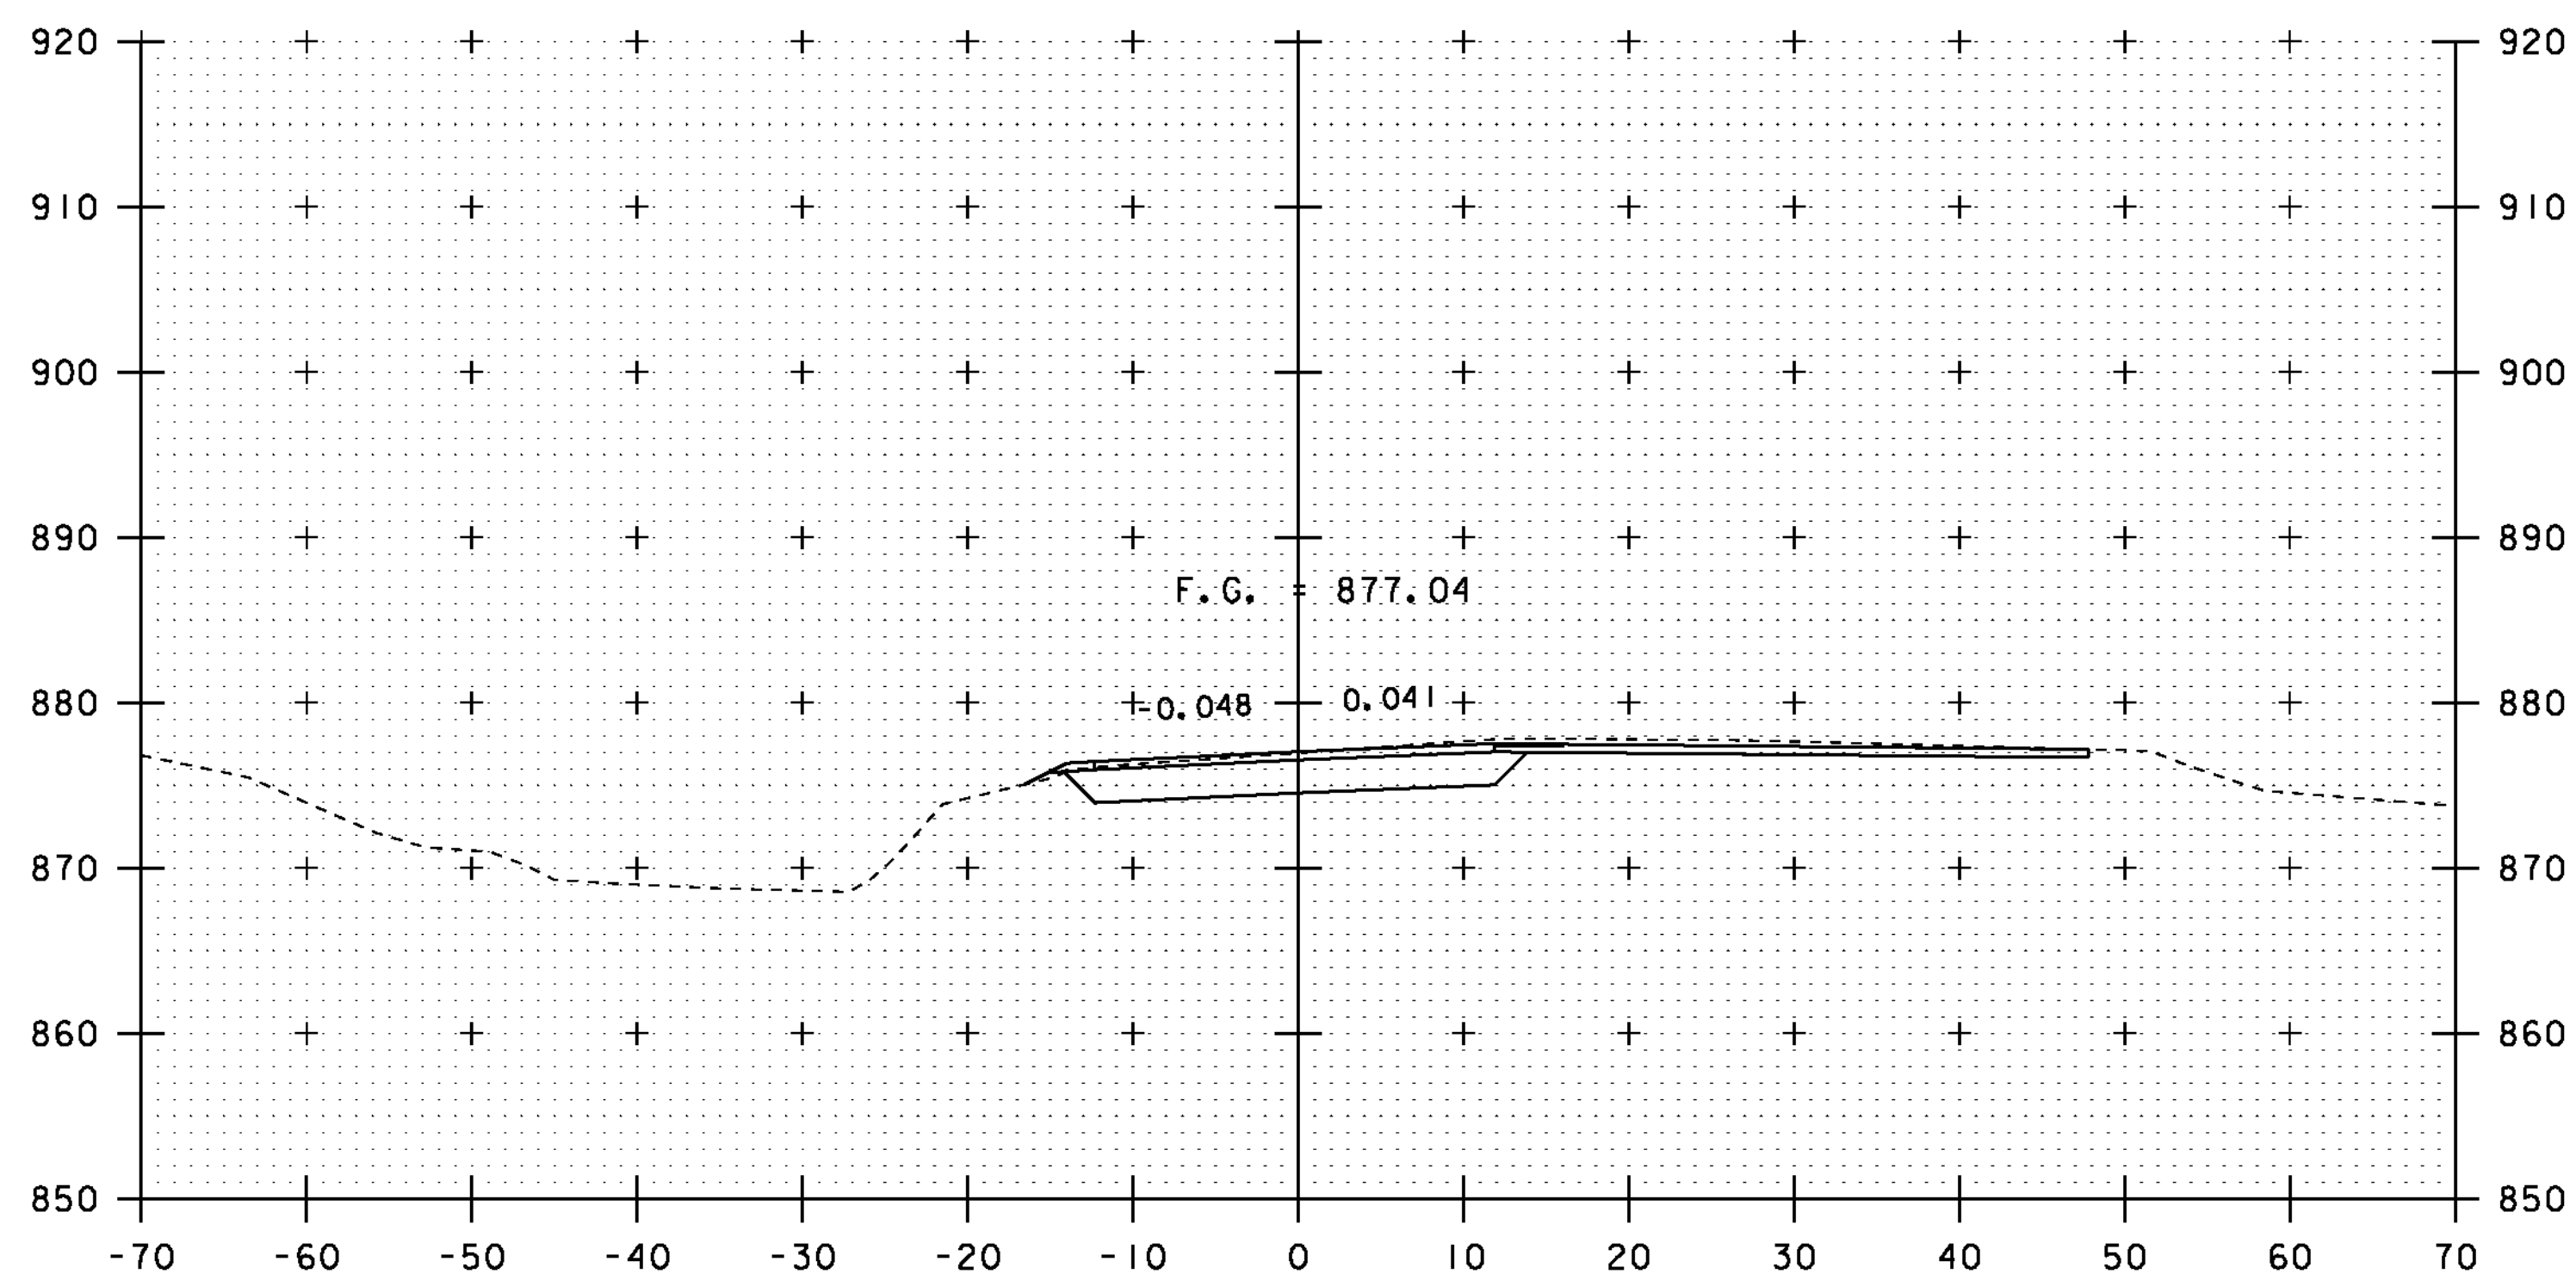

6+00

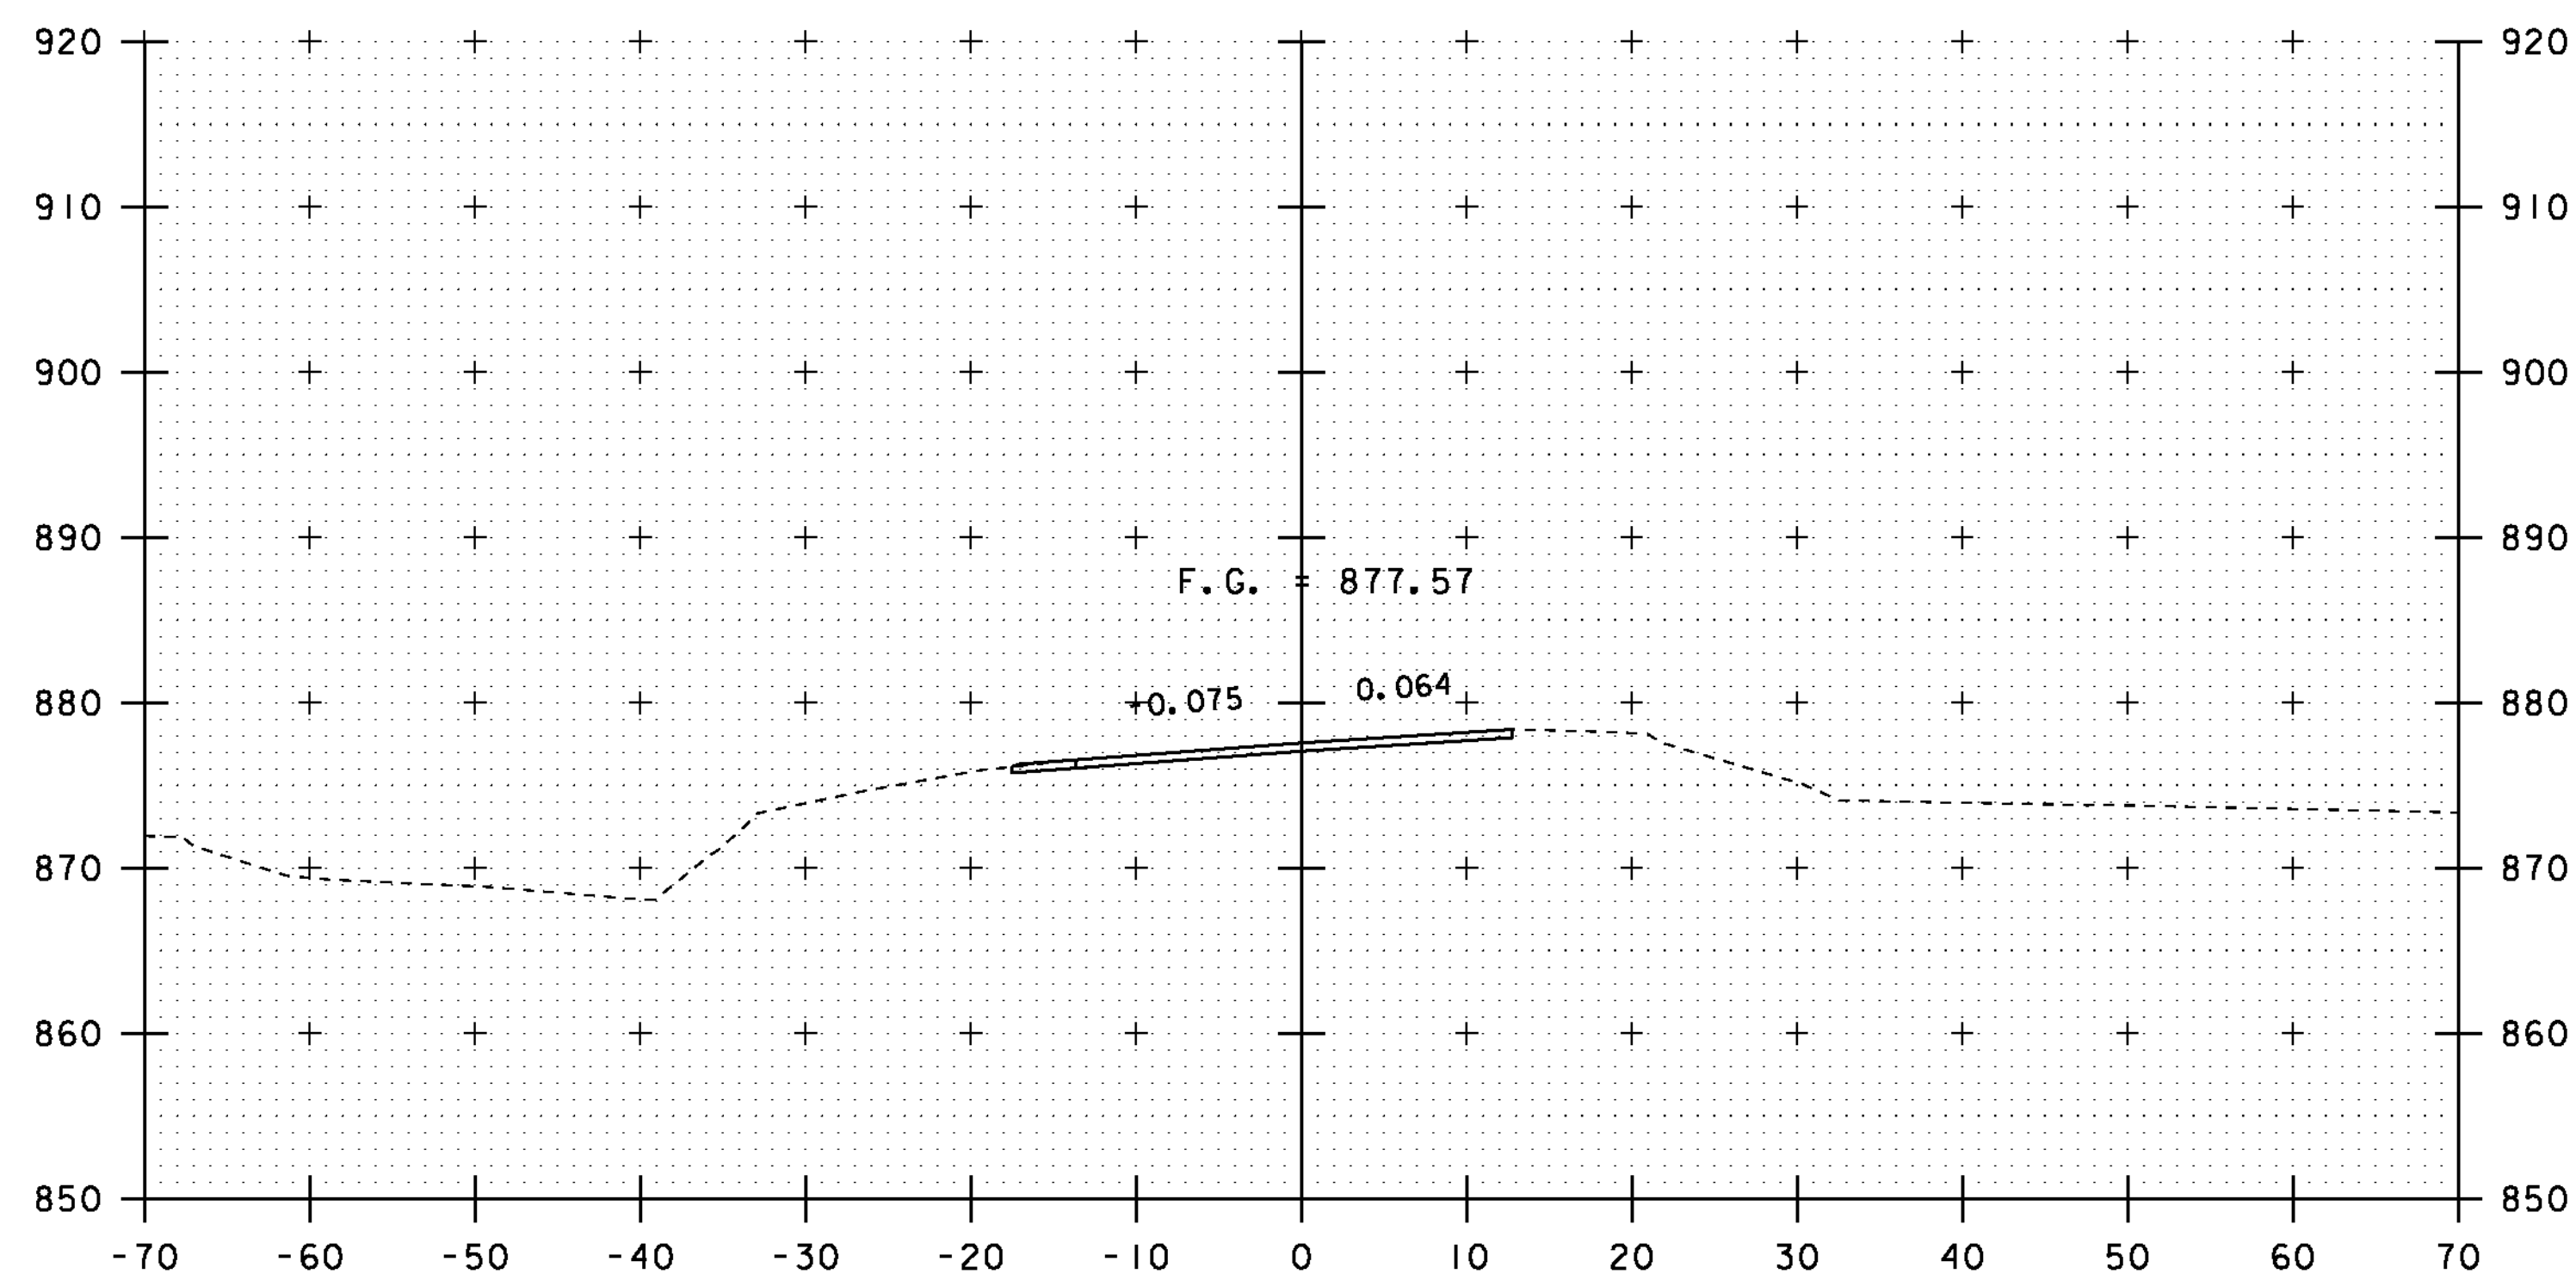

6+50

END PRECAST CONCRETE STRUCTURE (WINGWALL NO. 3)
STA 5+99.30 LT
END PERMANENT STEEL SHEET PILING
STA 6+00.0 LT

END PROJECT
BEGIN APPROACH
STA 6+00.00

END APPROACH
MATCH EXISTING
STA 6+50.00

PROJECT NAME: ROXBURY
PROJECT NUMBER: BHF 0187(8)

FILE NAME: sl0c420xsl.dgn
PROJECT LEADER: C. P. WILLIAMS
DESIGNED BY: G. ROY
VT I2A CROSS SECTIONS (5)

PLOT DATE: 21-SEP-2011
DRAWN BY: G. ROY
CHECKED BY: T. FILLBACH
SHEET 36 OF 54

STA. 6+00 TO STA. 6+75