



PLAN
SCALE 1" = 10'-0"

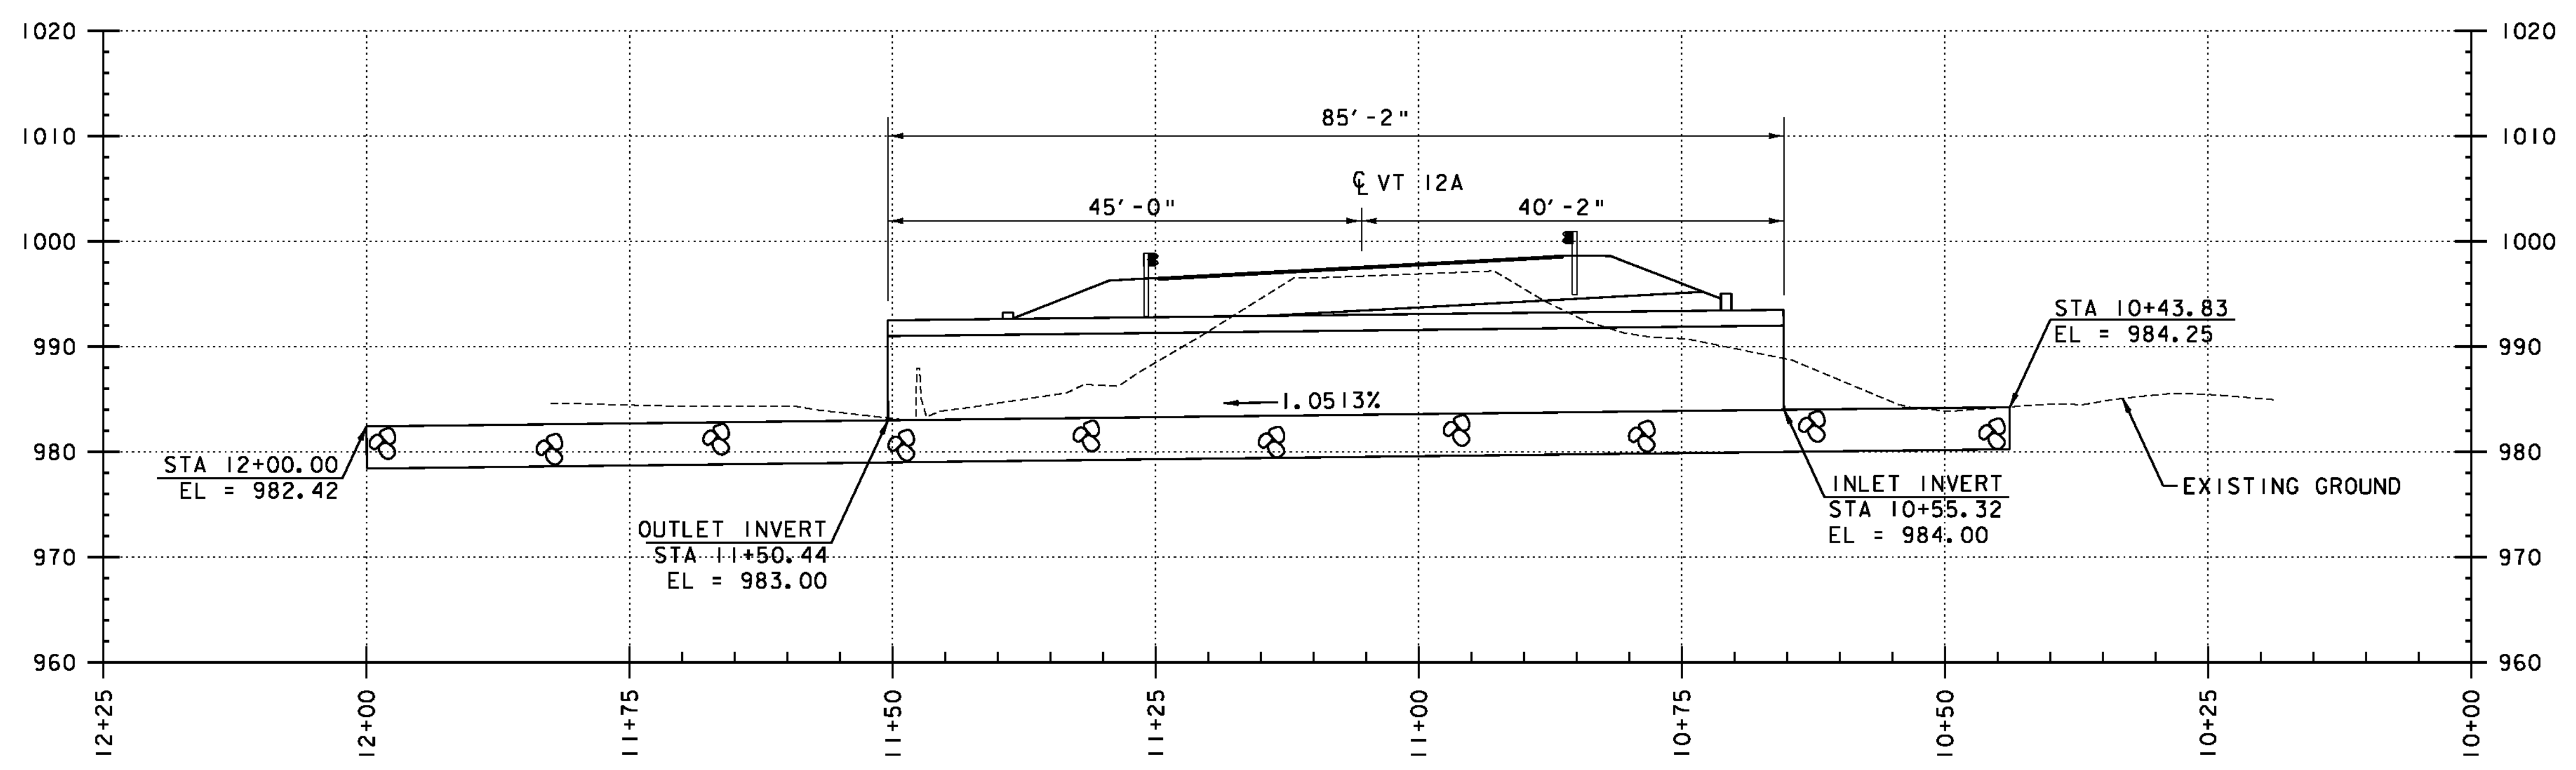

PROFILE ALONG CHANNEL LINE
SCALE 1" = 10'-0"

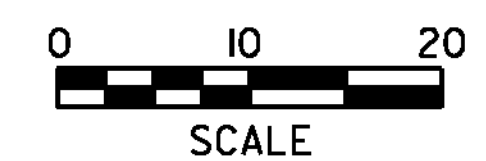

PROJECT NAME:	ROXBURY	FILE NAME:	...plotfiles\Plan-Profile.dgn	PLOT DATE:	9/21/2011
PROJECT NUMBER:	ER 0187(9)	PROJECT LEADER:	G. BOGUE	DRAWN BY:	JTS/ISM
		DESIGNED BY:	M. CHENETTE	CHECKED BY:	G. BOGUE
				SHEET	46 OF 54

PLAN AND PROFILE