


NOTE:
 ELEVATION SHOWN TO THE NEAREST TENTHS ARE
 EXISTING GROUND ALONG PROPOSED CENTERLINE.
 ELEVATIONS SHOWN TO THE NEAREST HUNDREDTHS ARE
 FINISH GRADE ALONG PROPOSED CENTERLINE.

PROFILE ALONG VT 12A

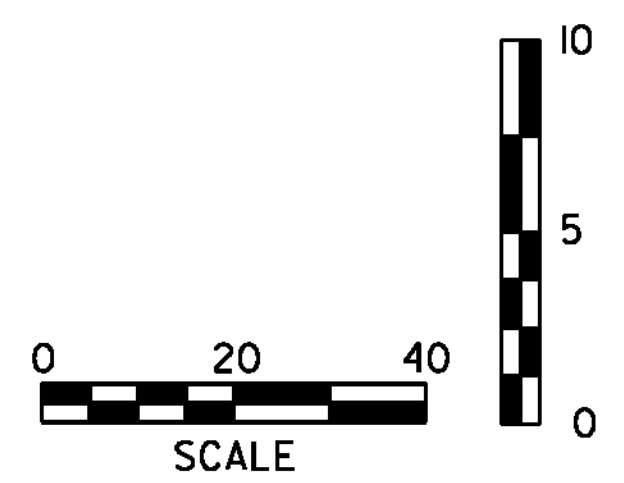

PROJECT NAME:	ROXBURY	PLOT DATE:	9/21/2011
PROJECT NUMBER:	ER 0187(9)	DRAWN BY:	JTS/ISM
FILE NAME:	...drawing\plotfiles\pro.dgn	DESIGNED BY:	M. CHENETTE
PROJECT LEADER:	G. BOGUE	CHECKED BY:	G. BOGUE
PROFILE		SHEET	47 OF 54