


PRECAST CONCRETE STRUCTURE PLAN

SCALE: 1/4" = 1'-0"

WP OF STRUCTURE	NORTHING	EASTING
CHANNEL LINE STA 11+50.44	574107.89	1576390.76
CHANNEL LINE STA 10+65.29	574192.95	1576394.81

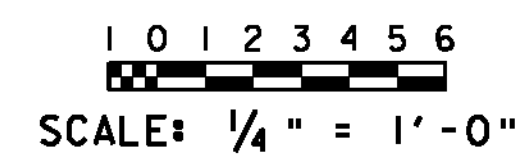

PROJECT NAME: ROXBURY	PLOT DATE: 9/21/2011
PROJECT NUMBER: ER 0187(9)	DRAWN BY: J. SOTER
FILE NAME: ...drawing\struct_plan_dets.dgn	CHECKED BY: G. BOGUE
PROJECT LEADER: G. BOGUE	SHEET 48 OF 54
DESIGNED BY: M. CHENETTE	
PRECAST CONCRETE STRUCTURE PLAN	