
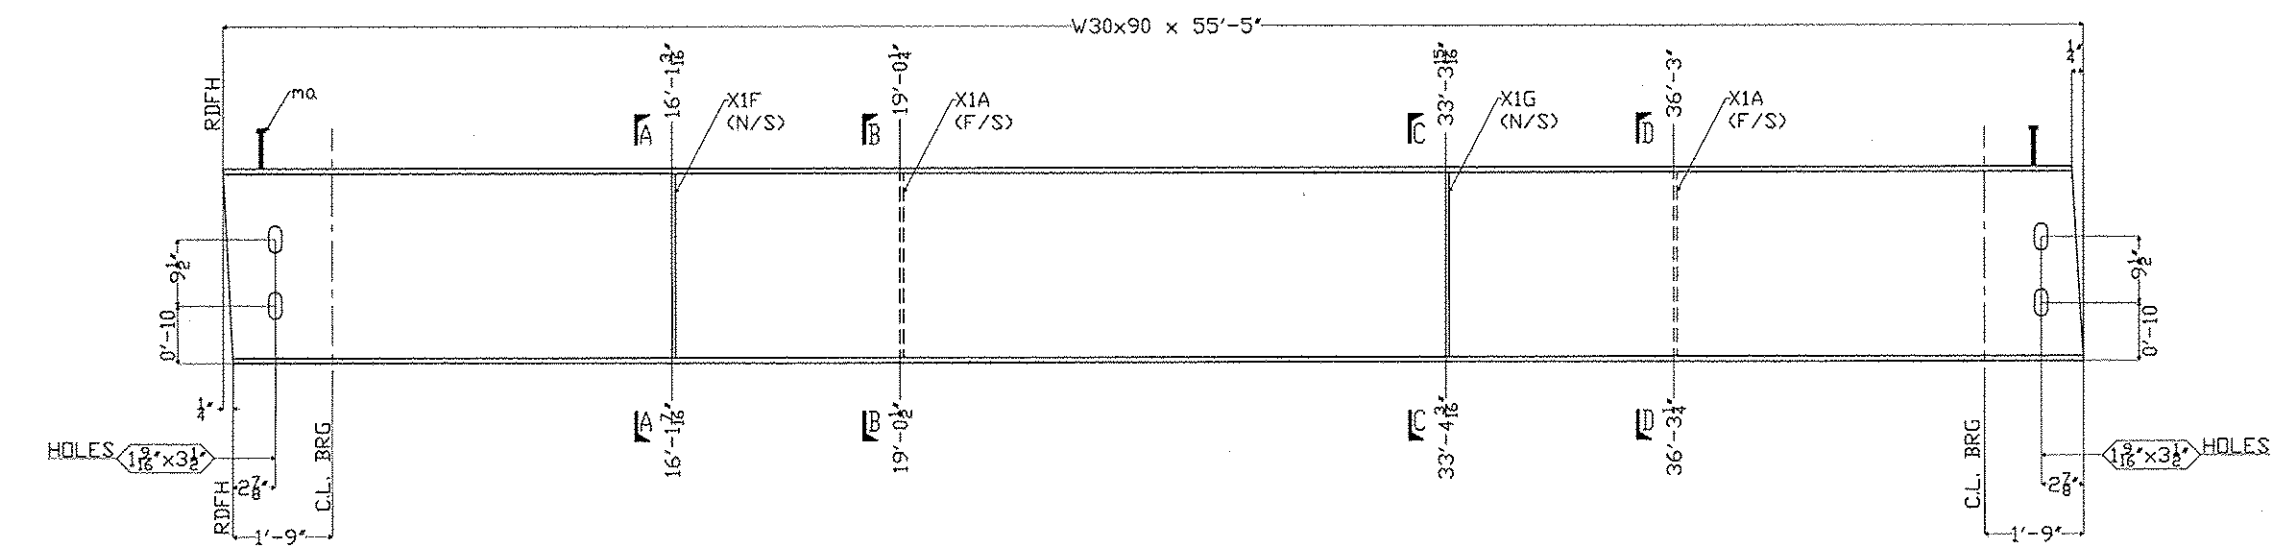



| SHIPPER | | BILL OF MATERIAL | | | | | | | |
|---------|------|------------------|------|----------|-----------|-----|---------|------|--------|
| NO. | MARK | NO. | MARK | SIZE | LENGTH | QTY | REMARKS | ITEM | WEIGHT |
| 1 | 3B1 | | | W30x90 | 55'-5" | | CVN | | |
| | | 2 | XIA | PL 1/2x5 | 2'-4 1/2" | | CVN | | |
| | | 1 | XIF | PL 1/2x5 | 2'-4 1/2" | | CVN | | |
| | | 1 | XIG | PL 1/2x5 | 2'-4 1/2" | | CVN | | |
| | | 94 | no | 7/8\"/> | | | | | |

TYP. DIAPHRAGM STIFFENER WELD DETAIL

* NO WELD FOR 3/8\"/>

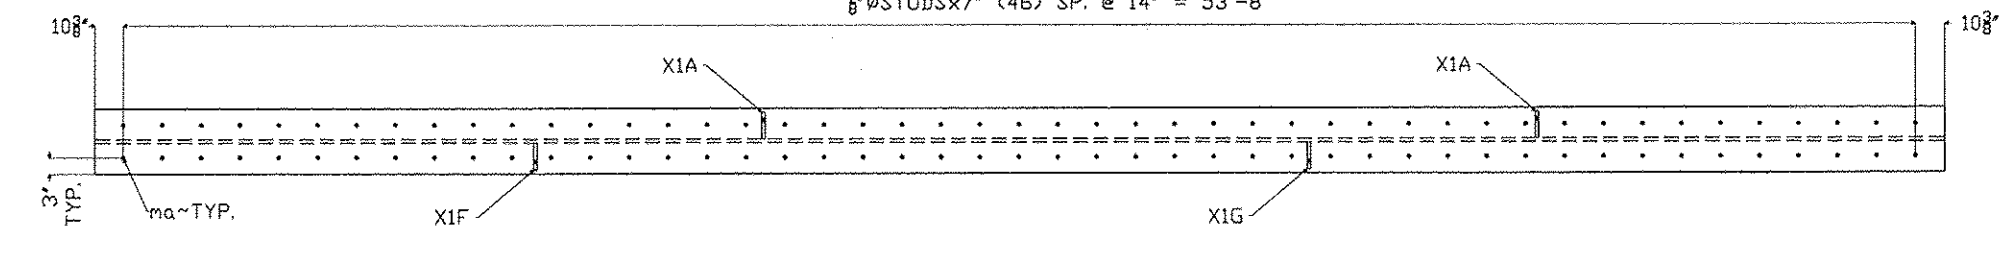

RECEIVED
 OK'D BY _____ OK'D BY RSY
 OCT 17 2011
 RESUBMIT _____ APPROVED ✓
 BY _____ DATE 10/18/2011

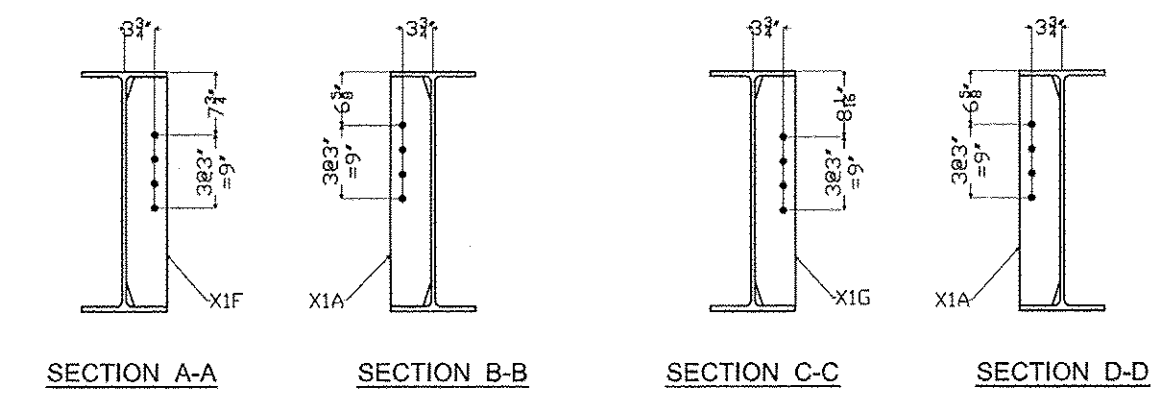

SHOP NOTES
 HOLES: 15/16\"/>

PRECISE STRUCTURAL PRODUCTS
 3 PARK LANE
 GEORGETOWN, MA 01833
 PHONE: 978-851-1100
 OWNER: VT AGENCY OF TRANSPORTATION
 CONTRACTOR: LUCK BROTHERS INC
 DRAWN BY: [REDACTED] REV. [REDACTED] SHEET [REDACTED] CONTRACT NO. [REDACTED] SHEET NO. [REDACTED]