



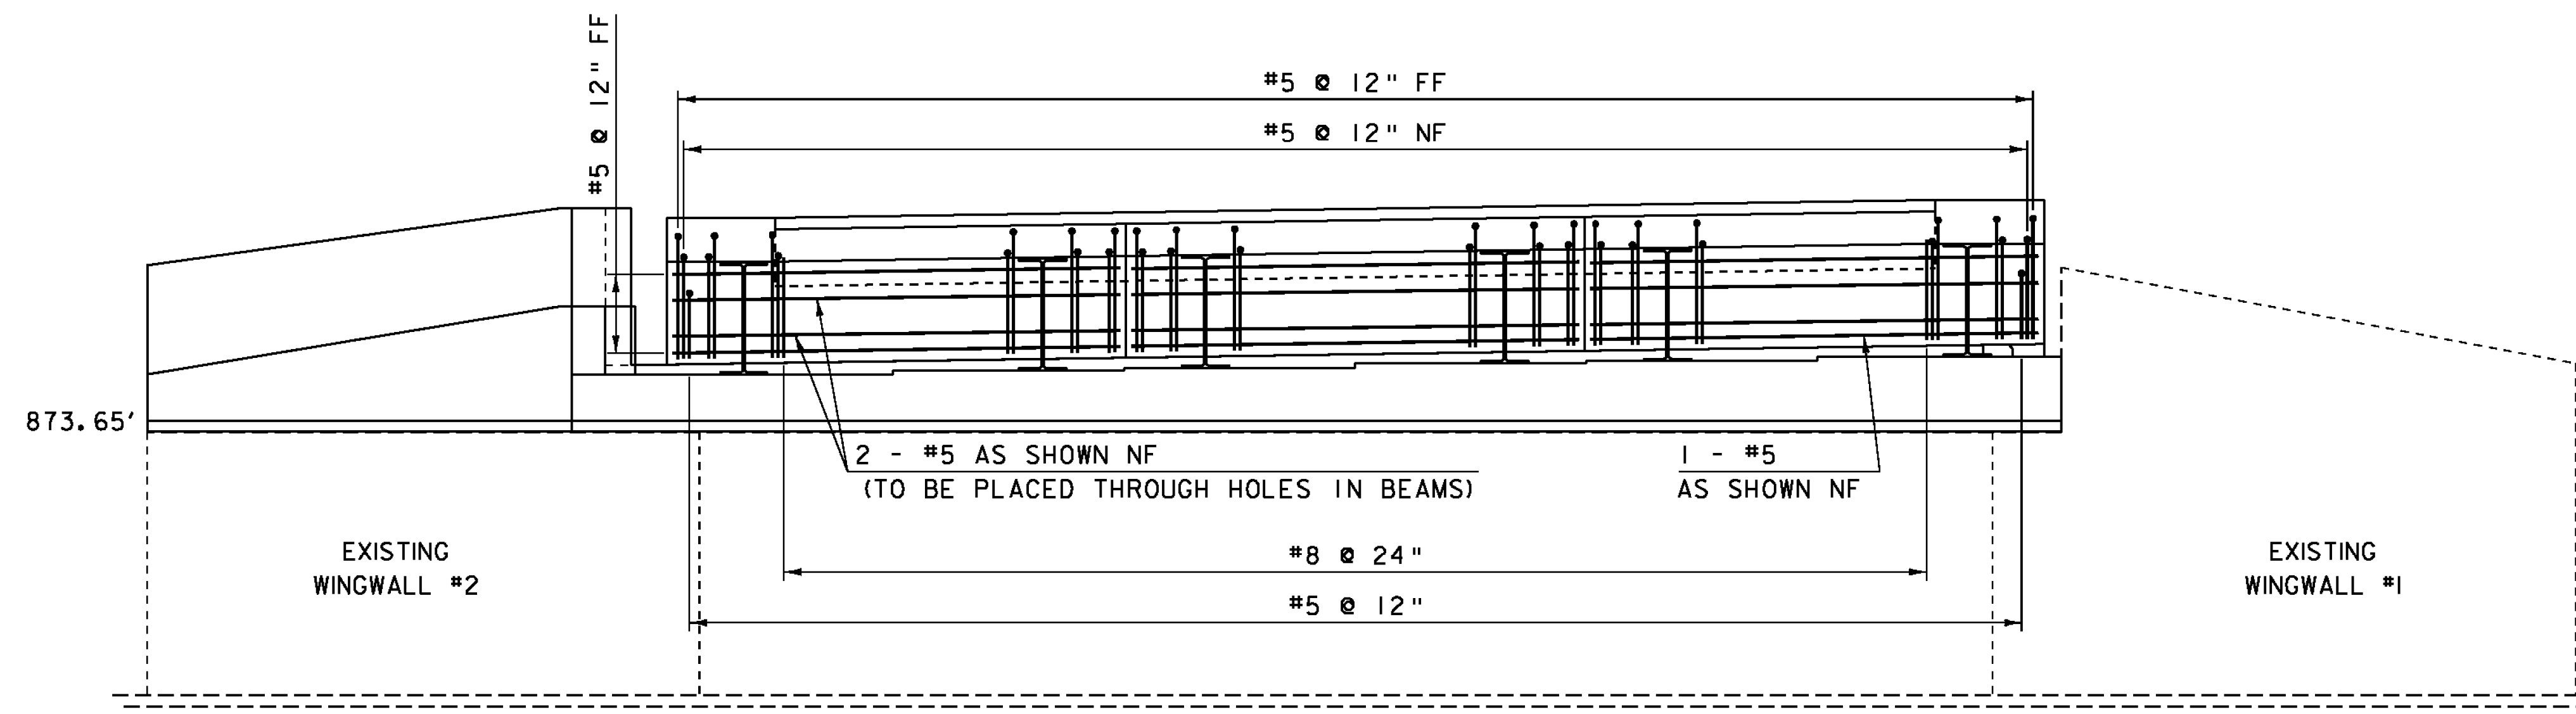


CURTAINWALL TYPICAL SECTION

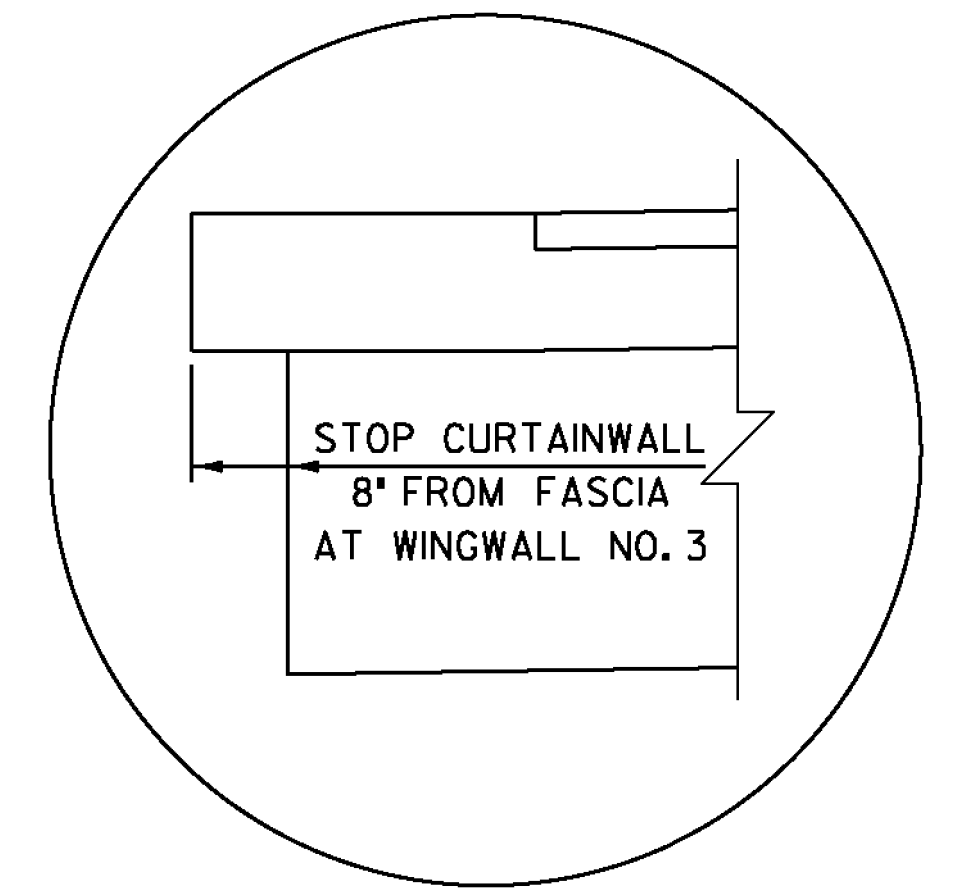

UNIT NO.1 @ ABUTMENT NO.2

NOTE:

NF = NEAR FACE
 FF = FAR FACE
 EF = EACH FACE
 ▲ = CUT TO FIT IN FIELD
 3" CLEAR, UNLESS OTHERWISE SPECIFIED ON THE PLANS.
 2'-2" BAR LAP UNLESS OTHERWISE SPECIFIED ON THE PLANS.

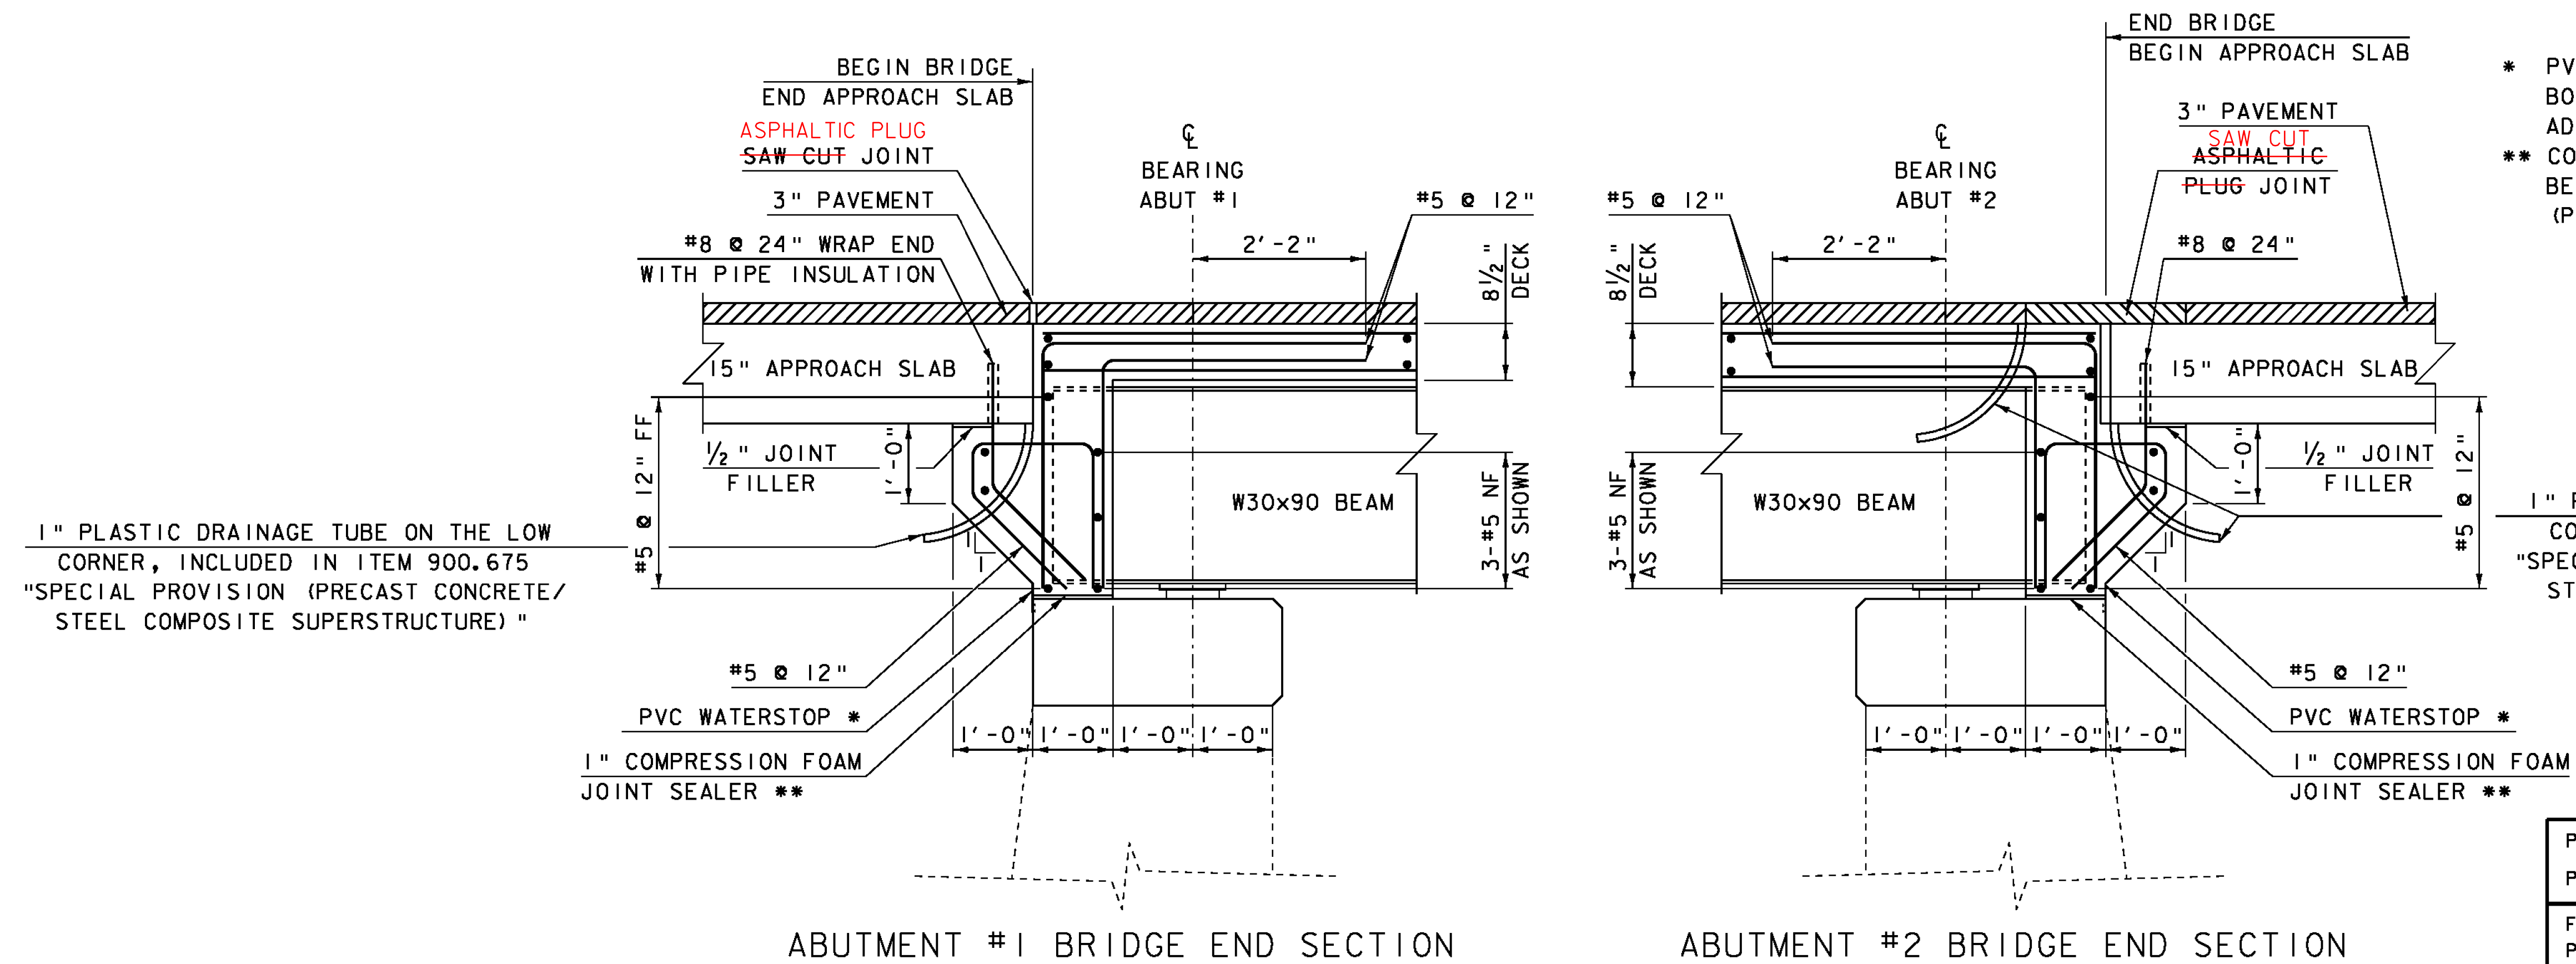

- * PVC WATERSTOP SHALL HAVE TOP LEGS CLIPPED. BOND TO END OF PRESTRESSED UNITS WITH APPROVED ADHESIVE. WATERSTOP TO EXTEND ACROSS ALL UNITS.
- ** COST OF 1" COMPRESSION FOAM JOINT SEALER SHALL BE INCLUDED IN ITEM 900.675 "SPECIAL PROVISION (PRECAST CONCRETE/STEEL COMPOSITE SUPERSTRUCTURE) "

1" PLASTIC DRAINAGE TUBE ON THE LOW CORNER, INCLUDED IN ITEM 900.675 "SPECIAL PROVISION (PRECAST CONCRETE/STEEL COMPOSITE SUPERSTRUCTURE) "

PROJECT NAME: ROXBURY
 PROJECT NUMBER: BHF 0187(8)

FILE NAME: sl0c420sup.dgn	PLOT DATE: 21-SEP-2011
PROJECT LEADER: C.P.WILLIAMS	DRAWN BY: D.D.BEARD
DESIGNED BY: E.R.Charbonneau	CHECKED BY: E.R.Charbonneau
CURTAINWALL DETAILS	SHEET 20 OF 54