
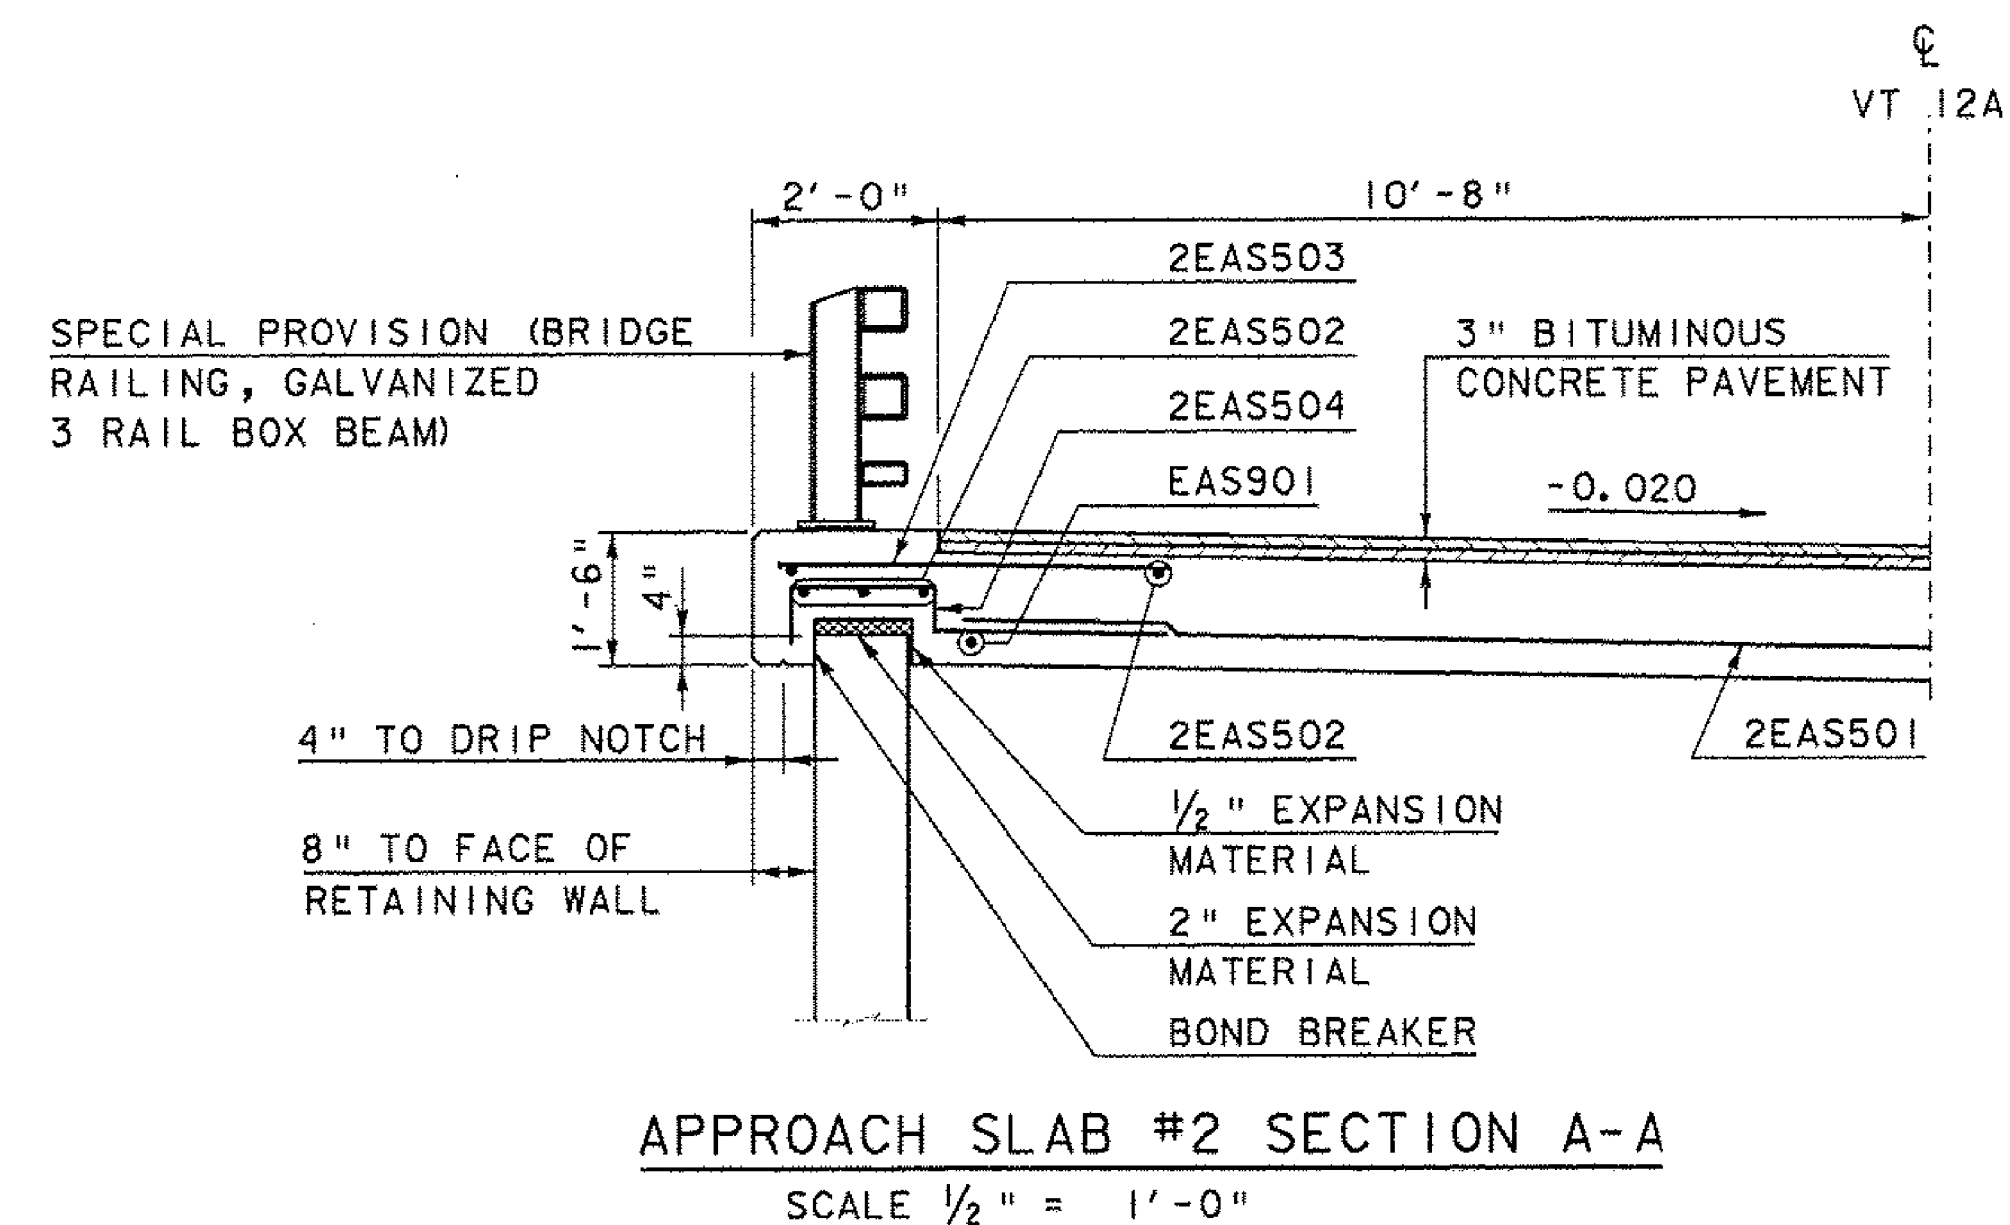
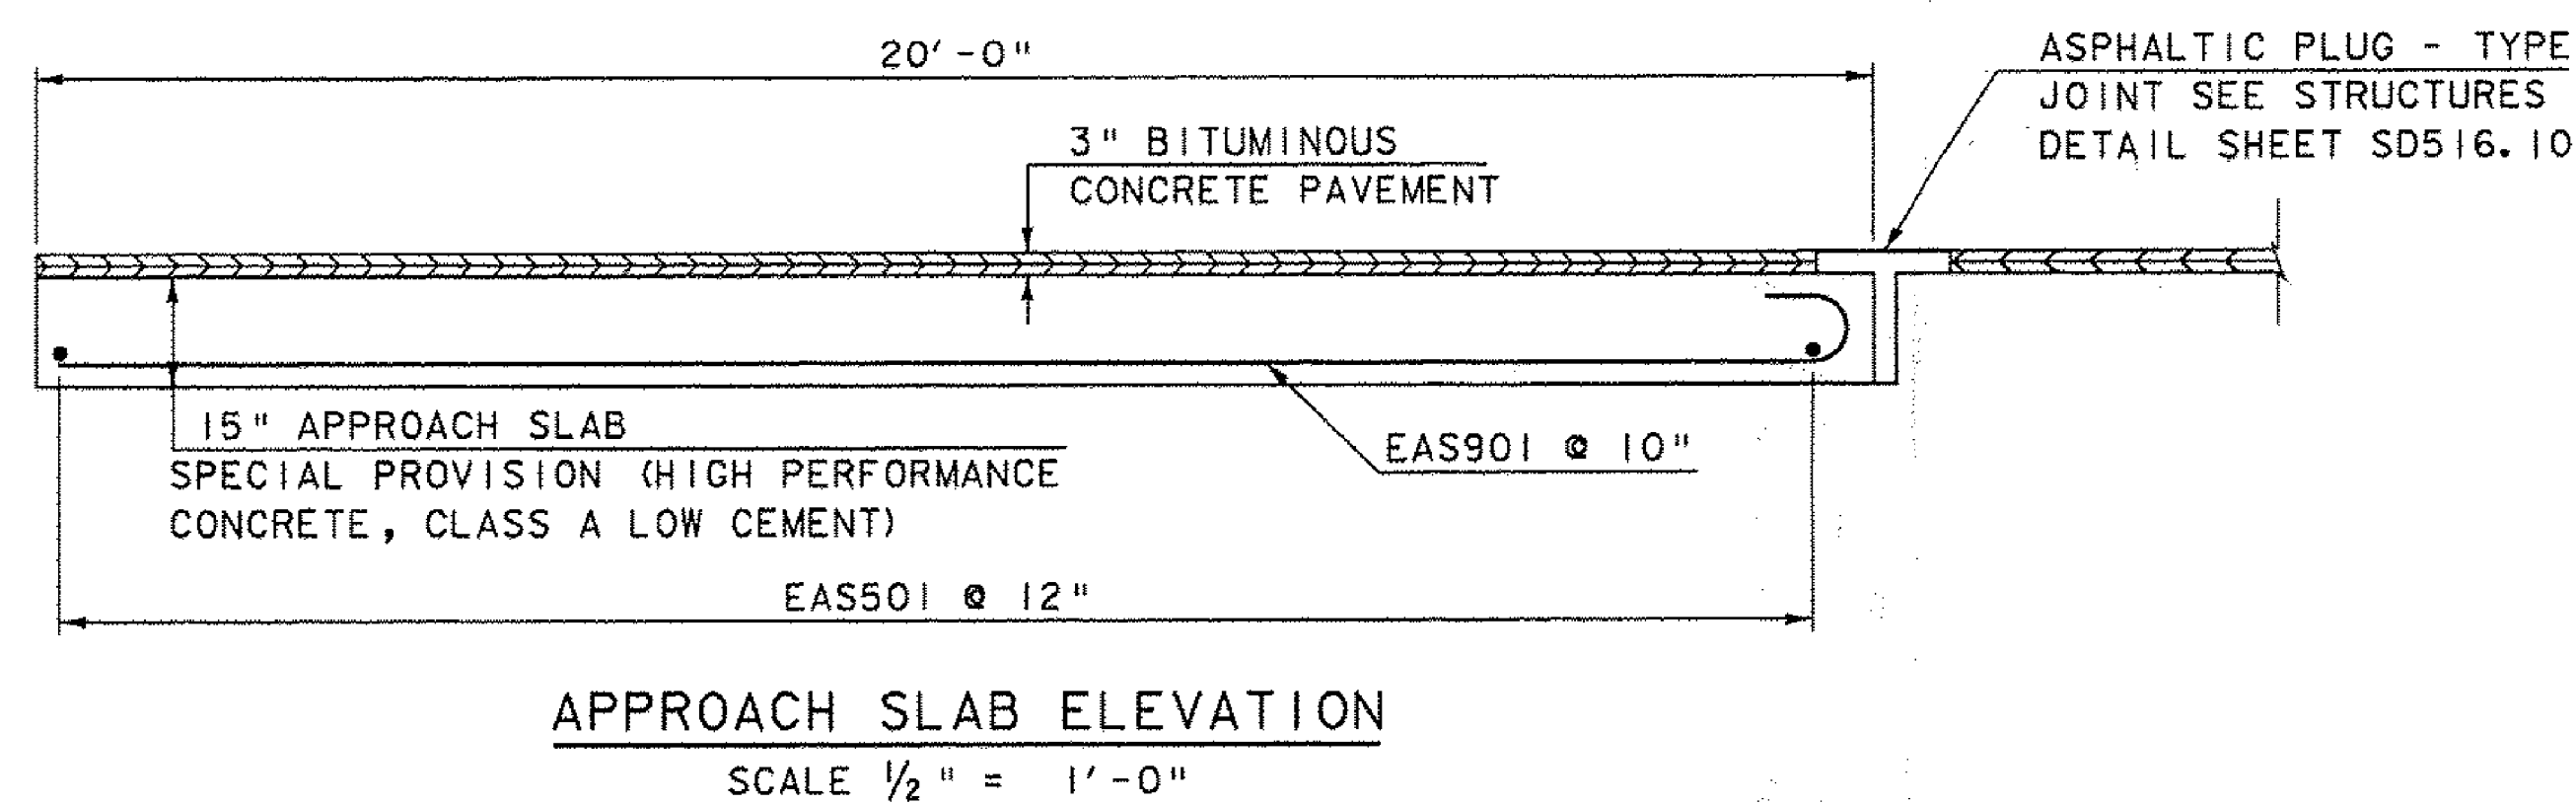
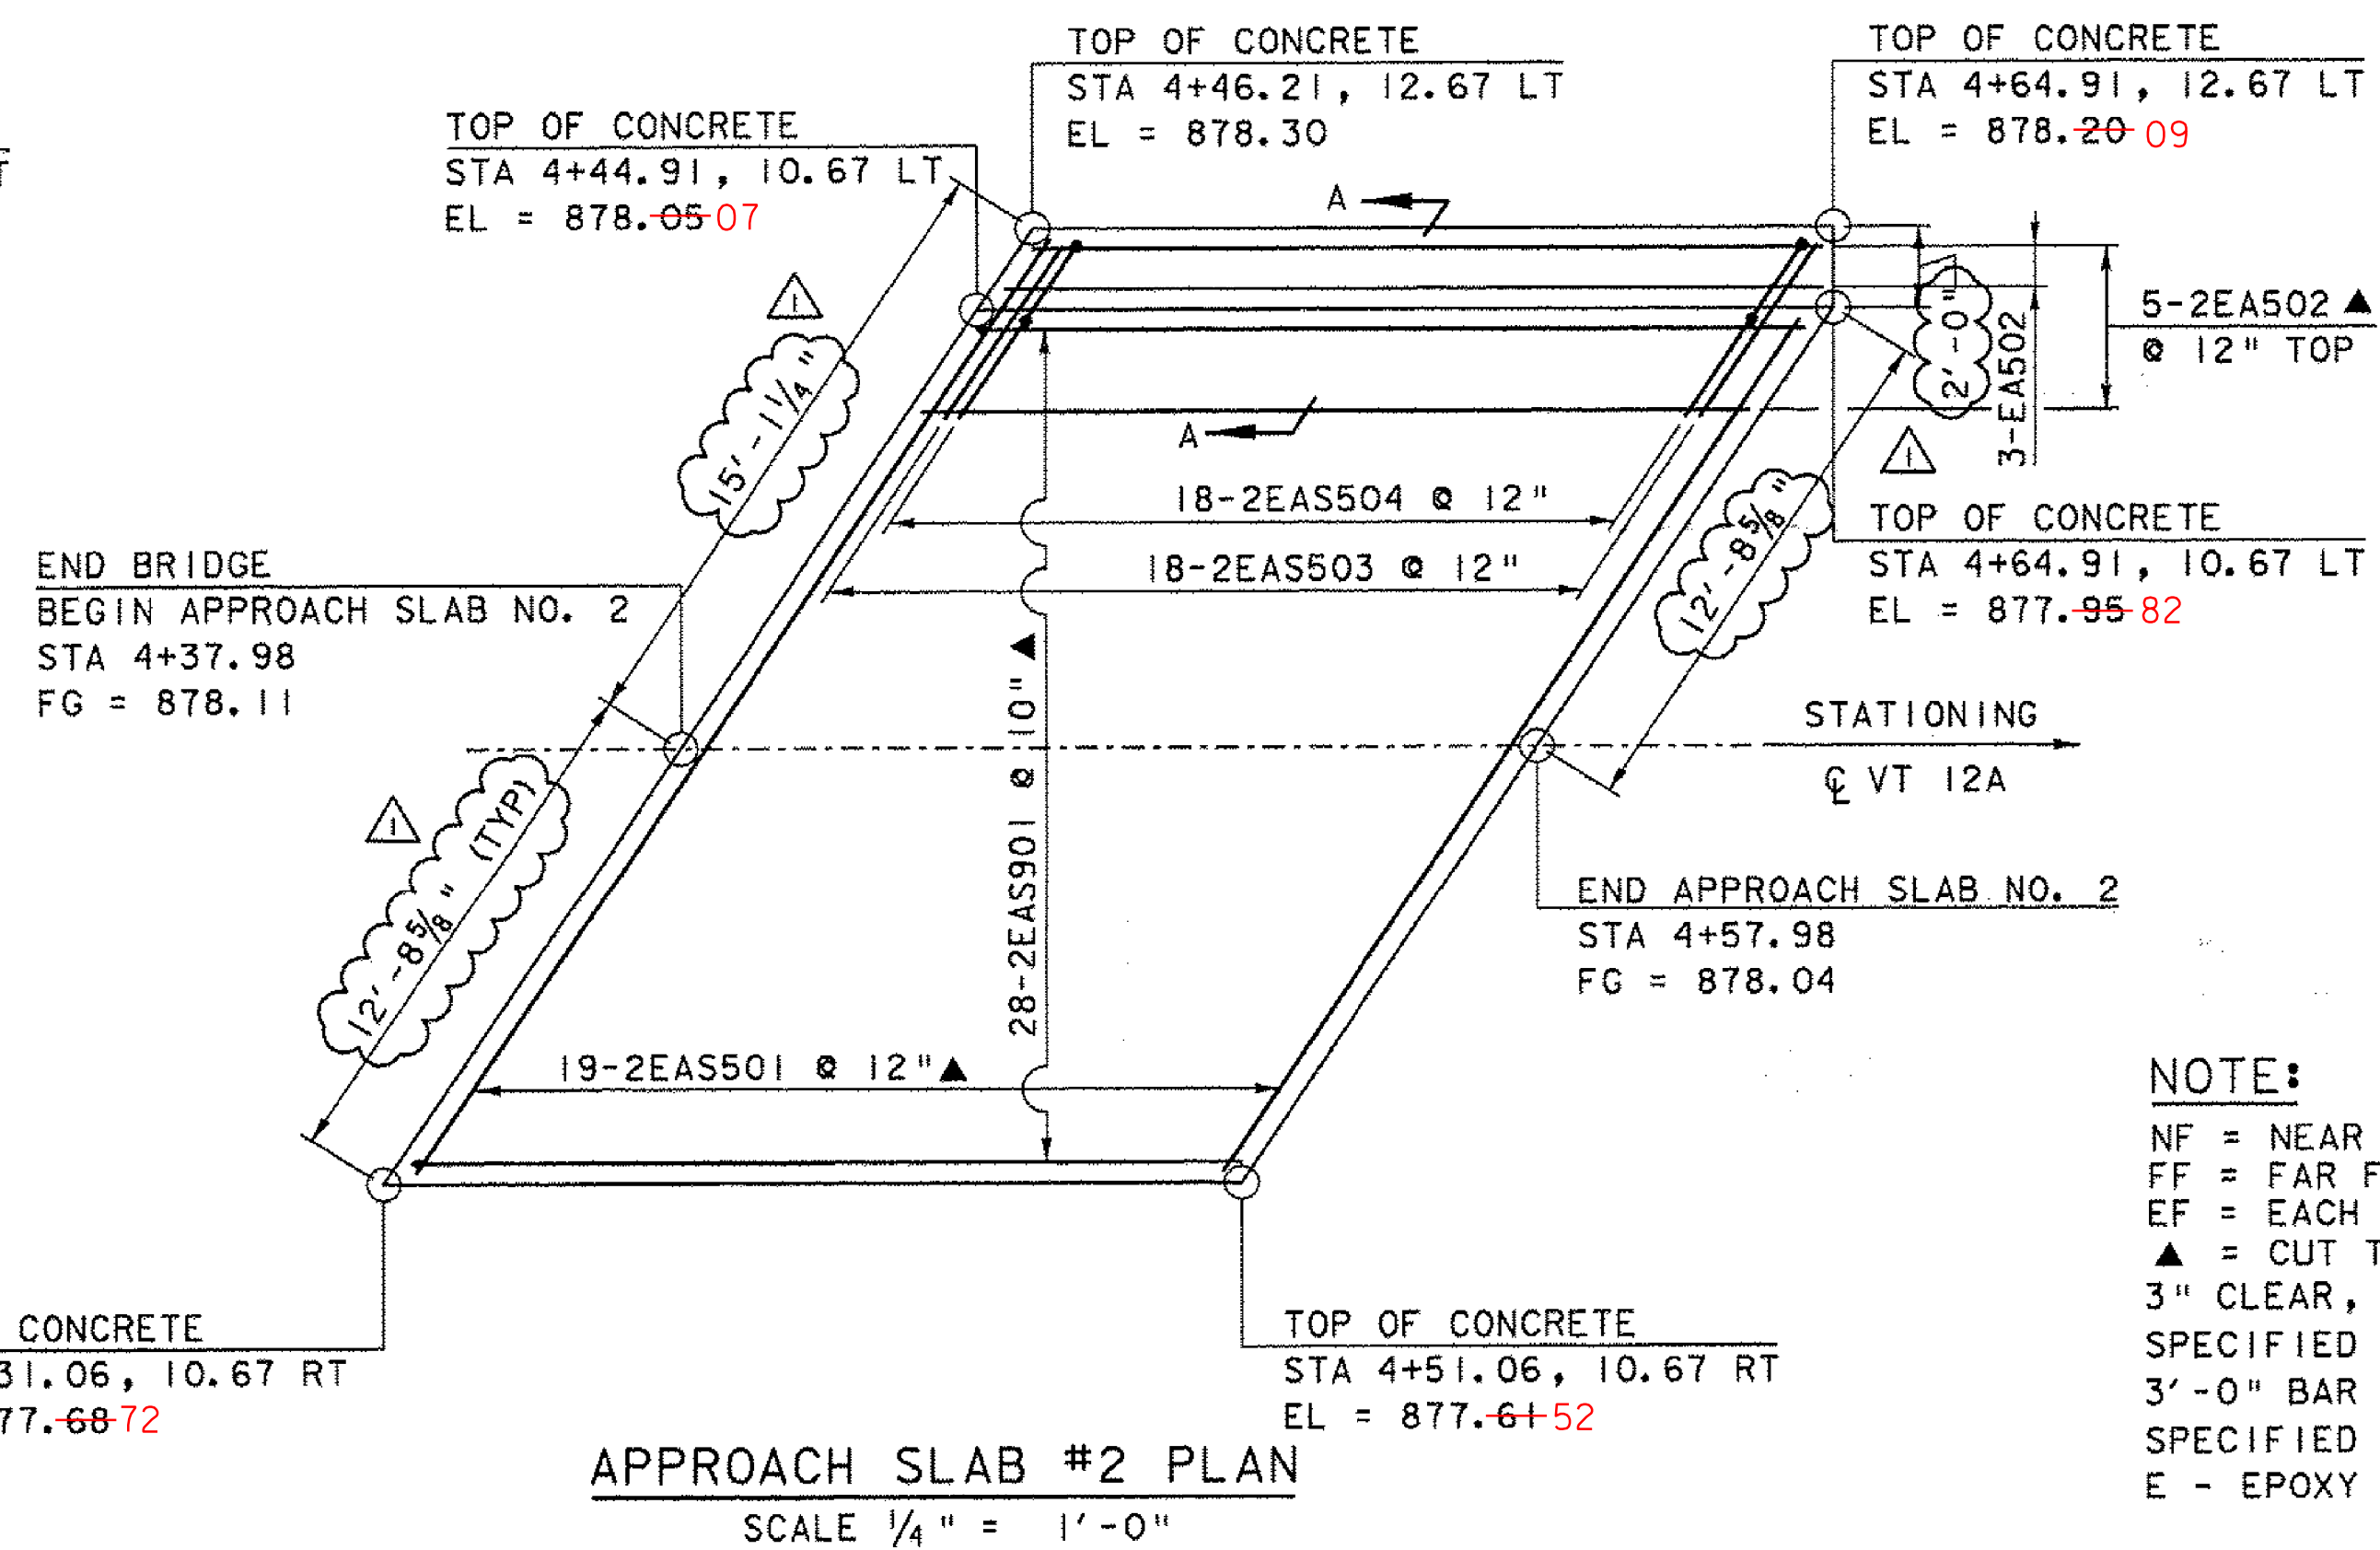


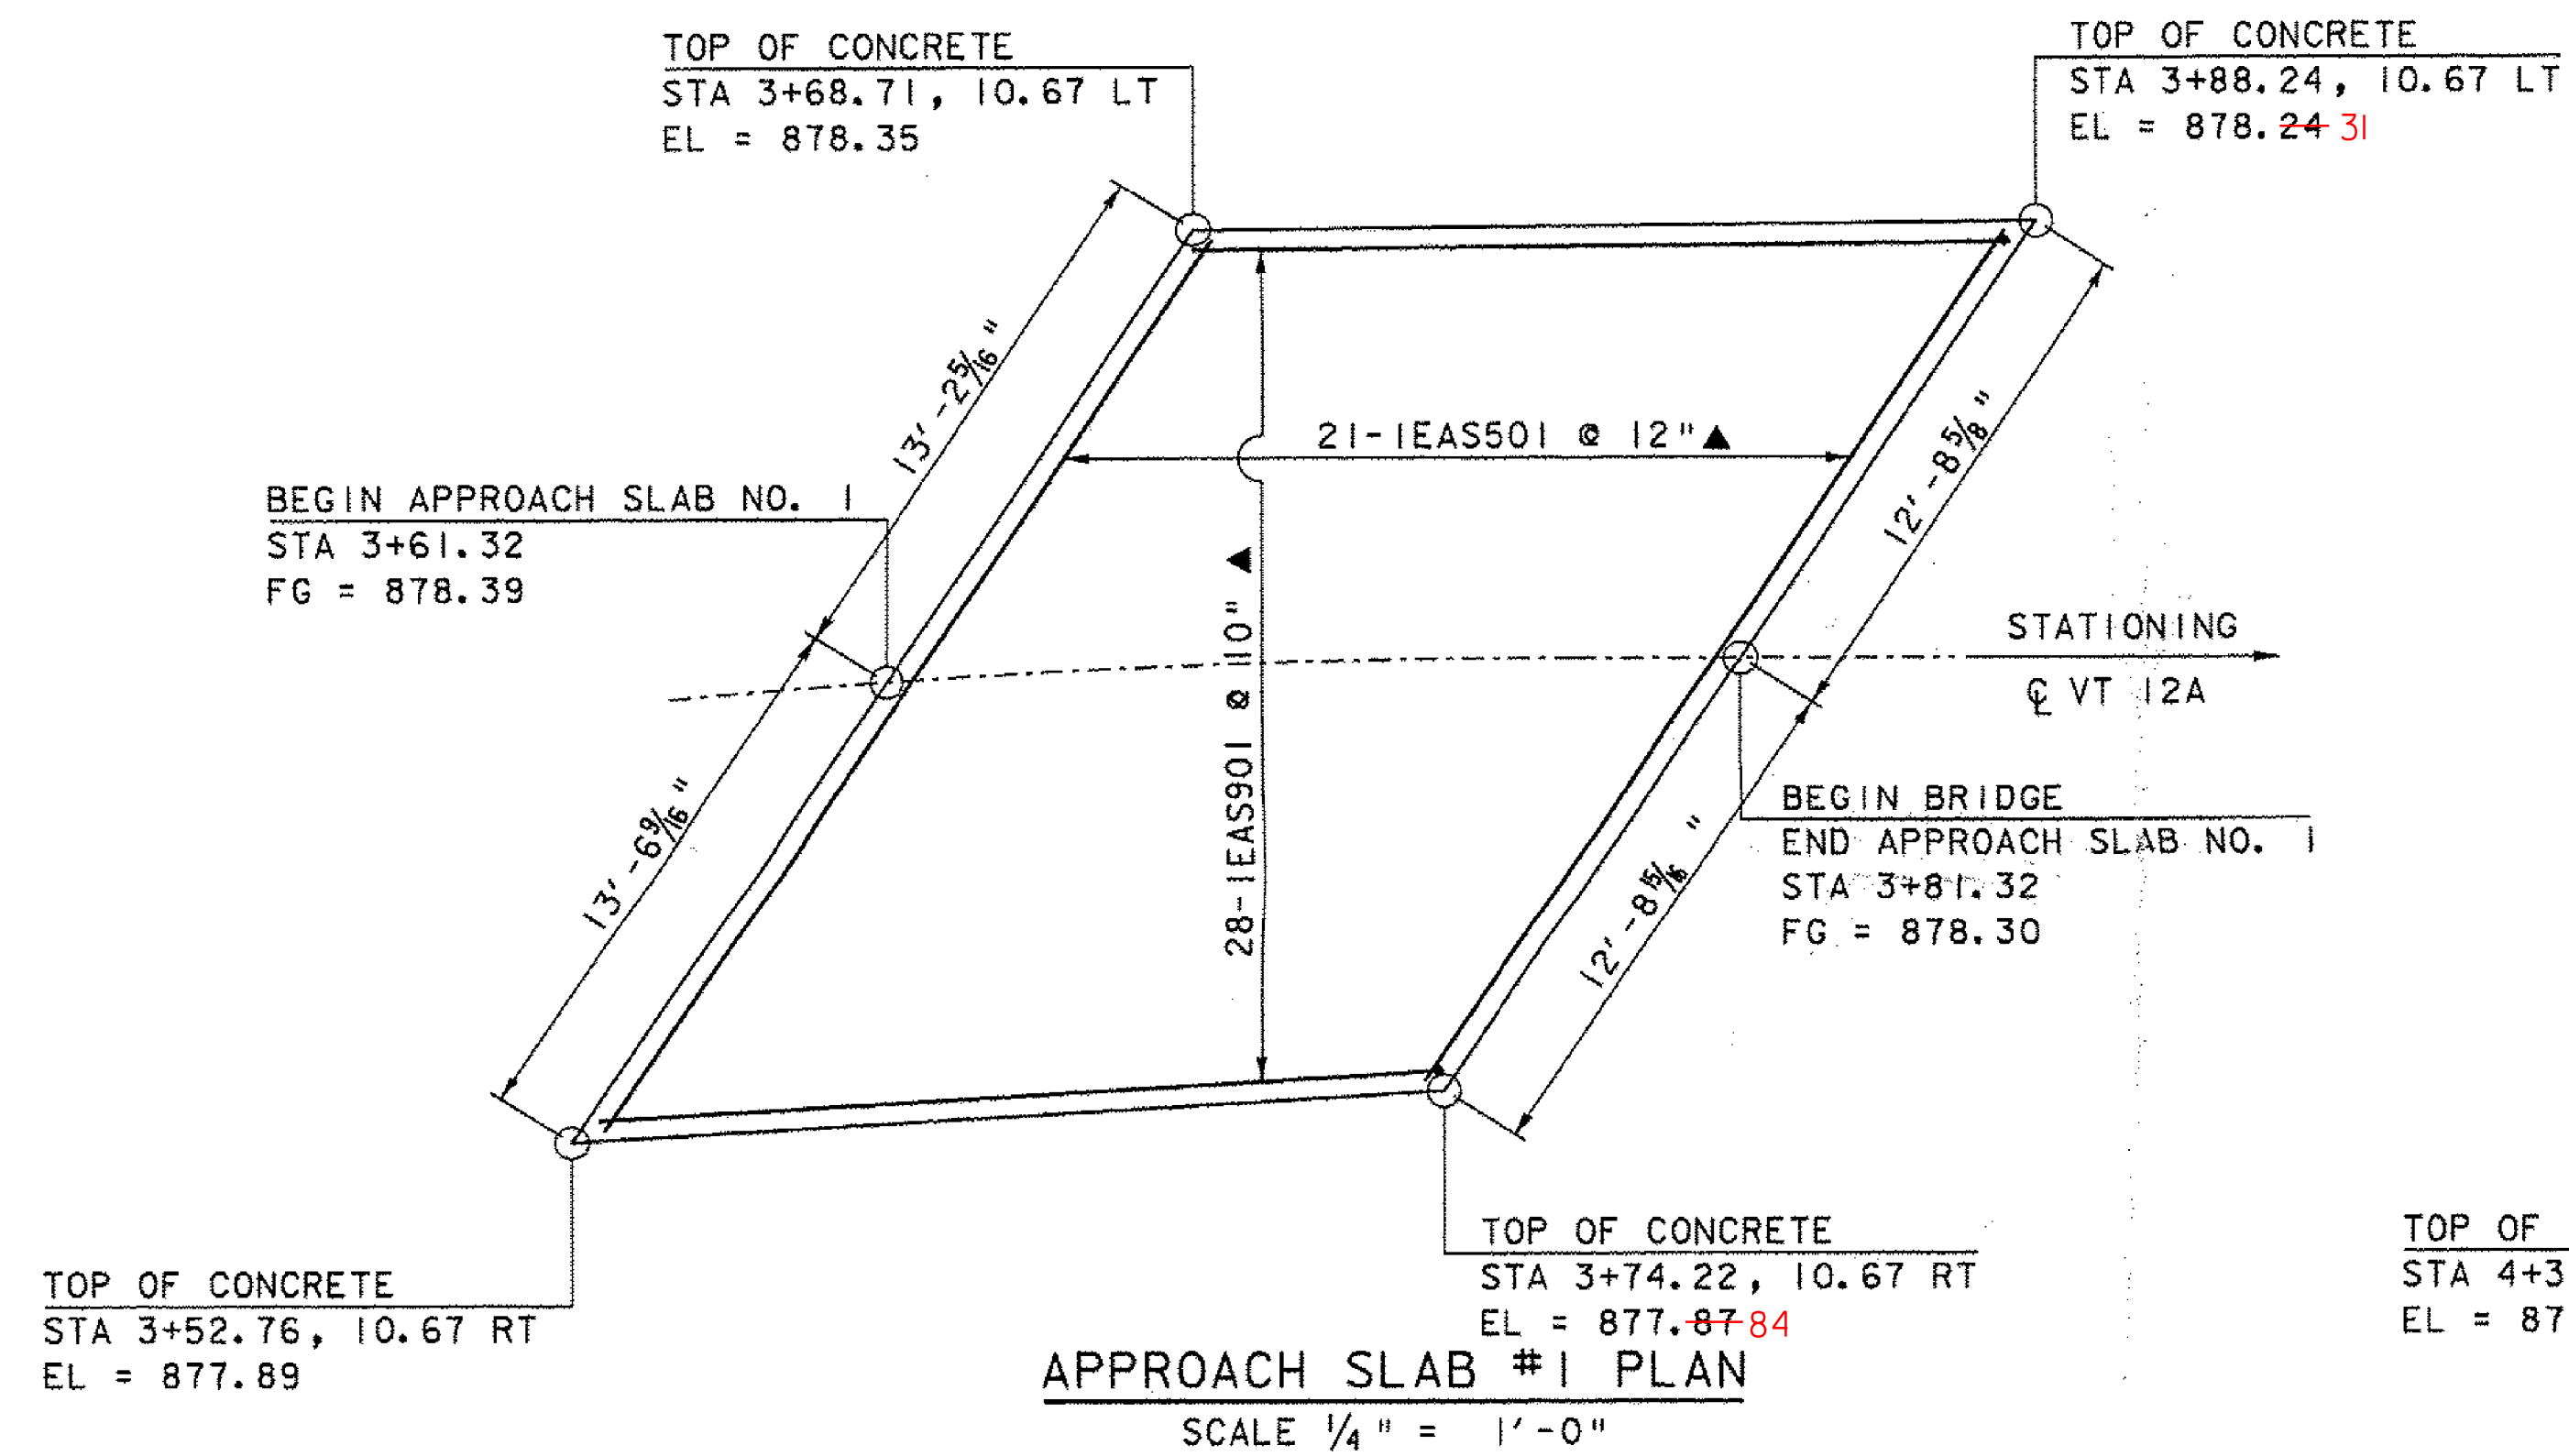

PROJECT NAME: ROXBURY
PROJECT NUMBER: BHF 0187(8)

FILE NAME: sl0c420slab>dgn
PROJECT LEADER: C. WILLIAMS
DESIGNED BY: R. YOUNG
APPROACH SLAB DETAILS

PLOT DATE: 07-NOV-2011
DRAWN BY: J. SALVATORI
CHECKED BY: E. CHARBONNEAU
SHEET 17 OF 38 54

REVISION	DATE	DESCRIPTION	BY
1	11-7-2011	DIMENSION APPROACH SLAB WIDTH	MCL