
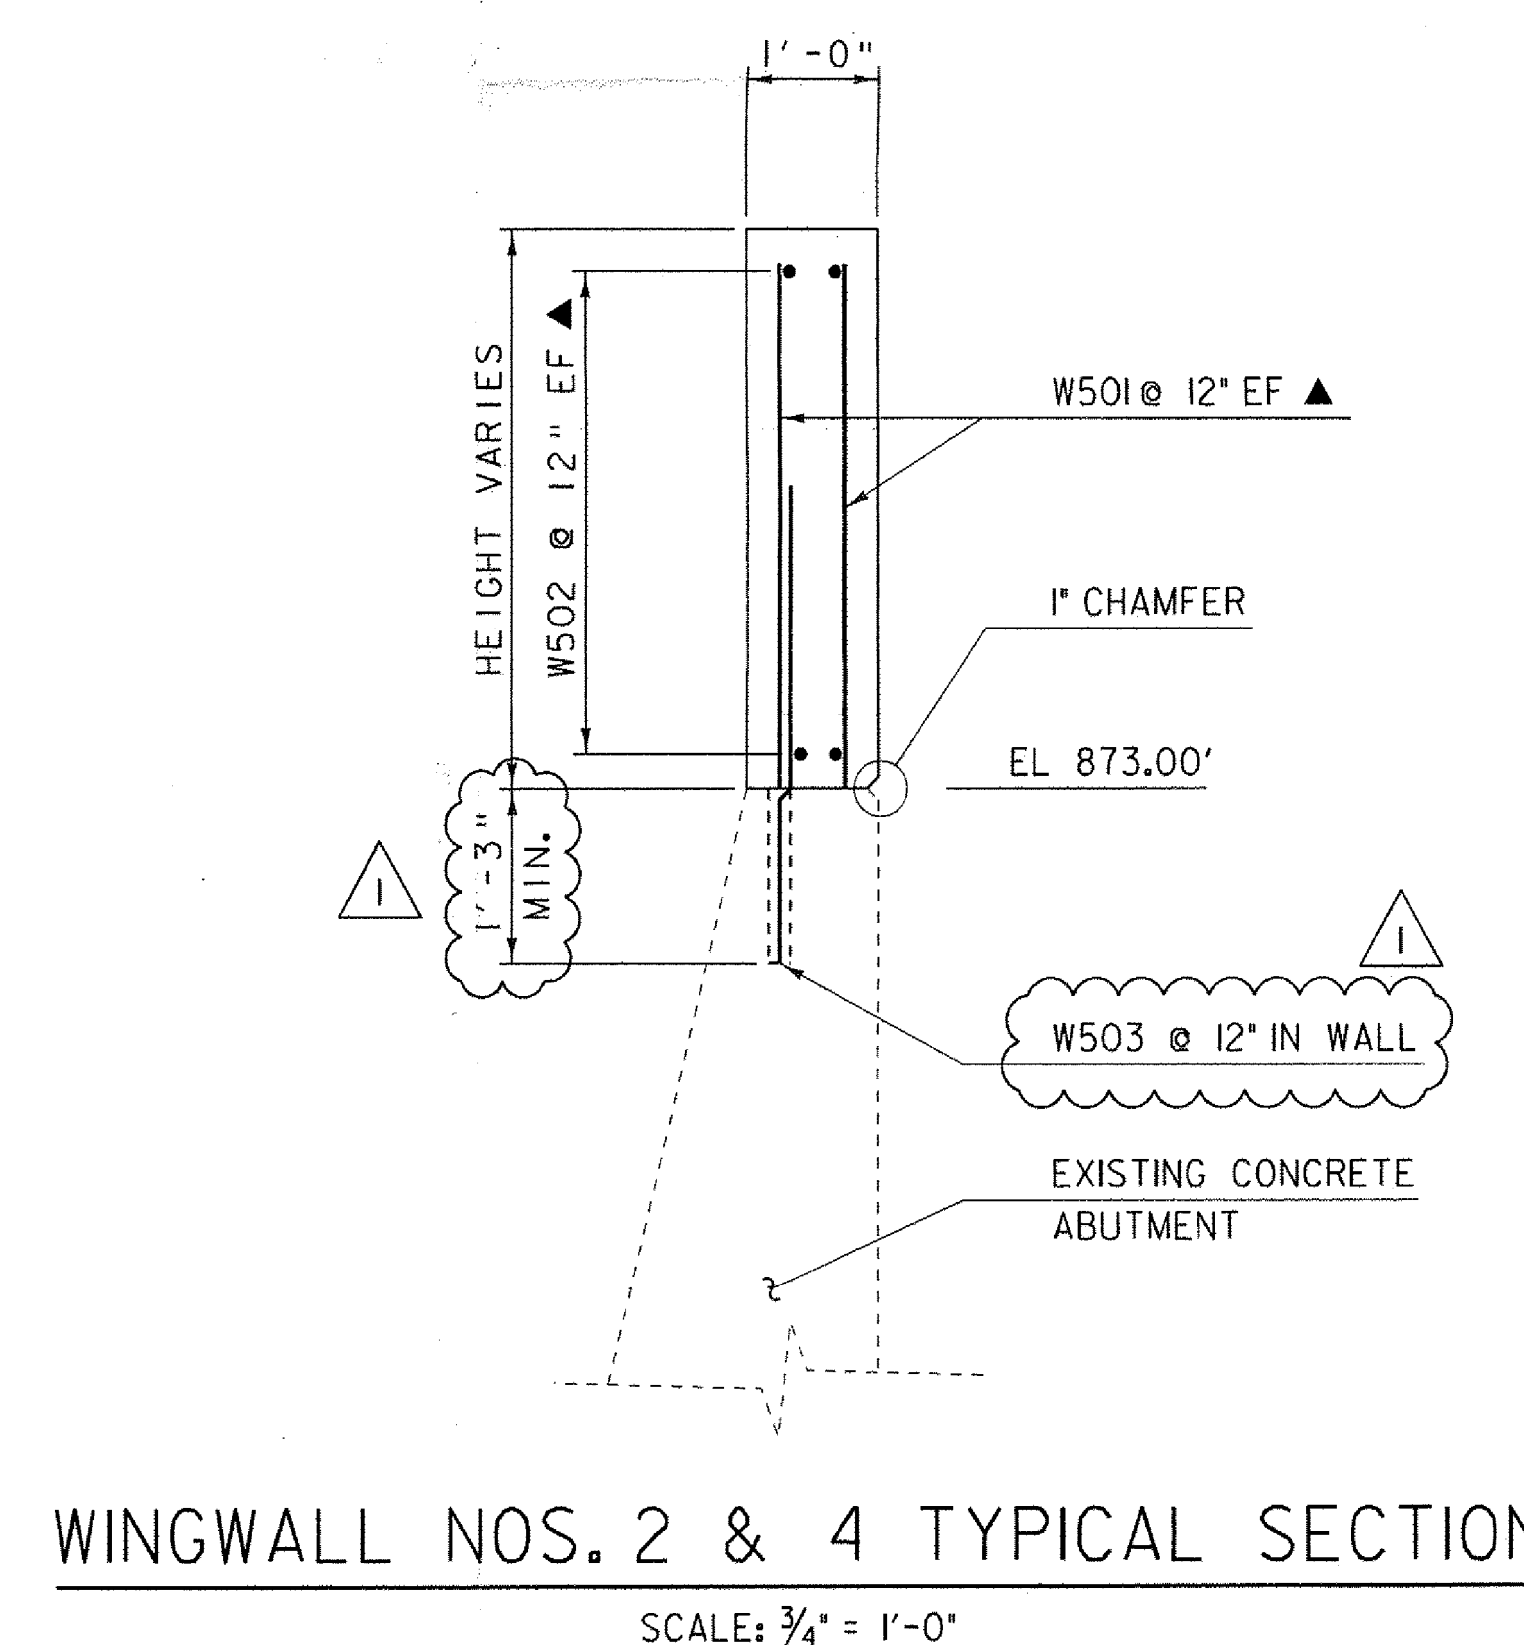
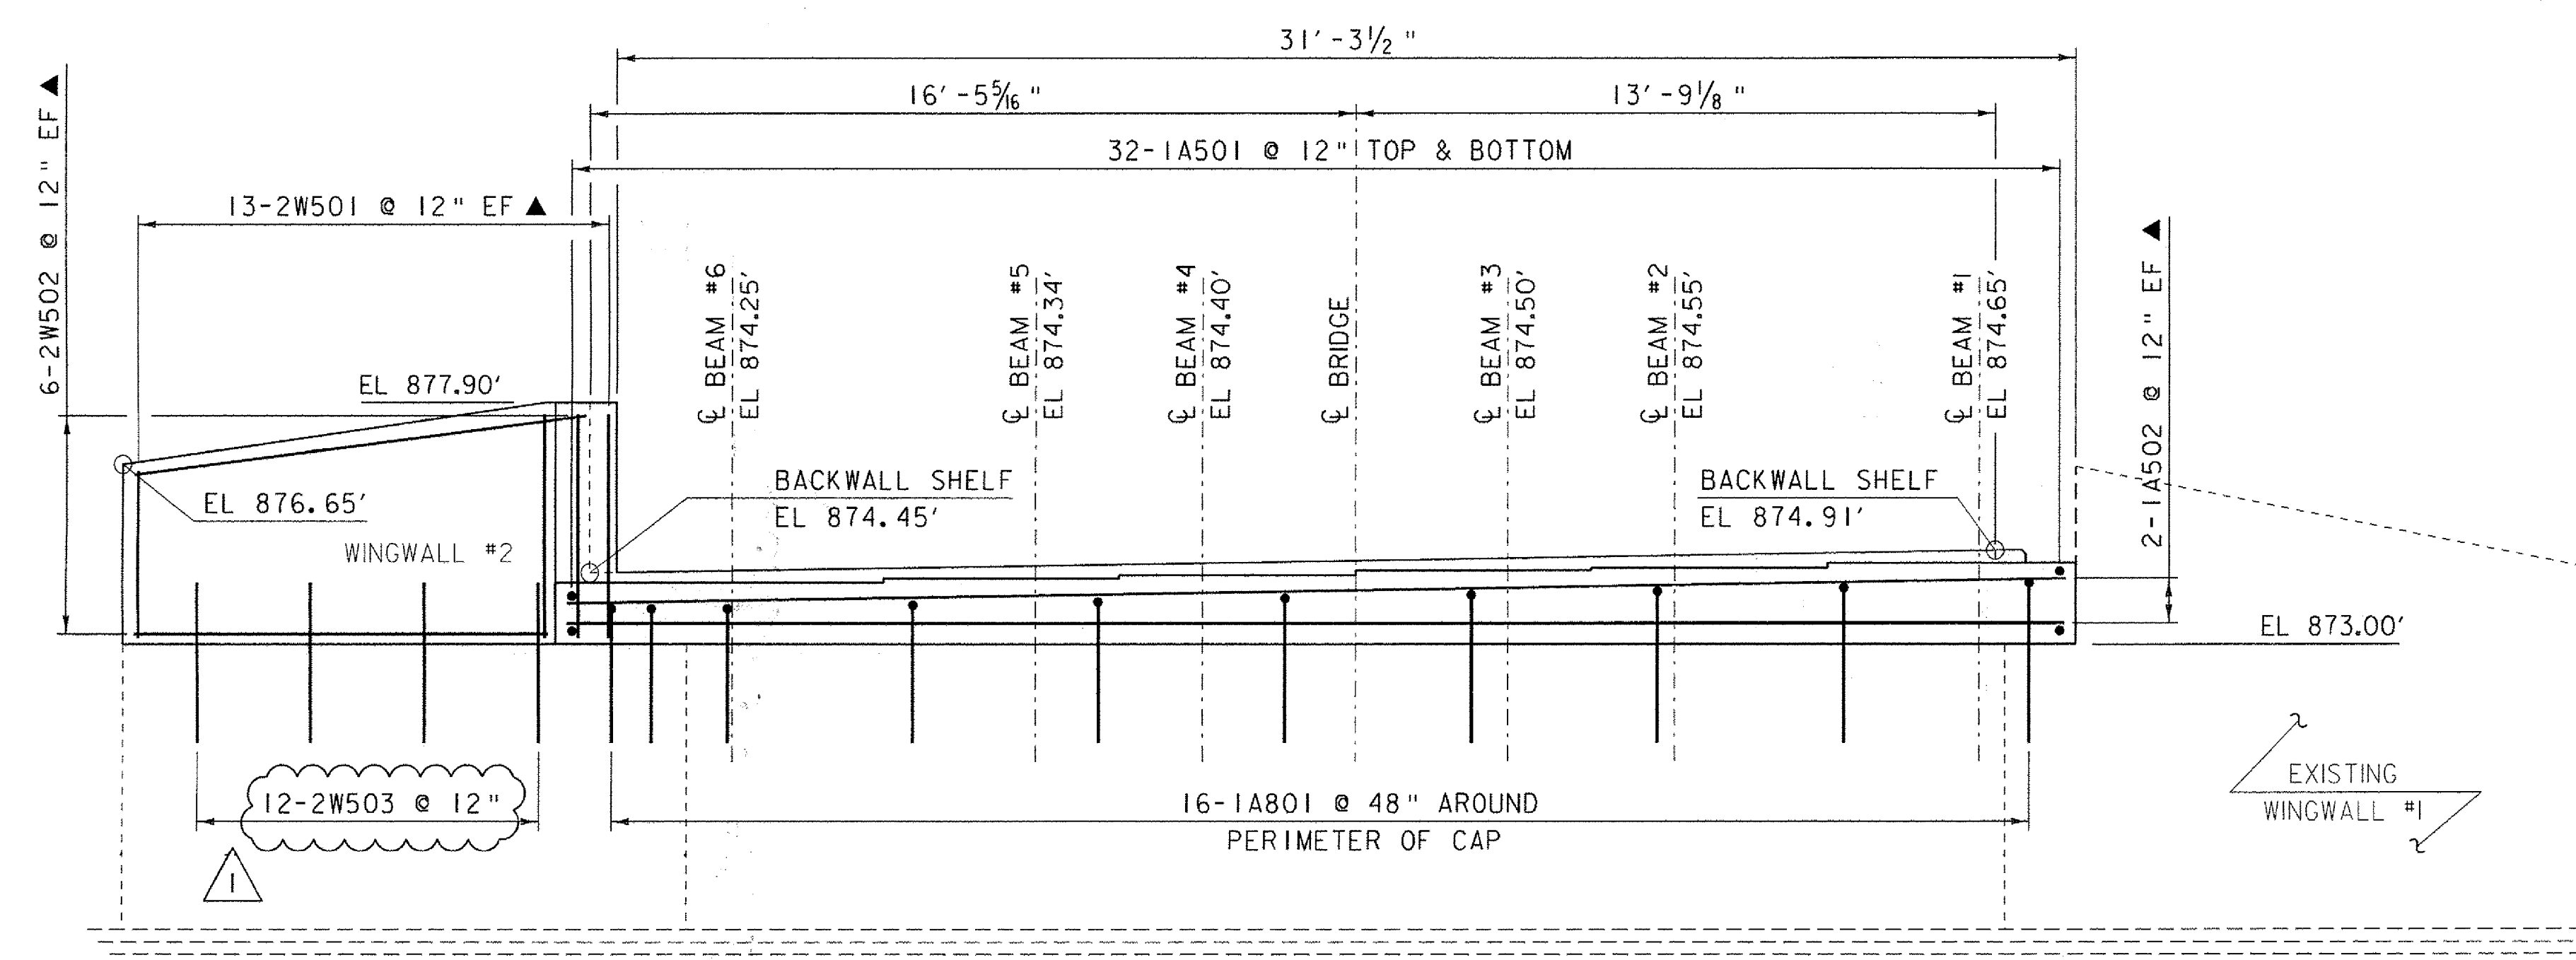
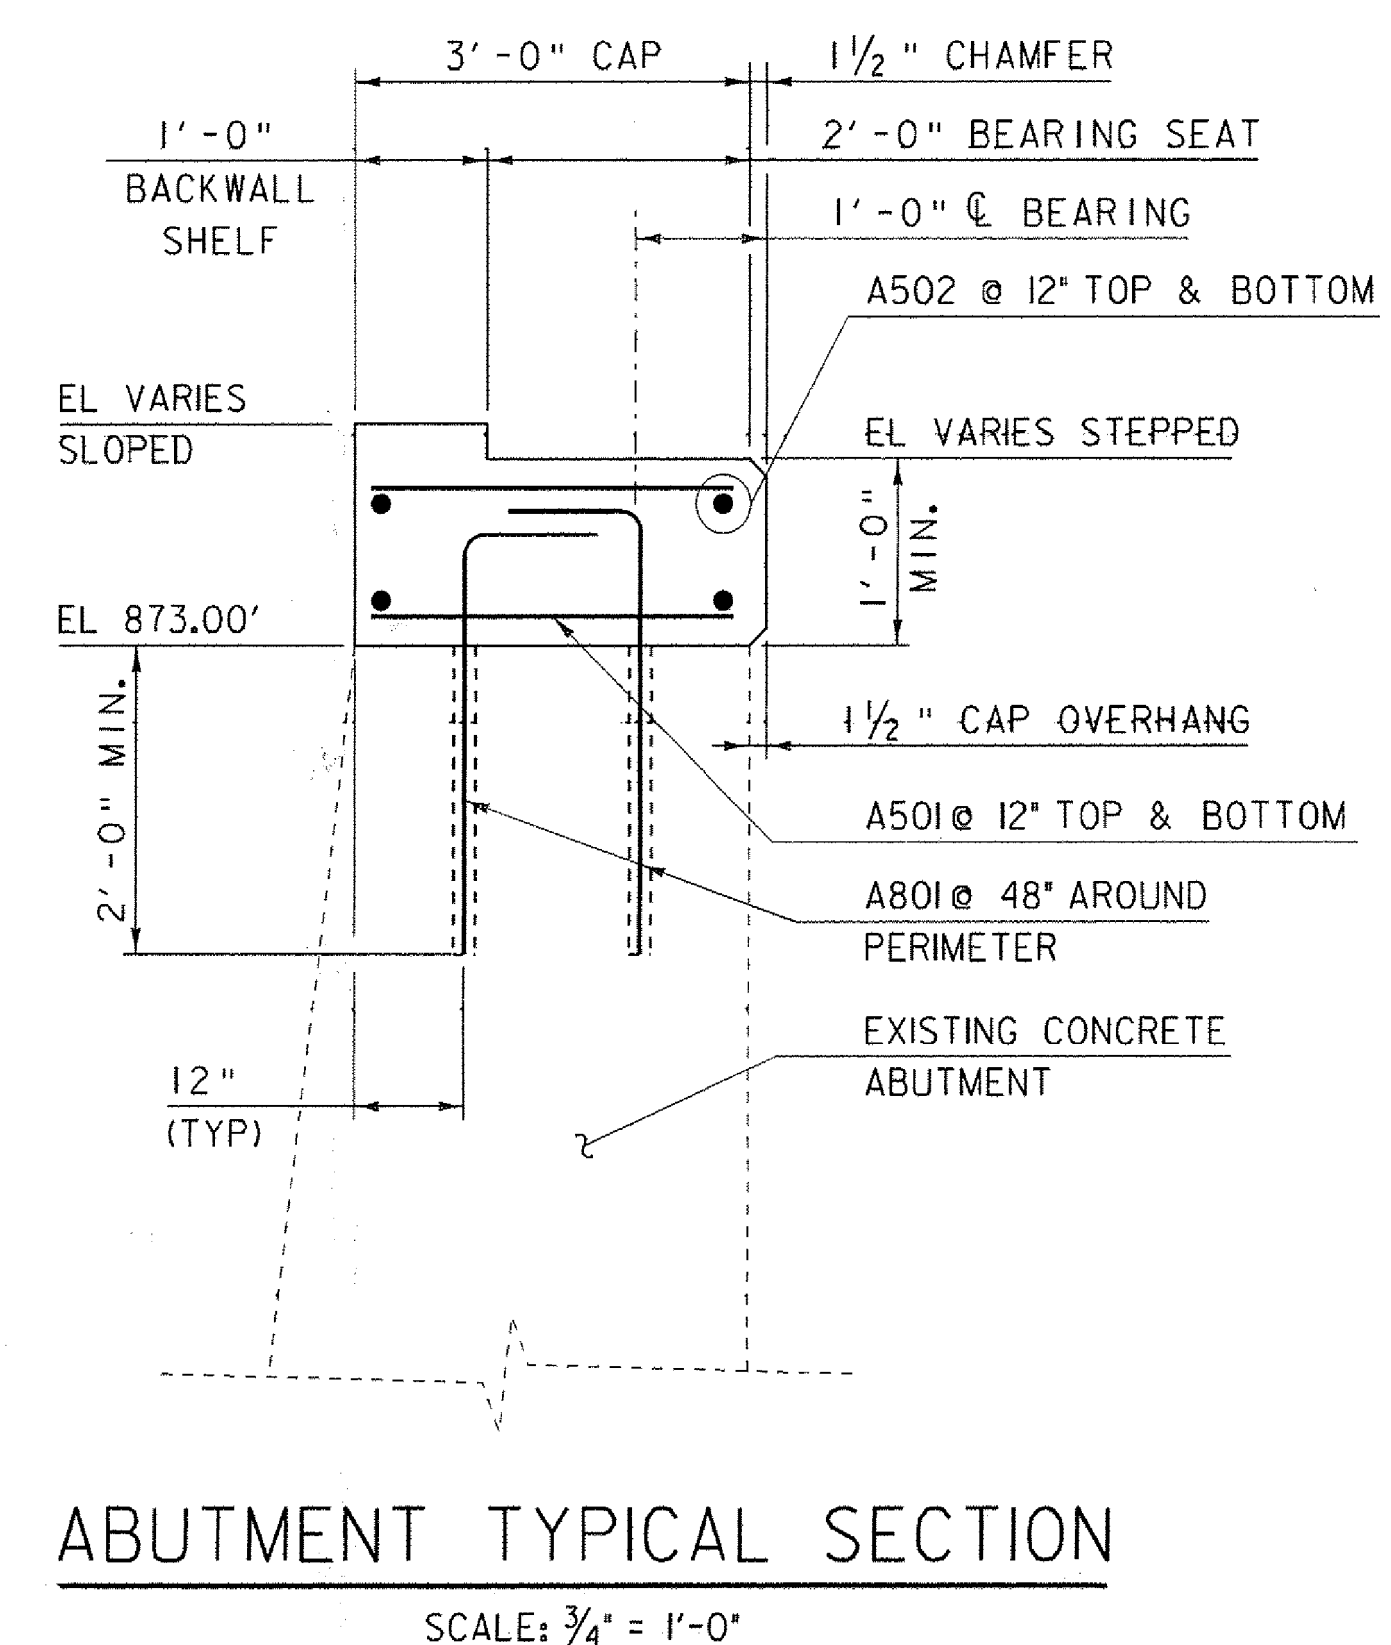


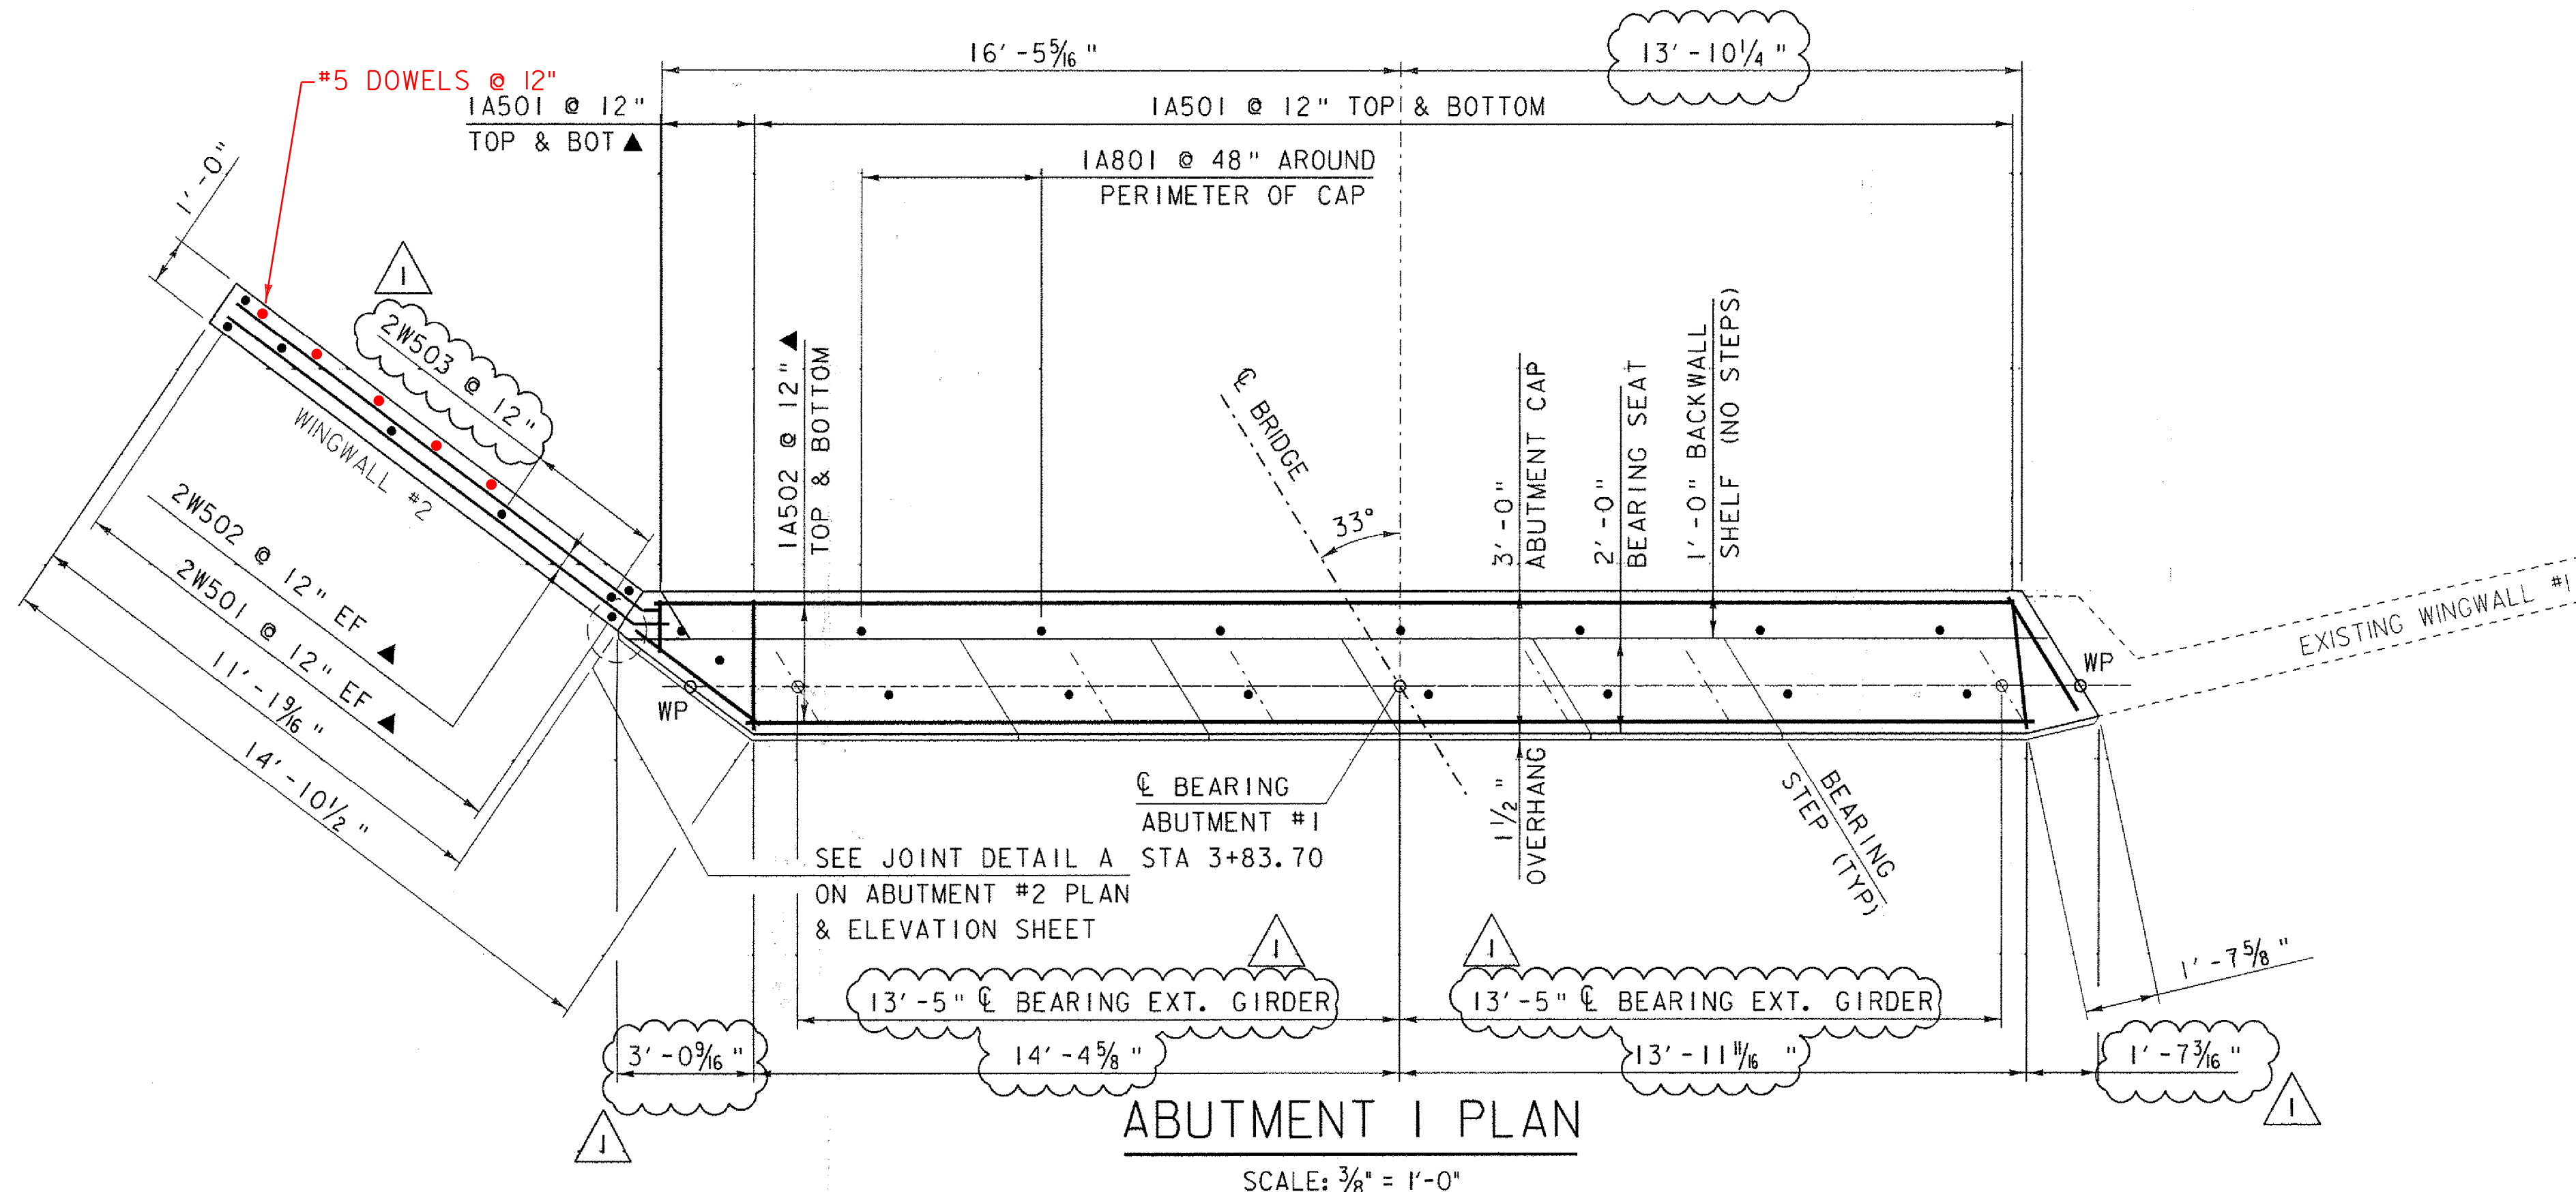

NOTE:

NF = NEAR FACE

FF = FAR FACE

EF = EACH FACE

▲ = CUT TO FIT IN FIELD

3" CLEAR, UNLESS OTHERWISE SPECIFIED ON THE PLANS.

2'-2" BAR LAP UNLESS OTHERWISE SPECIFIED ON THE PLANS.

ABUTMENT I ELEVATION

SCALE: 3/8" = 1'-0"

REVISION	DATE	DESCRIPTION	BY
1	11-7-2011	WW REBAR REV. AND DIMENSION CL EXTERIOR BEAM BEARING LOCATION	MCL

PROJECT NAME: ROXBURY	PLOT DATE: 07-NOV-2011
PROJECT NUMBER: BHF 0187 (8)	DRAWN BY: M. LONGSTREET
FILE NAME: st0c420sub.dgn	CHECKED BY: E.R.CHARBONNEAU
PROJECT LEADER: C.P. WILLIAMS	SHEET 238 OF 35
DESIGNED BY: R.S. YOUNG	
ABUTMENT #1 PLAN & ELEVATION	