


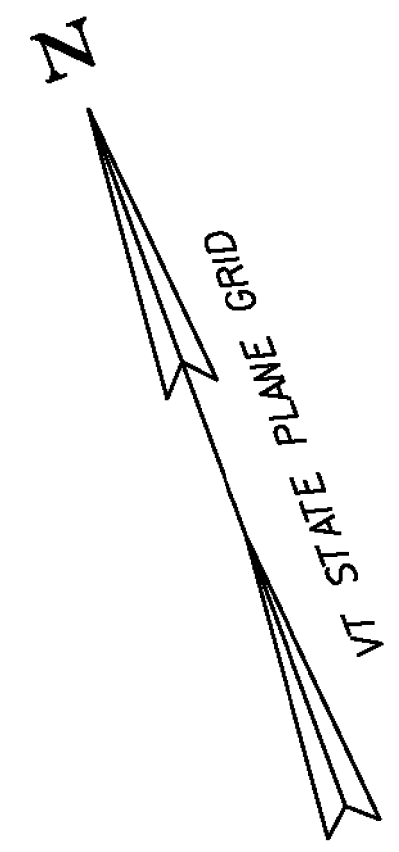

4 INCH WHITE LINE
STA 2+50.0 - 6+50.0 LT
STA 2+50.0 - 6+50.0 RT

4 INCH YELLOW LINE
STA 2+50.0 - 6+50.0 CL (DOUBLE)

TRAFFIC SIGNS, TYPE A
STA 3+69.6 RT
STA 3+79.9 LT
STA 4+32.9 RT
STA 5+34.6 LT

REMOVING SIGNS
STA 3+14.7 RT (2)
STA 3+69.9 RT (1)
STA 3+79.9 LT (1)
STA 4+57.2 RT (1)
STA 7+03.9 LT (2)

ERECTING SALVAGED SIGNS
STA 4+98.2 RT (1)

6+92 LT
STA ~~5+34.6~~ LT

13'-0"

N

N

TWO POSTS

6+20 LT
STA ~~6+34.0~~ LT

RET

RET

7+03.9 LT

WEIGHT LIMIT

12T

13T

13T

17T

20T

R

R

STA 3+04.9 LT

RET

RET

STA 3+14.7 RT

WEIGHT LIMIT

12T

13T

13T

17T

20T

R

R

STA 6+58.6 RT

RET

RET

LEGEND

	EXISTING SIGNS
	NEW OR SALVAGED SIGNS
RET	RETAIN
R	REMOVE
N	NEW
R&S	REMOVE & SALVAGE
S	SALVAGE

STA 0+72.8 RT

NARROW BRIDGE

RET

0121

1215

0060

RET

RET

STA 3+69.6 RT

RET

STA ~~3+69.6~~ RT

3+72 RT

STA ~~4+32.9~~ RT

4+32 RT

MOUNTED ON BACK OF 13'-0" SIGN

STA 4+57.2 RT

13'-0"

R&S


R&S

TWO POSTS

13'-0"

S

S

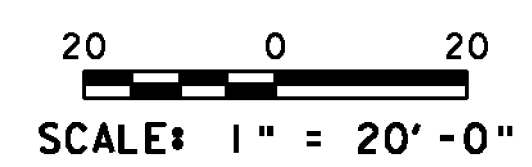

PROJECT NAME:	ROXBURY
PROJECT NUMBER:	BHF 0187(8)
FILE NAME:	sl0c420bdr.dgn
PROJECT LEADER:	C. P. WILLIAMS
DESIGNED BY:	T. FILLBACH
TRAFFIC SIGNS AND PAVEMENT MARKINGS	
PLOT DATE:	21-SEP-2011
DRAWN BY:	G. ROY
CHECKED BY:	T. FILLBACH
SHEET	28 OF 54