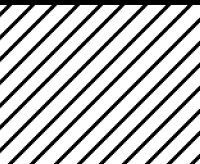


STATE OF VERMONT
AGENCY OF TRANSPORTATION

TRAFFIC SIGN SUMMARY SHEET

MILEMARKER, STATION, OR SIGN NUMBER	SIGN LEGEND	SIGN DIMENSIONS			NEW & SALVAGED SIGNS				EXIST POST		NO. OF POST S	NEW SIGN POSTS																			REMARKS	SIGN DETAIL												
												FLANGED CHANNEL			SQUARE STEEL (In)			TUBULAR ALUMINUM Ø (In)			TUBULAR STEEL Ø (In)				W-SHAPE STEEL																			
		E A	WIDTH (In)	HEIGHT (In)	"A"	"B"	SALV SIGN	SALV TIS	RET AIN	S ALV AGE		I J 2	2 .0	3 .0	1 .75	2 .0	2 .5	A N C H O R	S L E E V E	3 .0	4 .0	4 .0 MOD	FOUND- ATION	3 .0	3 .5	4 .0	5 .0	FTG. SIZE		WEIGHT		POST SIZE	R E F R A M E D	DETAIL IN SHS	DETAIL ON SHEET NUMBER	STD. SHEET NUMBER								
																												lb/ft	lb/ft								lb/ft	lb/ft	24"	30"				
												OPTION ITEMS																																
3+69.6-RT 3+72 RT		I	12	36	3.00						I					X 11'		X																		OM3-R	X							
3+79.9-LT 3+87 LT		I	12	36	3.00						I					X 11'		X																			OM3-L	X						
4+32.9-RT 4+32 RT		I	12	36	3.00						I	ON SALVAGED POSTS				X		X																			OM3-L	X						
6+20 LT		I	12	36	3.00						I					X 11'		X																										
4+98.2-RT 4+32 RT								X			+ 2					14.25' X 14.25'		X																										
5+34.6-LT 6+92 LT		I	36	36	9.00						+ 2					14.25' X 14.50'		X																			W12-2	X						
FINAL POST LENGTHS ARE TO BE DETERMINED IN THE FIELD. POST SIZES ARE COMPUTED BASED ON INFORMATION FURNISHED ON THE STANDARD SHEETS AND VTRANS "SIGN POST DESIGN GUIDELINE." SHS = STANDARD HIGHWAY SIGNS												FT	FT	FT	FT	FT	70.0	FT		EA	LB	LB	LB			LB	LB	LB	LB						PROJECT NAME: ROXBURY PROJECT NUMBER: BHF 0187(8) FILE NAME: s10c420+ss.dgn PROJECT LEADER: C.P.WILLIAMS DESIGNED BY: G. ROY TRAFFIC SIGN SUMMARY SHEET					PLOT DATE: 21-SEP-2011 DRAWN BY: G. ROY CHECKED BY: R. YOUNG SHEET 29 OF 54				
TOTALS					SF	SF	EA.	SF		FT			FT				LB				EA.	LB				EA.	EA.	LB																
					18.00 21.00		I						70.0 90.25																															