



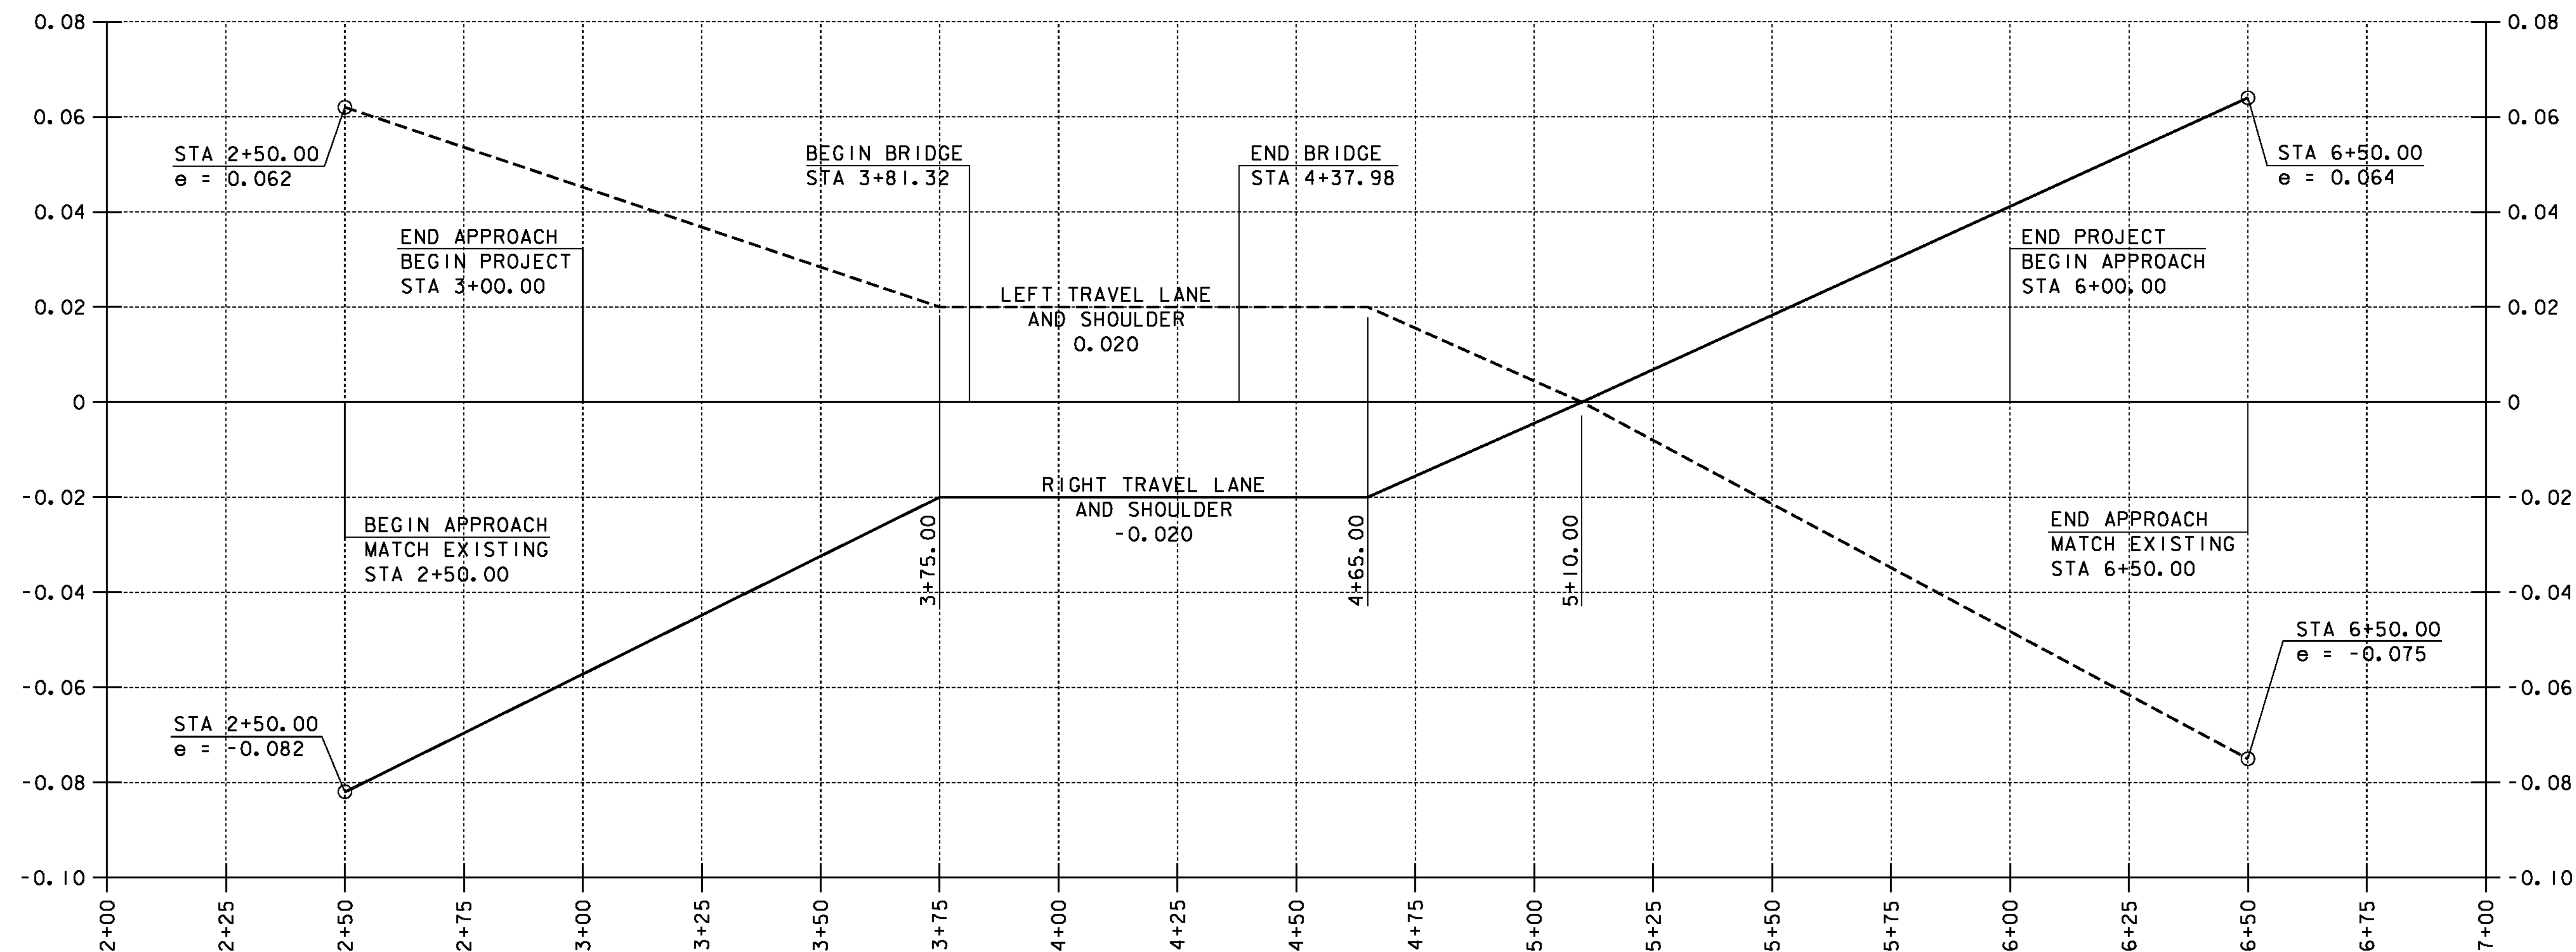

VT 12A BANKING DIAGRAM

HORIZONTAL SCALE: 1" = 20'-0"
VERTICAL SCALE: 1" = 0.02' /"

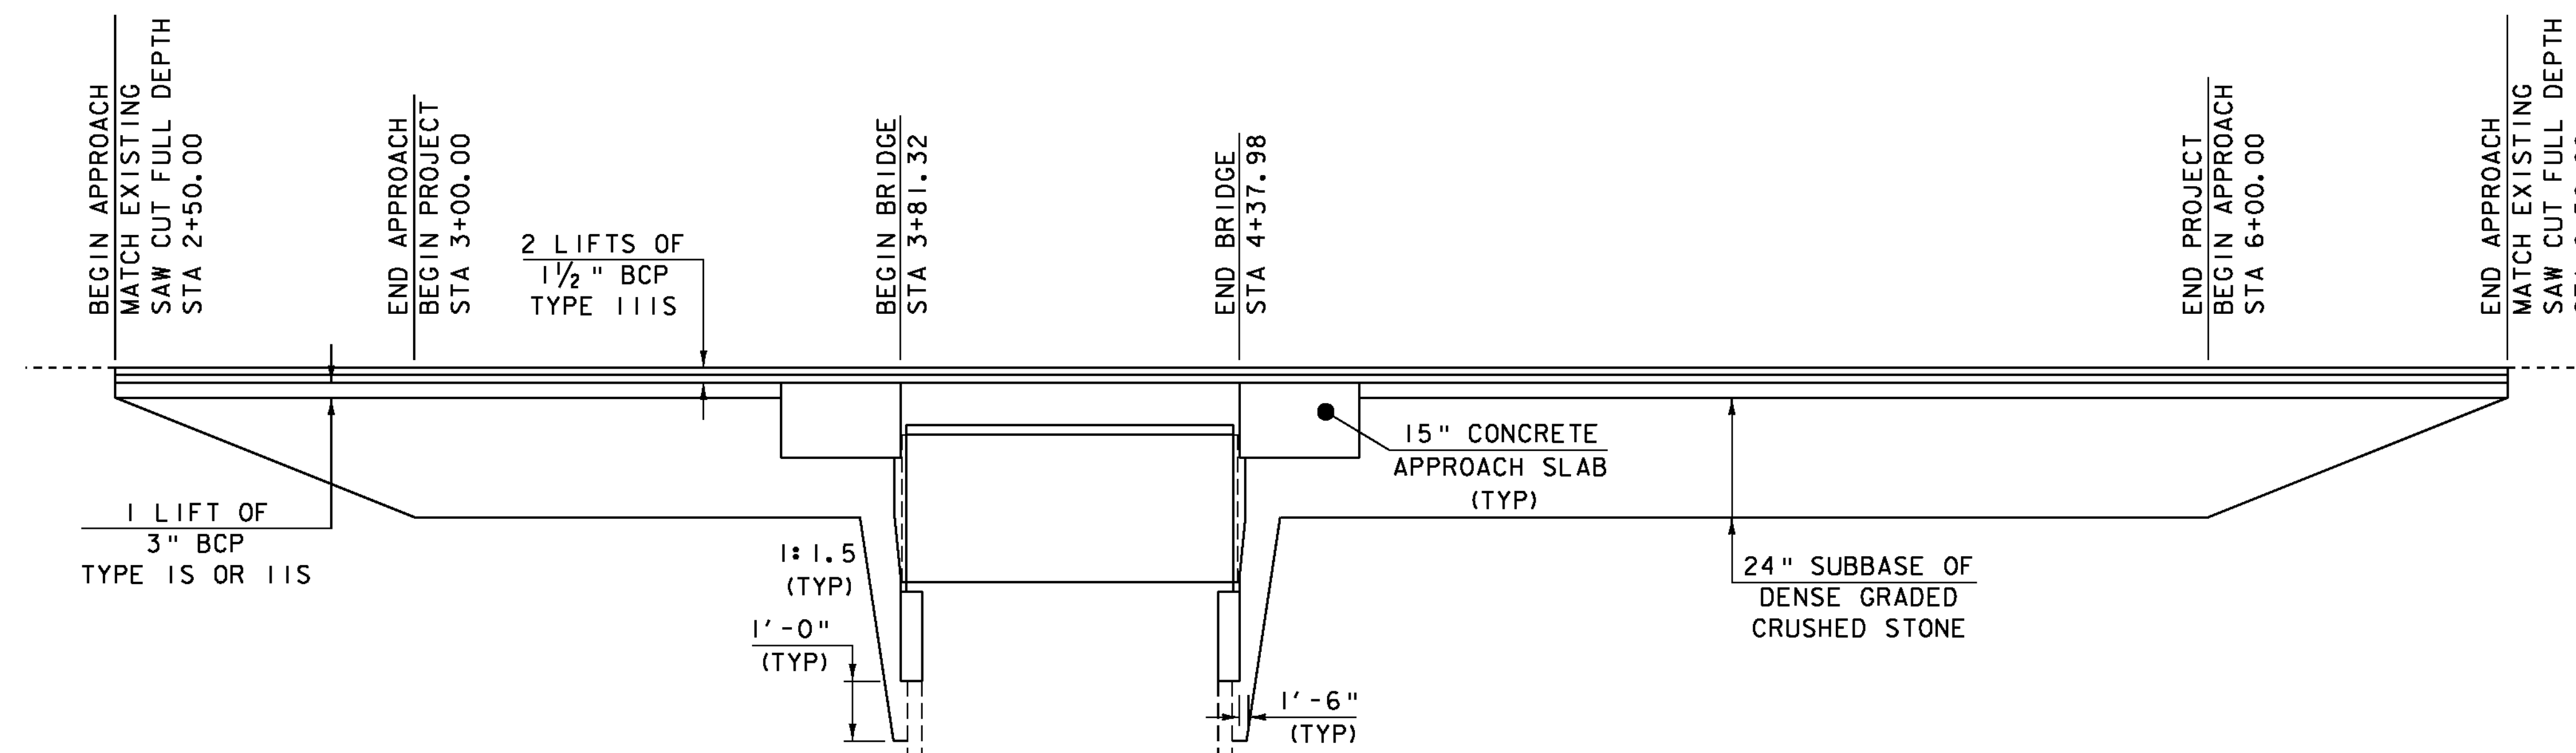

VT 12A MATERIAL TRANSITION DETAIL

HORIZONTAL SCALE: 1" = 20'-0"
VERTICAL SCALE: 1" = 2'-0"

PROJECT NAME: ROXBURY	PLOT DATE: 21-SEP-2011
PROJECT NUMBER: BHF 0187(8)	DRAWN BY: G. ROY
FILE NAME: sl0c420pro.dgn	CHECKED BY: T. FILLBACH
PROJECT LEADER: C. P. WILLIAMS	BANKING DIAGRAM AND MATERIAL TRANSITION SHEET 31 OF 54
DESIGNED BY: G. ROY	