



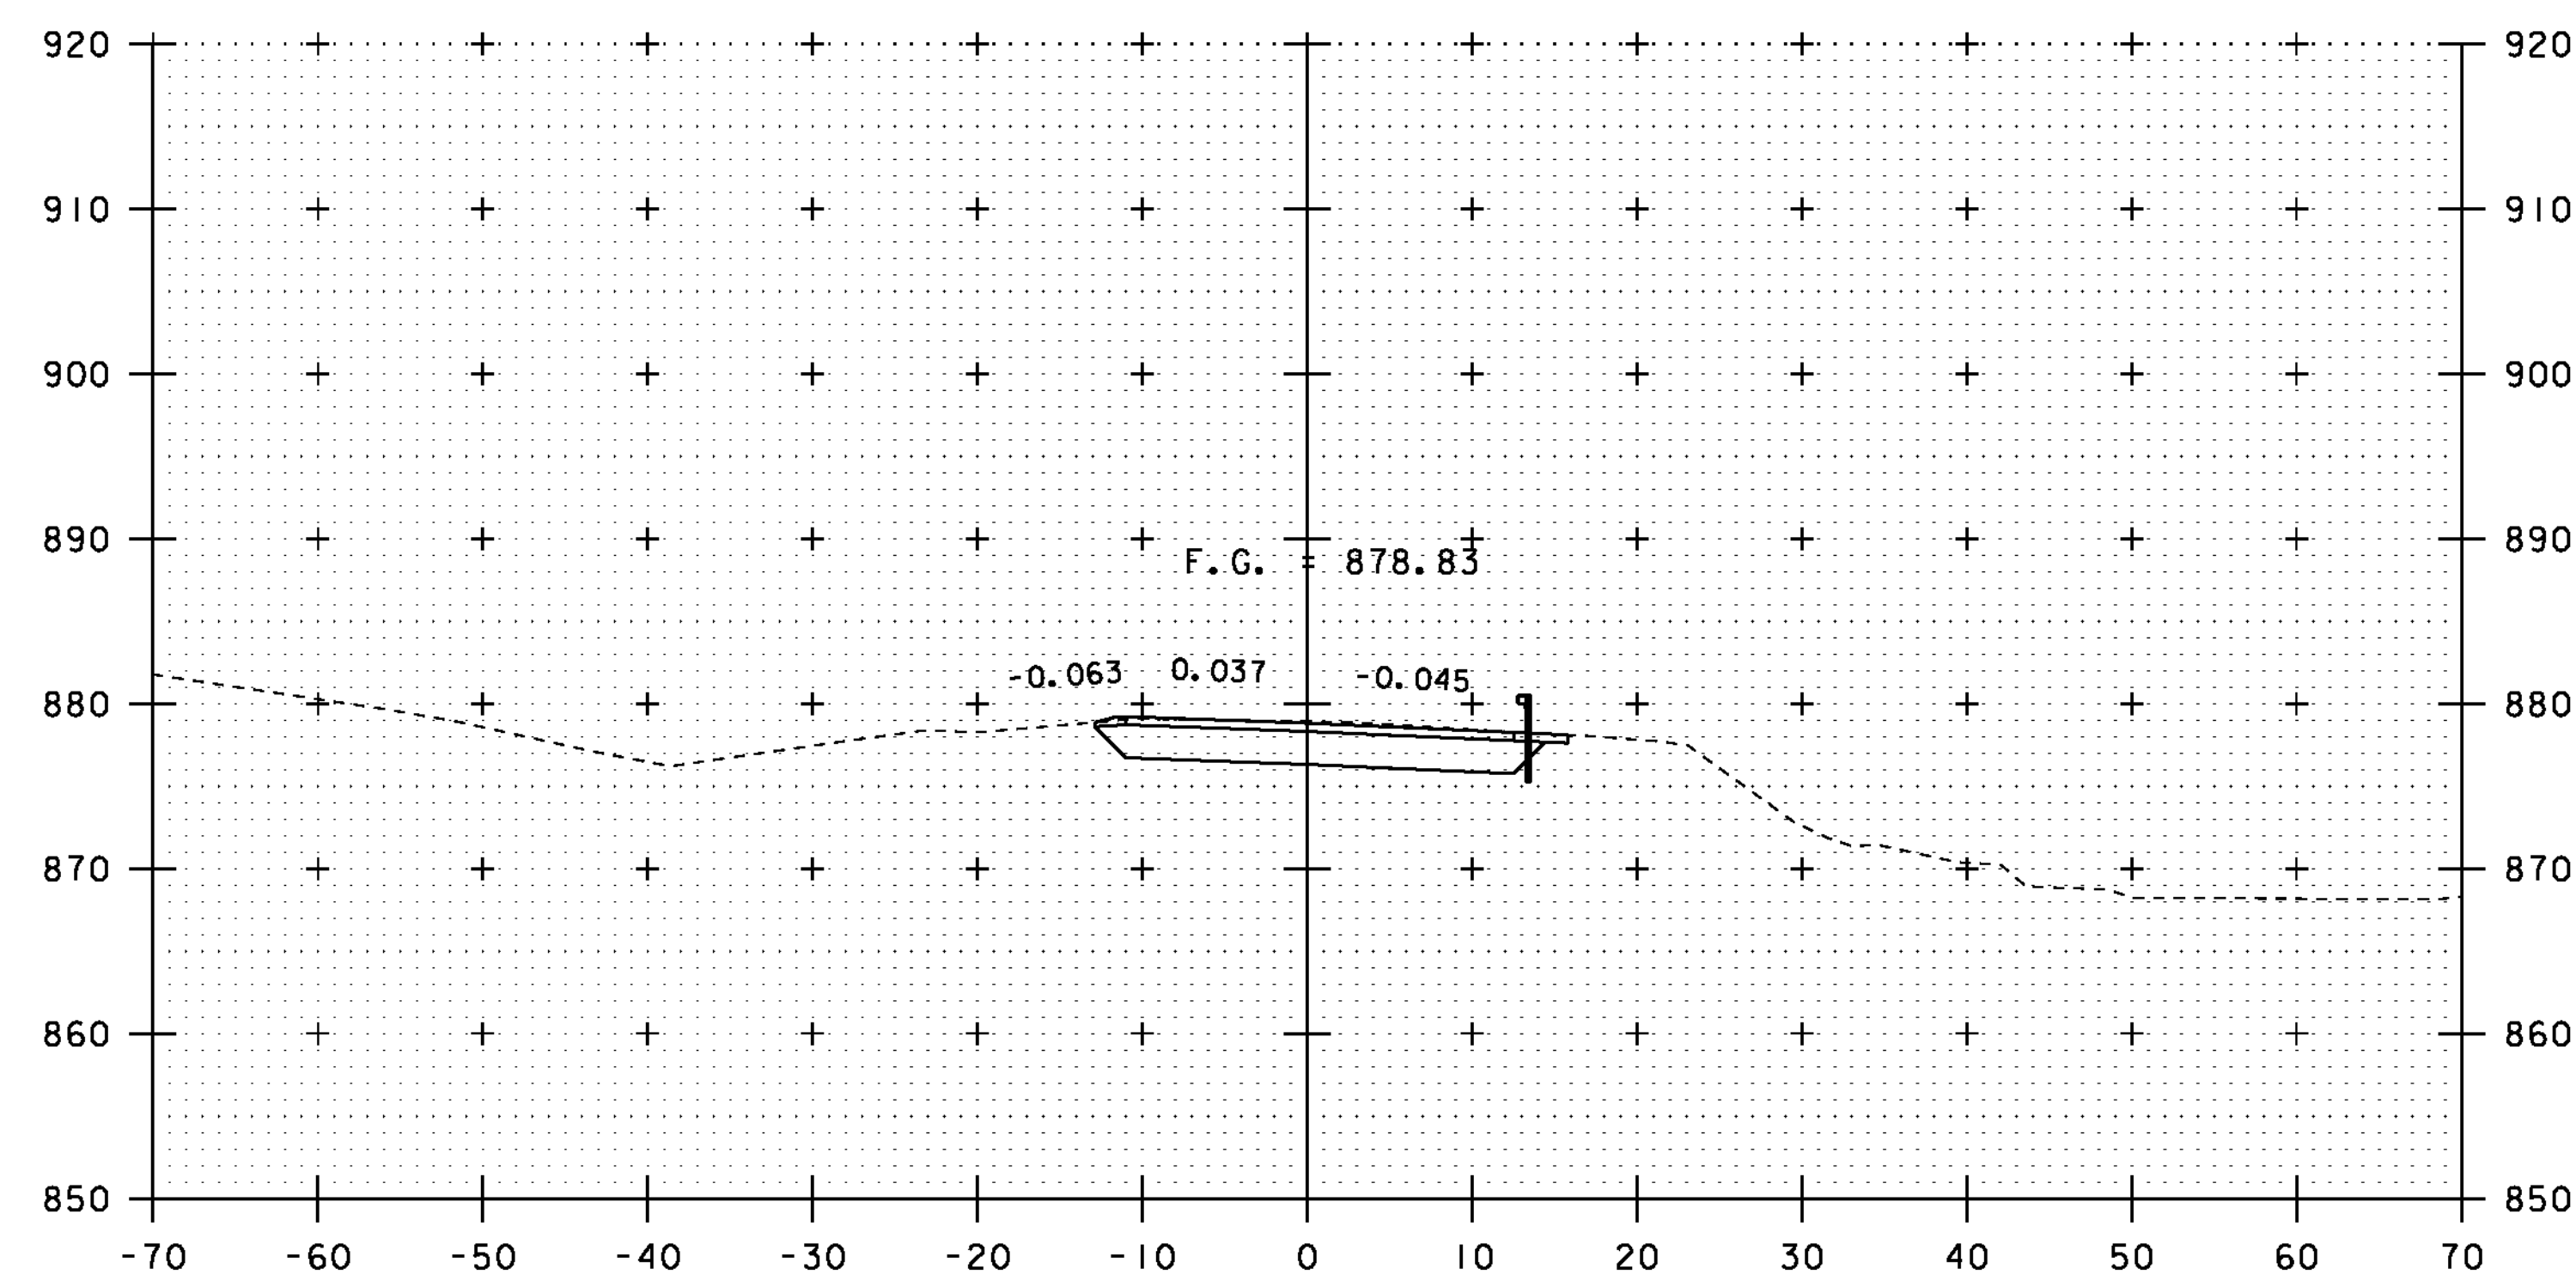


3+25

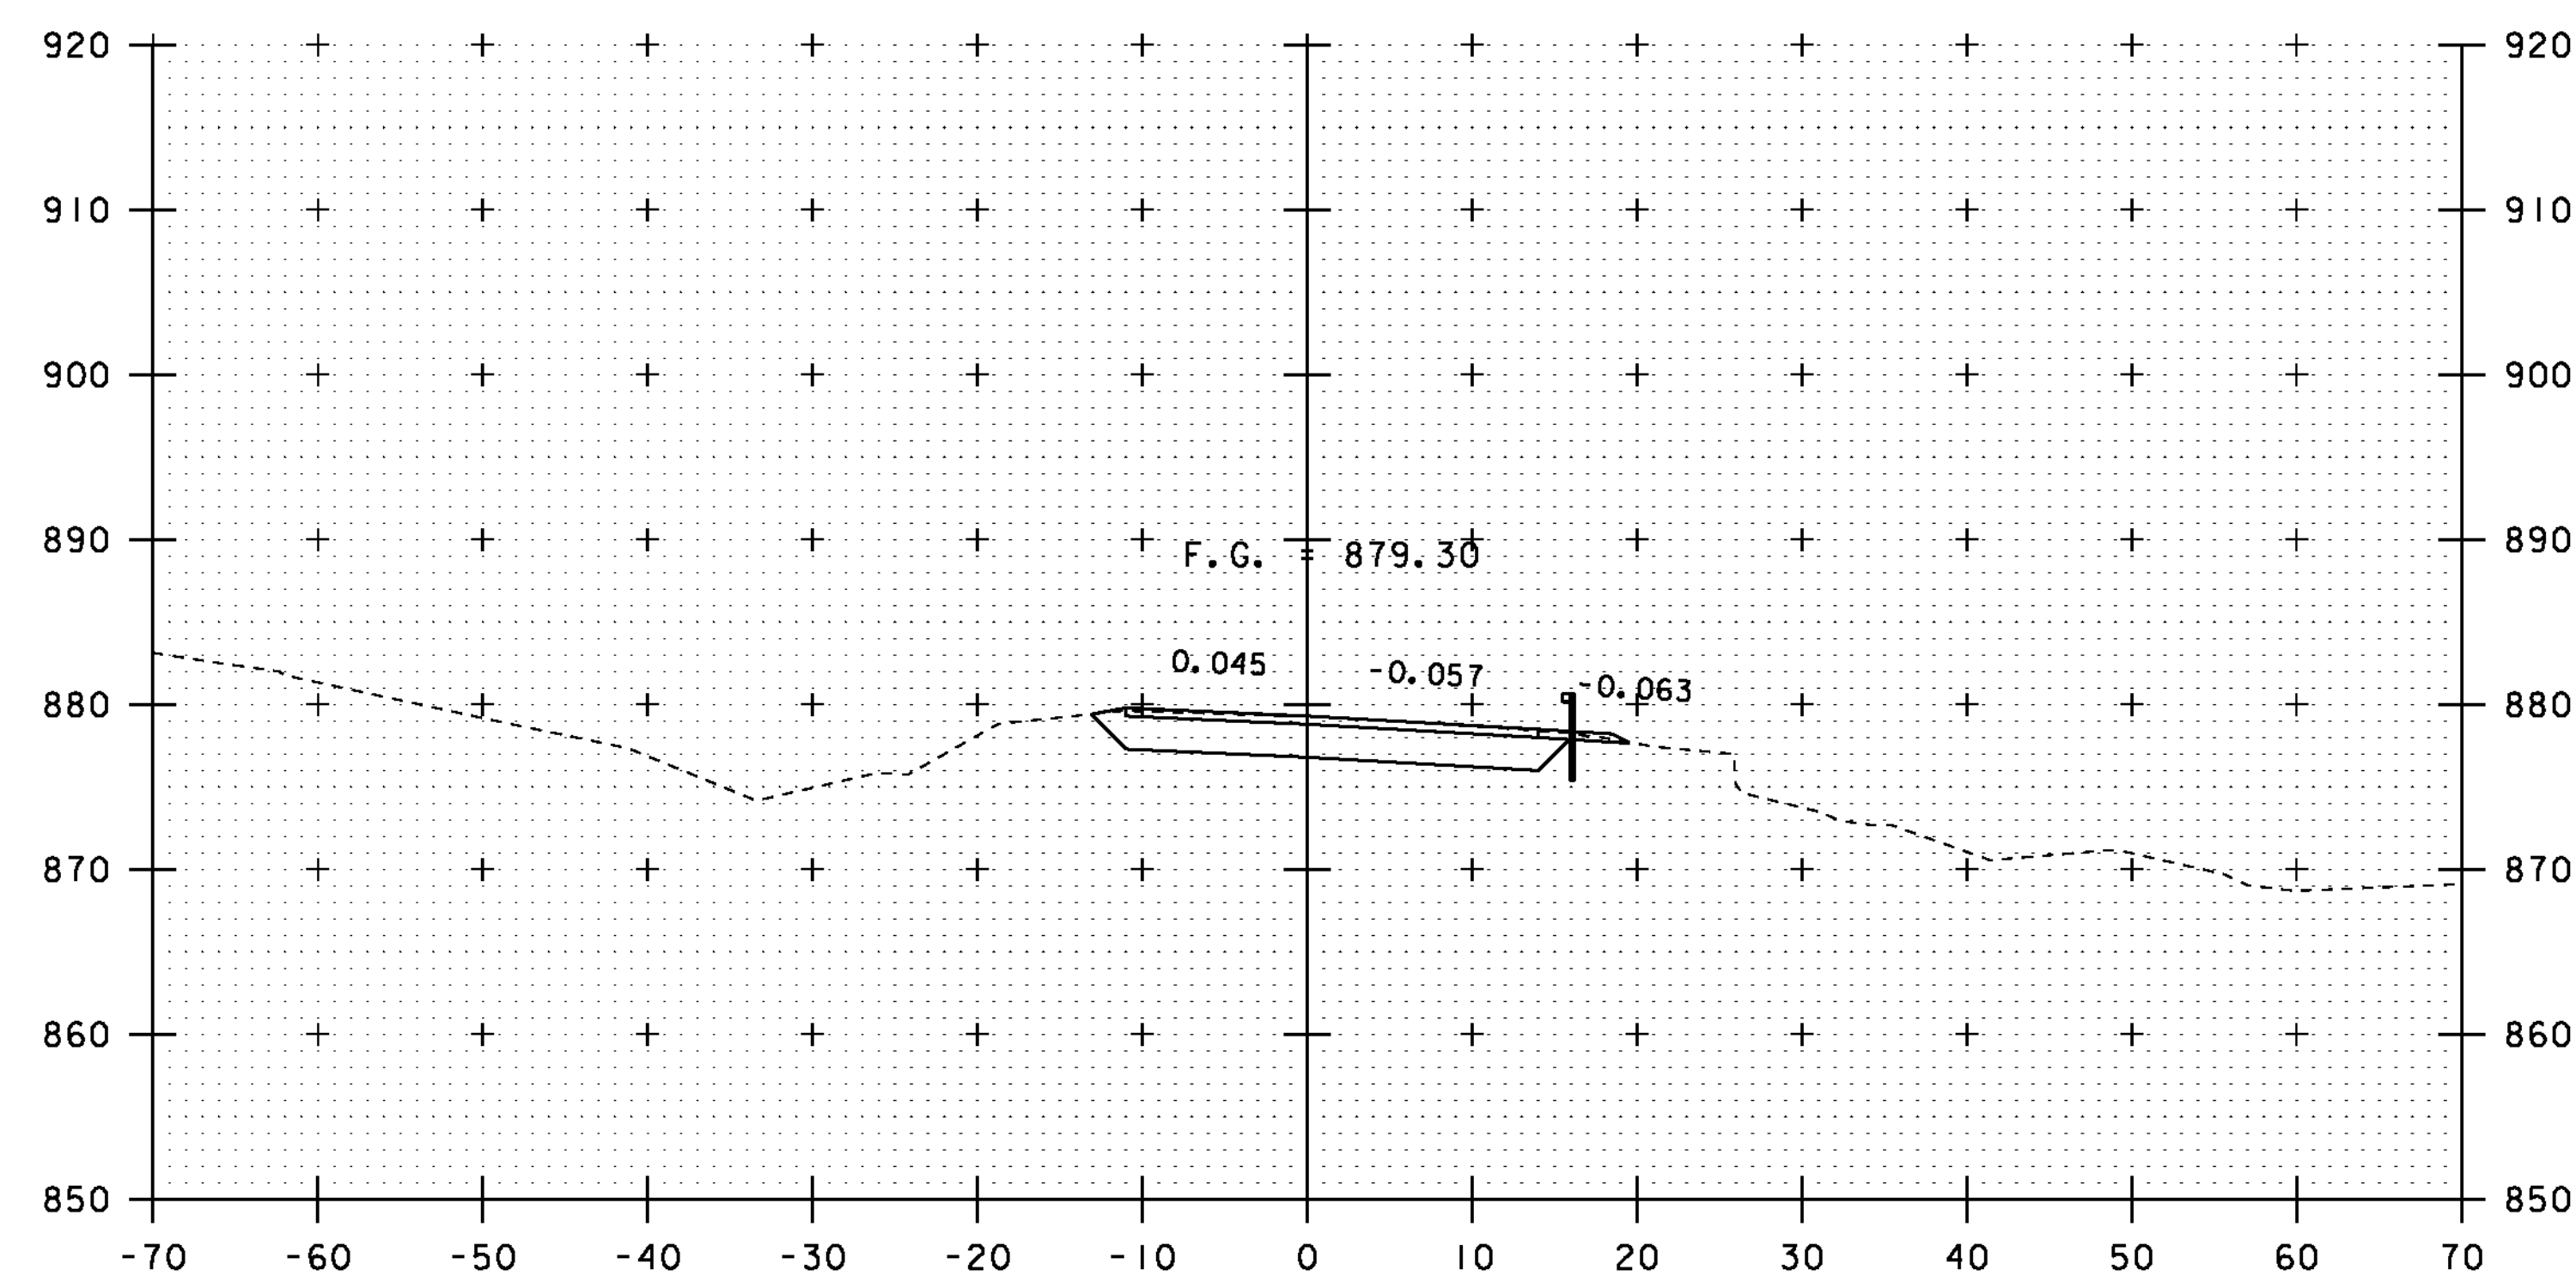


SEE SHEET 37 FOR NEW OPTION PIPE
SECTION AT STA 2+89.2.

3+00

END APPROACH
BEGIN PROJECT
STA 3+00.00

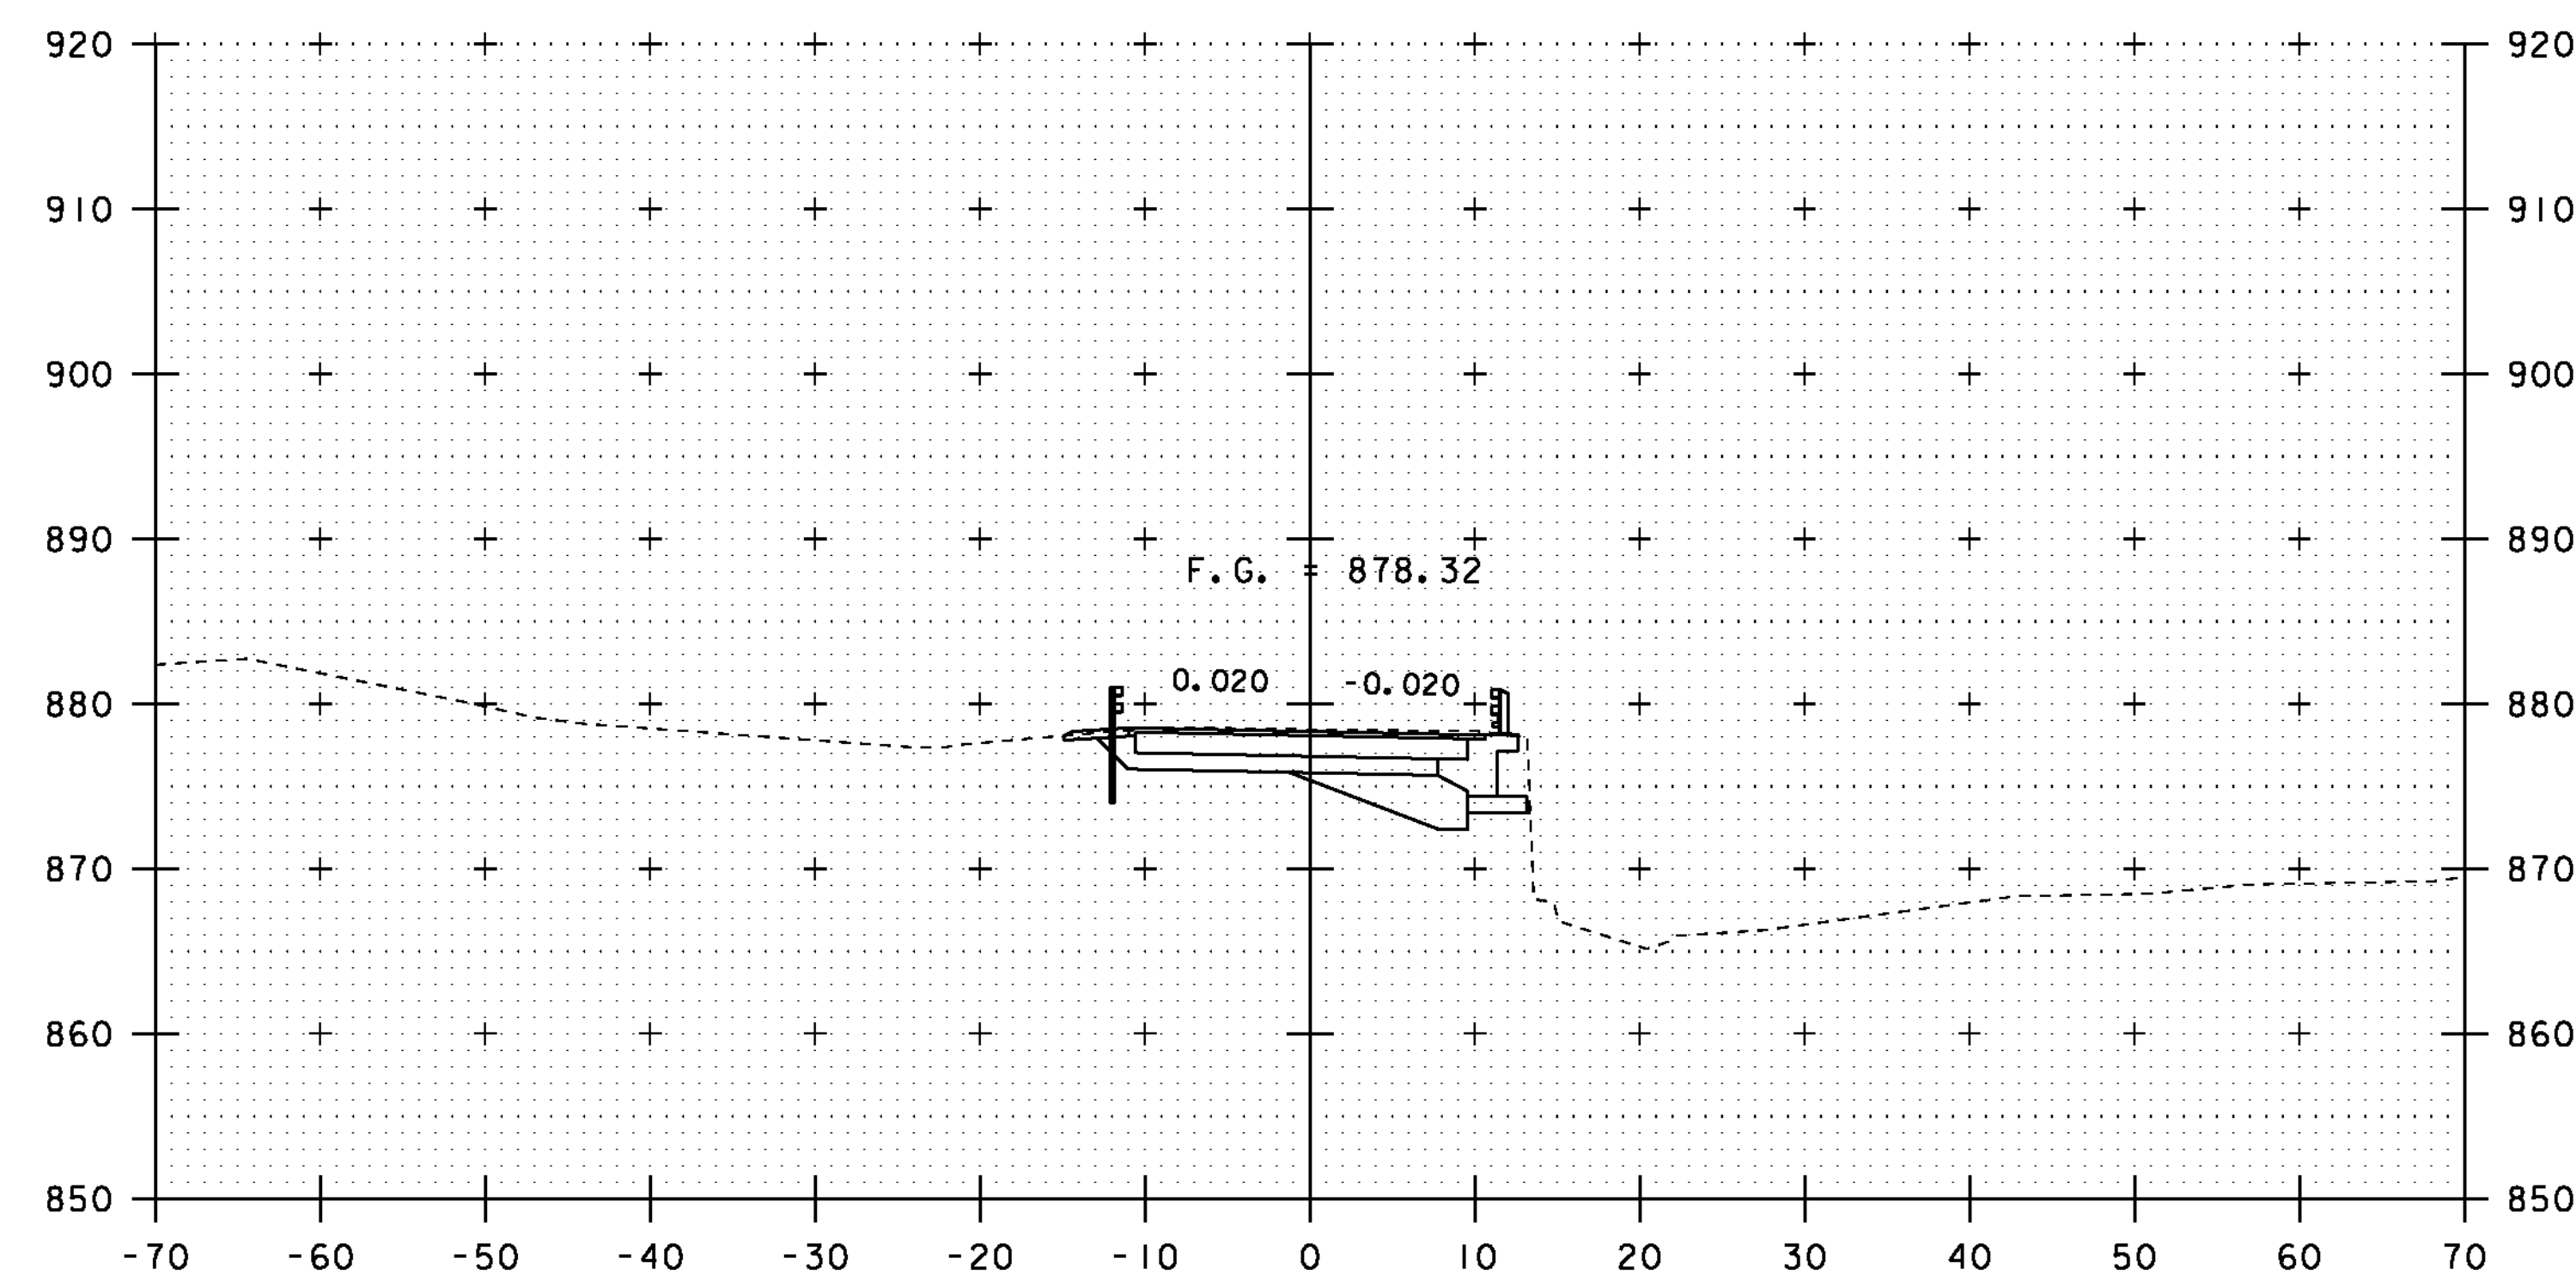

3+75

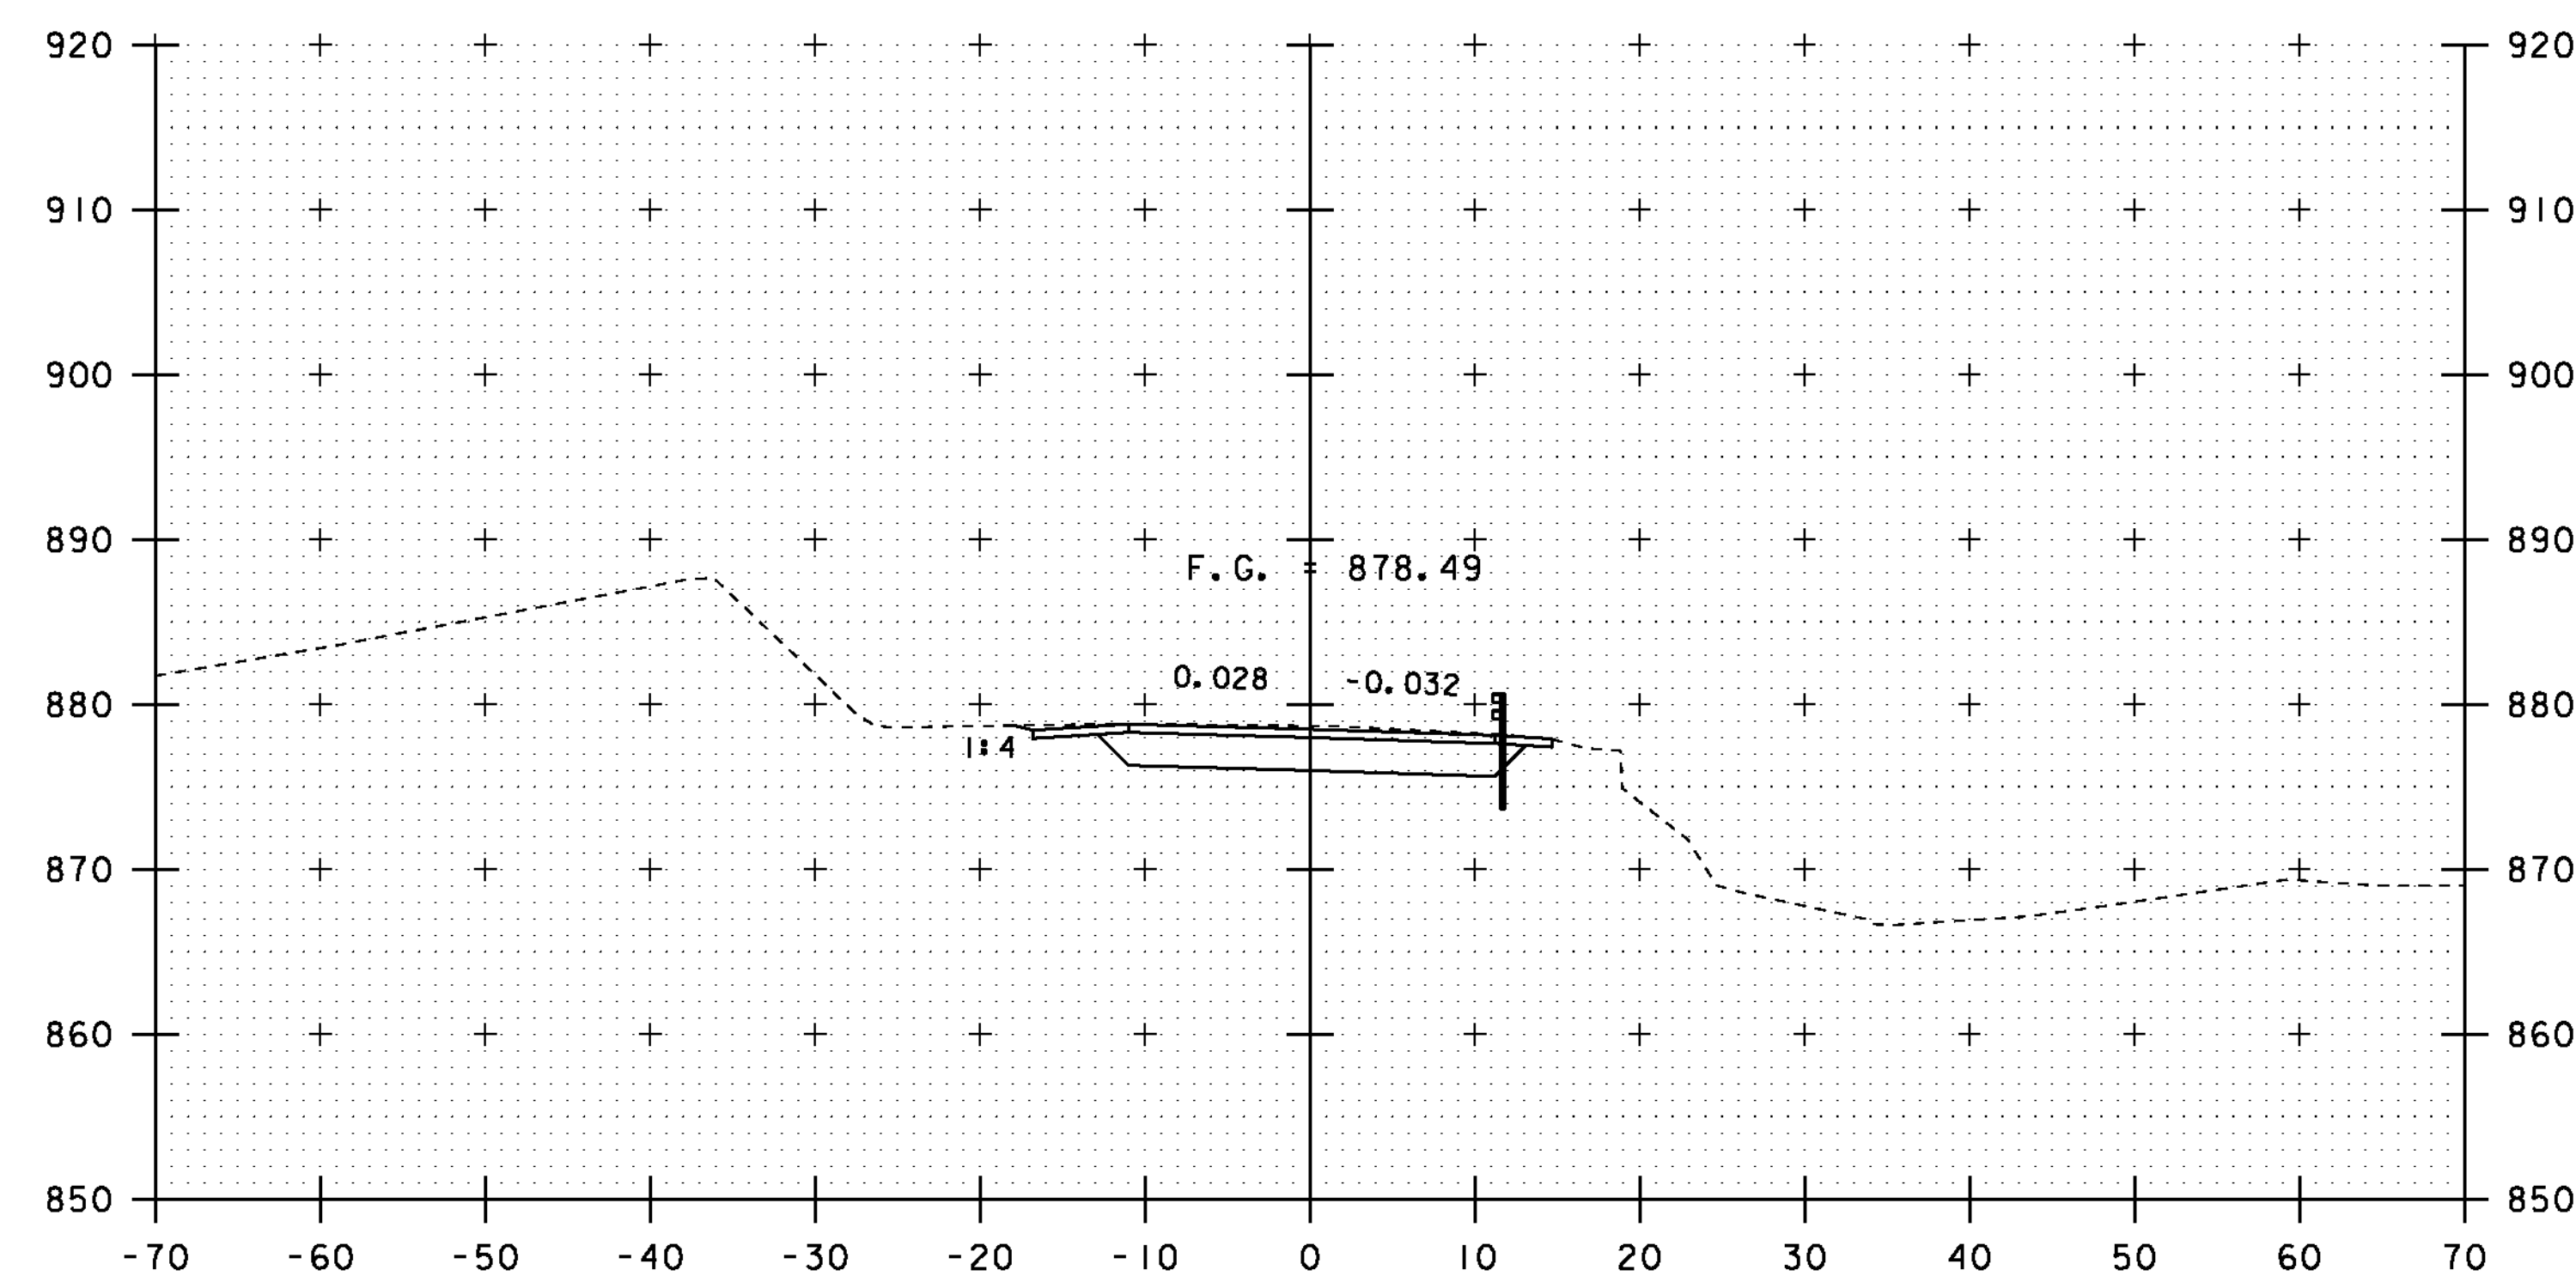

3+50



STA. 3+00 TO STA. 3+75

PROJECT NAME: ROXBURY	
PROJECT NUMBER: BHF 0187(8)	
FILE NAME: sl0c420xsl.dgn	PLOT DATE: 21-SEP-2011
PROJECT LEADER: C. P. WILLIAMS	DRAWN BY: G. ROY
DESIGNED BY: G. ROY	CHECKED BY: T. FILLBACH
VT 12A CROSS SECTIONS (2)	SHEET 33 OF 54