
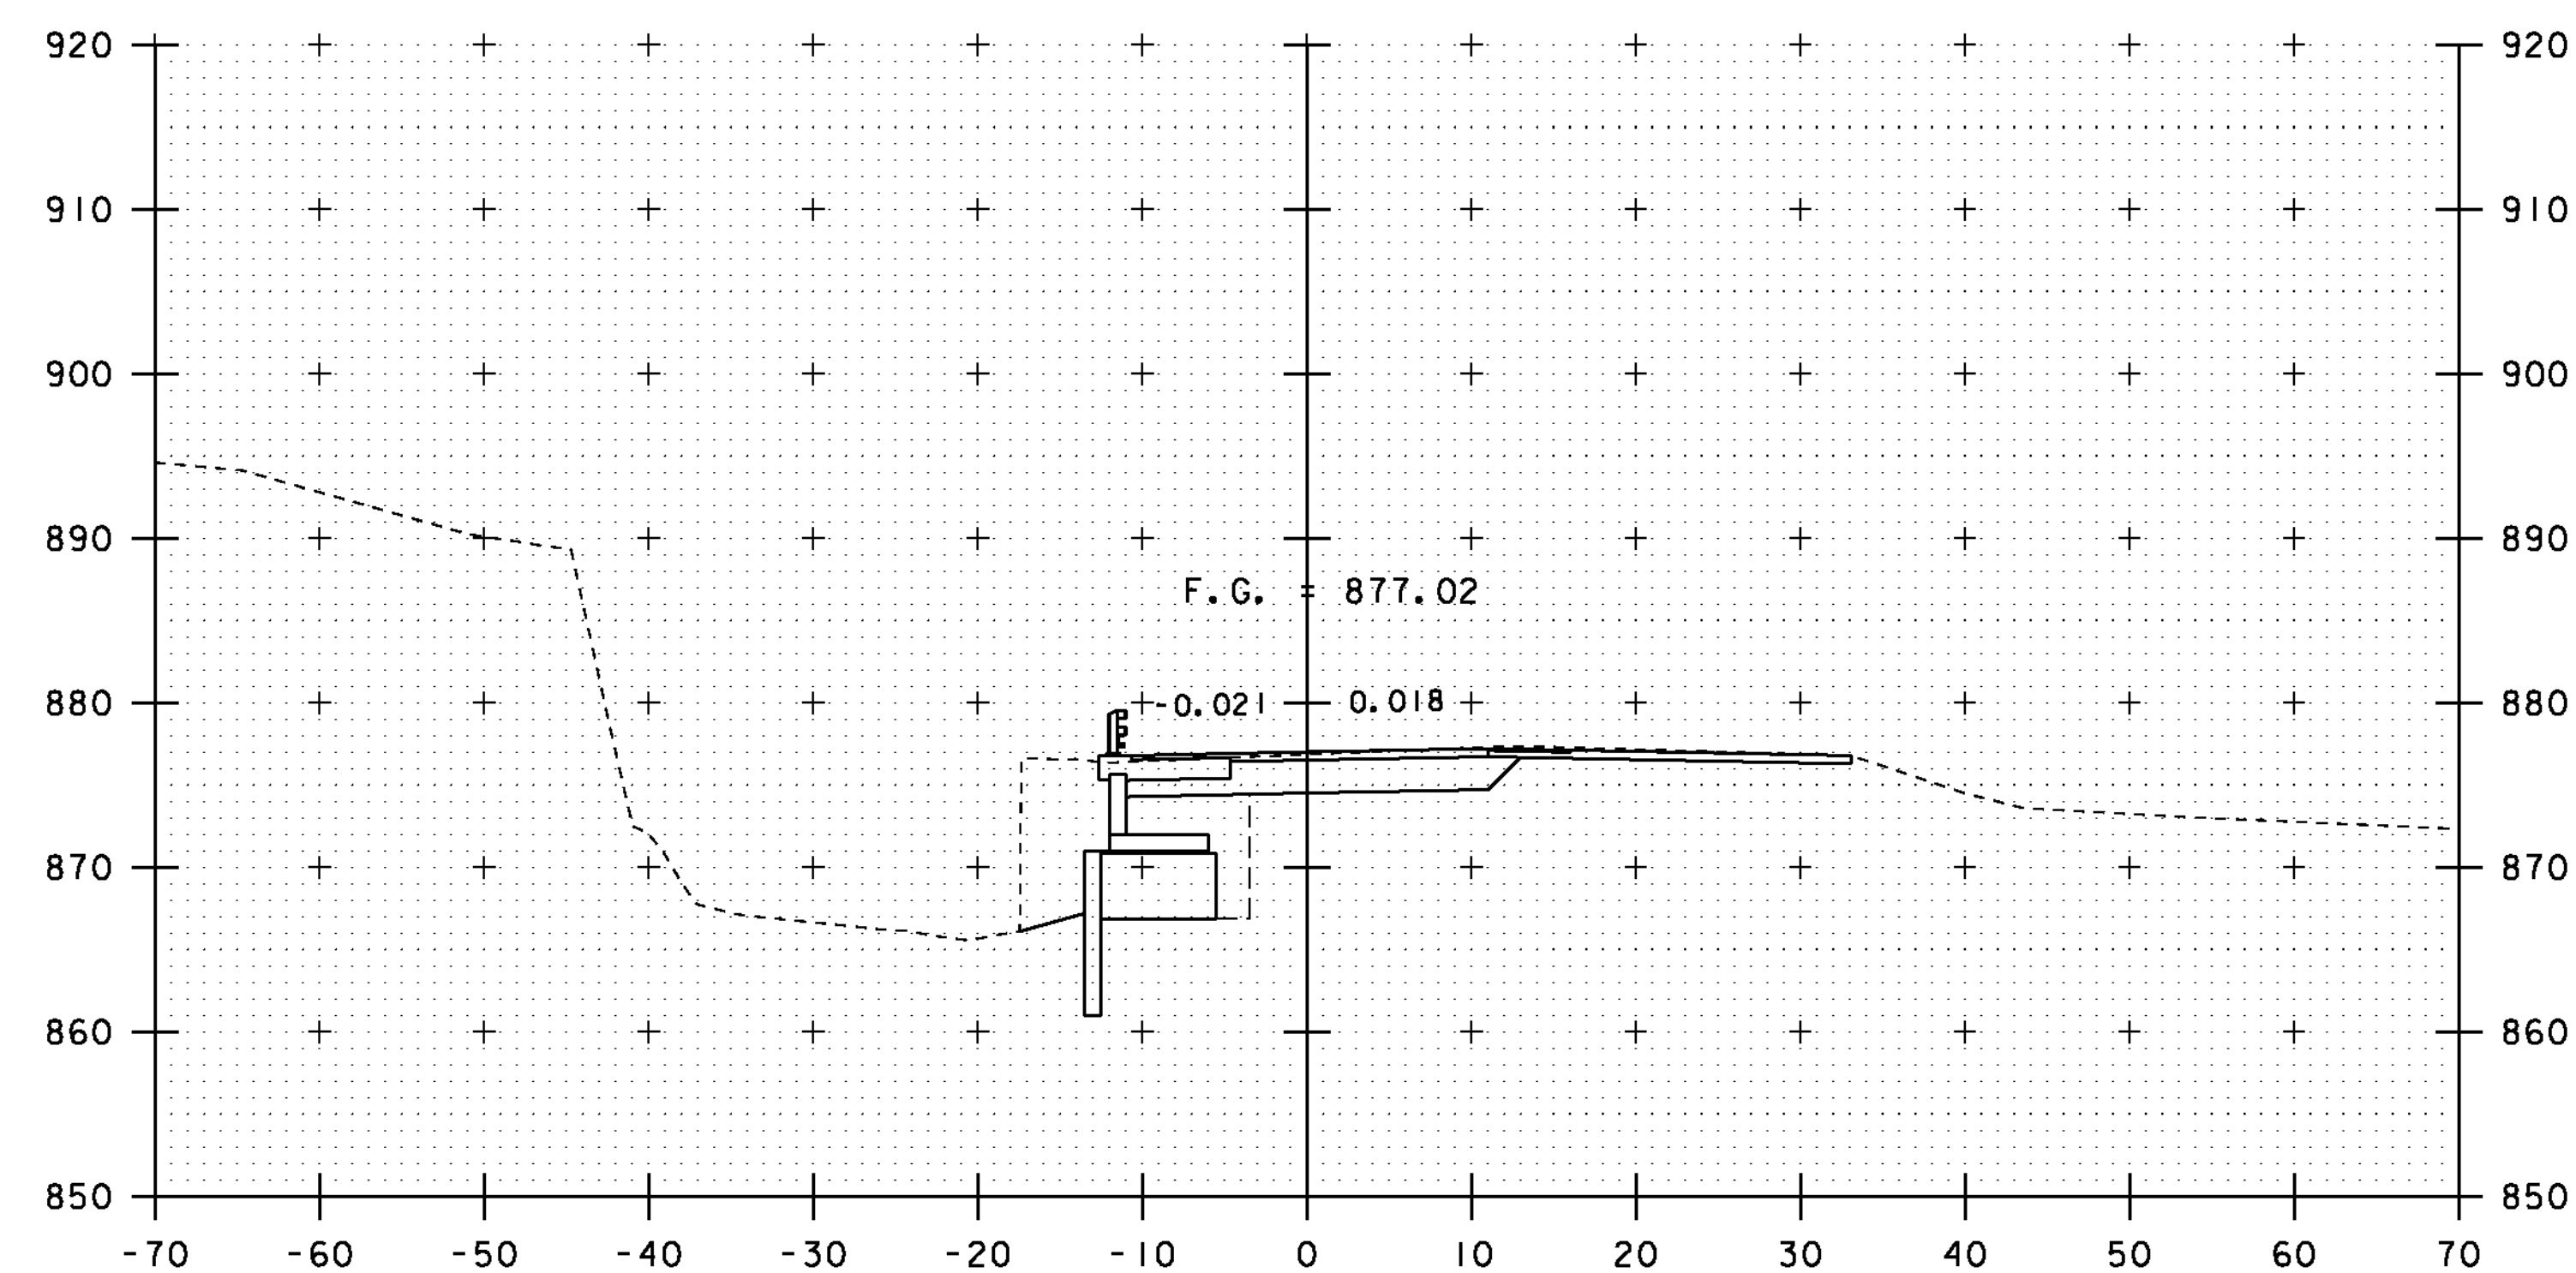
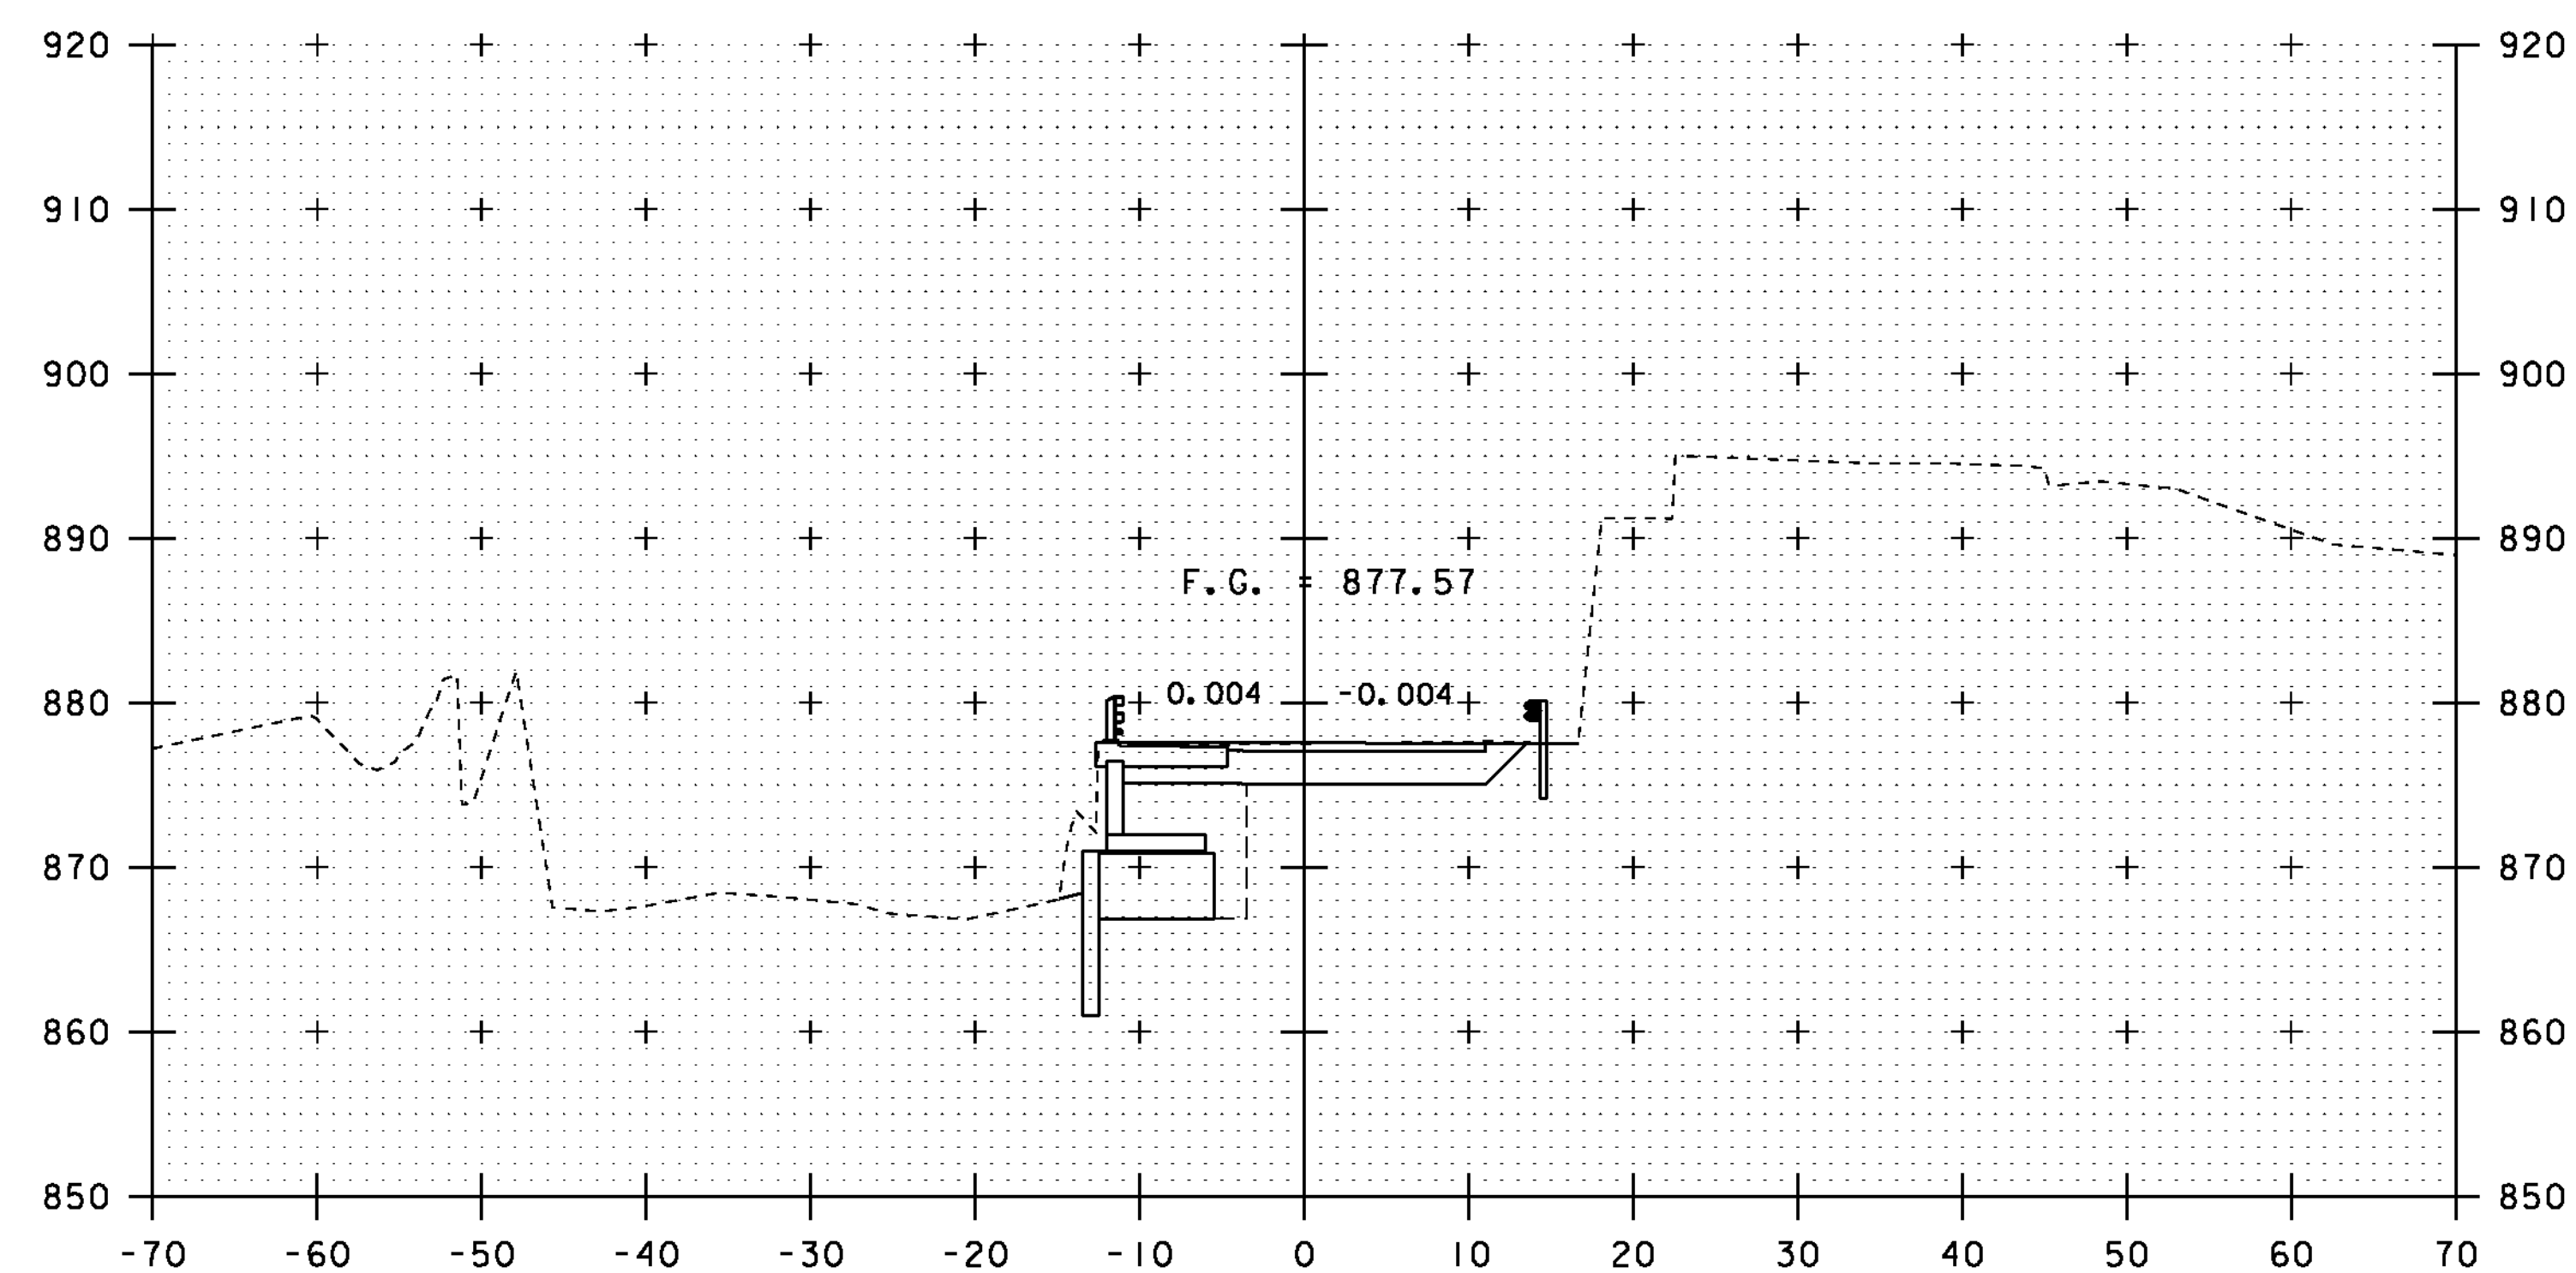
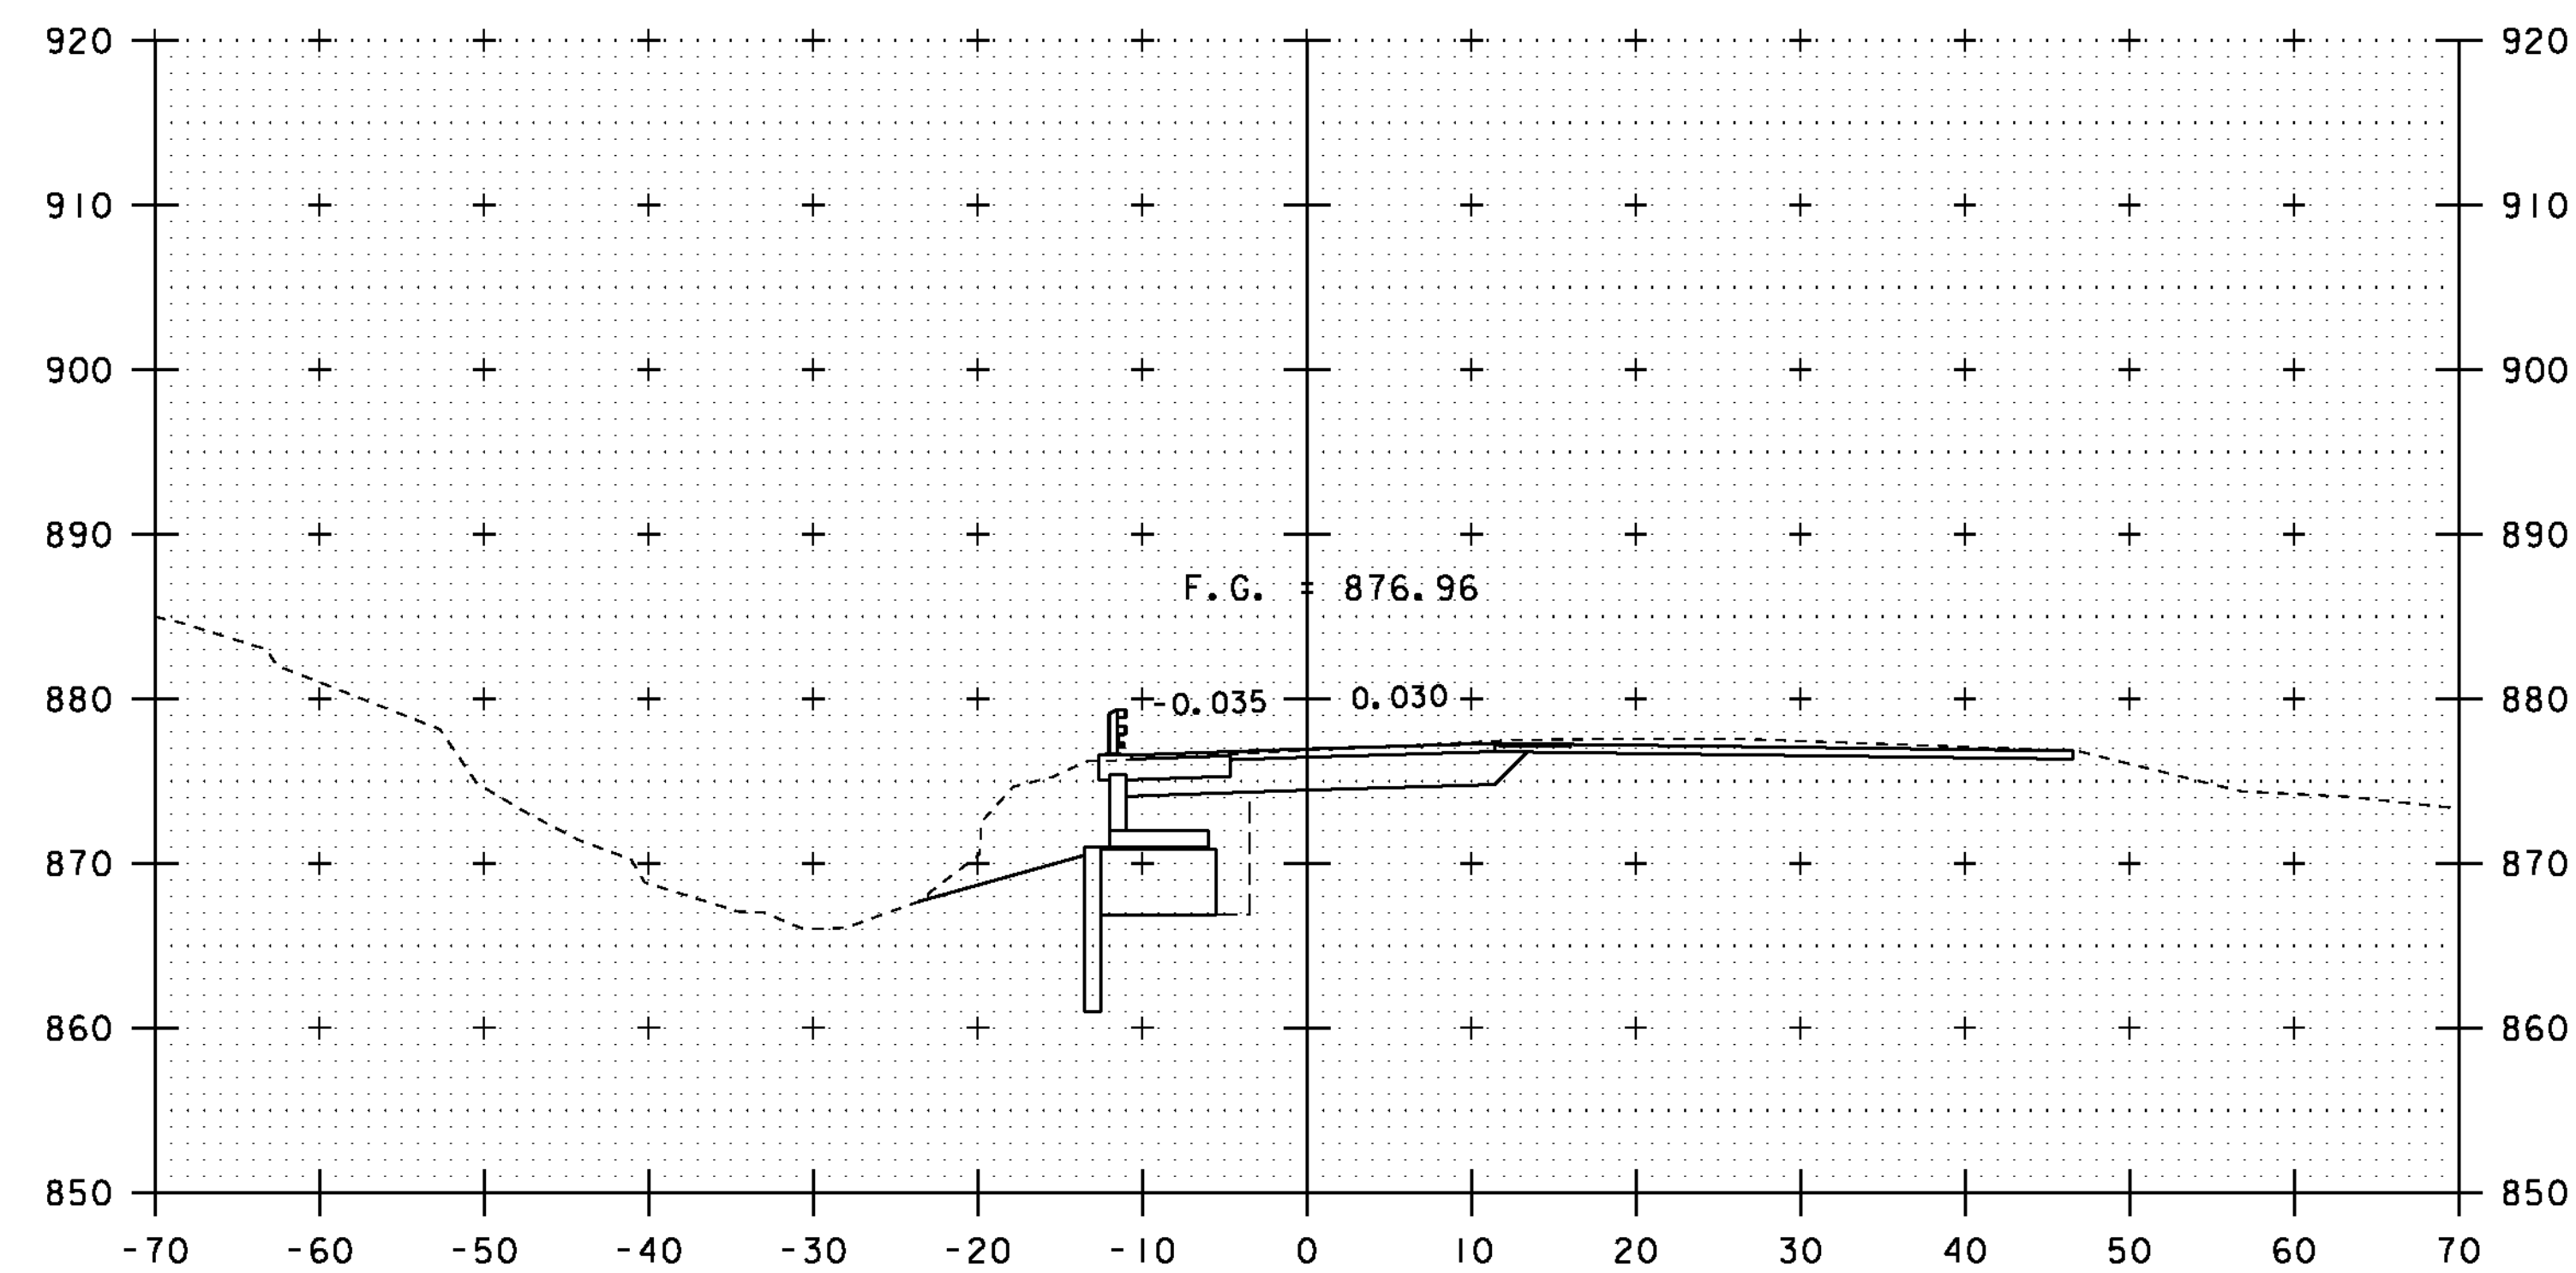


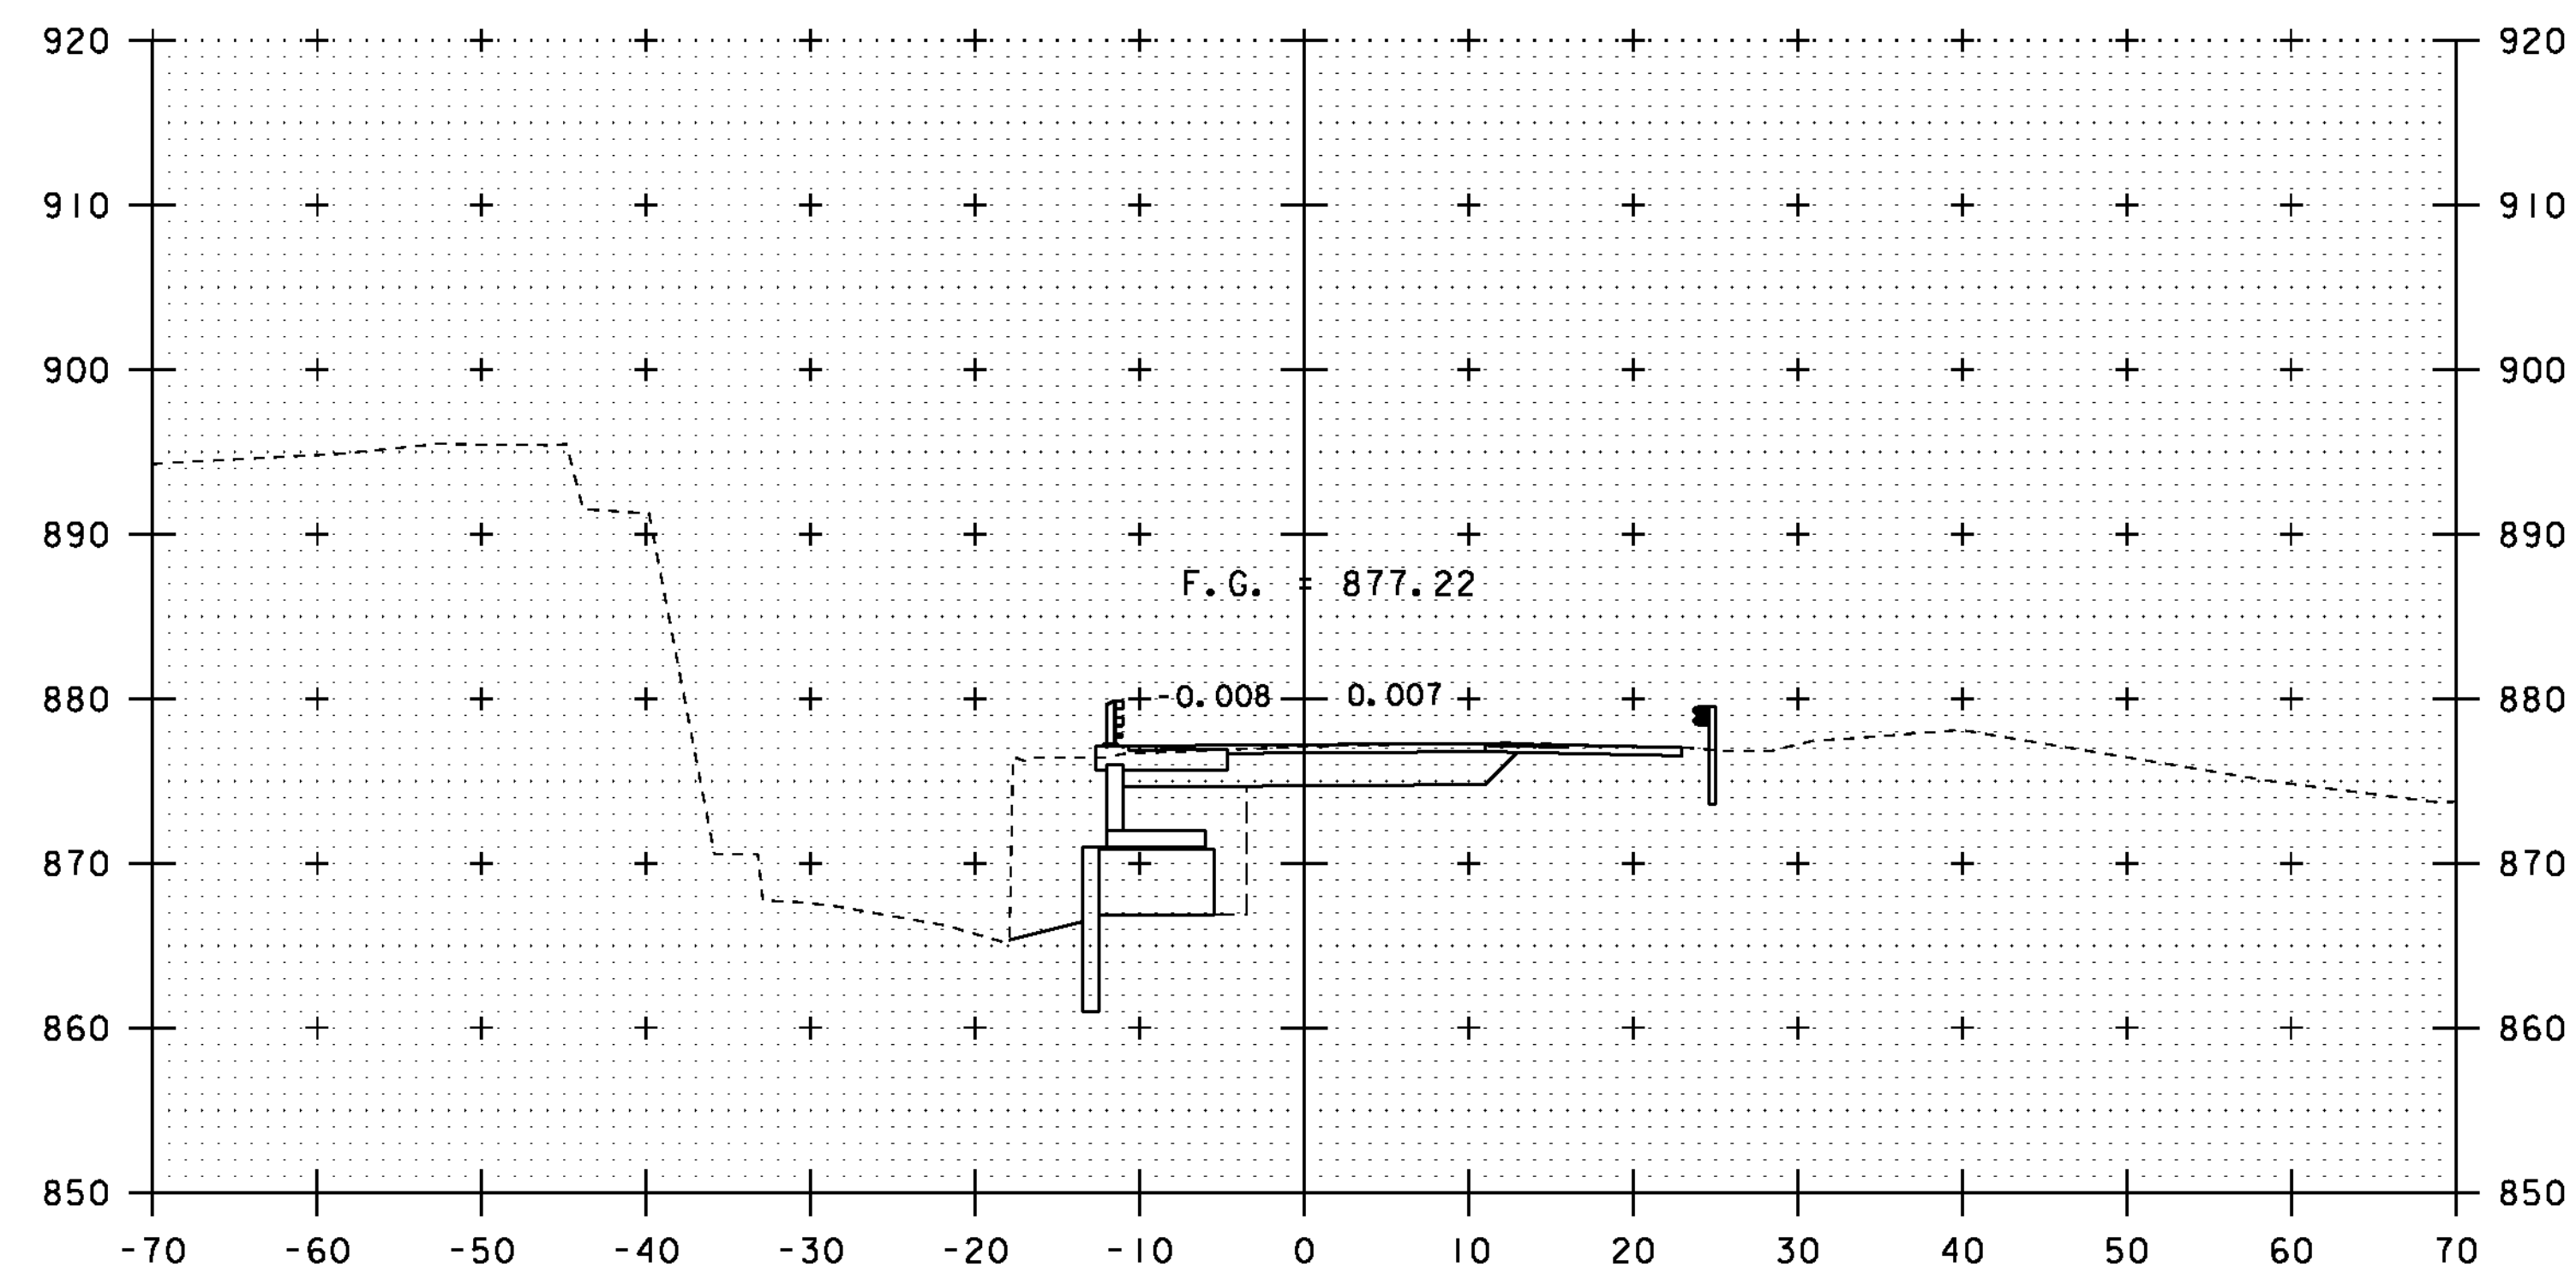

BEGIN PERMANENT STEEL SHEET PILING
STA 4+90.0 LT

STA. 5+00 TO STA. 5+75

PROJECT NAME: ROXBURY	
PROJECT NUMBER: BHF 0187(8)	
FILE NAME: sl0c420xsl.dgn	PLOT DATE: 21-SEP-2011
PROJECT LEADER: C. P. WILLIAMS	DRAWN BY: G. ROY
DESIGNED BY: G. ROY	CHECKED BY: T. FILLBACH
VT 12A CROSS SECTIONS (4)	SHEET 35 OF 54