



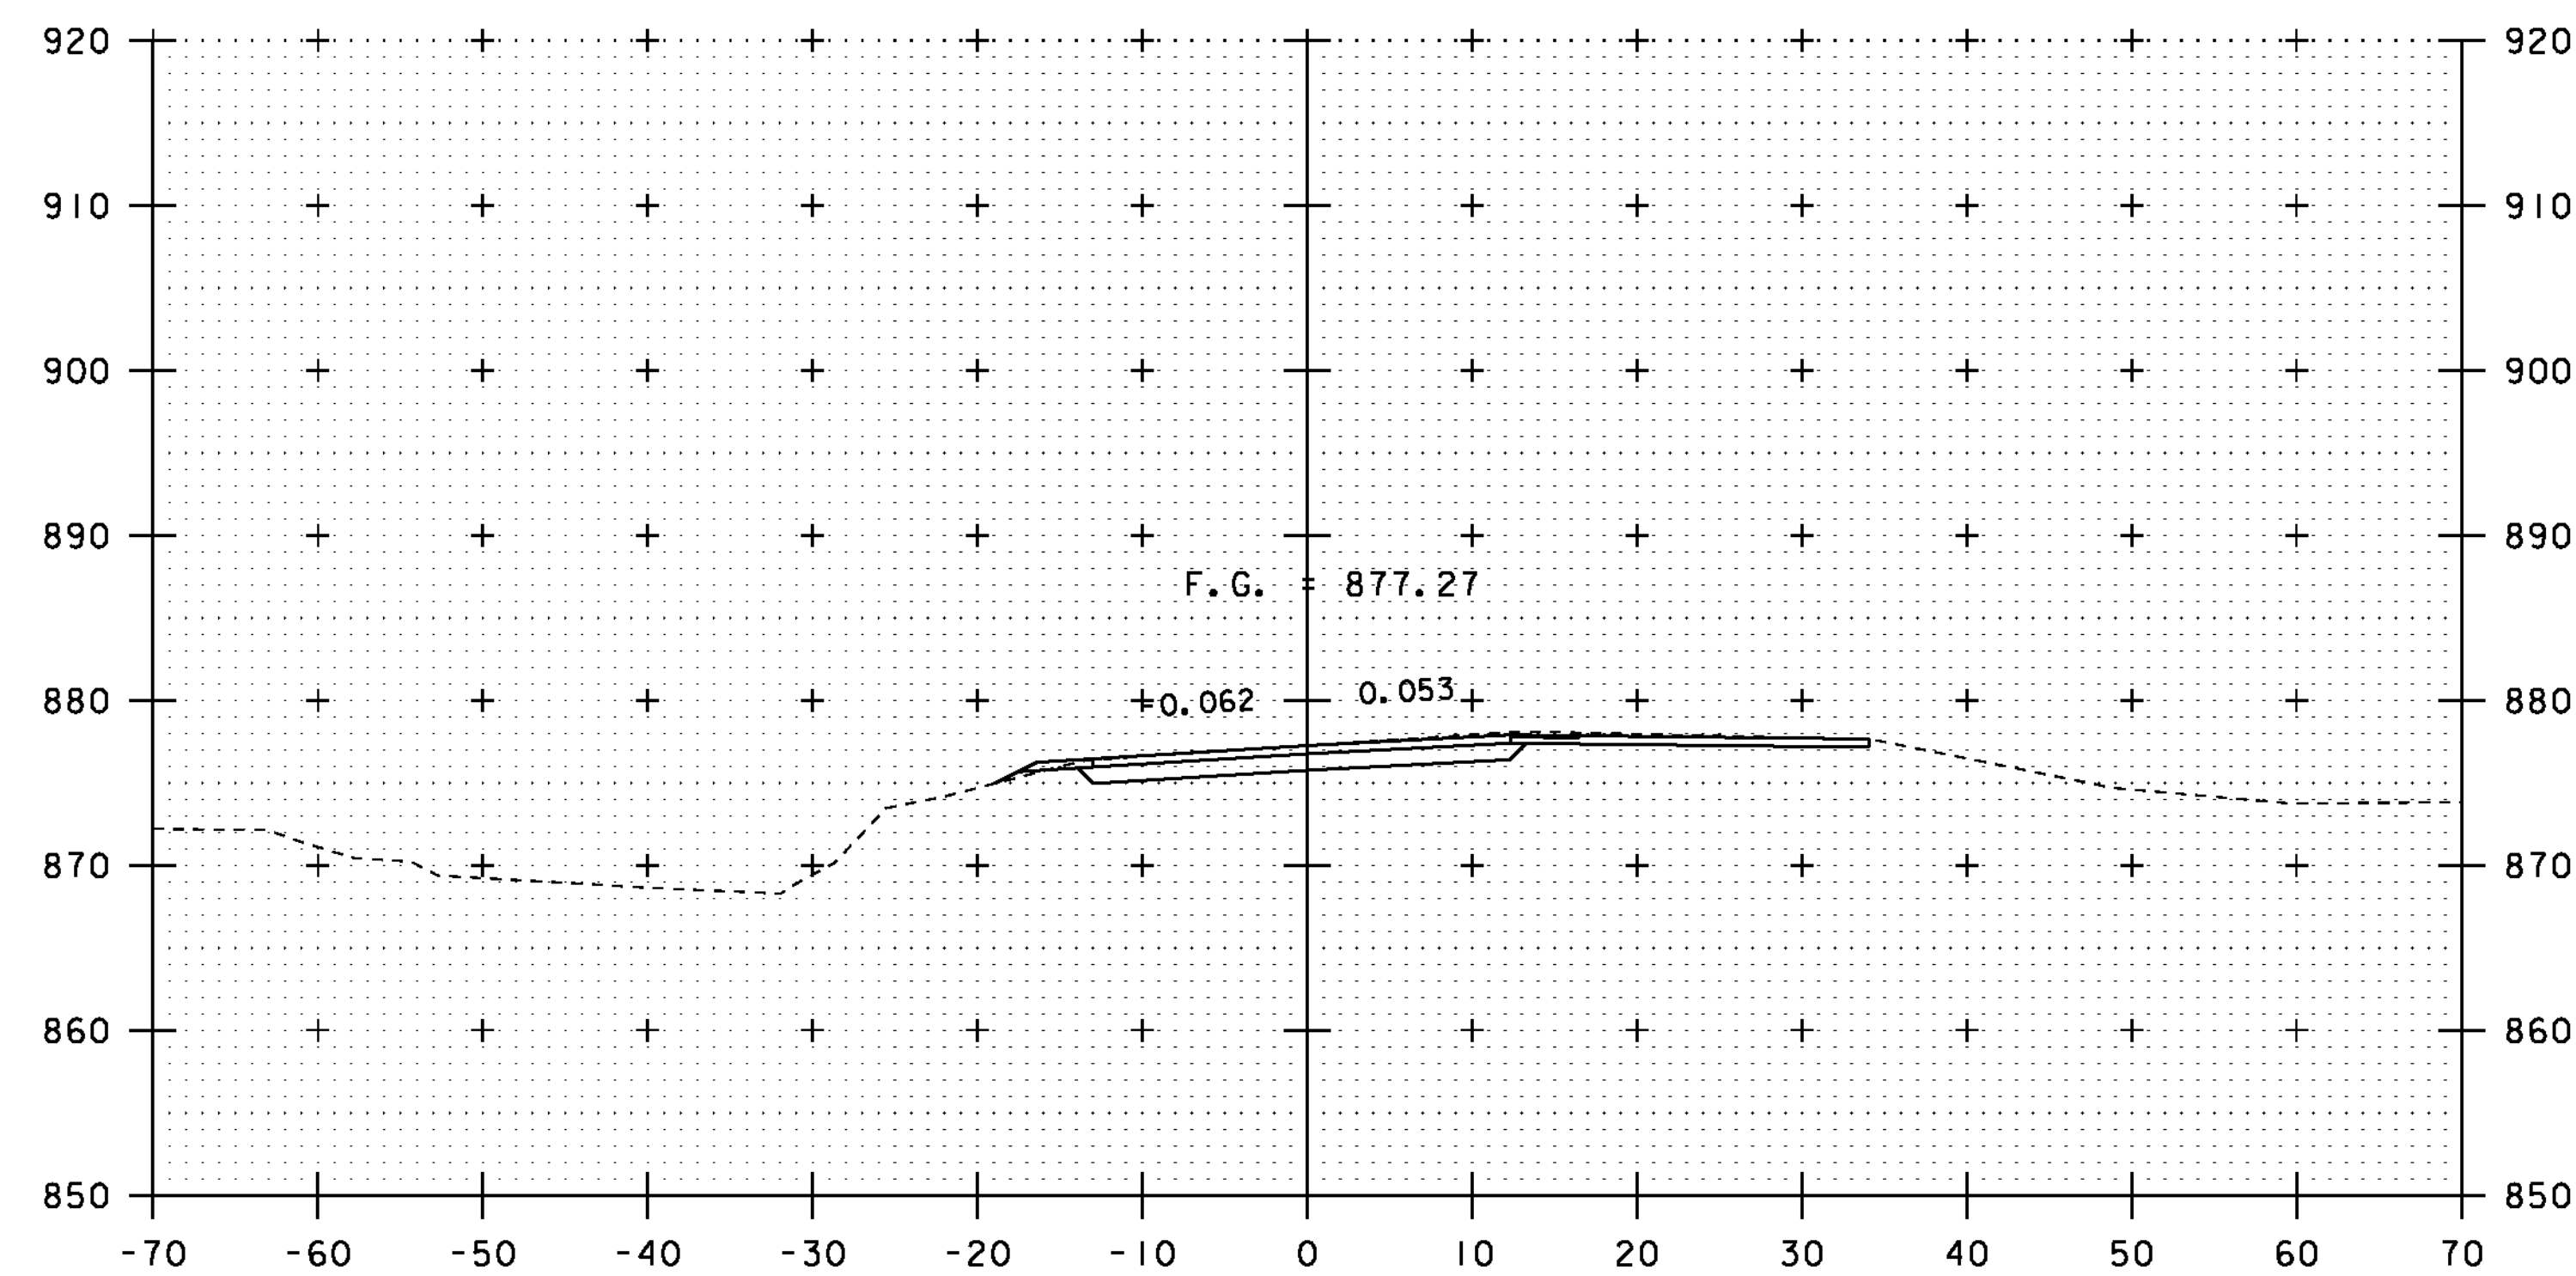


6+25

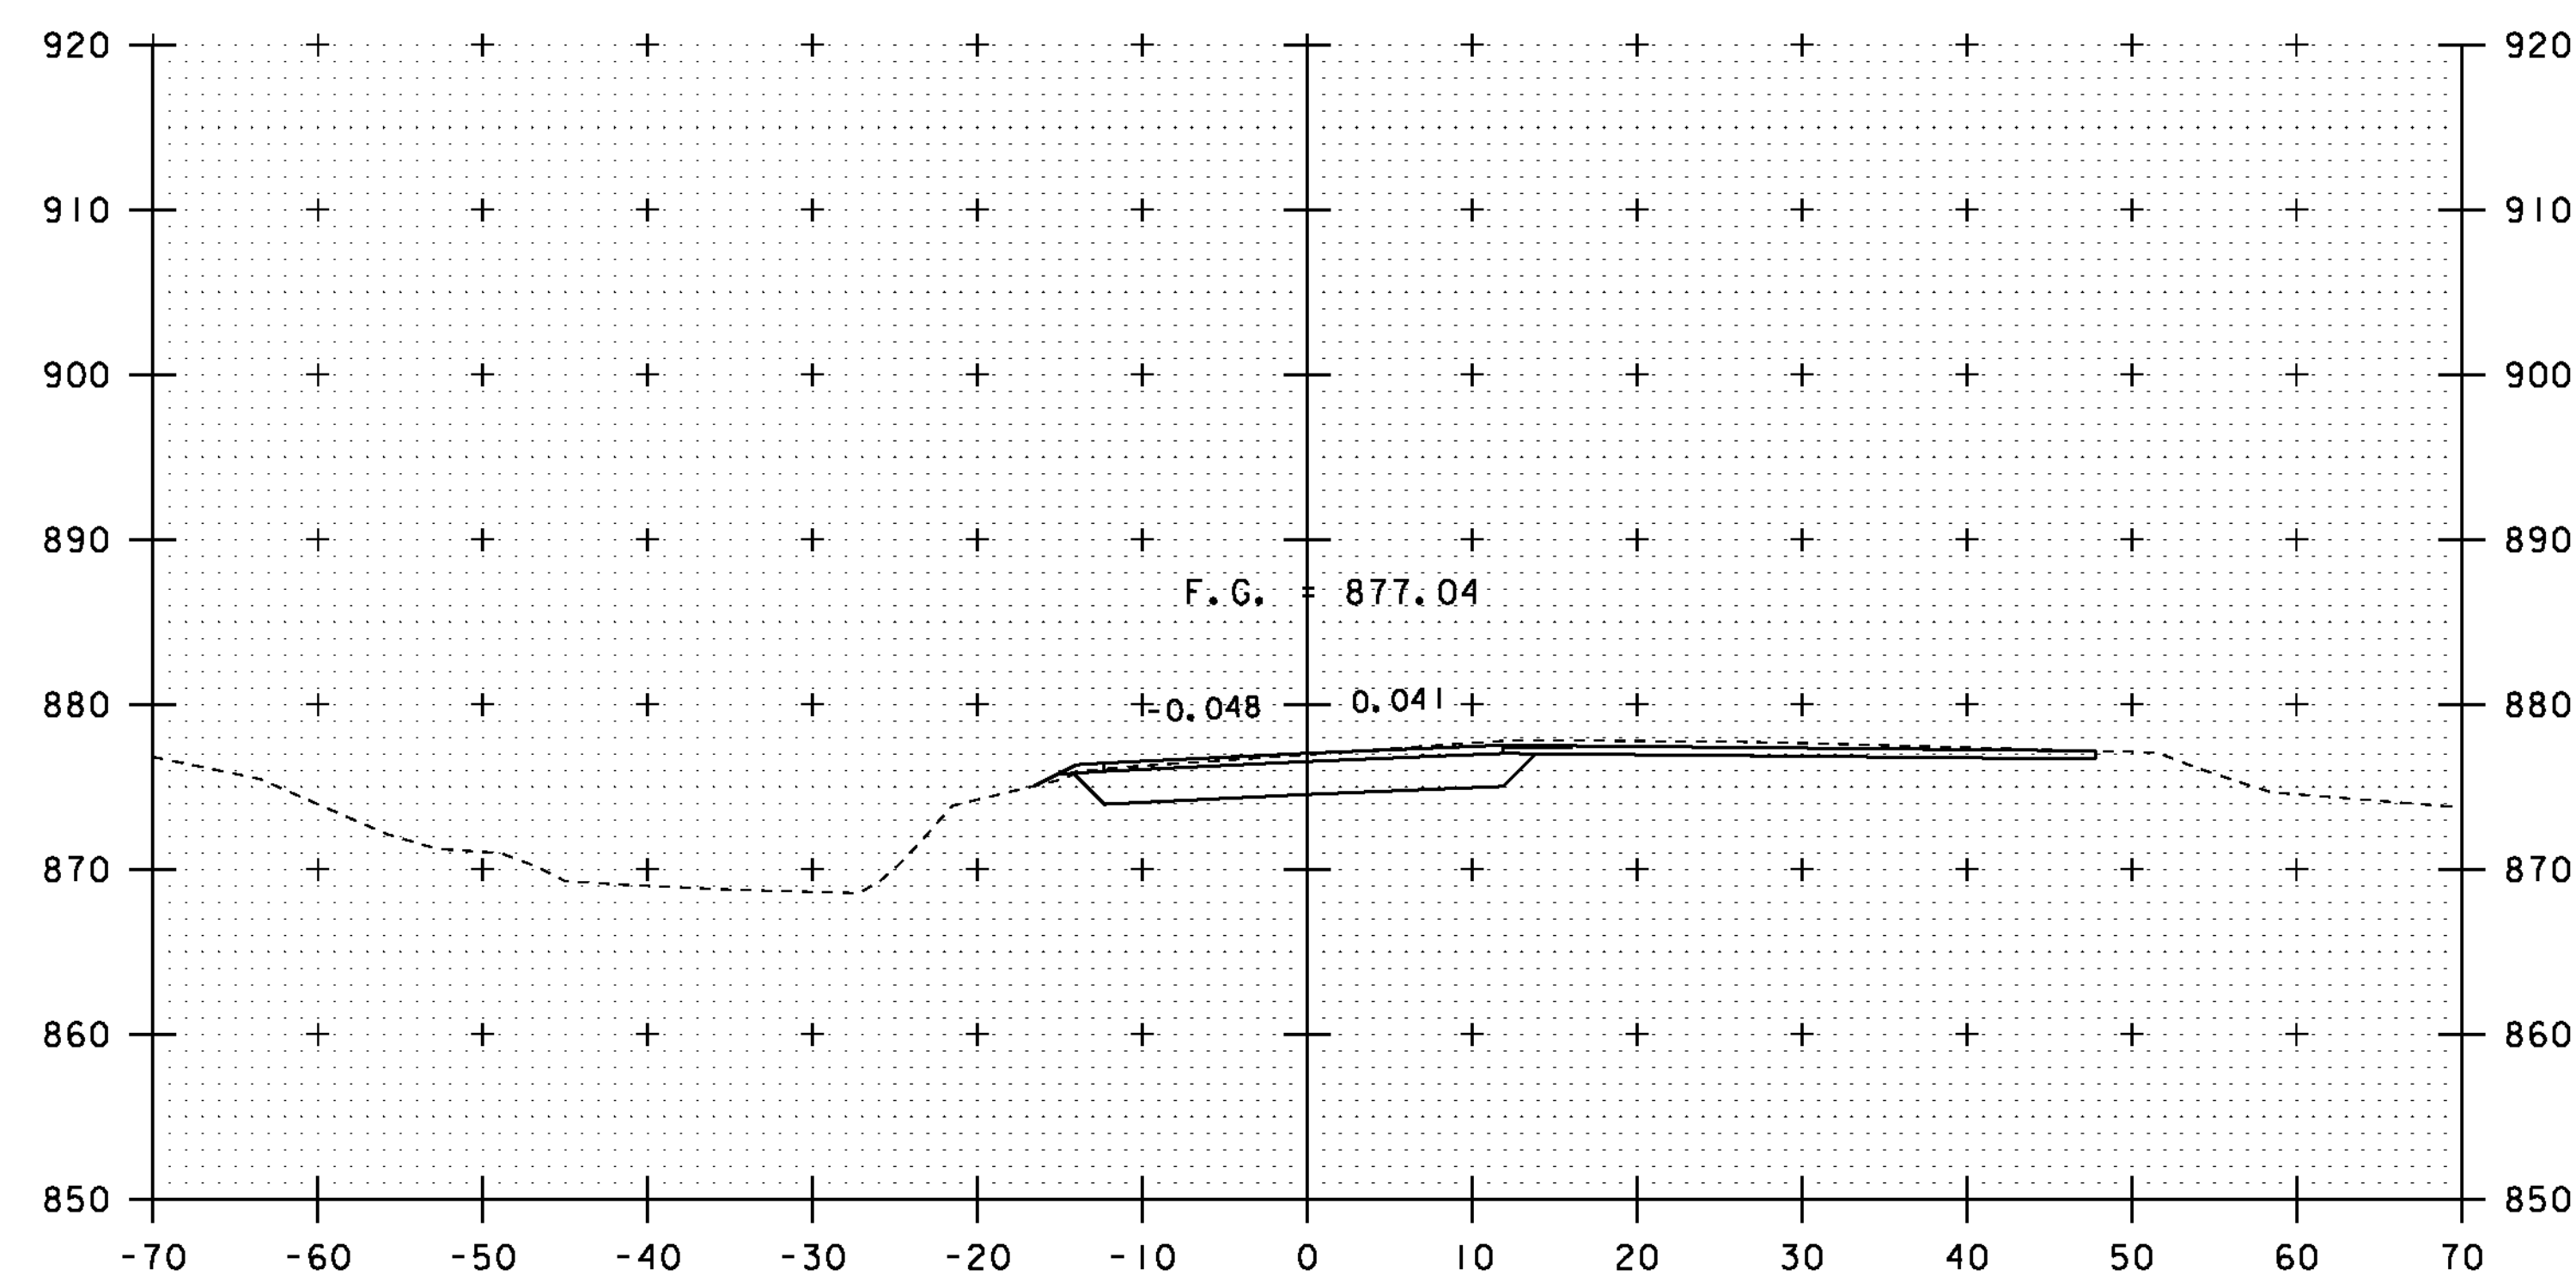


6+00

END PRECAST CONCRETE STRUCTURE (WINGWALL NO.3)
STA 5+99.30 LT
END PERMANENT STEEL SHEET PILING
STA 6+00.0 LT

END PROJECT
BEGIN APPROACH
STA 6+00.00

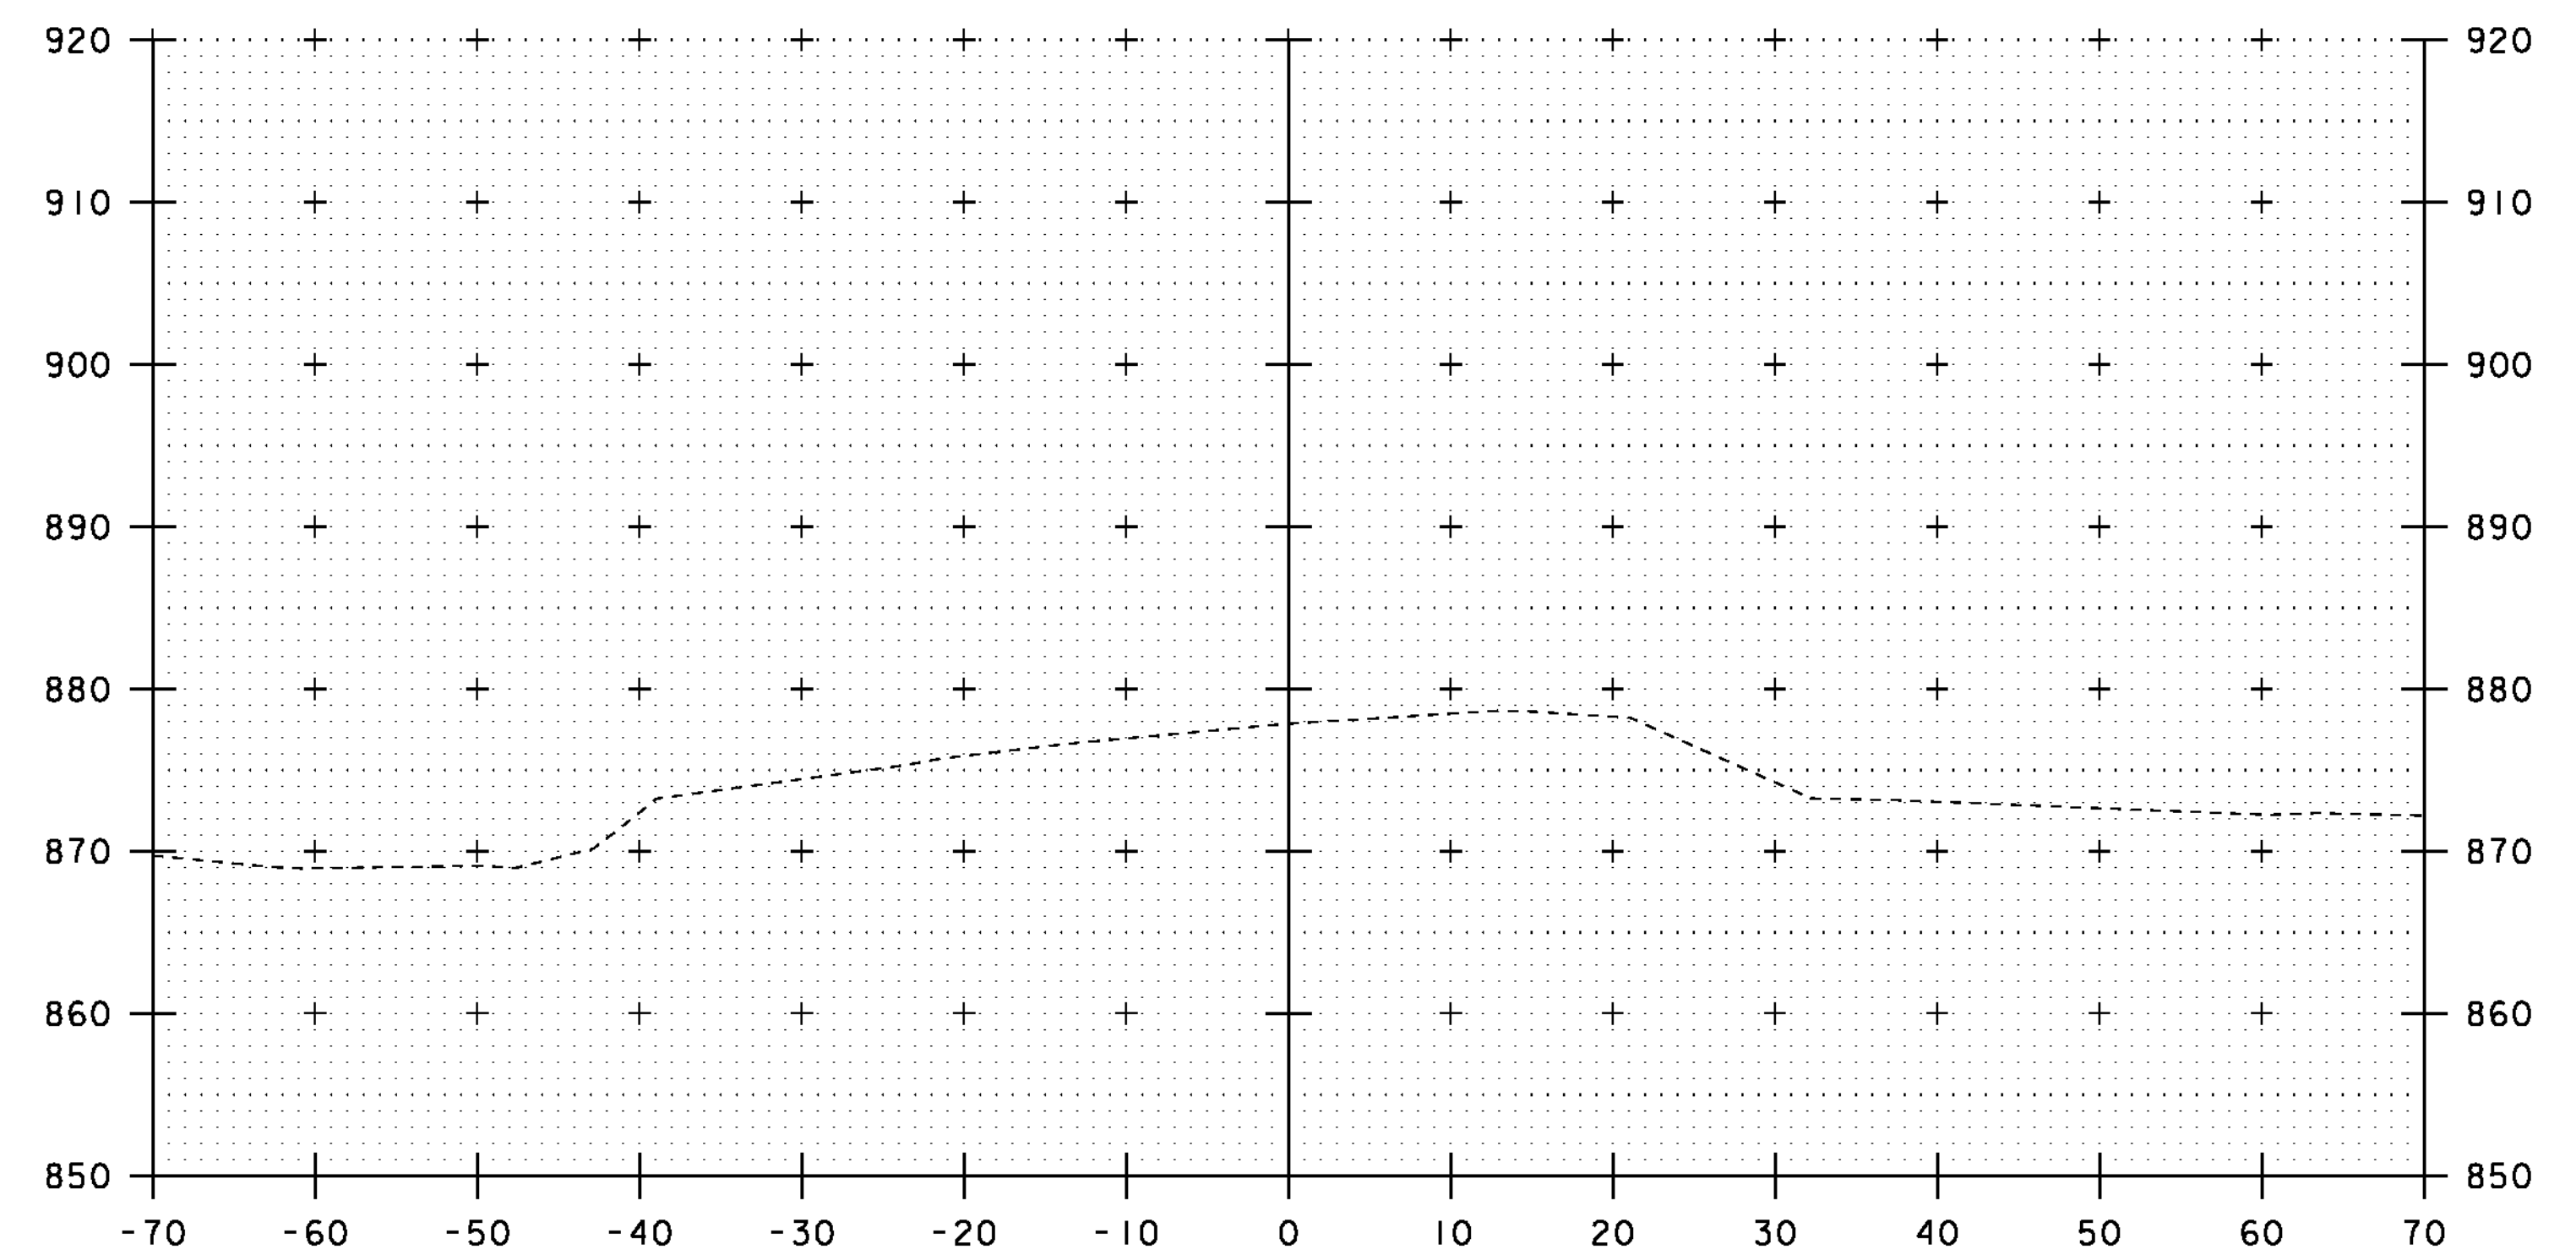

6+75

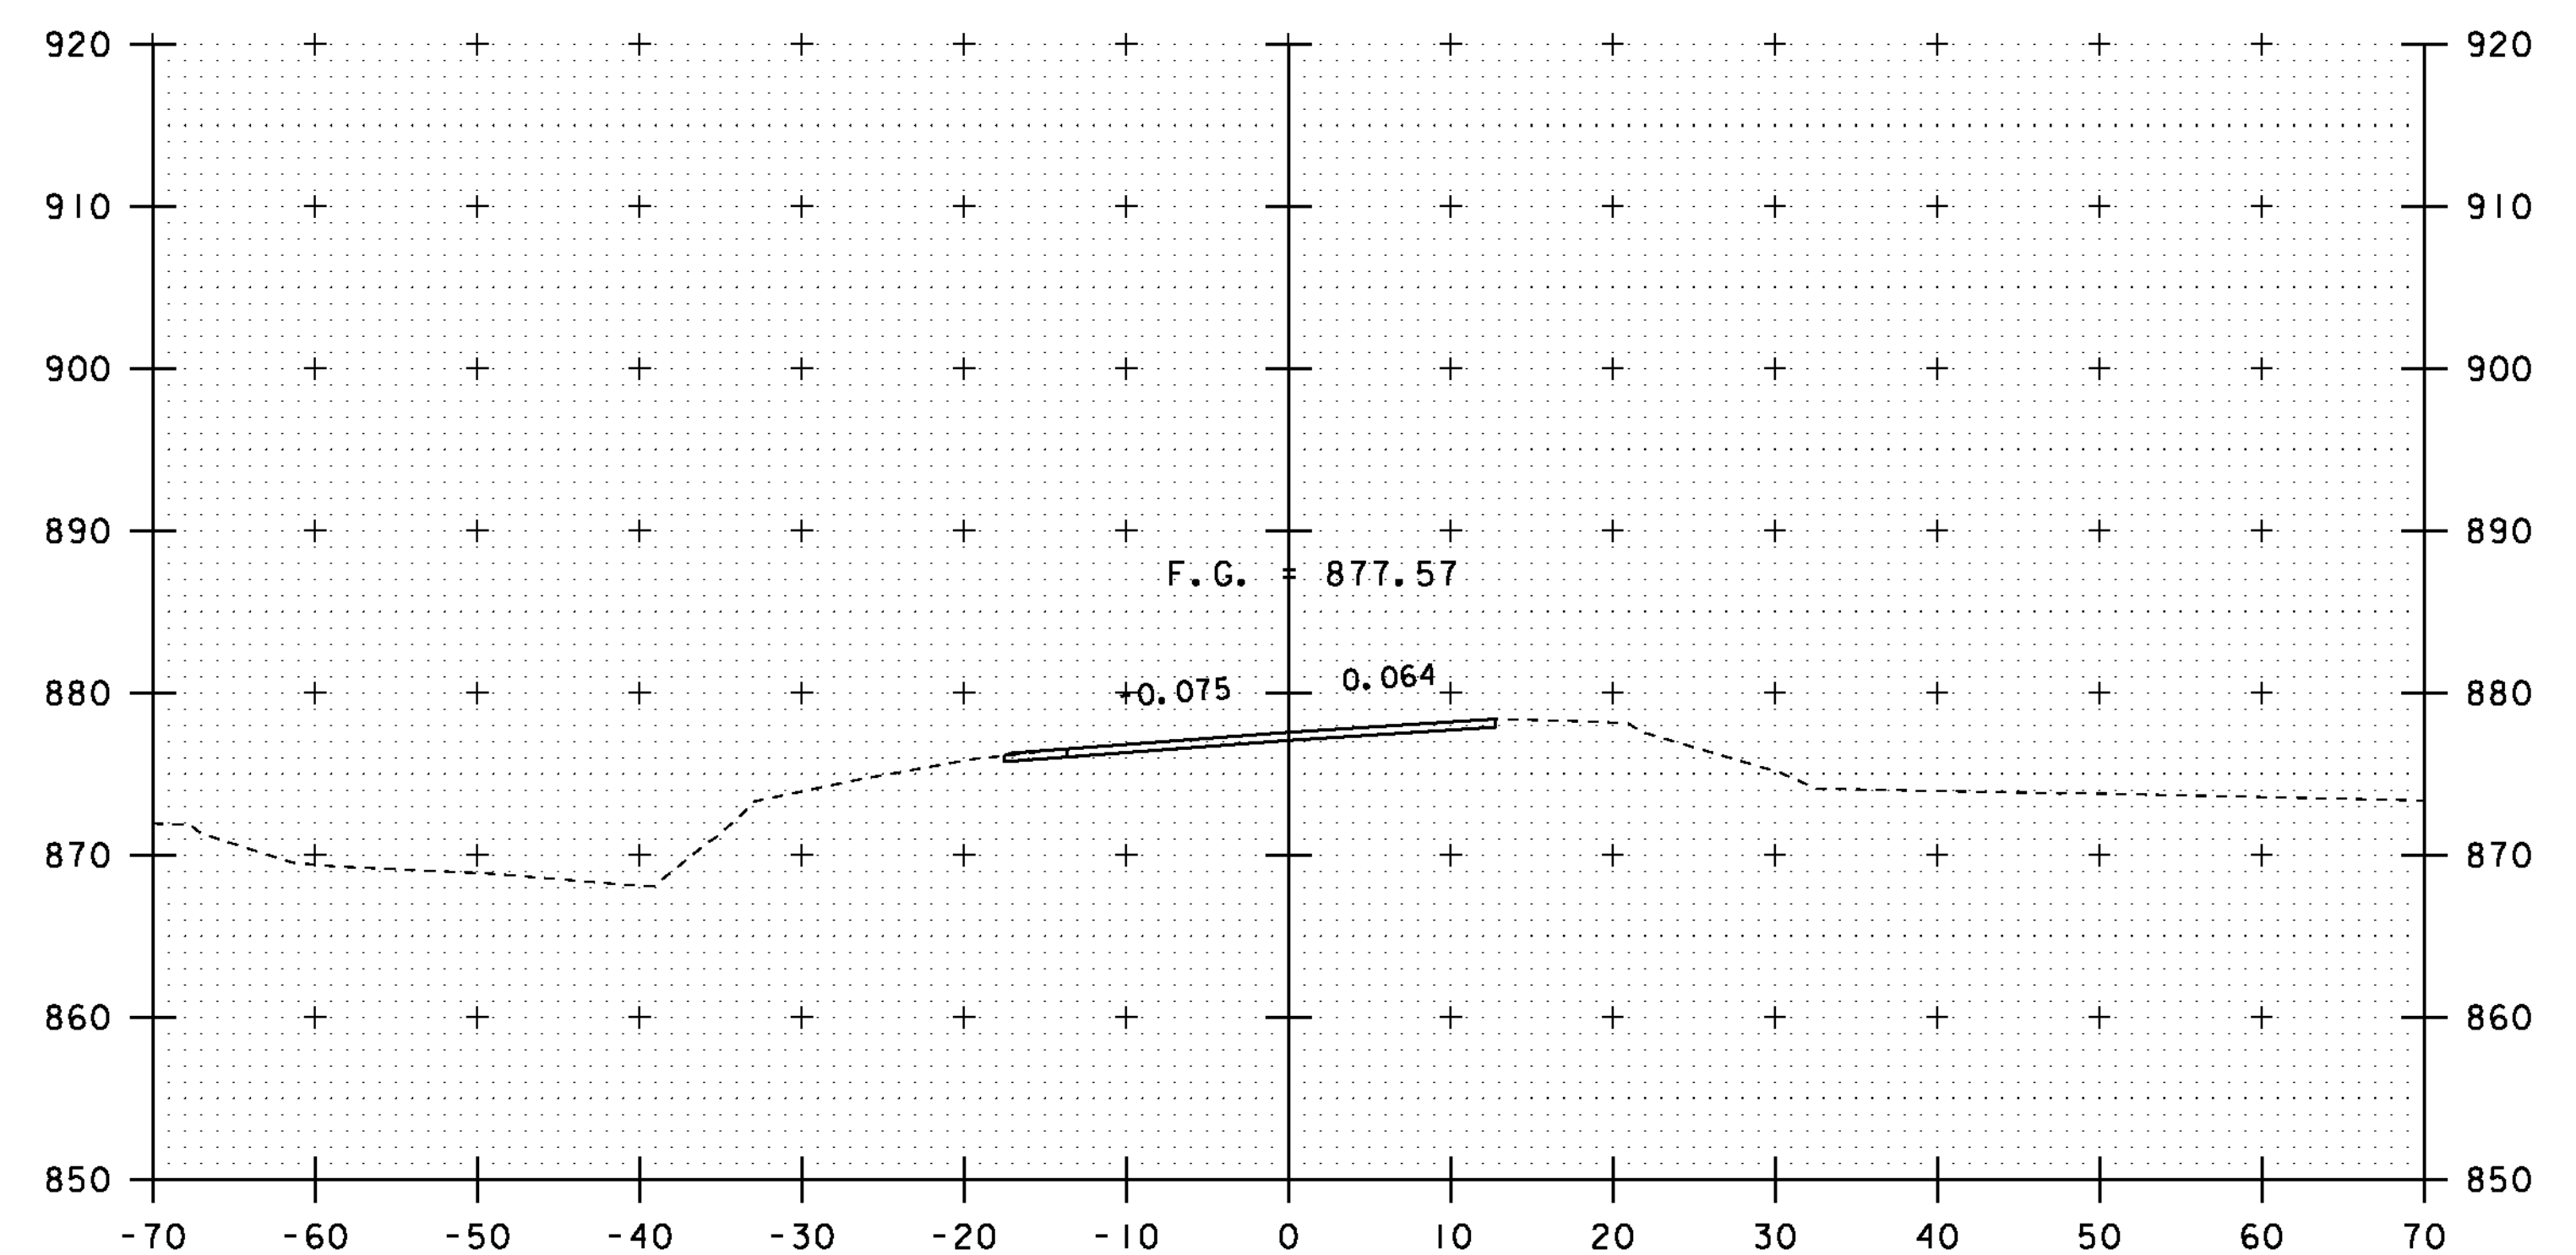

6+50

END APPROACH
MATCH EXISTING
STA 6+50.00

STA. 6+00 TO STA. 6+75

PROJECT NAME:	ROXBURY
PROJECT NUMBER:	BHF 0187(8)
FILE NAME:	sl0c420xsl.dgn
PROJECT LEADER:	C. P. WILLIAMS
DESIGNED BY:	G. ROY
VT 12A CROSS SECTIONS (5)	
PLOT DATE:	21-SEP-2011
DRAWN BY:	G. ROY
CHECKED BY:	T. FILLBACH
SHEET	36 OF 54