




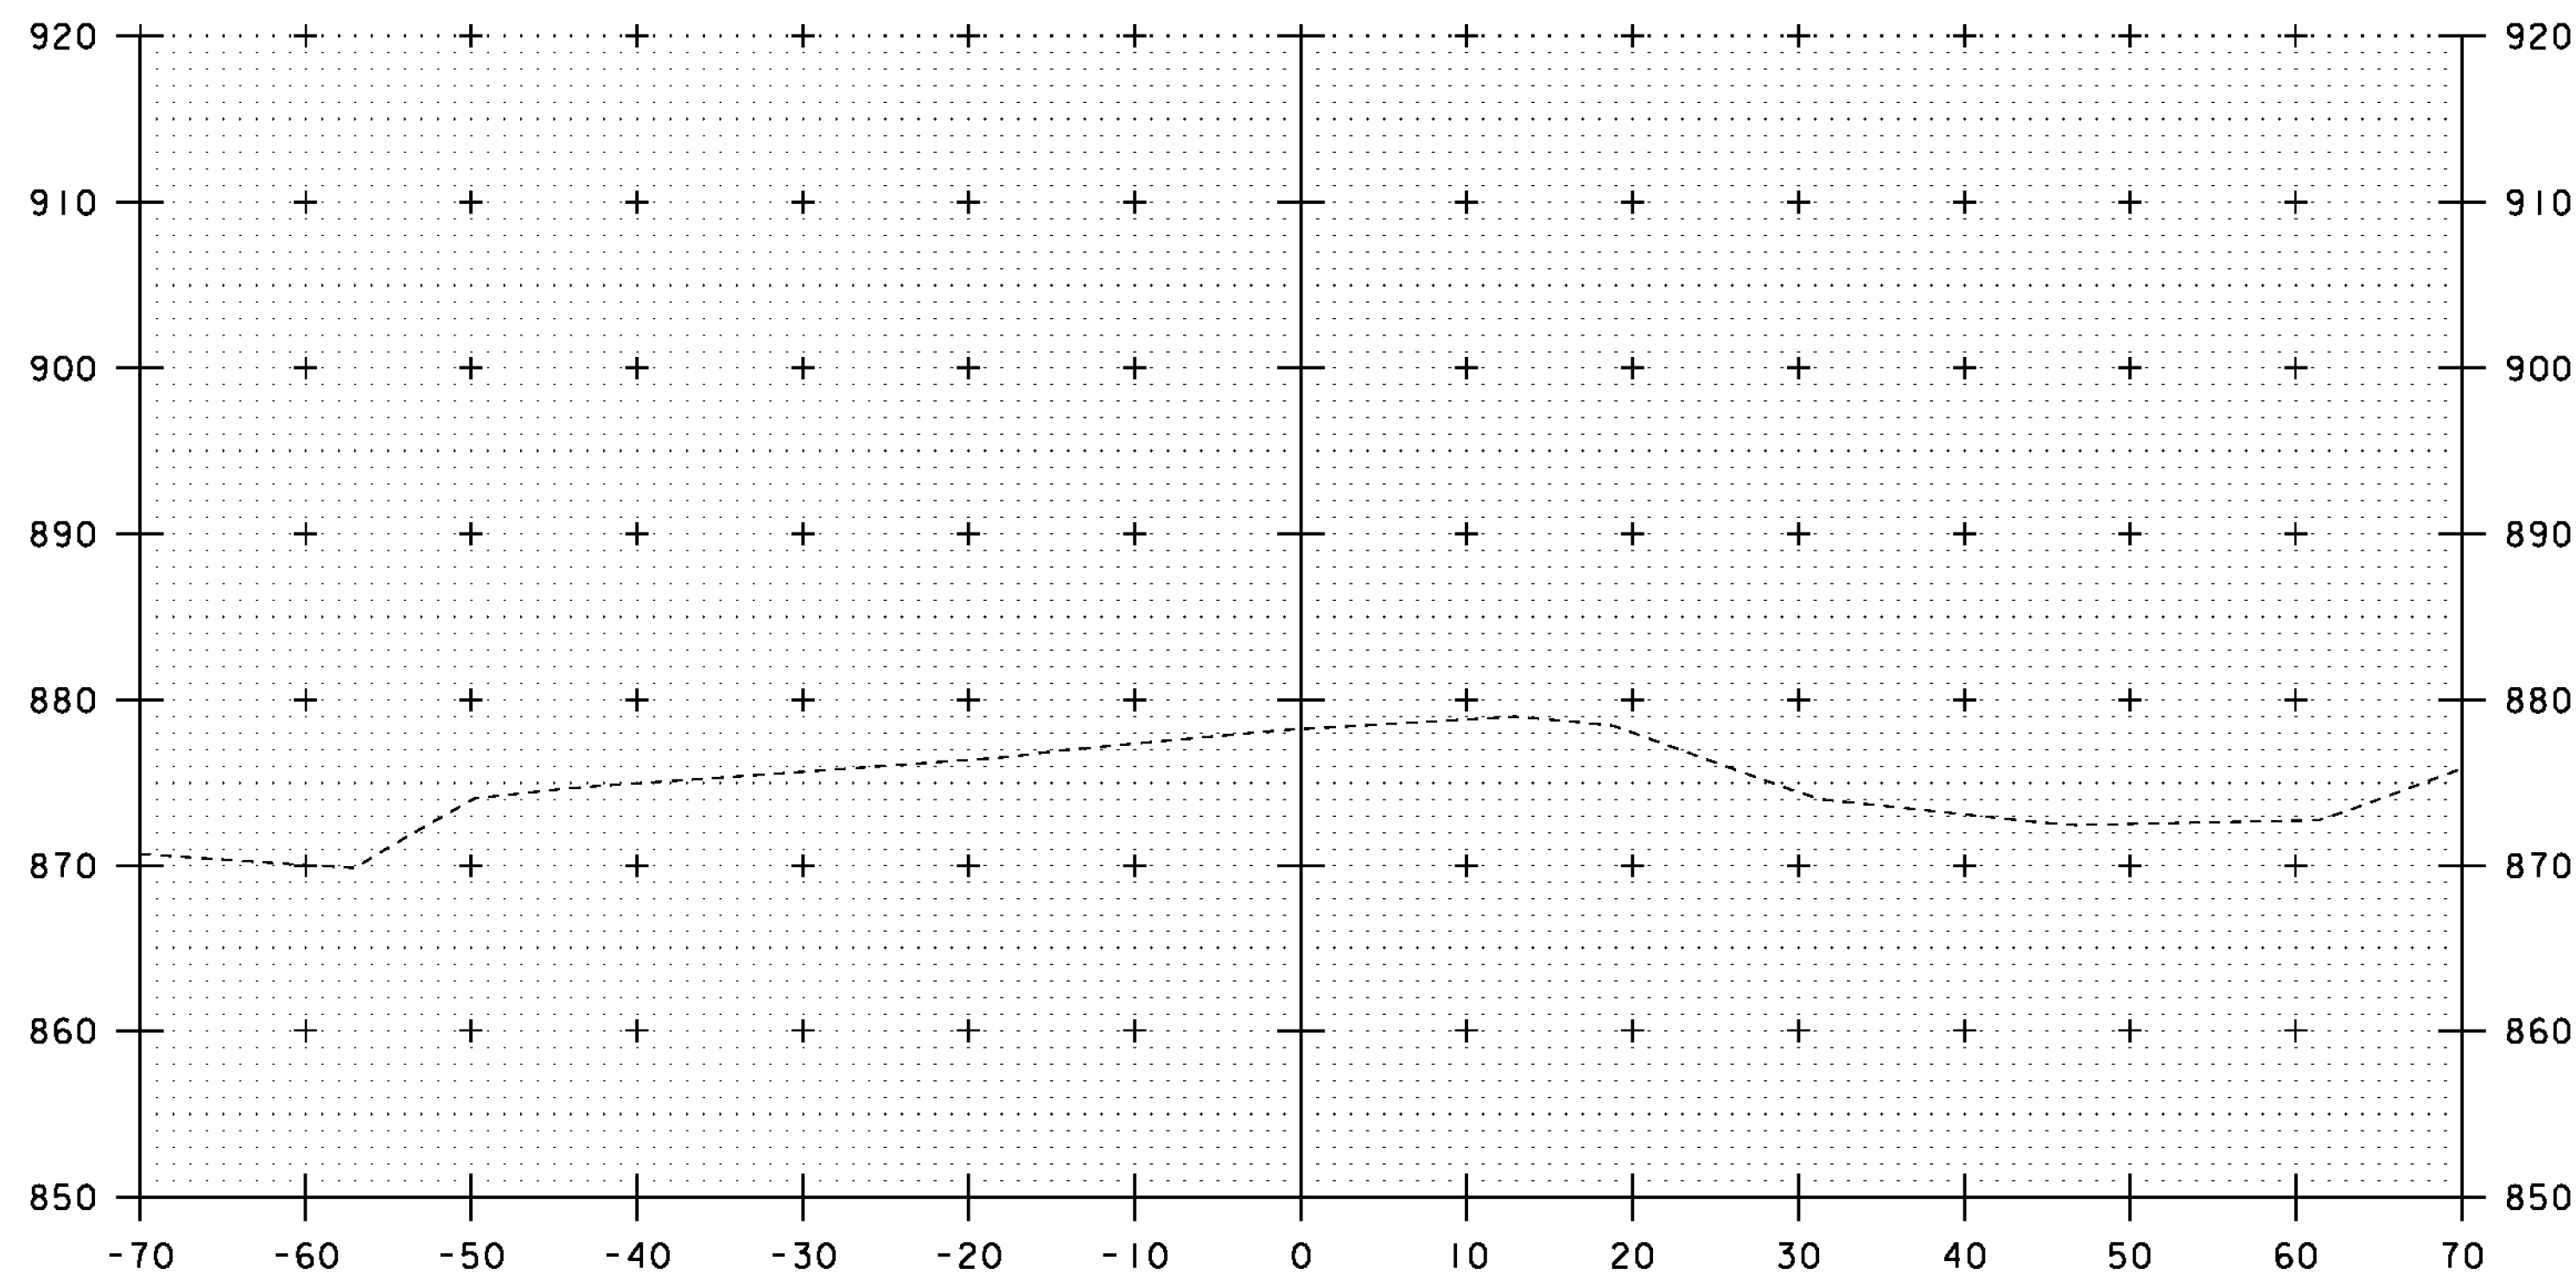

7+25

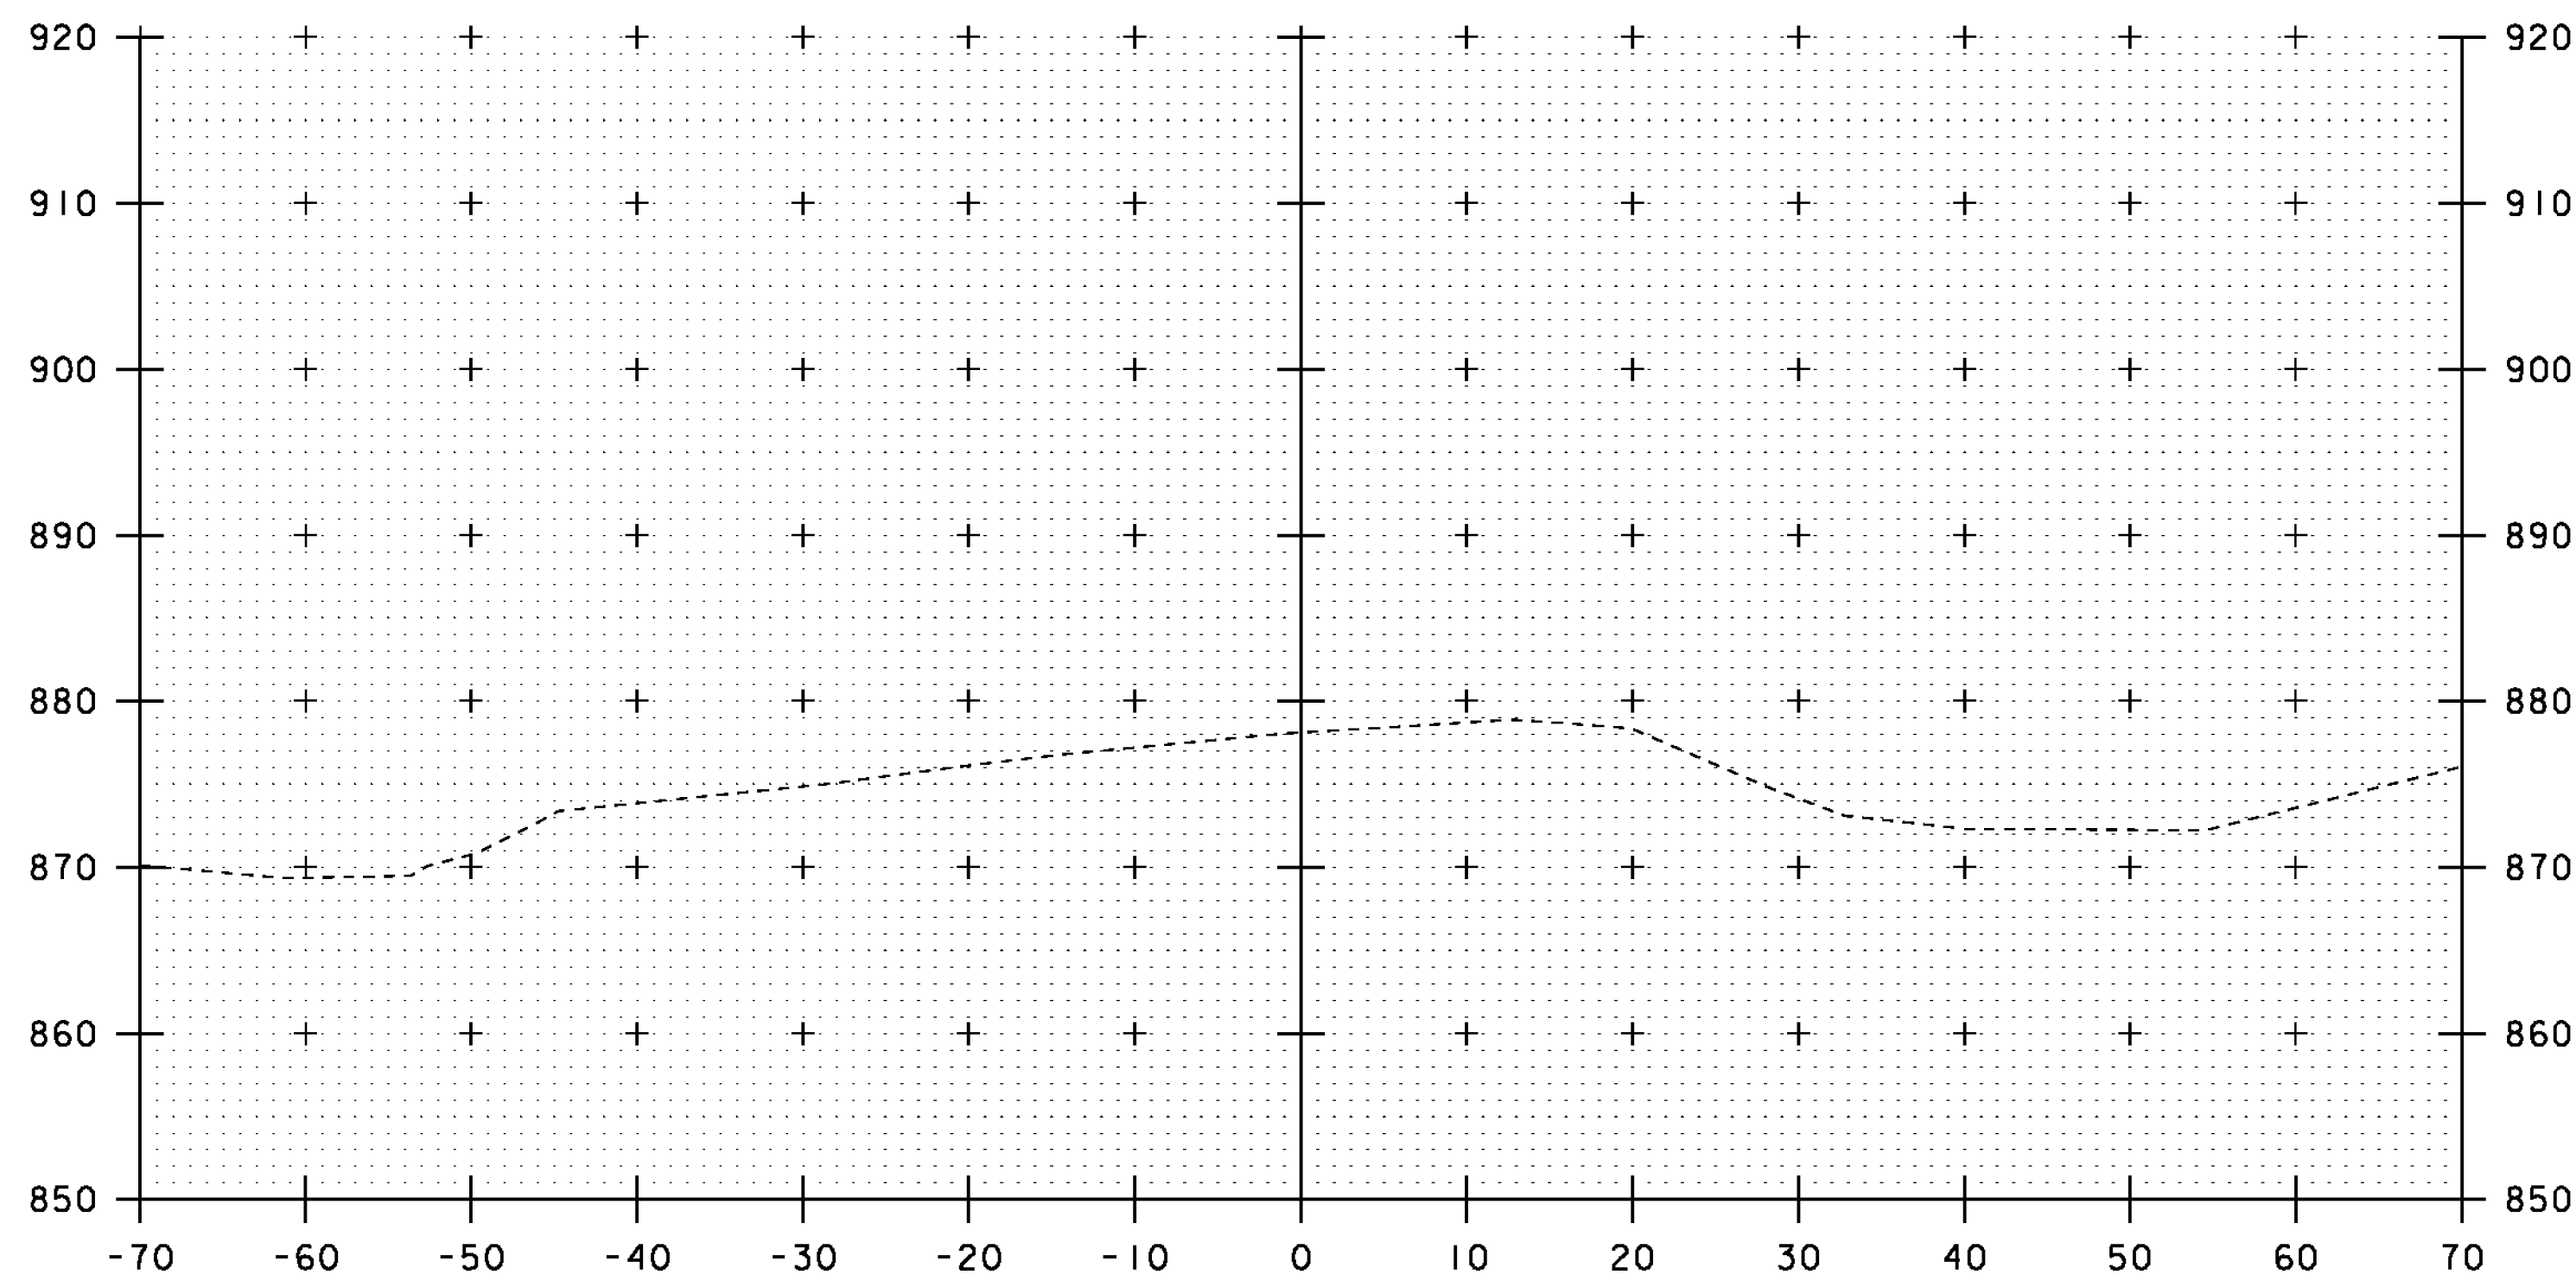

7+00

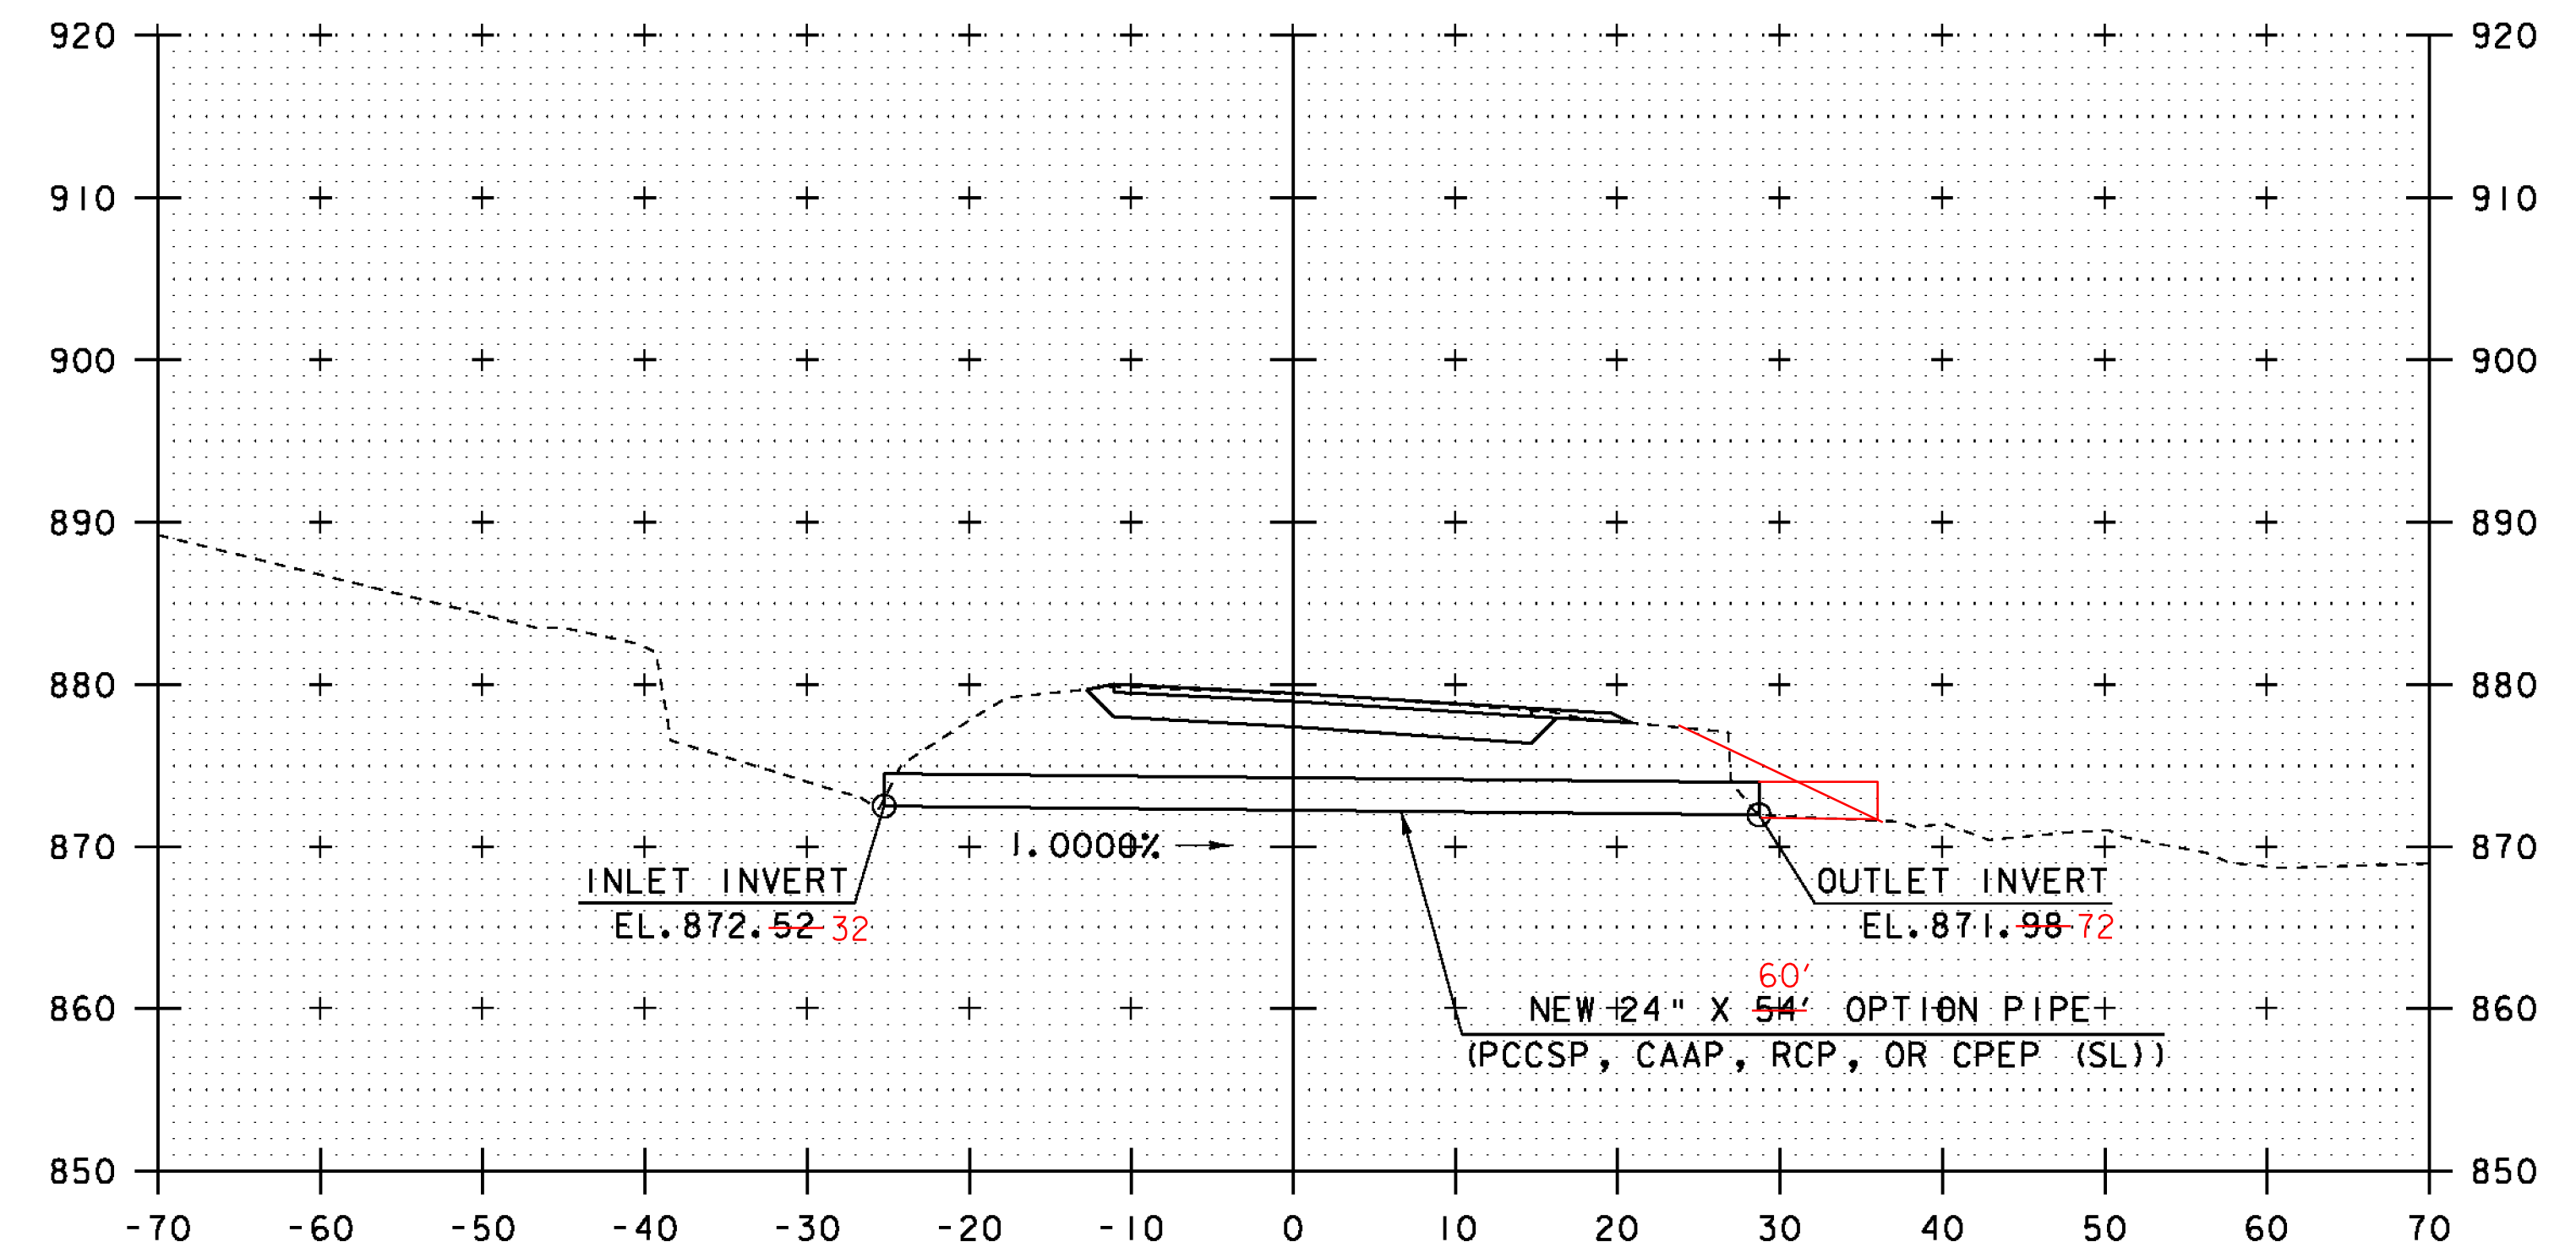

2+89.2 , SKEW 7° 48' LT

PROJECT NAME: ROXBURY	
PROJECT NUMBER: BHF 0187(8)	
FILE NAME: sl0c420xsl.dgn	PLOT DATE: 21-SEP-2011
PROJECT LEADER: C. P. WILLIAMS	DRAWN BY: G. ROY
DESIGNED BY: G. ROY	CHECKED BY: T. FILLBACH
VT I2A CROSS SECTIONS (6)	SHEET 37 OF 54

STA. 7+00 TO STA. 7+25