




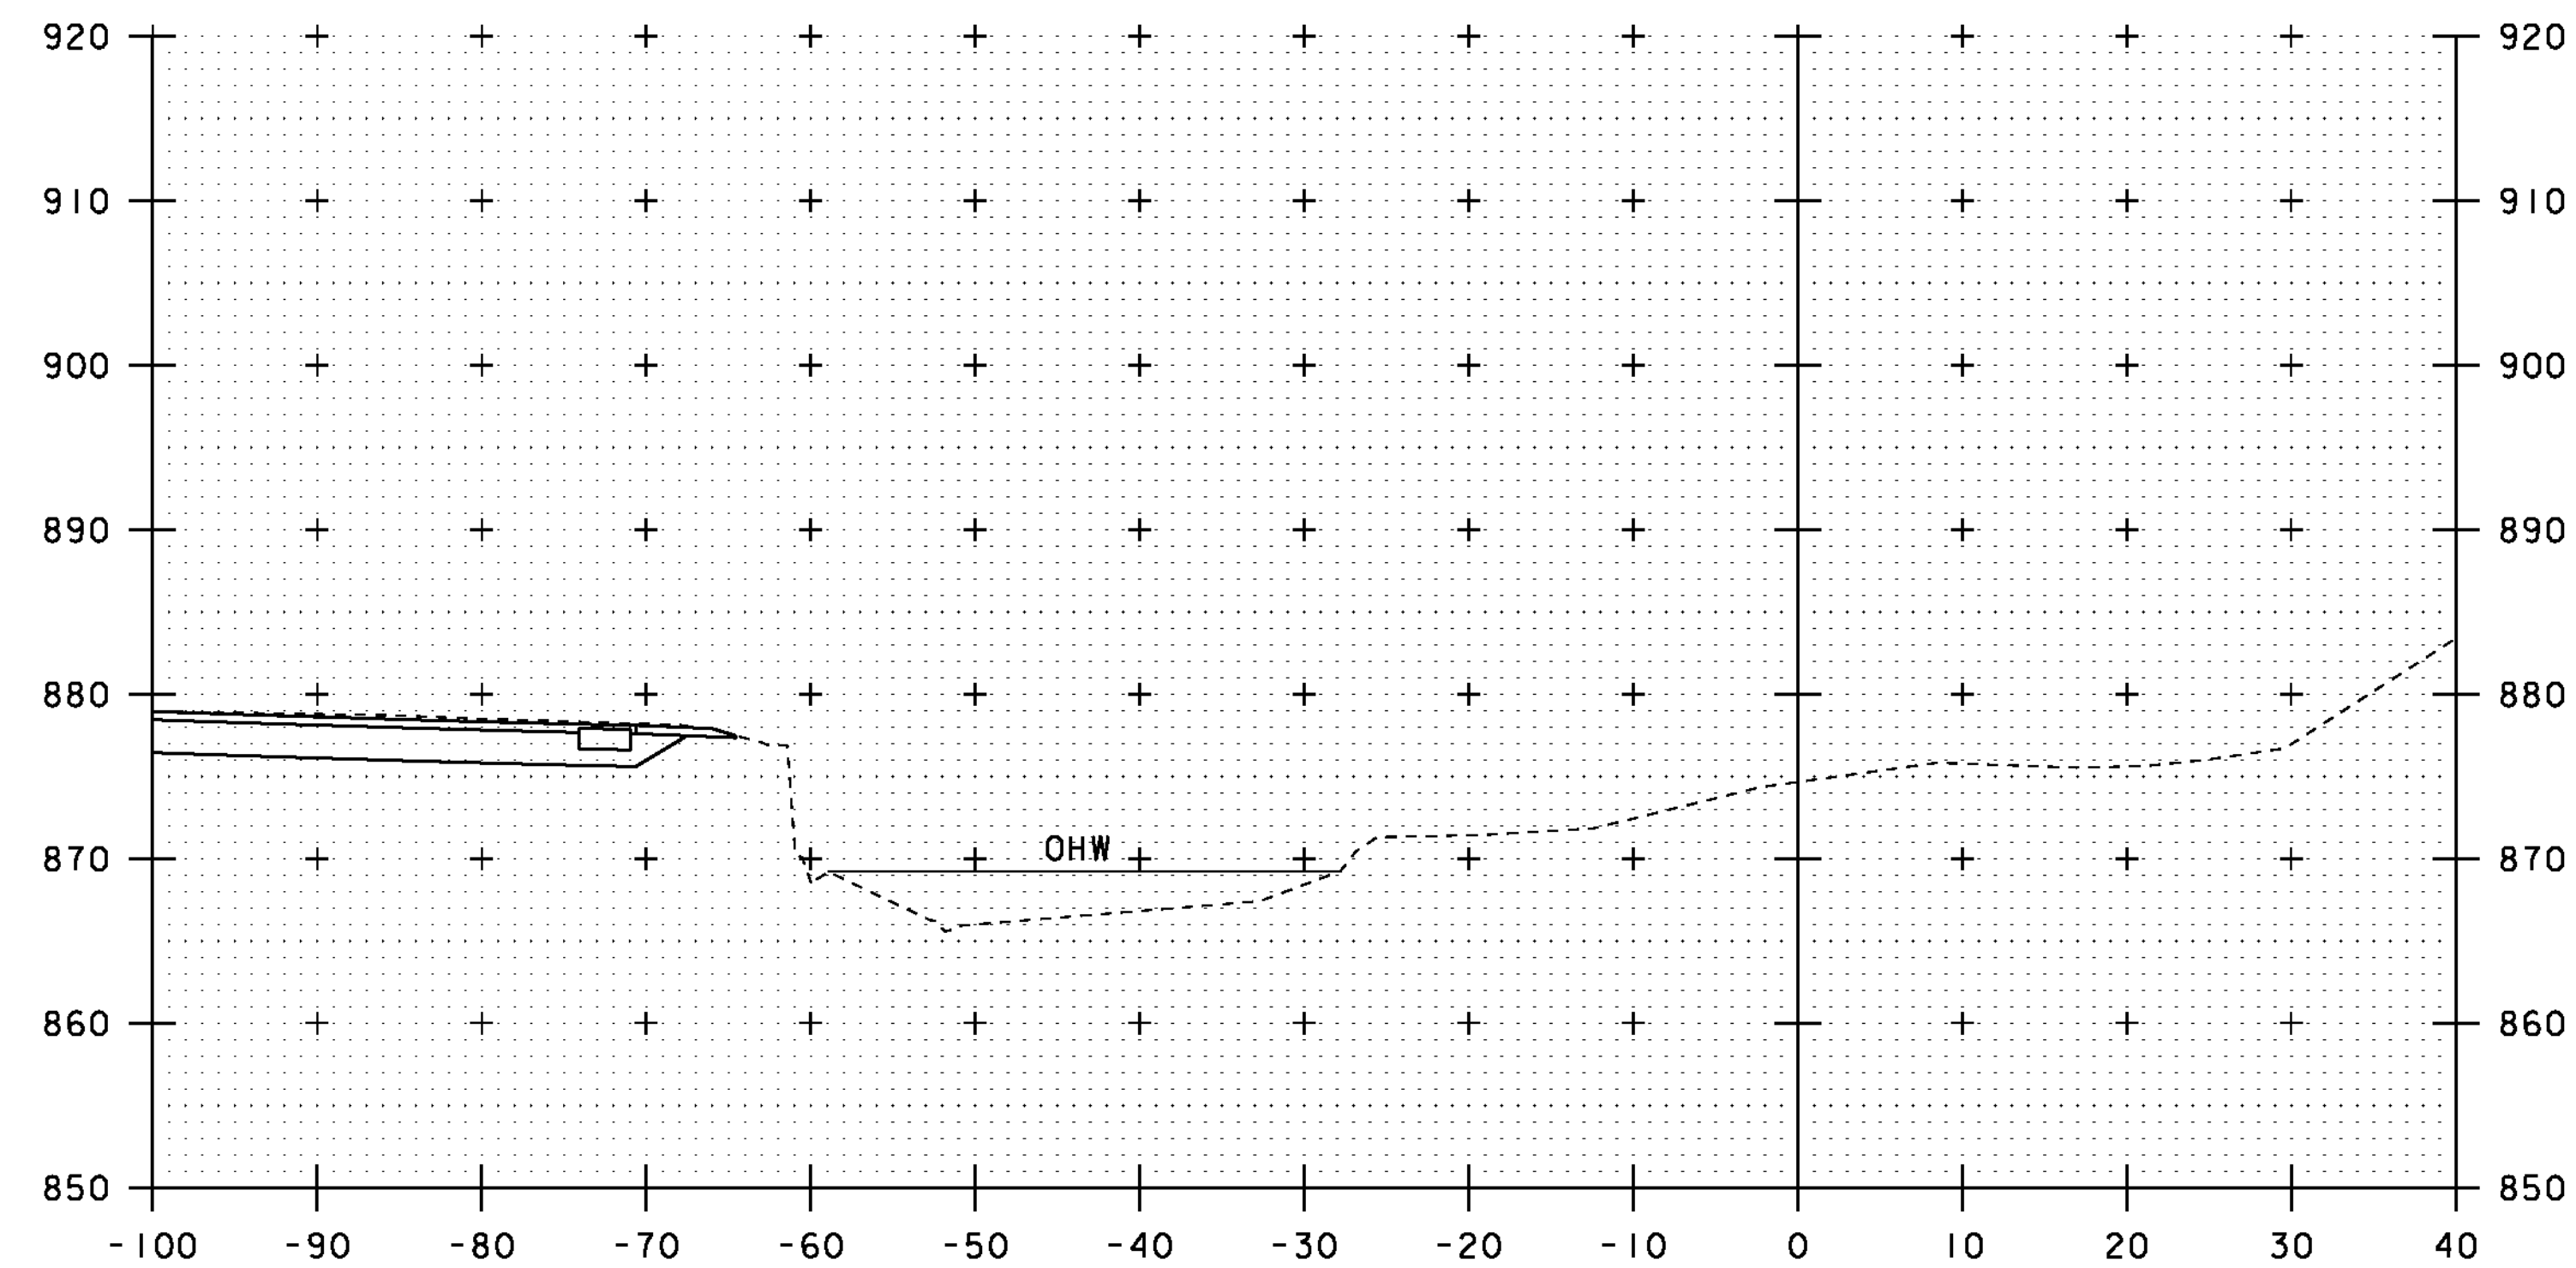


50+40

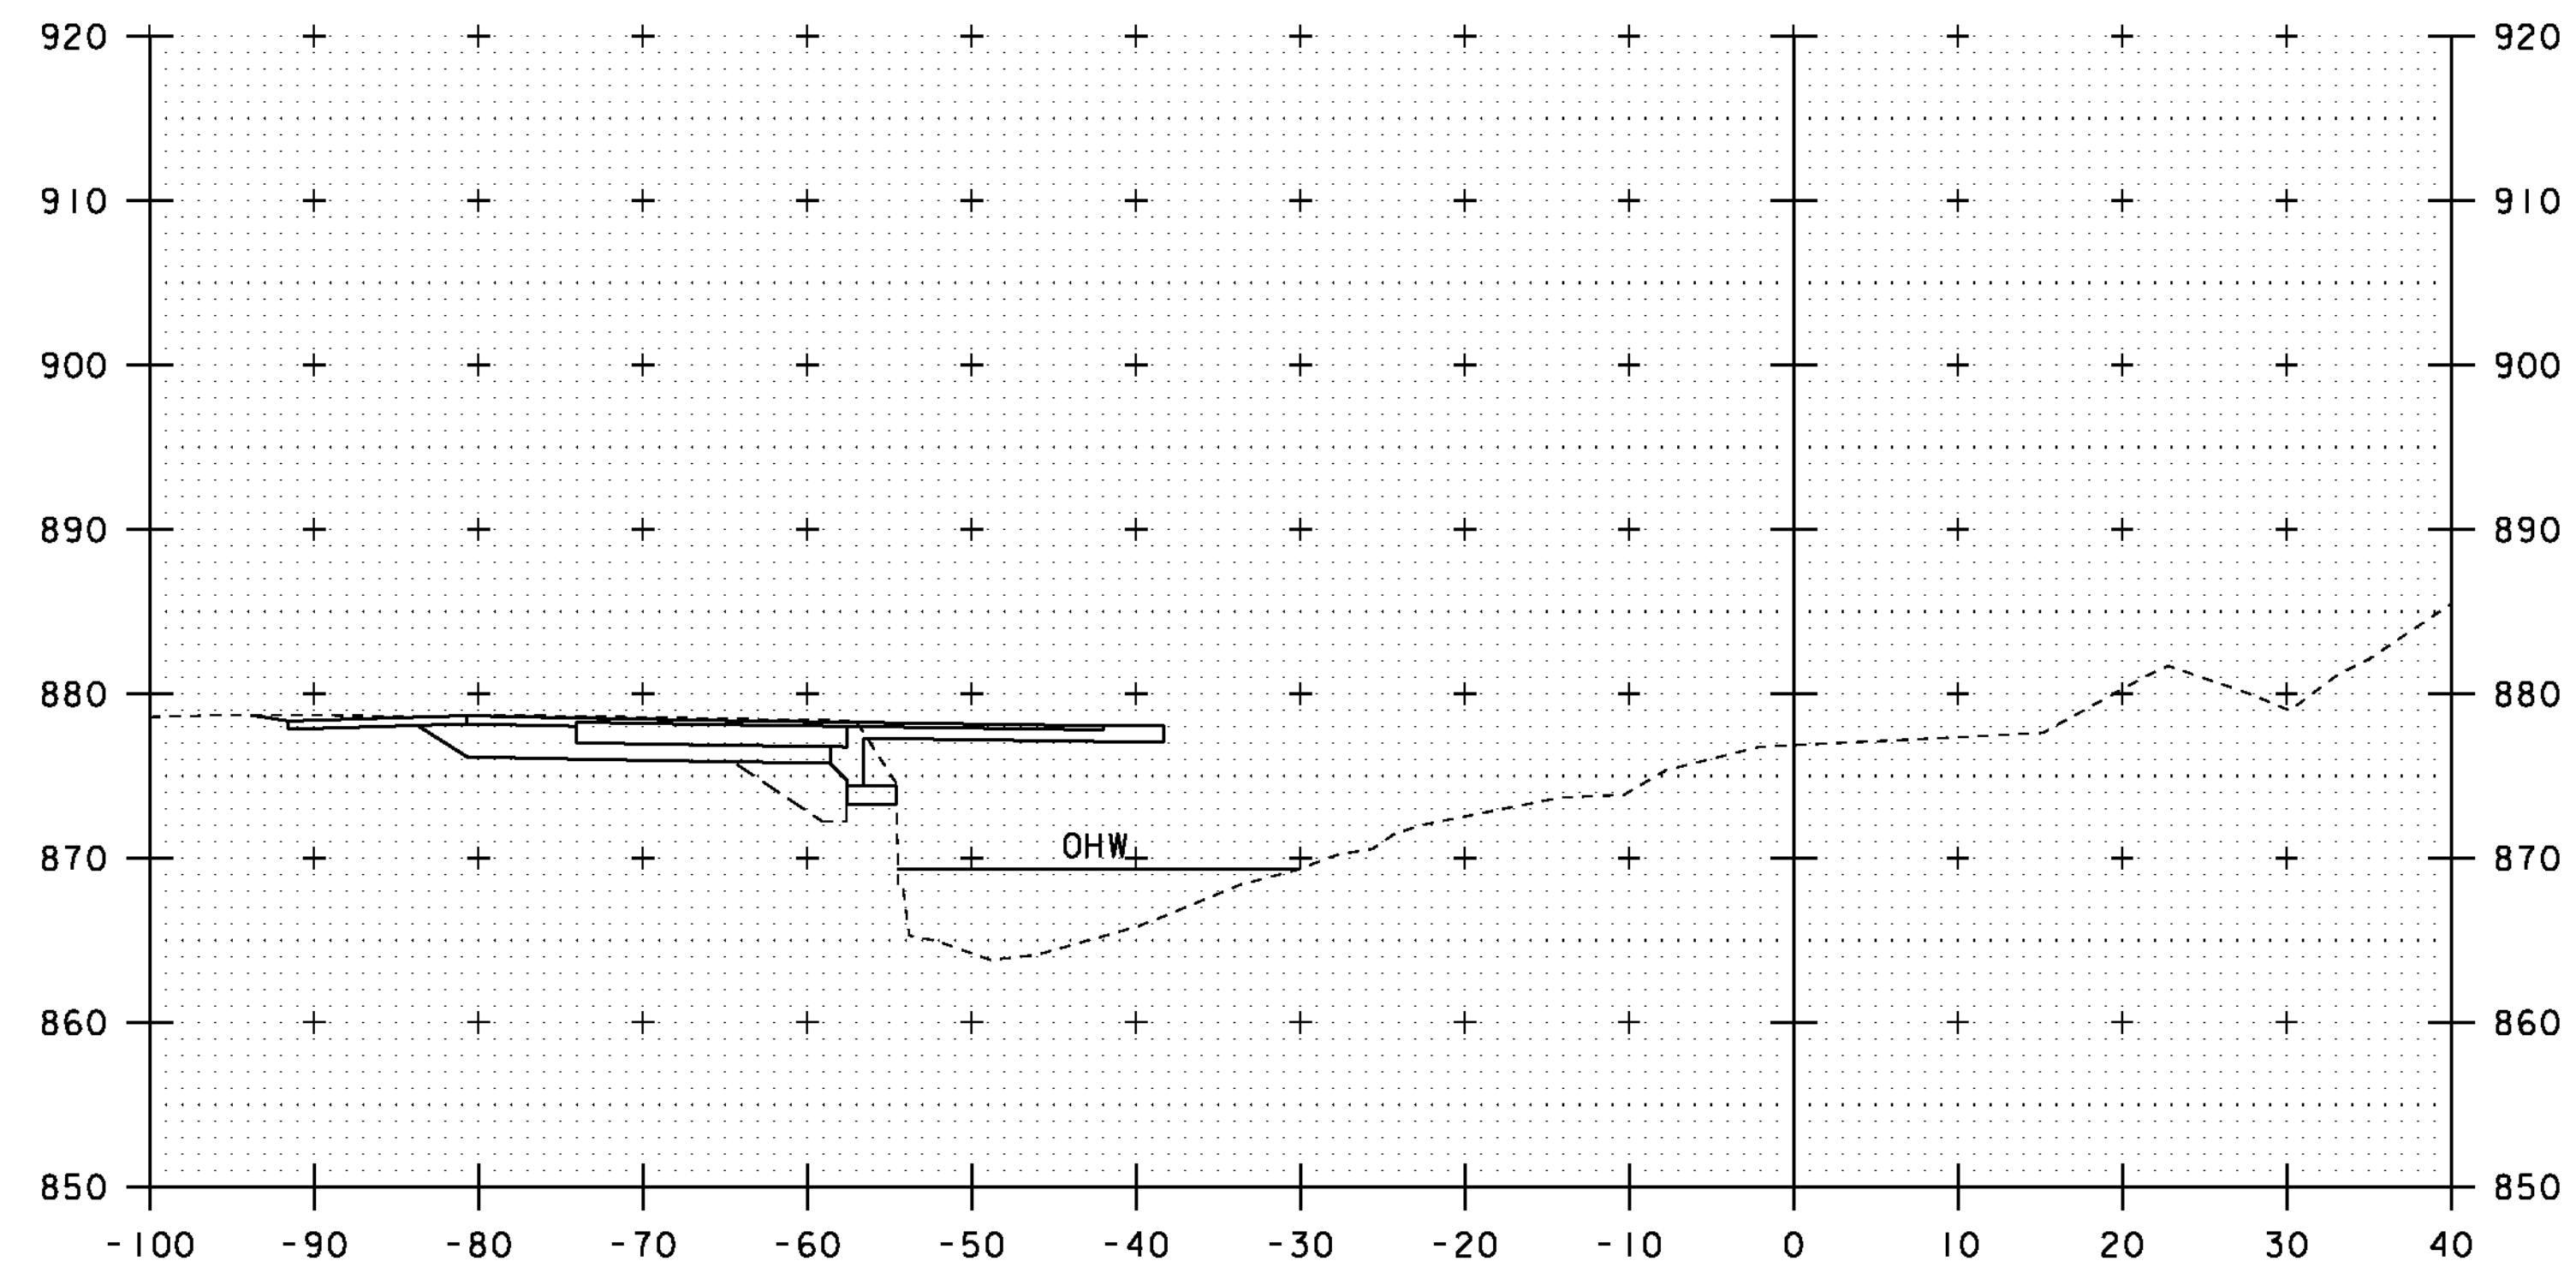

50+60

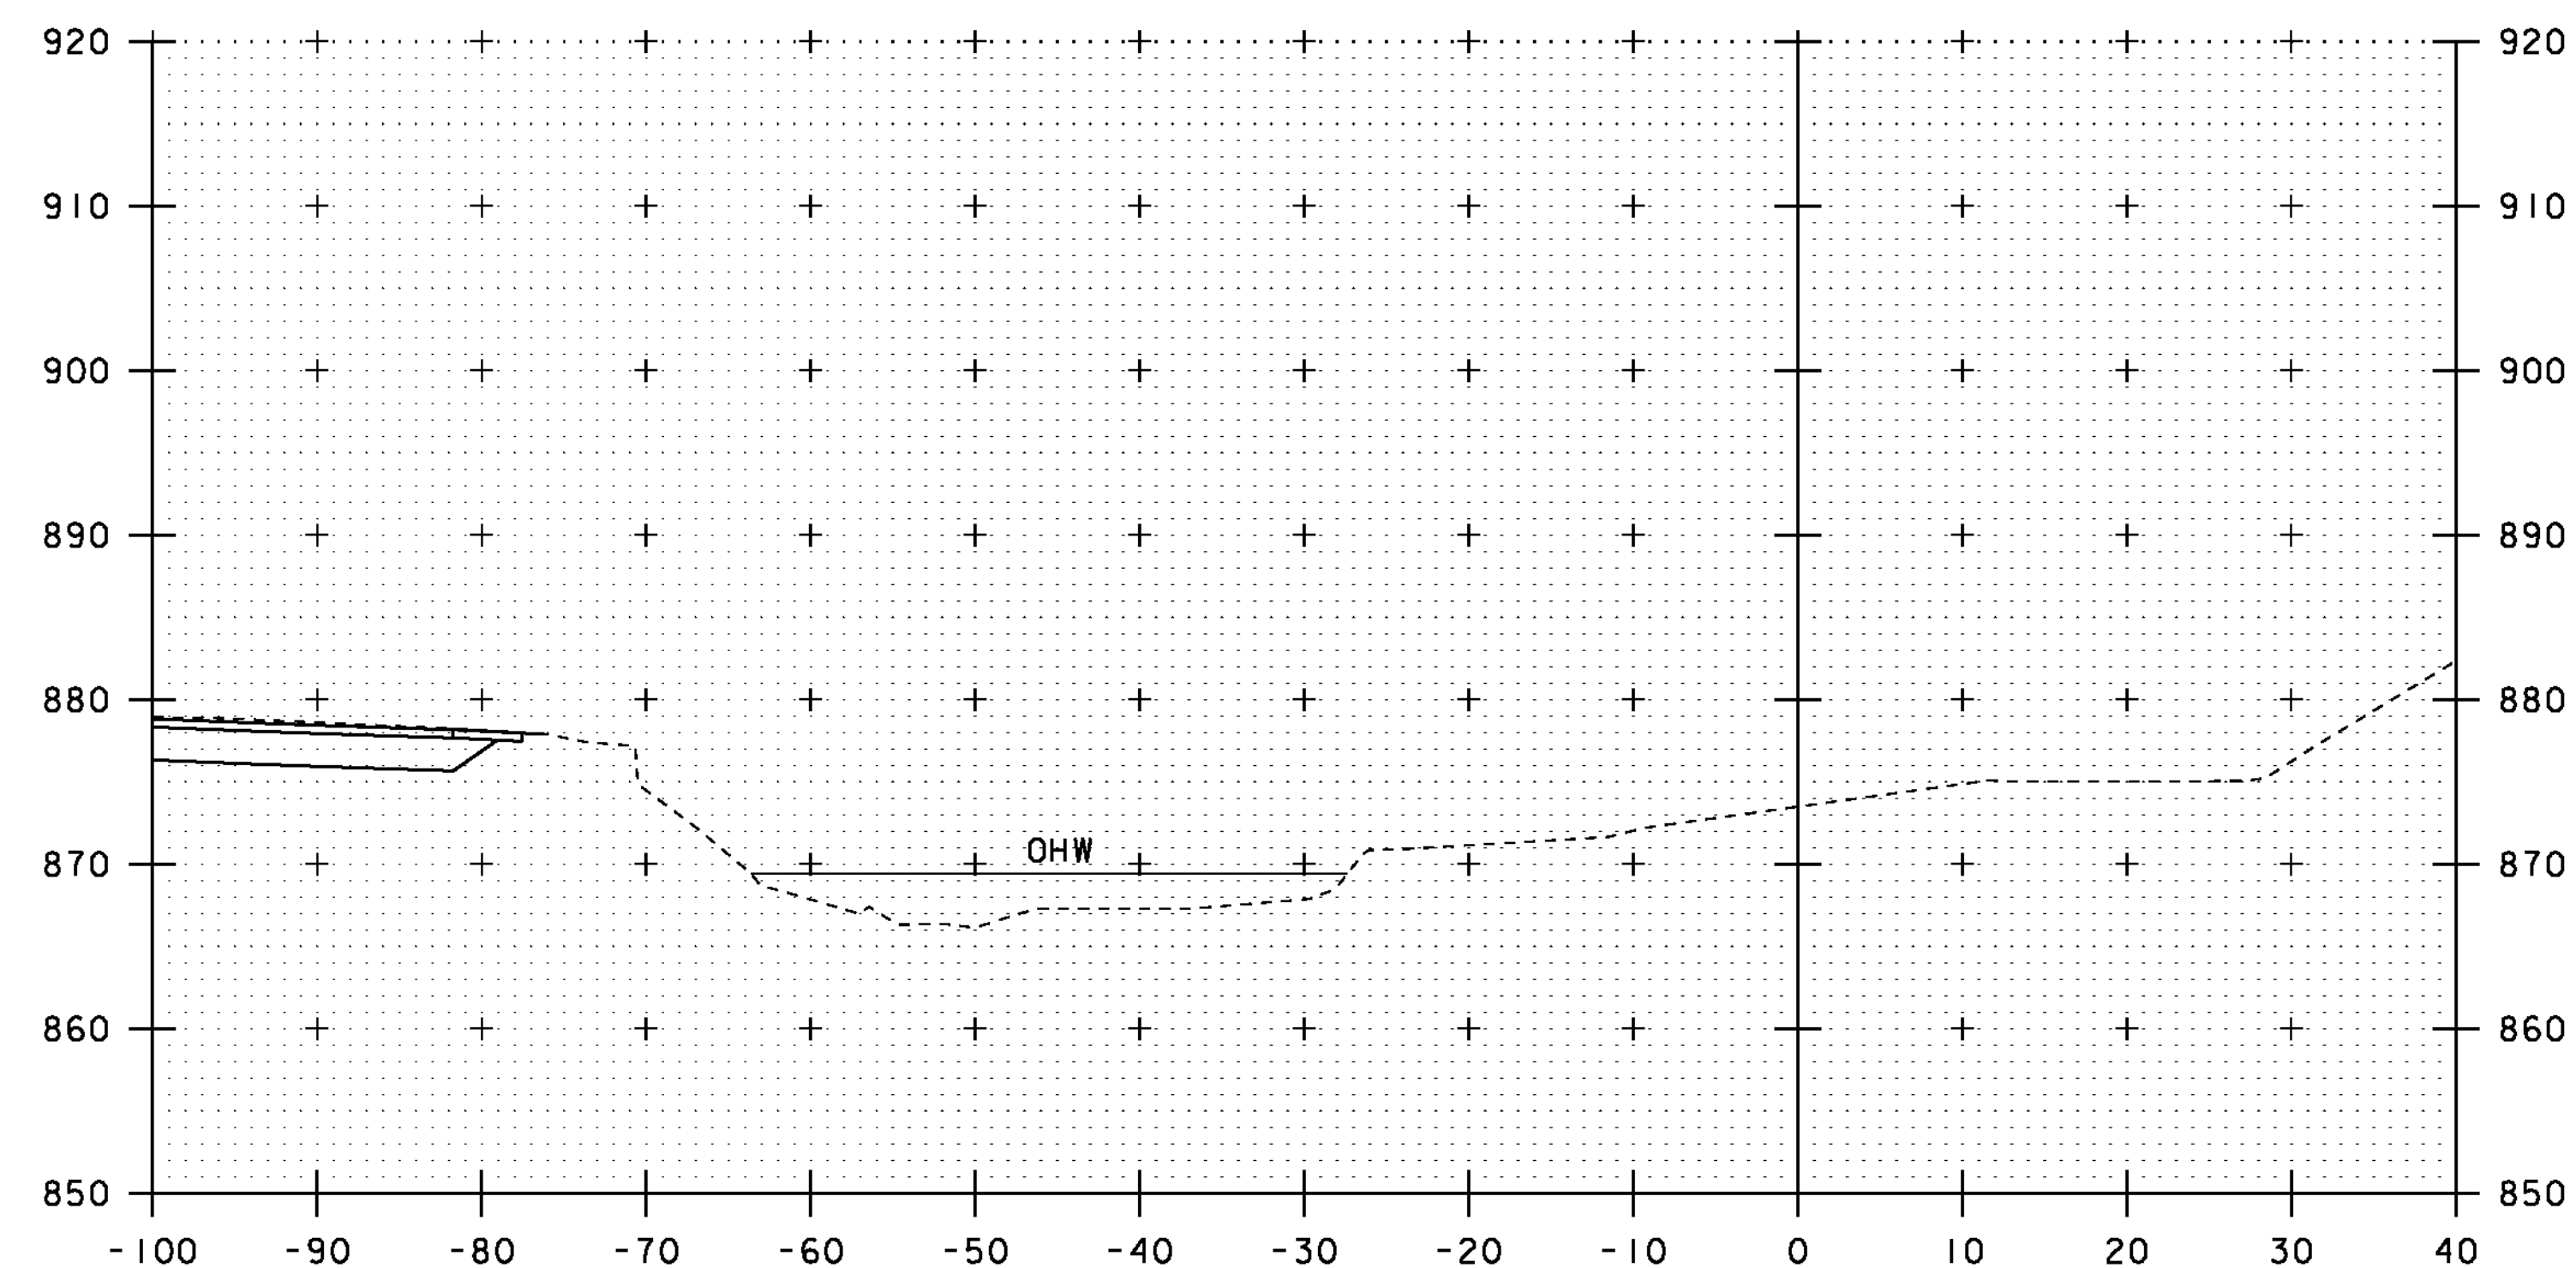

50+30

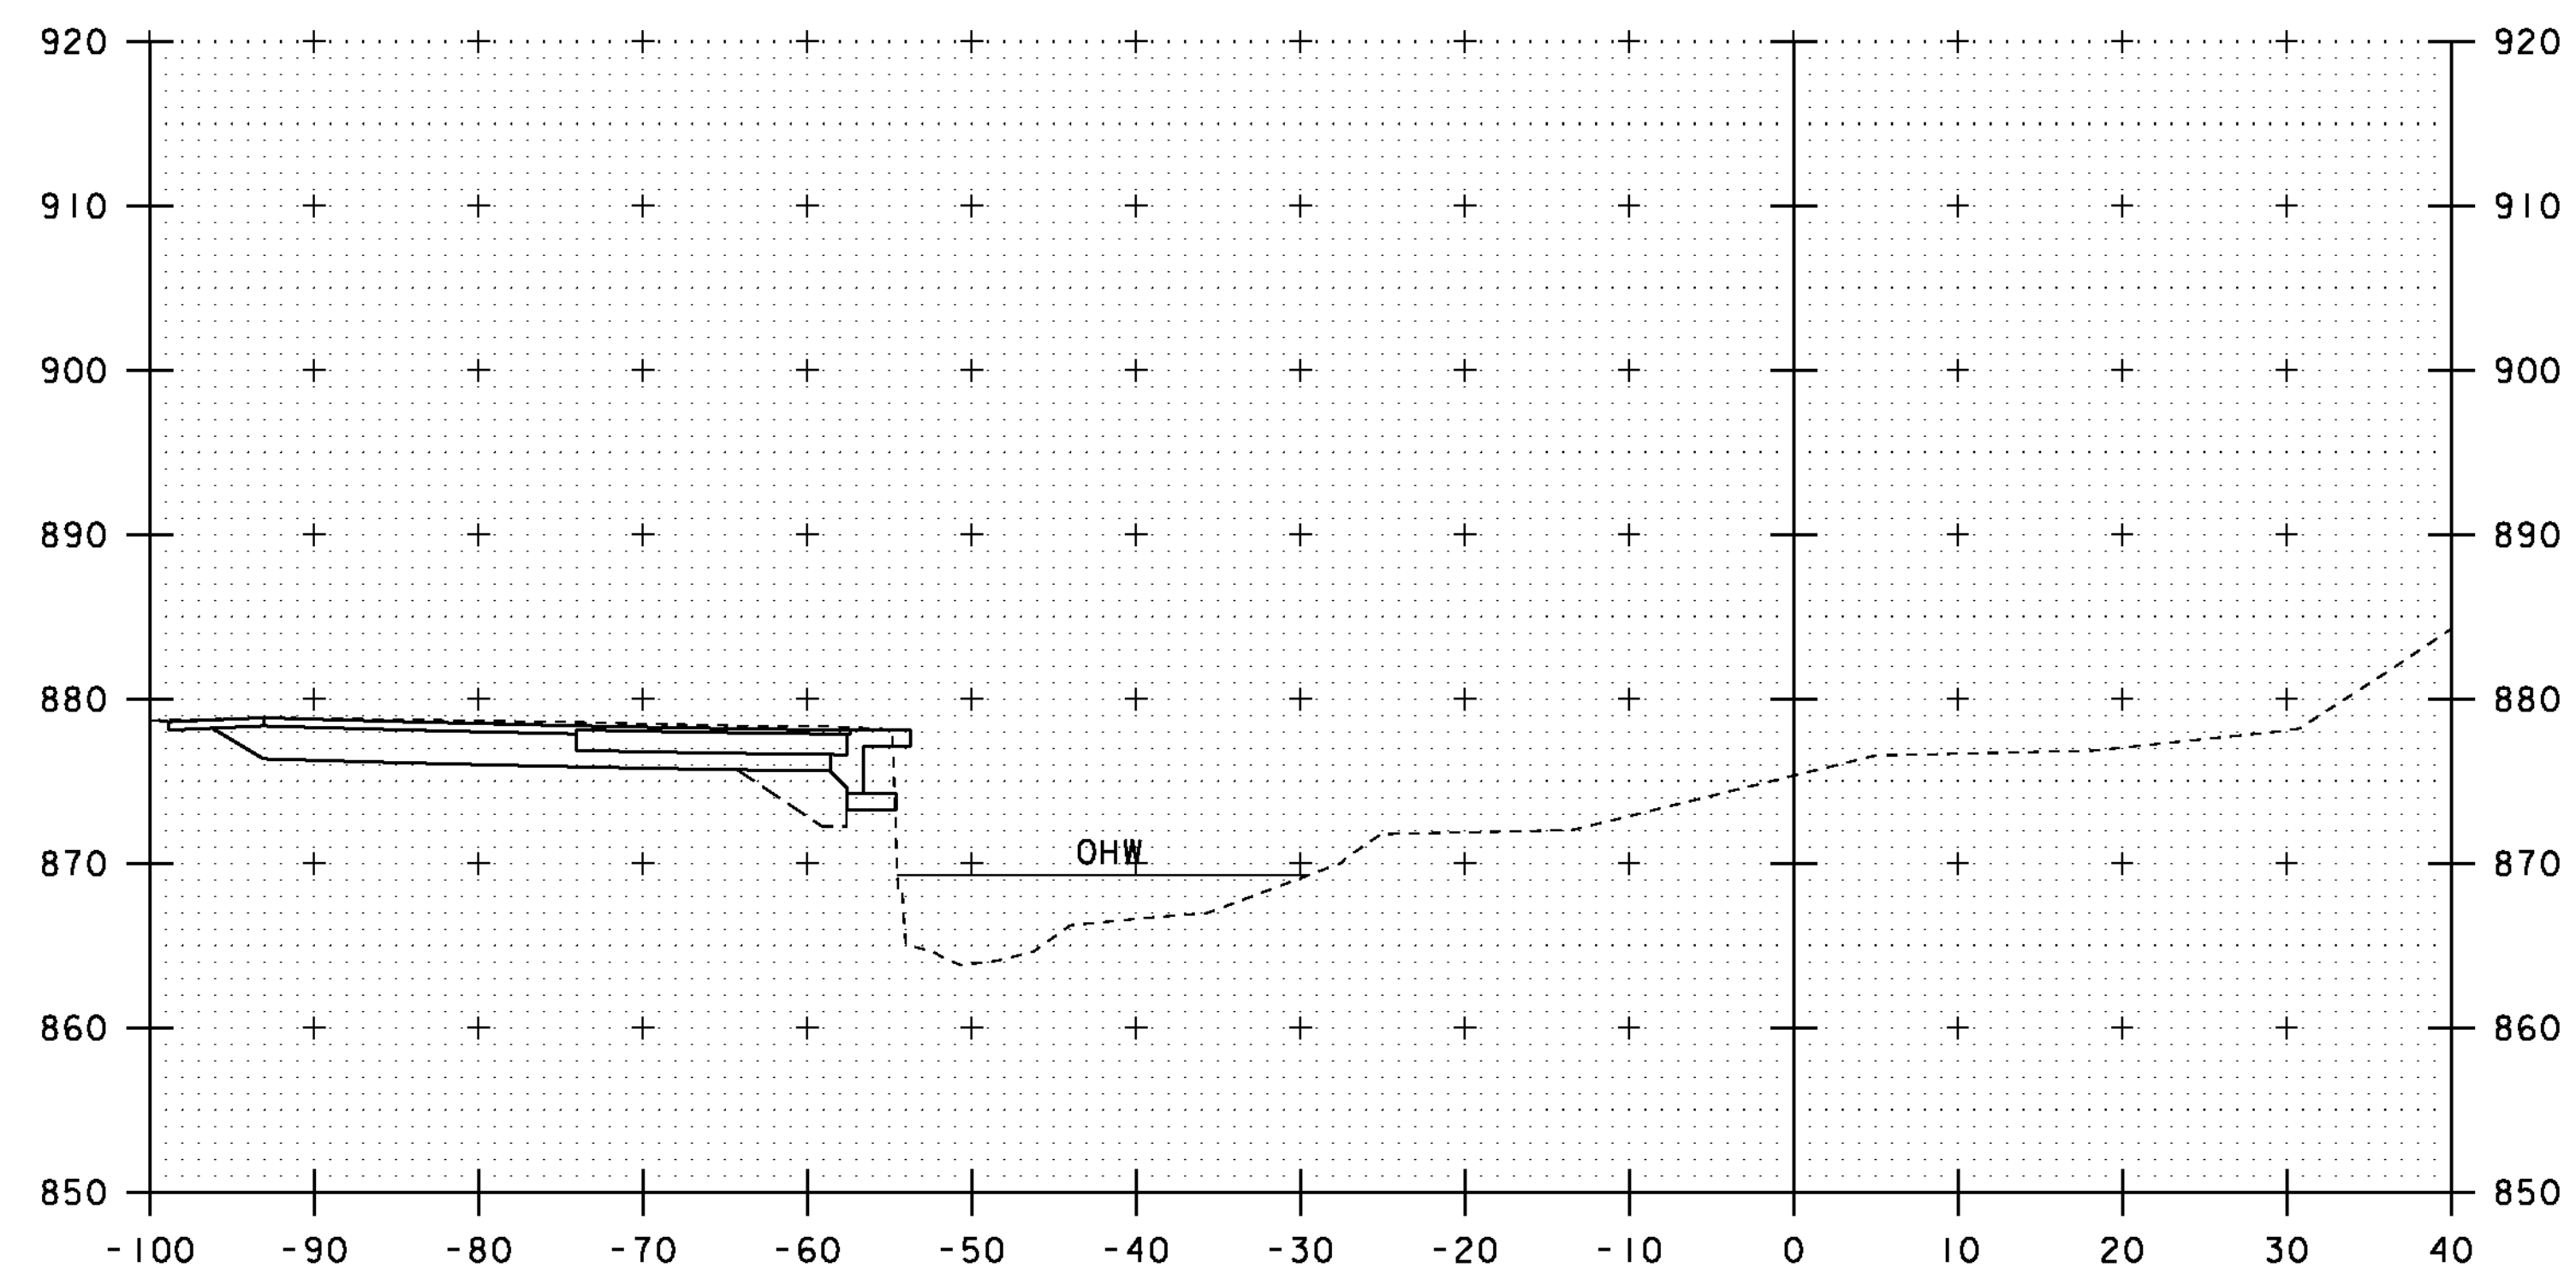

50+50

10 0 10
SCALE: 1" = 10'-0"

STA. 50+30 TO STA. 50+60

PROJECT NAME: ROXBURY
PROJECT NUMBER: BHF 0187(8)

FILE NAME: slOc420xsl.dgn
PROJECT LEADER: C. P. WILLIAMS
DESIGNED BY: G. ROY
CHANNEL LINE CROSS SECTIONS (1)

PLOT DATE: 21-SEP-2011
DRAWN BY: G. ROY
CHECKED BY: T. FILLBACH
SHEET 38 OF 54