




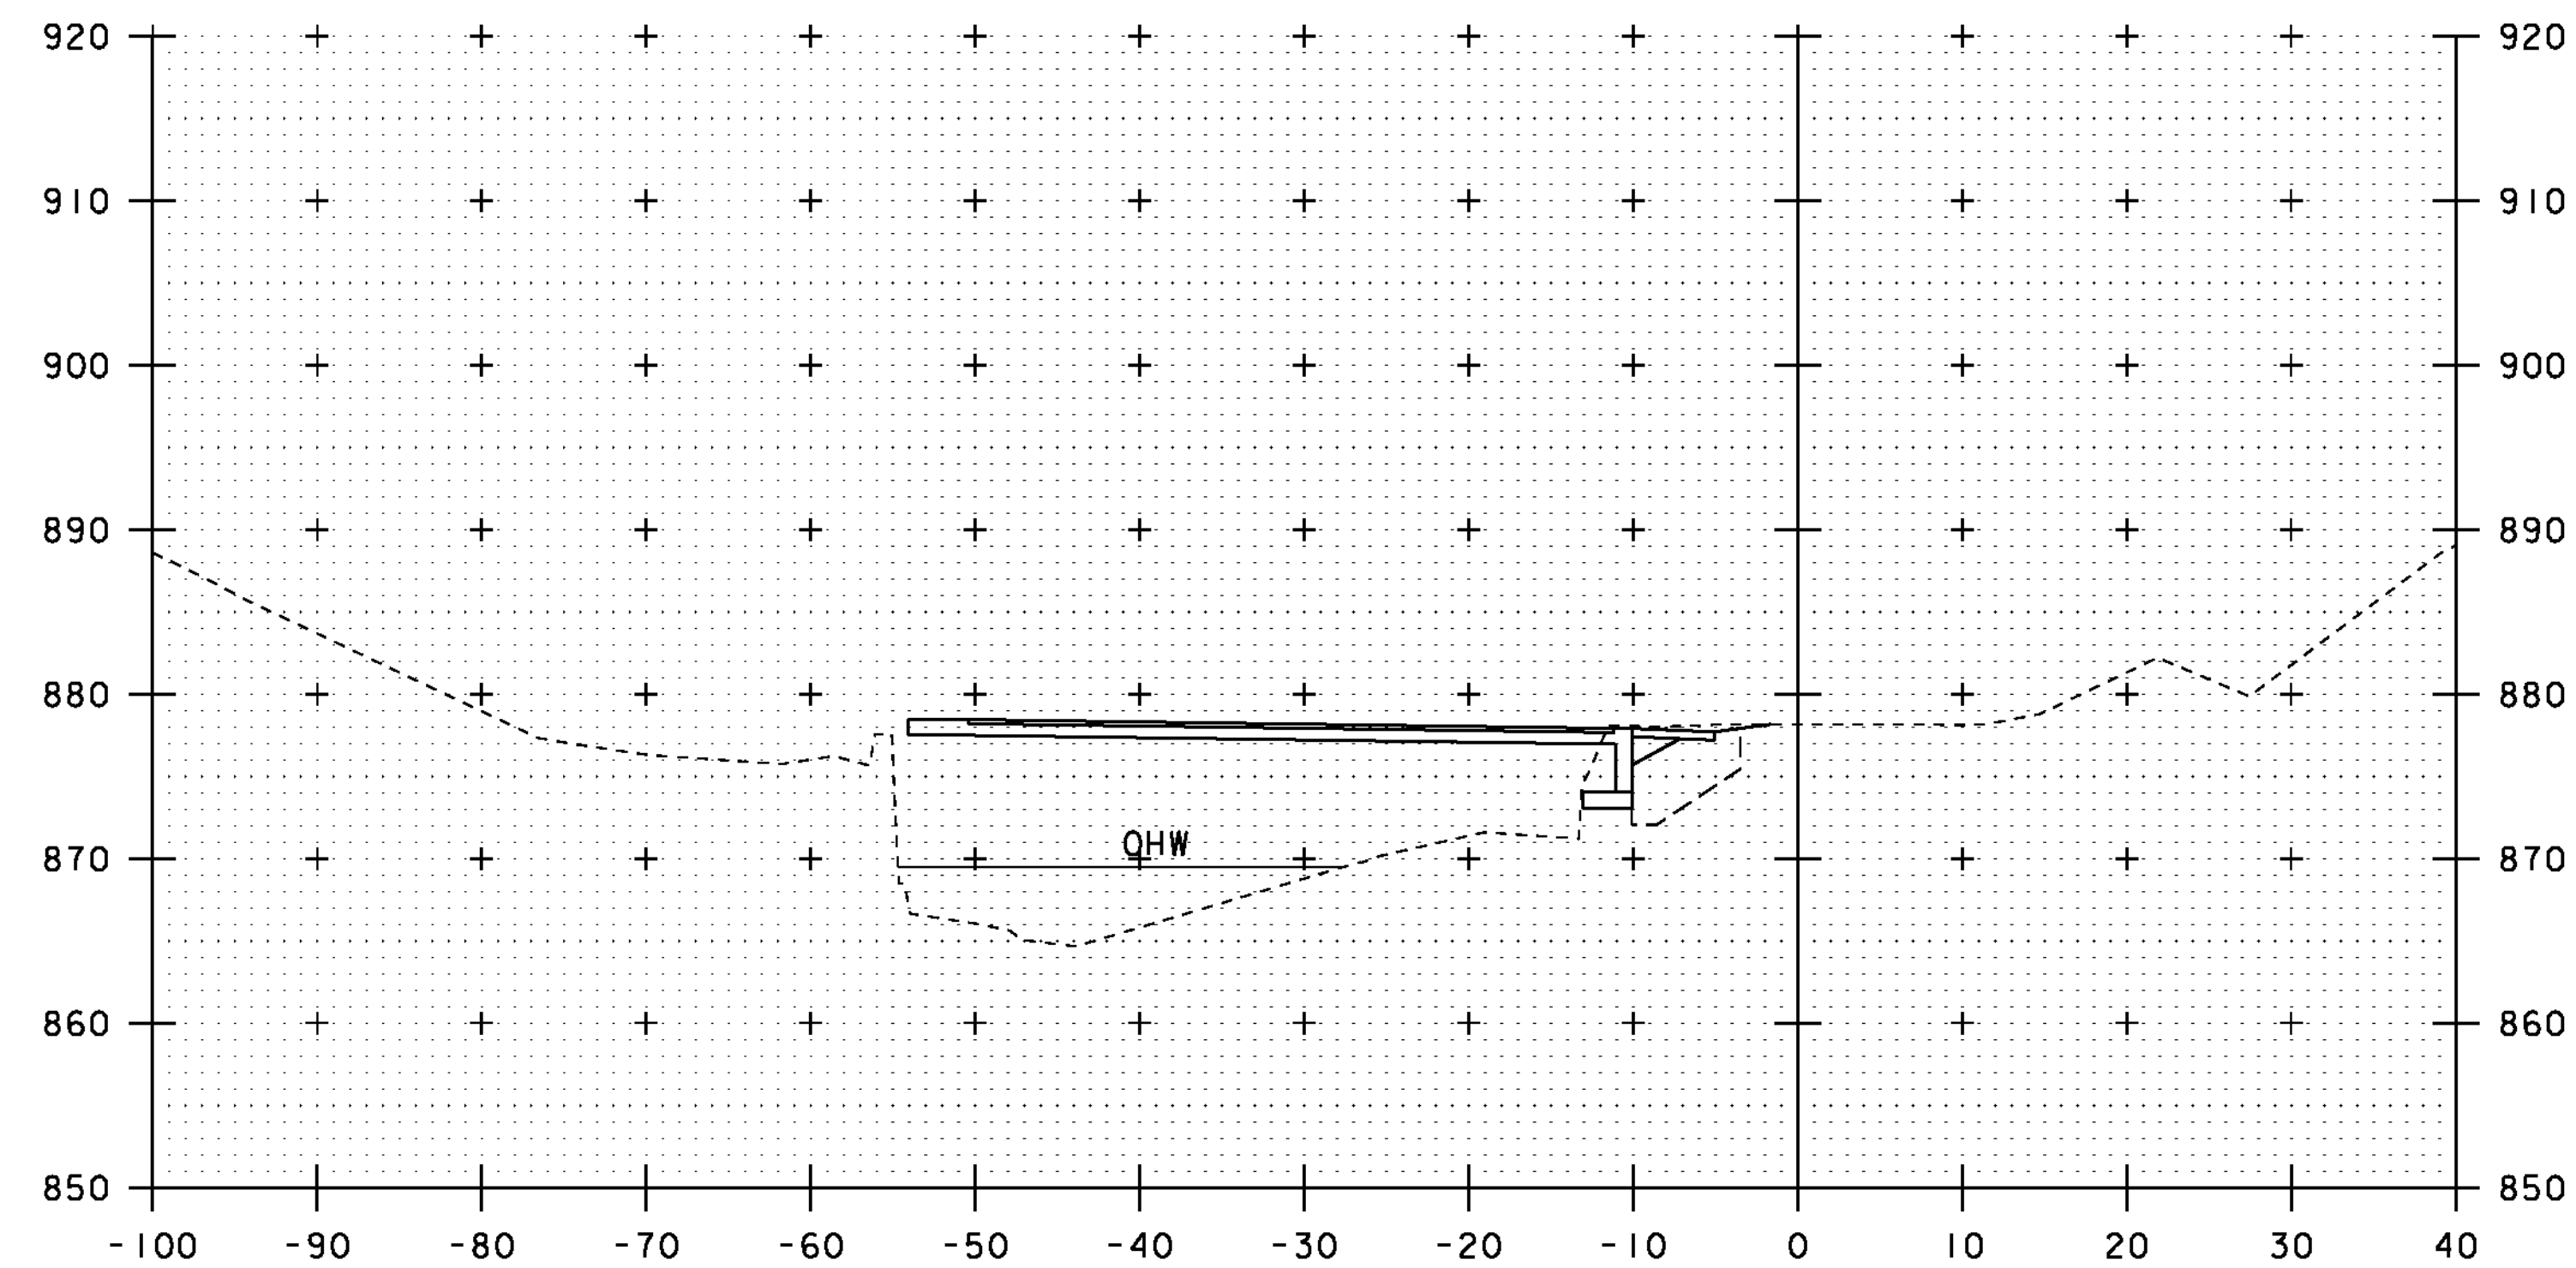


50+80

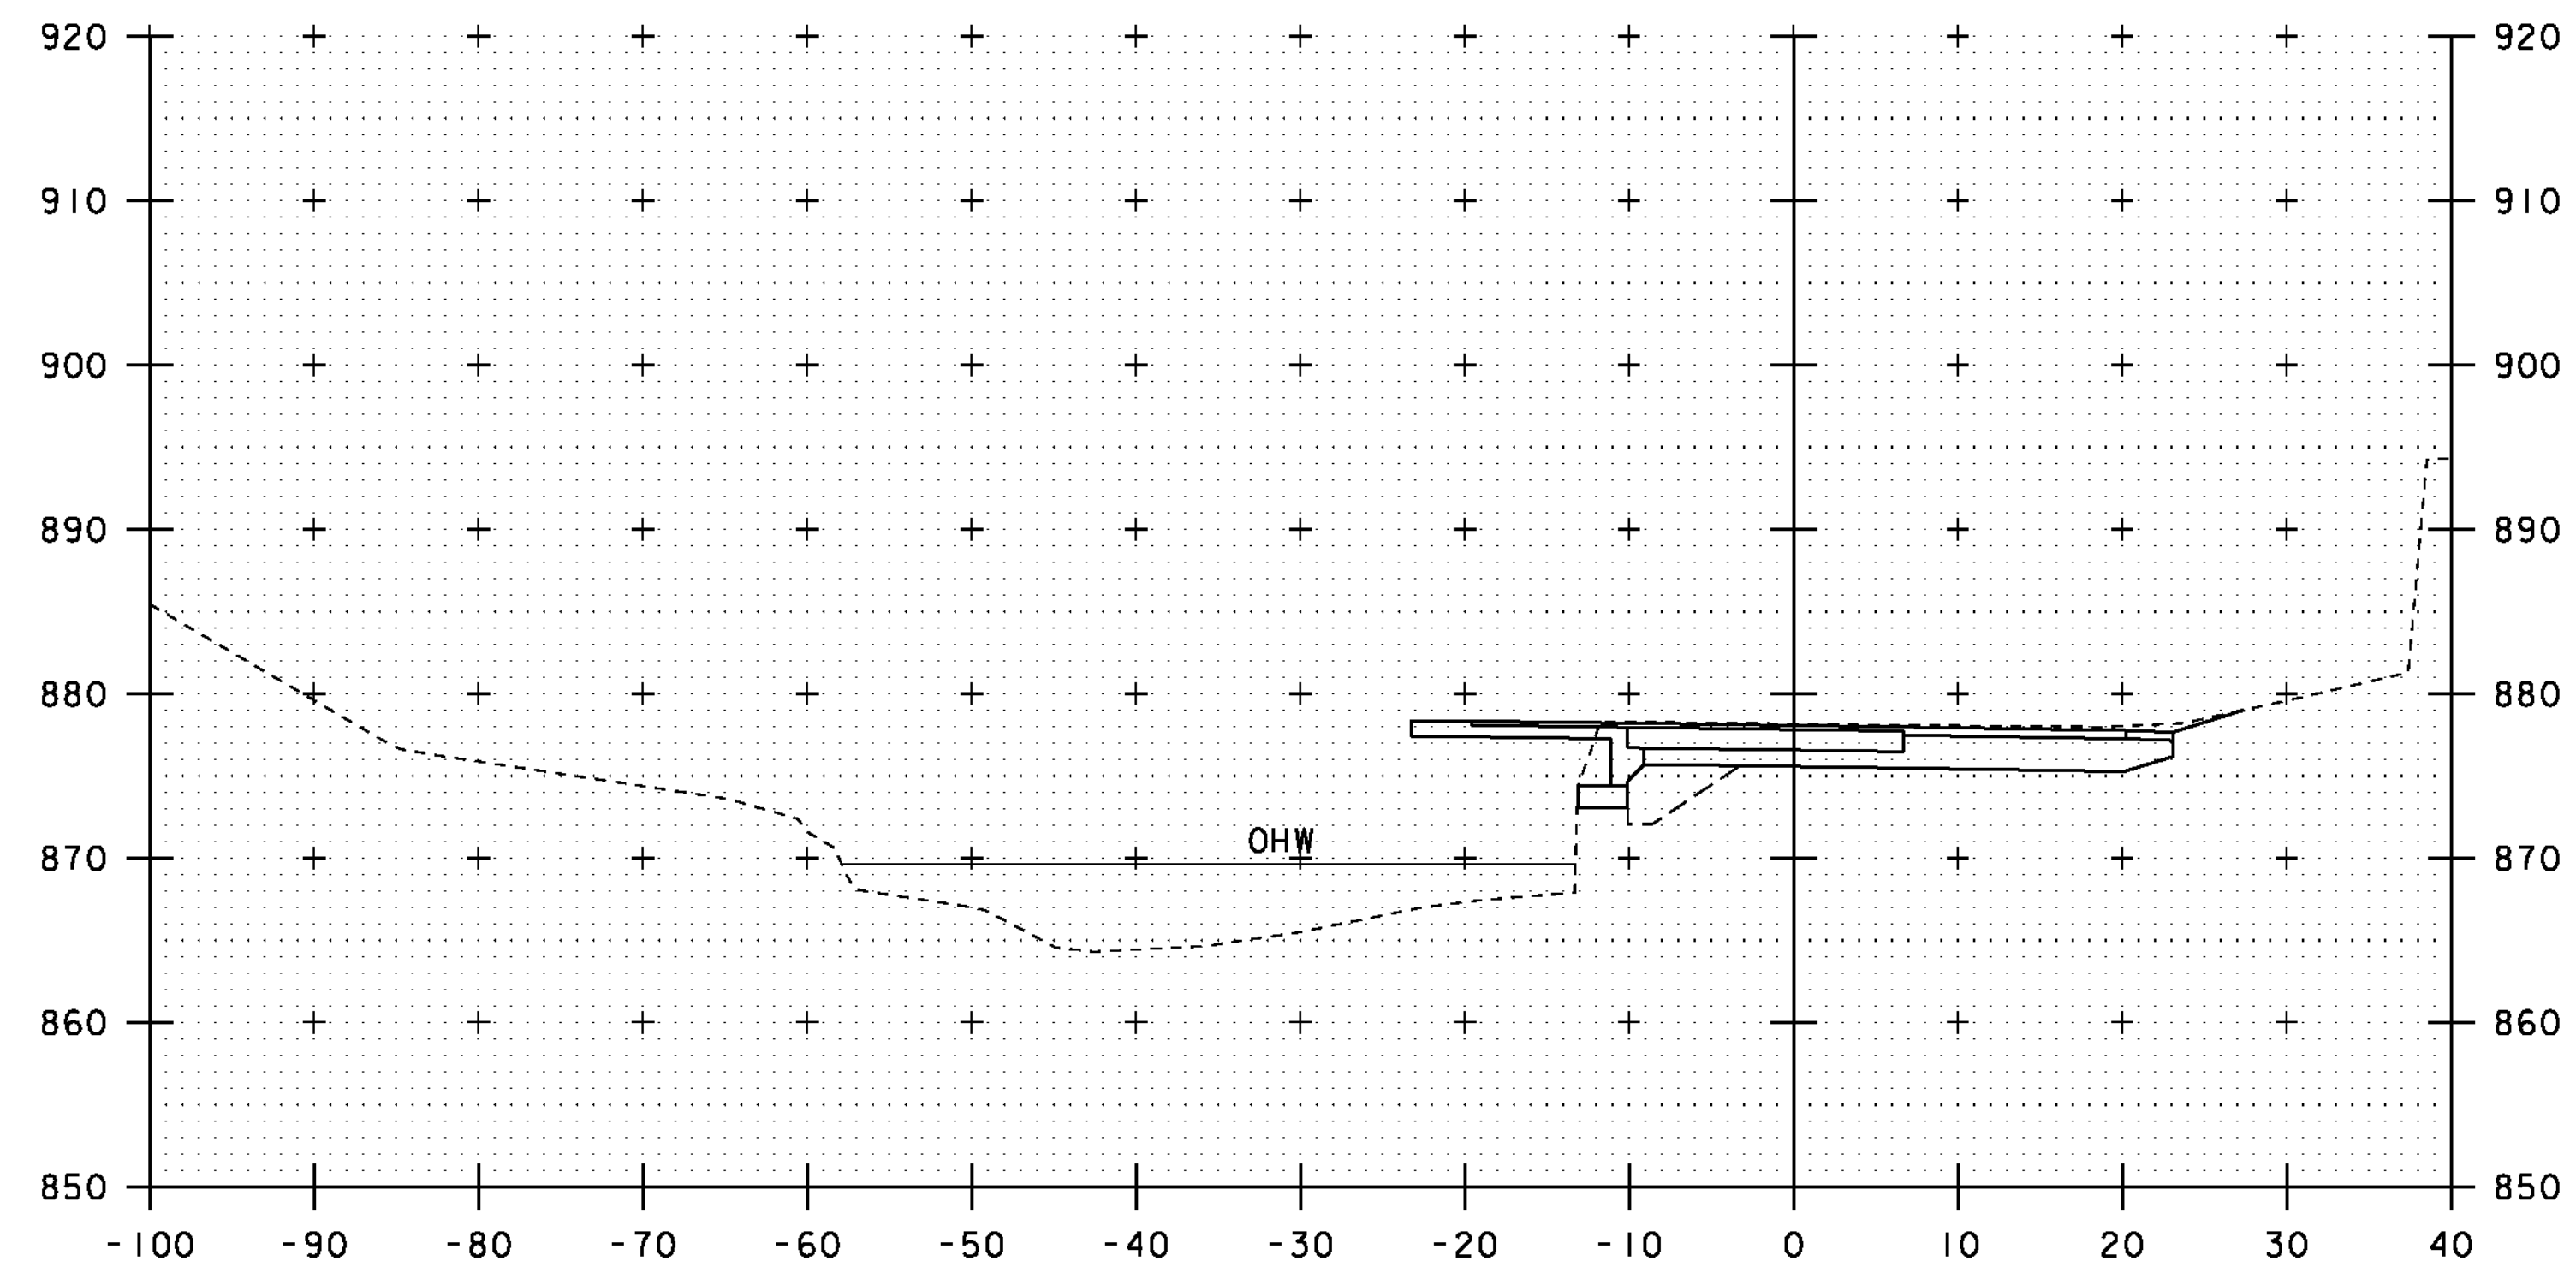

51+00

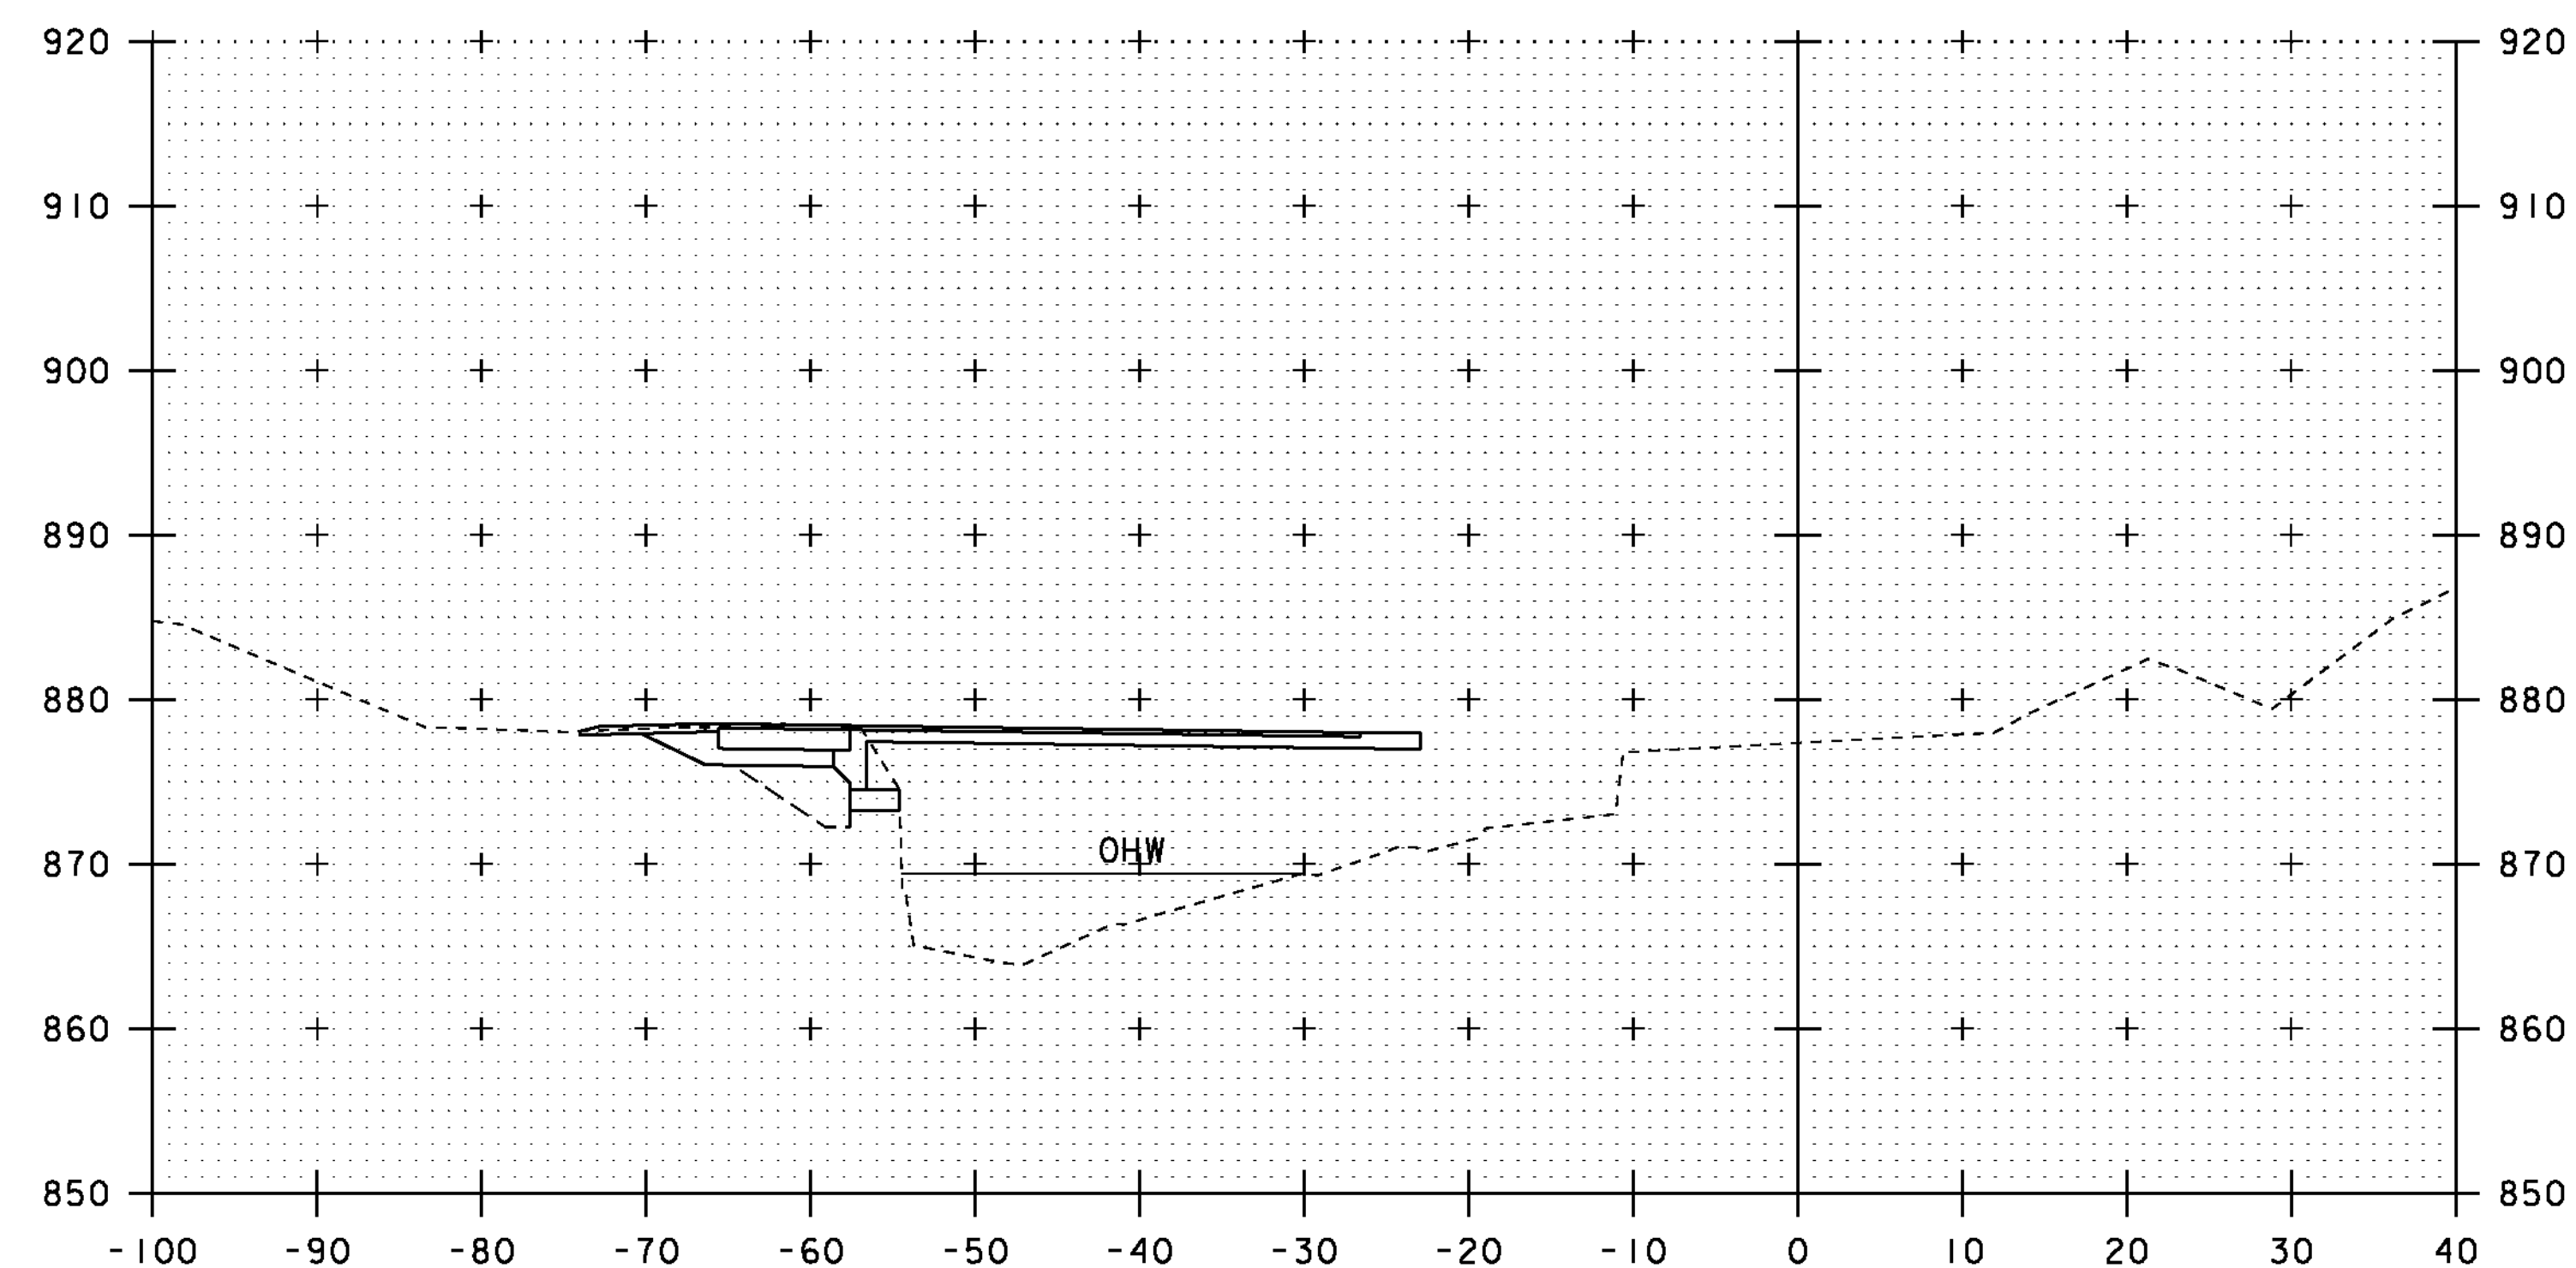

50+70

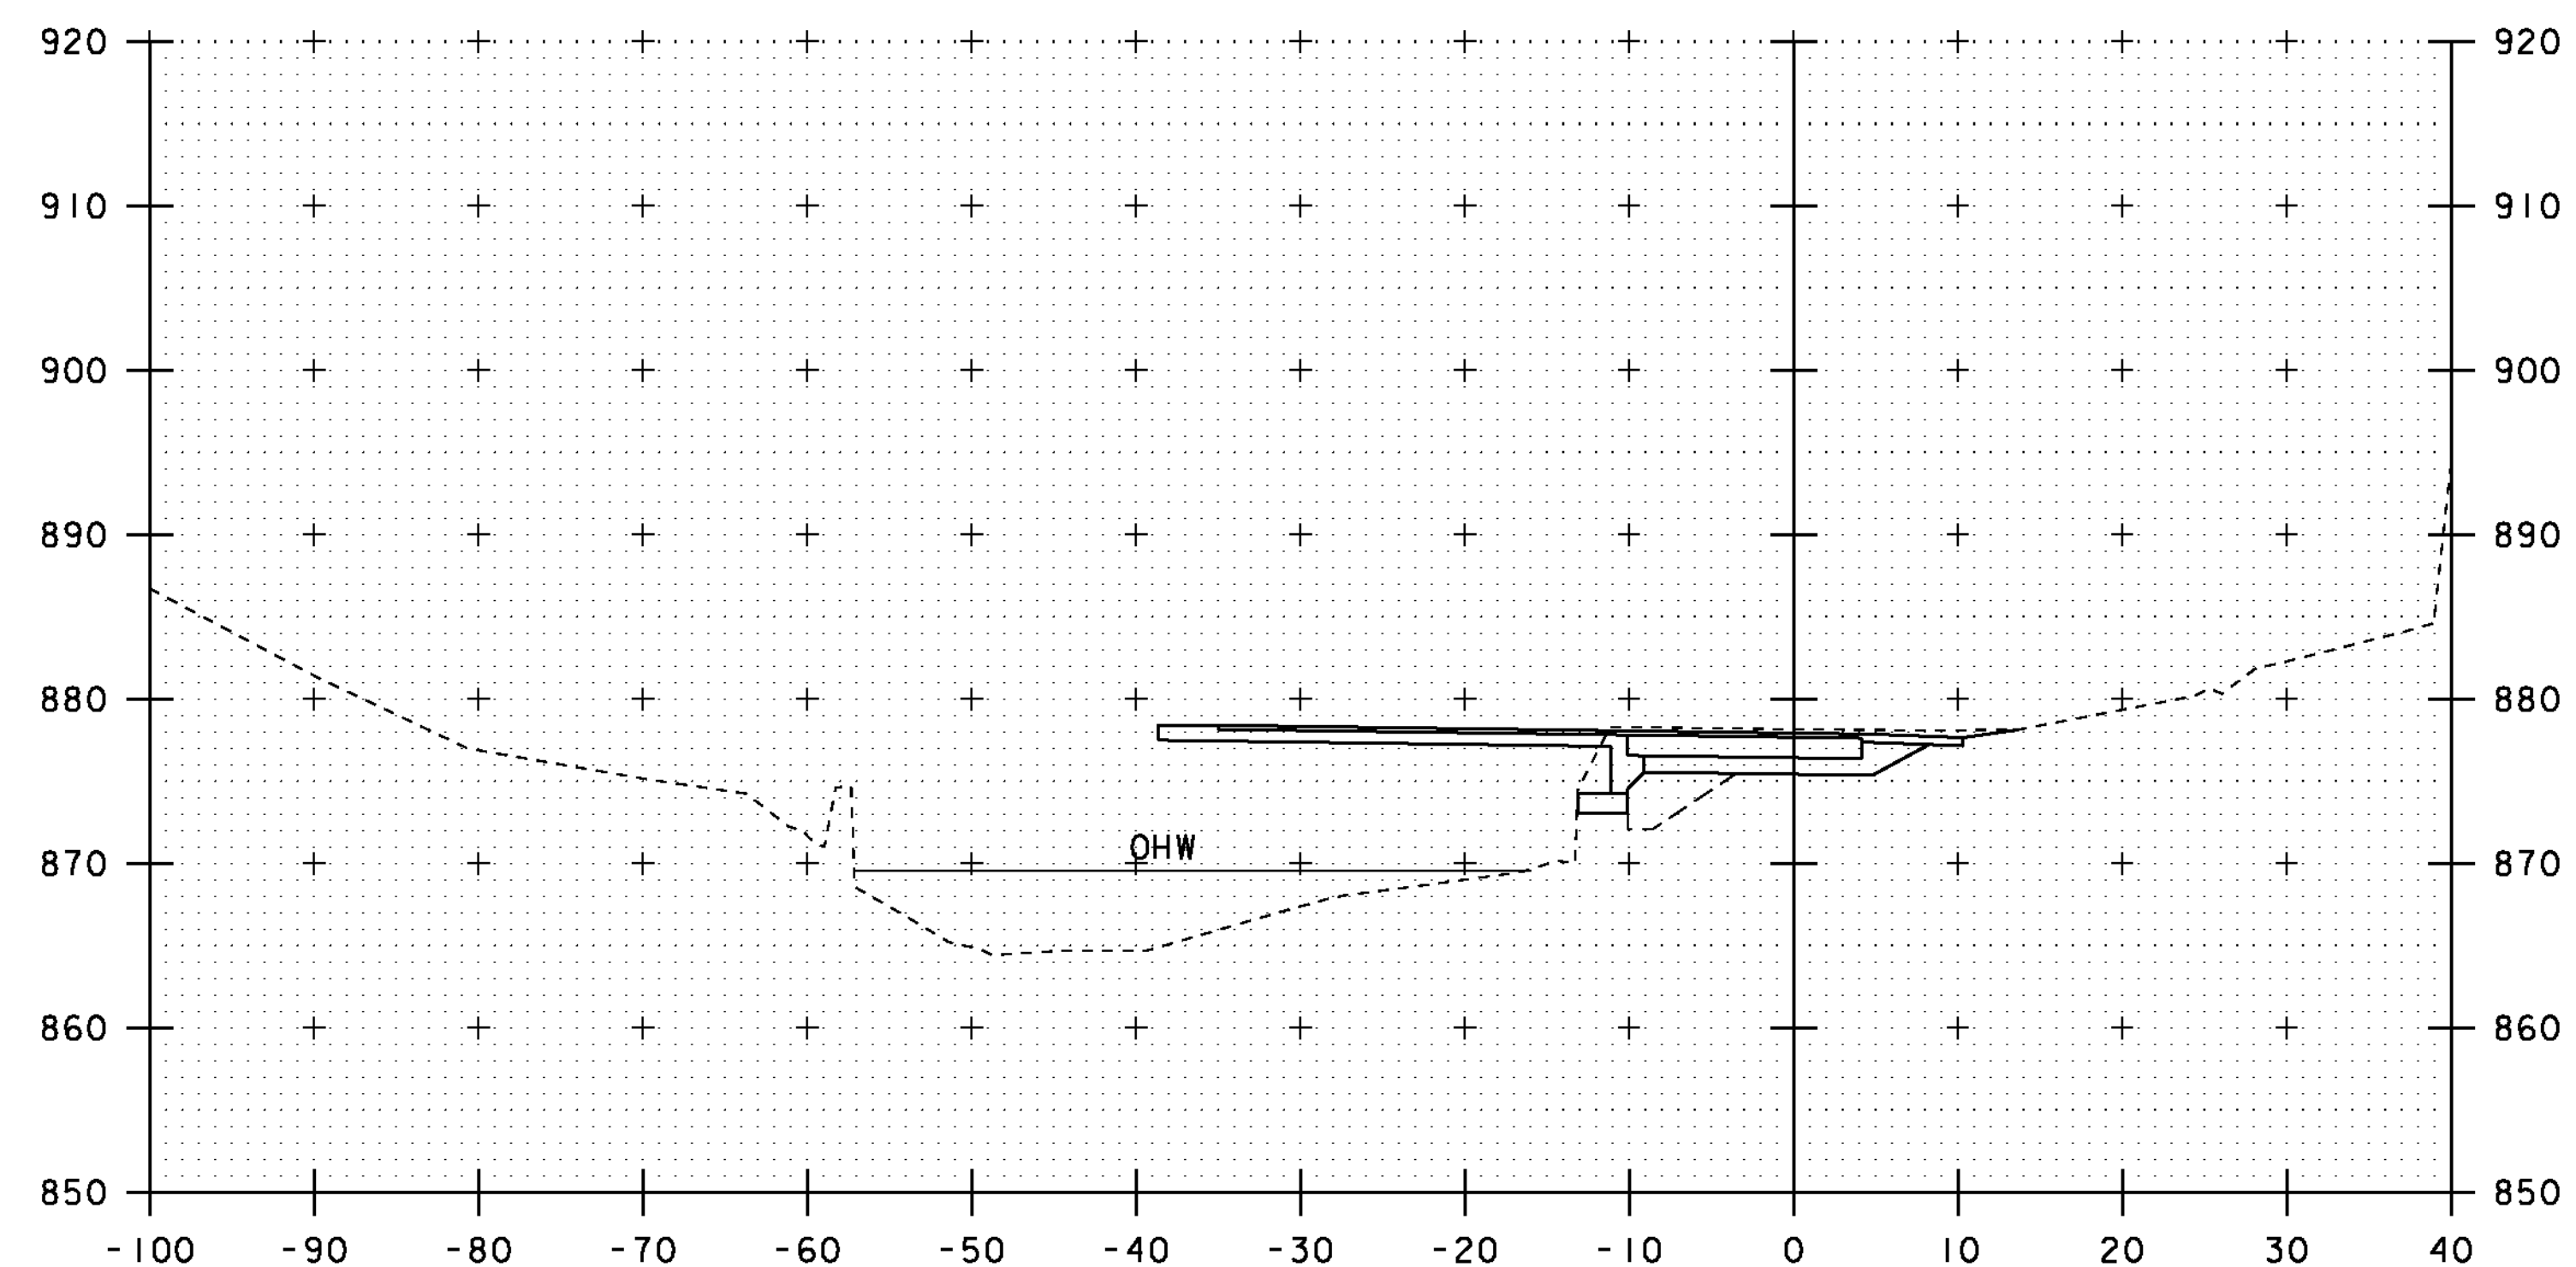

50+90

10 0 10
SCALE: 1" = 10'-0"

STA. 50+70 TO STA. 51+00

PROJECT NAME: ROXBURY
PROJECT NUMBER: BHF 0187(8)

FILE NAME: slOc420xsl.dgn
PROJECT LEADER: C. P. WILLIAMS
DESIGNED BY: G. ROY
CHANNEL LINE CROSS SECTIONS (2)

PLOT DATE: 21-SEP-2011
DRAWN BY: G. ROY
CHECKED BY: T. FILLBACH
SHEET 39 OF 54