
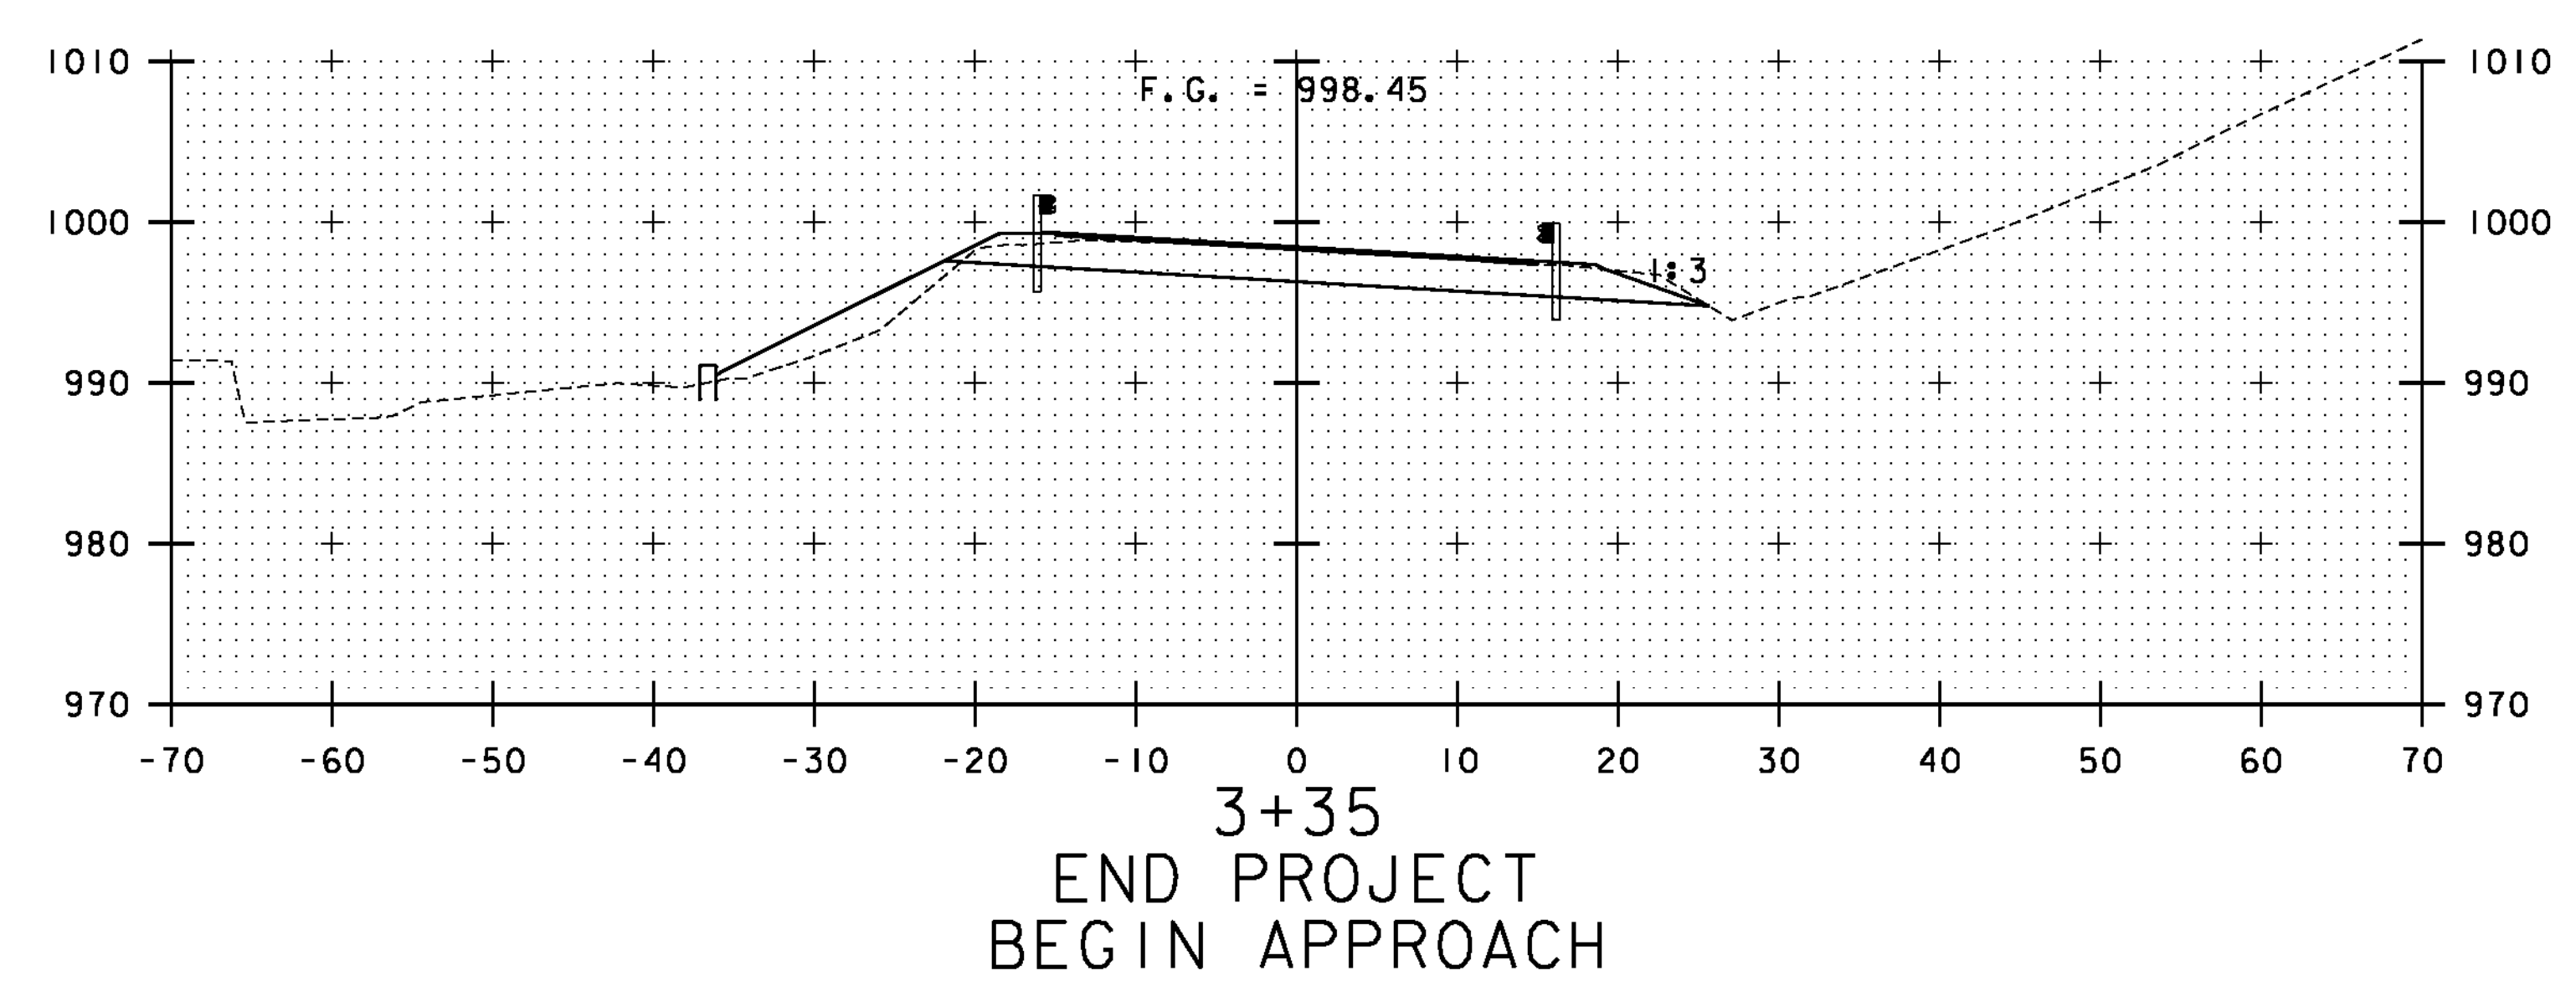
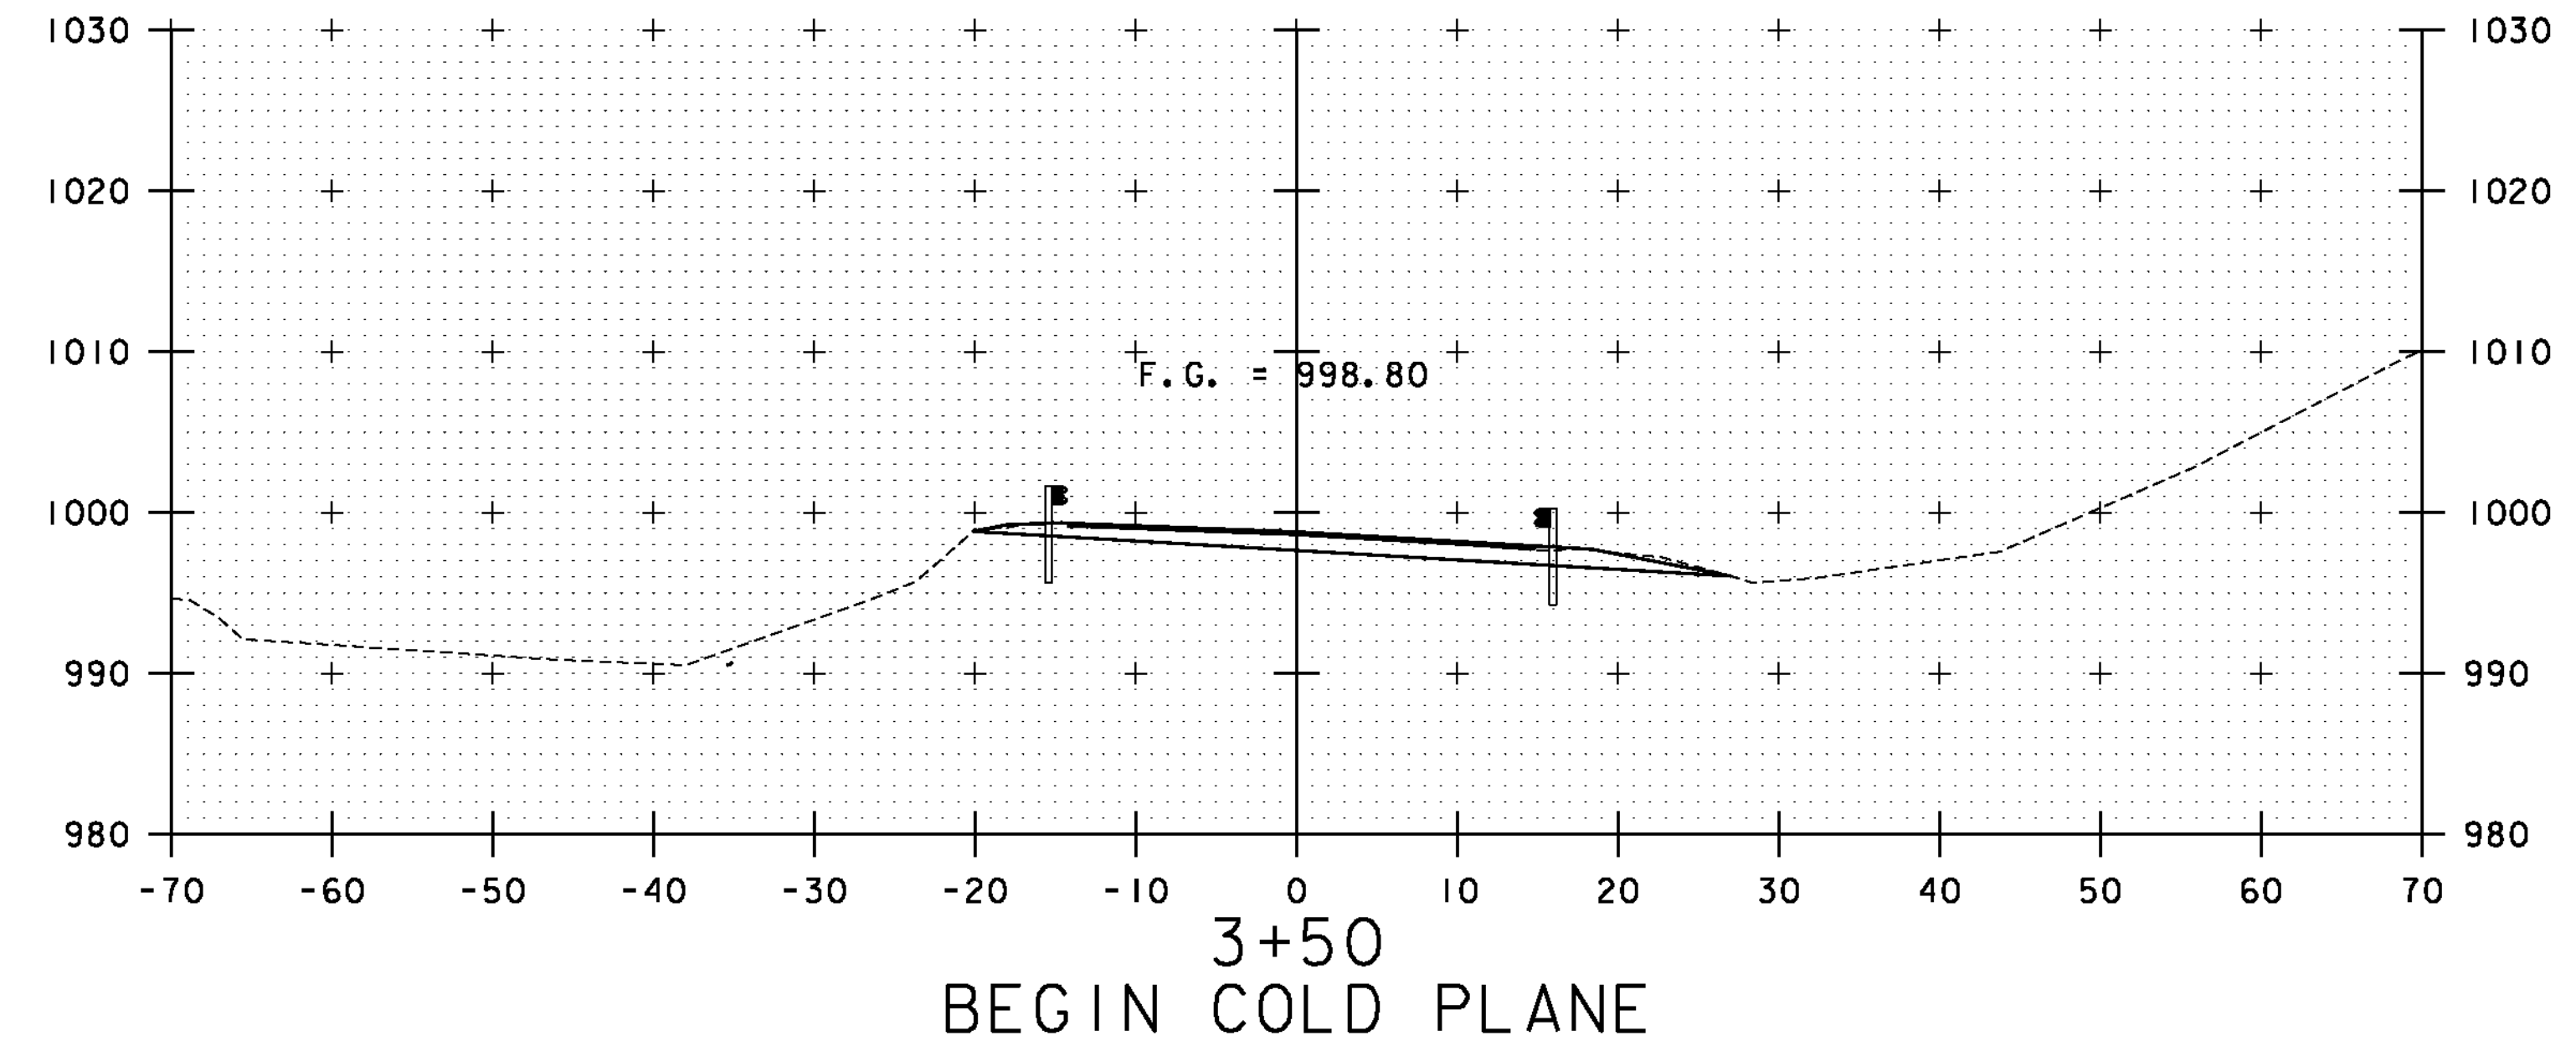
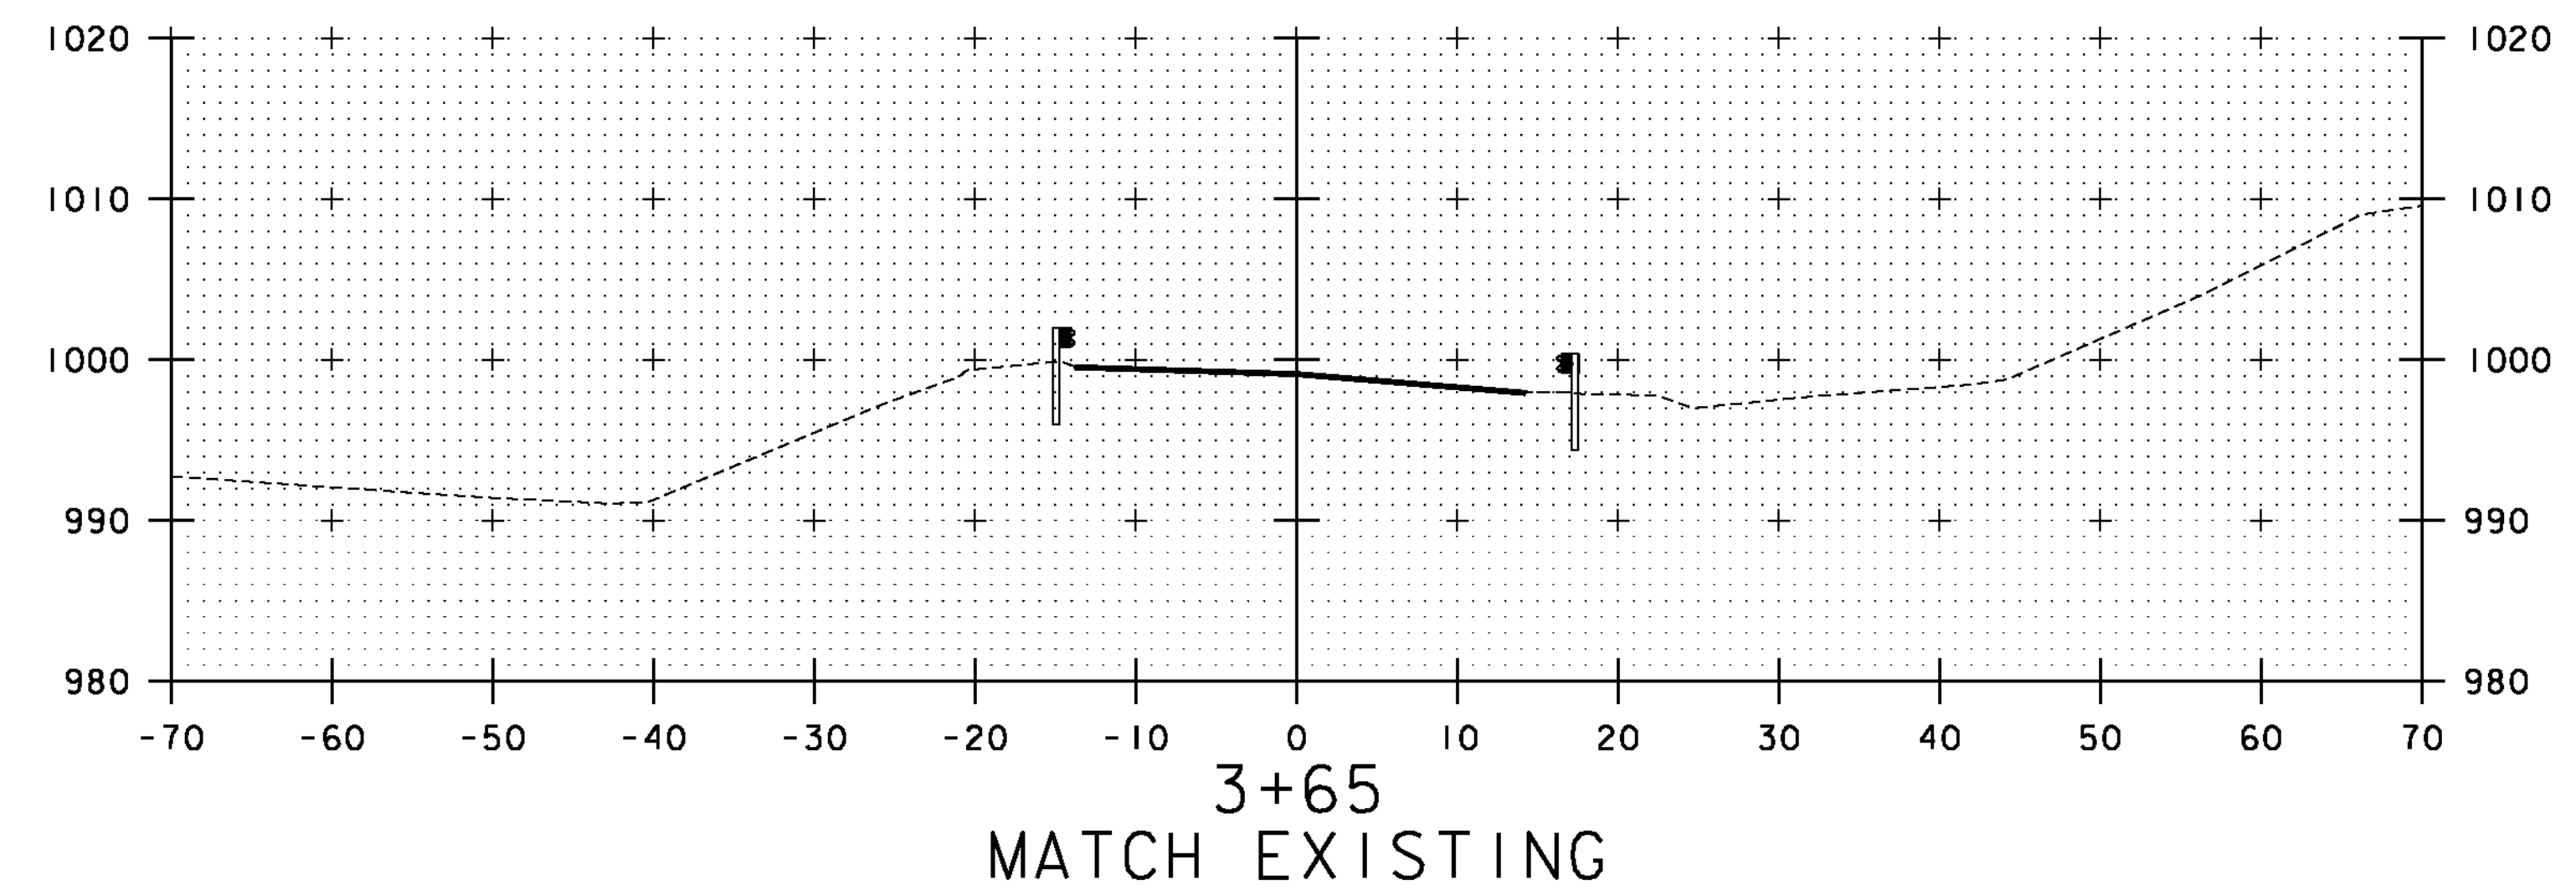
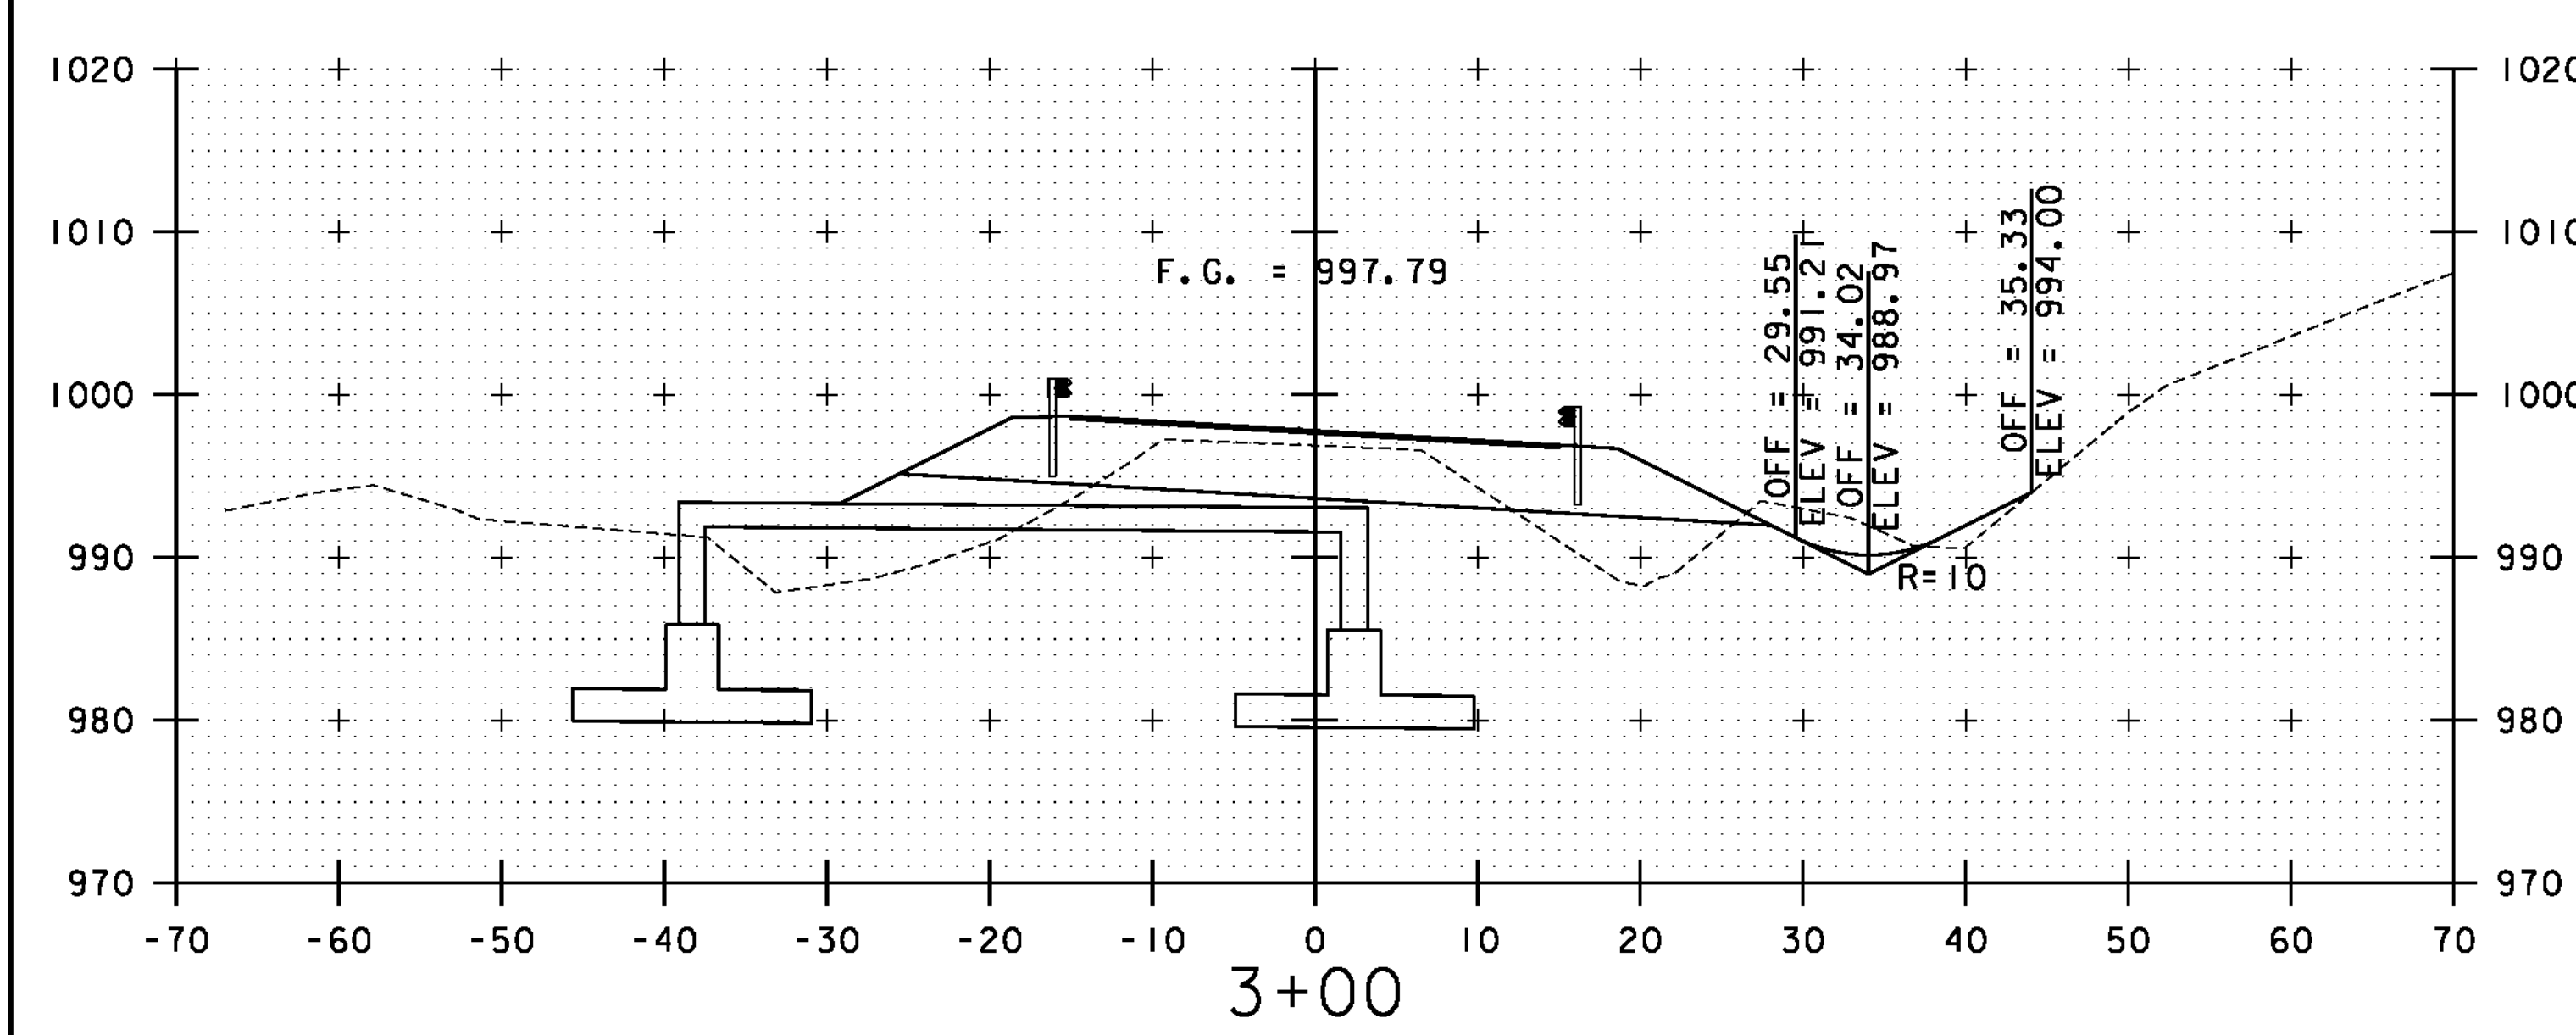
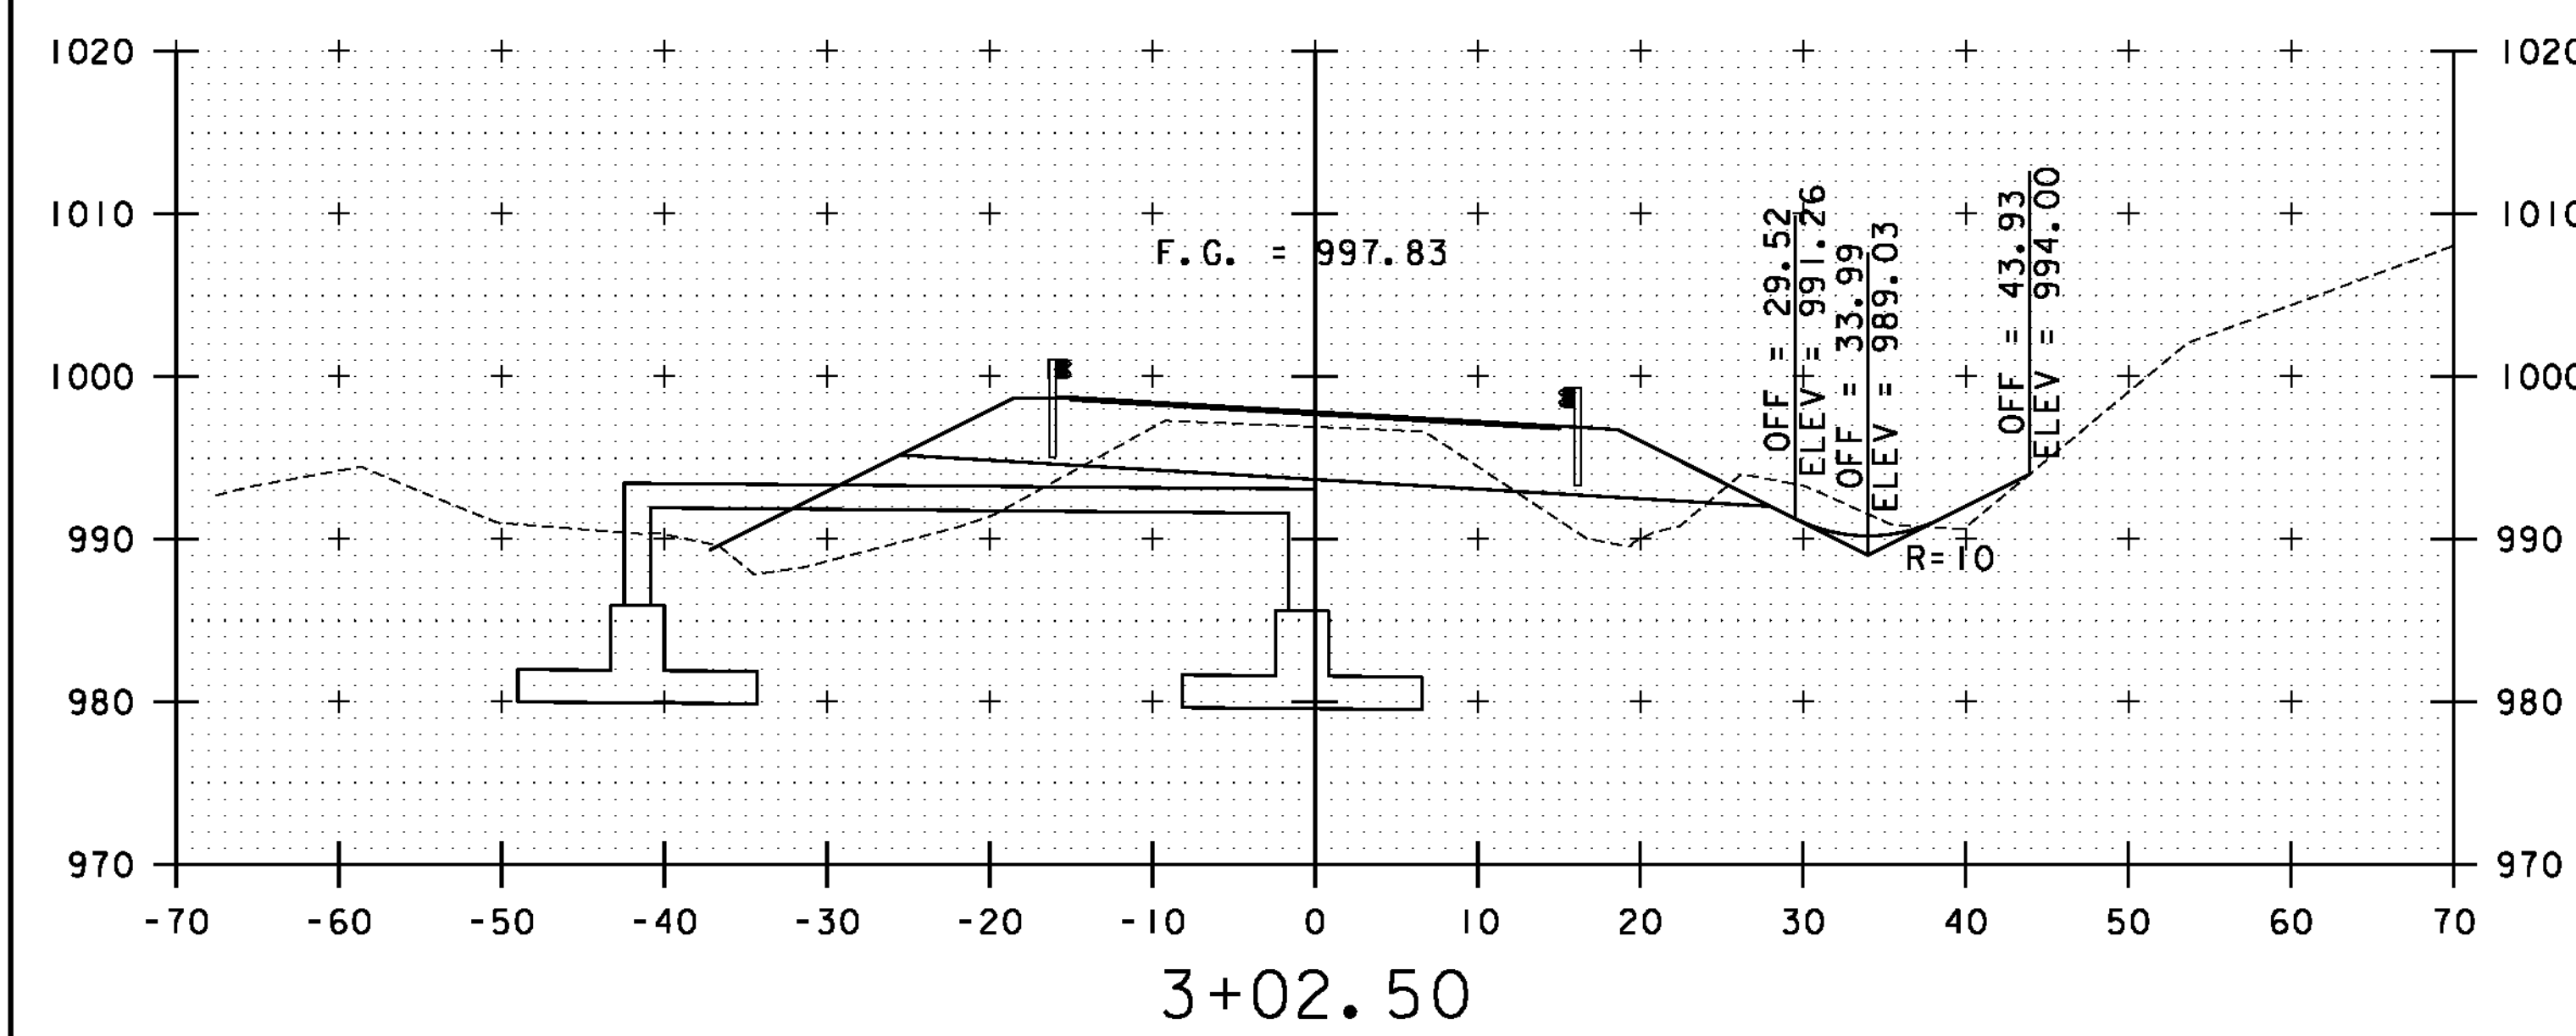


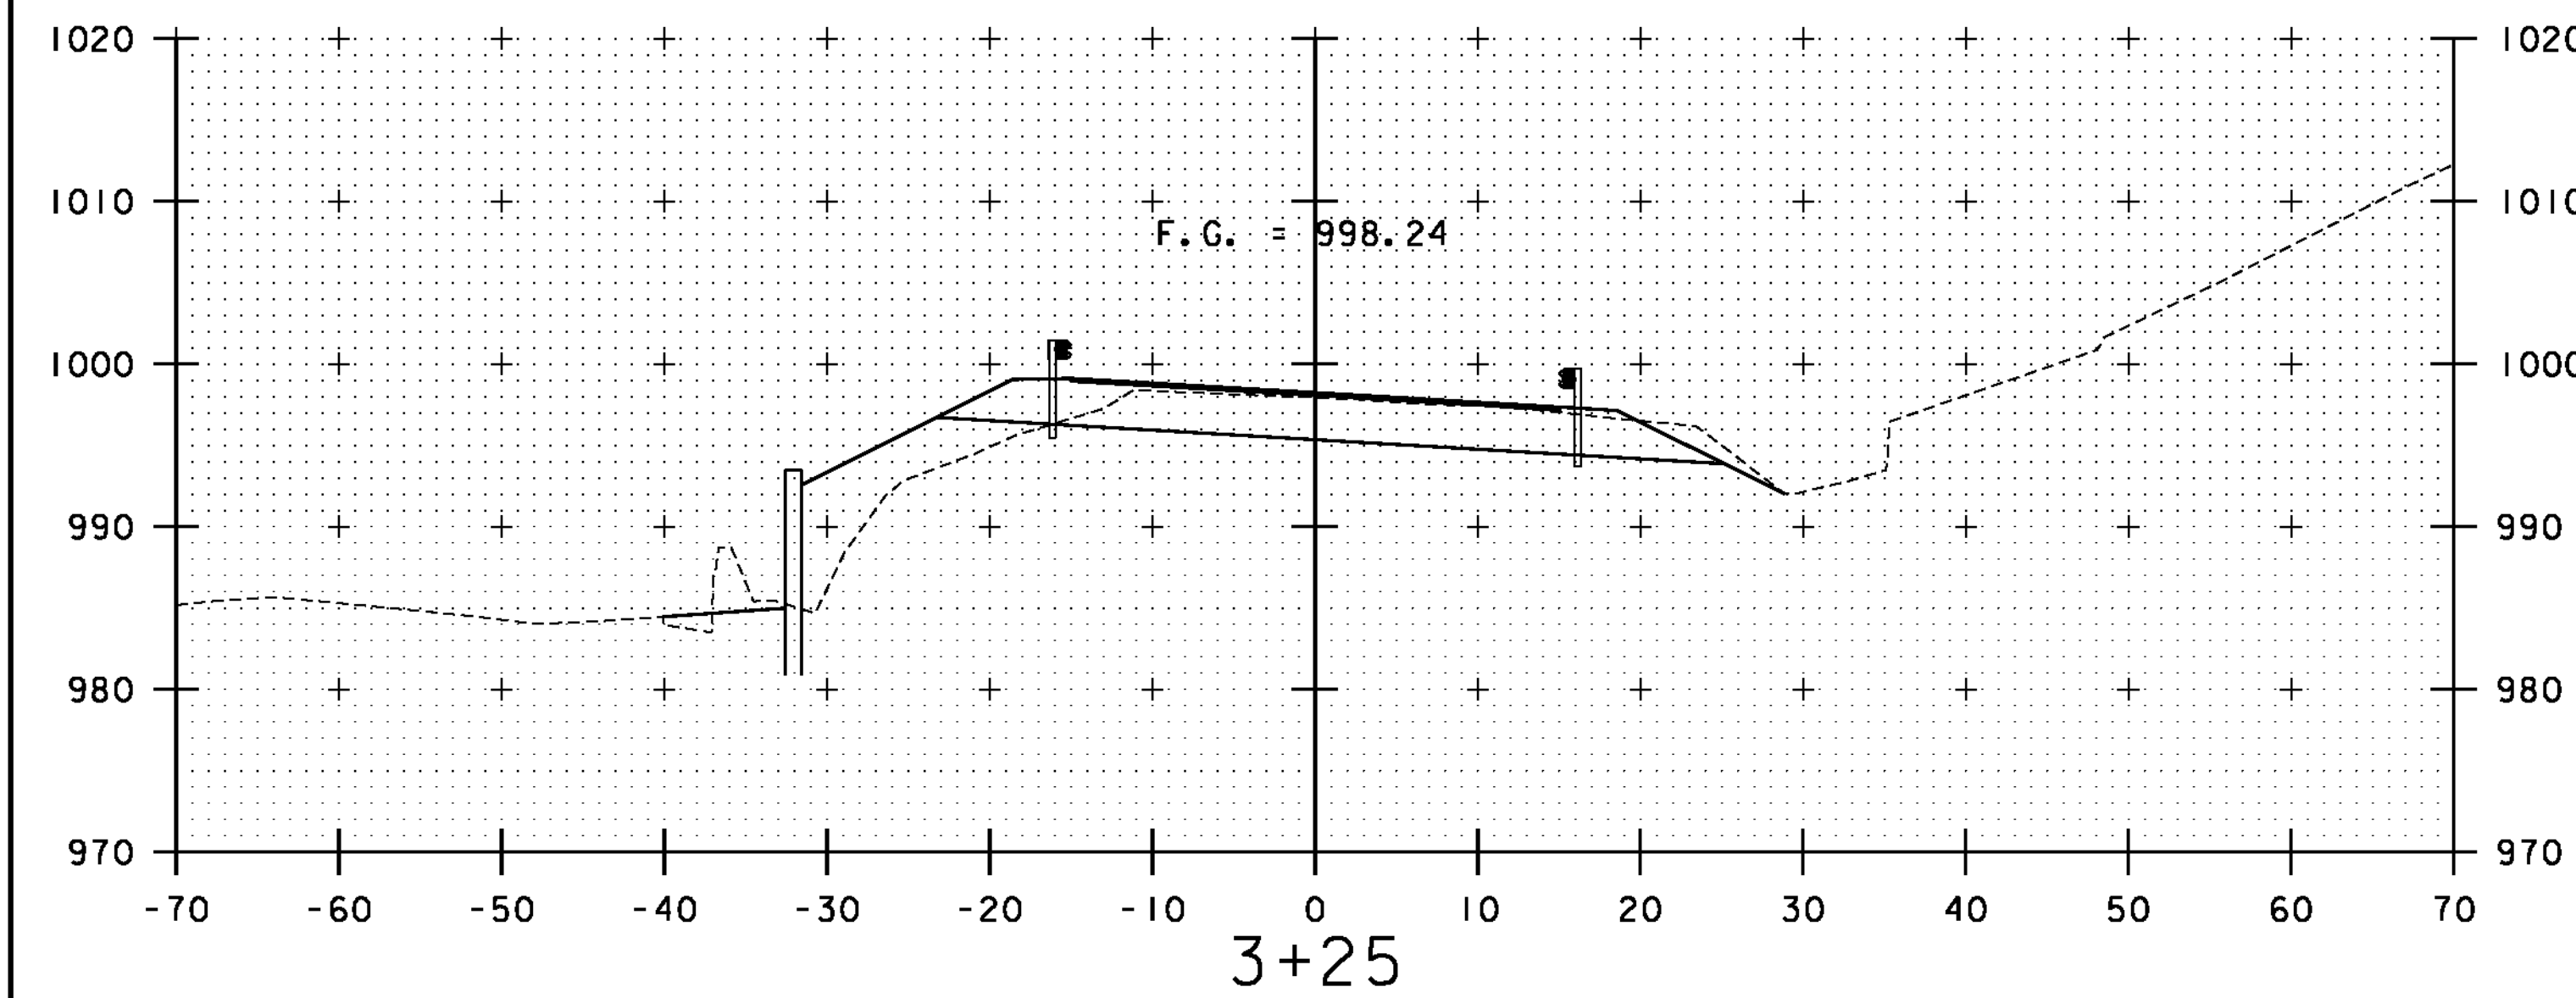

PROJECT NAME:	ROXBURY
PROJECT NUMBER:	ER 0187(9)
FILE NAME:...	plotfiles\Cross Sections.dgn
PROJECT LEADER:	G. BOGUE
DESIGNED BY:	M. CHENETTE
VT 12A CROSS SECTIONS 2	
DATE:	9/21/2011
DRAWN BY:	JTS/ISM
CHECKED BY:	G. BOGUE
SHEET	52 OF 54