


27 18" x 10" BASE PLATES @ 1'-2" A 36  
6 1/4" x 4" EXP FILL PLATE @ 2'-11" A 572 Gr SO

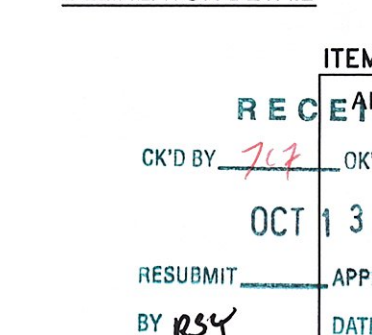

|                                                                                                                                                        |     |                                                                                                                                                                                                          |                                                                                       |    |   |
|--------------------------------------------------------------------------------------------------------------------------------------------------------|-----|----------------------------------------------------------------------------------------------------------------------------------------------------------------------------------------------------------|---------------------------------------------------------------------------------------|----|---|
| 0                                                                                                                                                      |     | GEN CONTR: F.R. Lafayette                                                                                                                                                                                |                                                                                       | SH |   |
| BY:                                                                                                                                                    |     | <h2 style="text-align: center;">BRIDGE RAIL DETAILS SHEET</h2> <p style="text-align: center;">ROUTE 12A, BR 15 &amp; BR 22</p> <p style="text-align: center;">TOWN OF ROXBURY, WASHINGTON COUNTY, VT</p> |                                                                                       |    |   |
| R                                                                                                                                                      | NO. | DATE                                                                                                                                                                                                     | DESCRIPTION                                                                           | BY | R |
| E                                                                                                                                                      | V   |                                                                                                                                                                                                          |                                                                                       | E  | V |
|                                                                   |     |                                                                                                                                                                                                          |  |    |   |
| <p><b>ELDERLEE, INC.</b><br/>         OAKS CONCRETE NEW YORK 16178<br/>         E-Mail: <a href="mailto:clong@elderlee.com">clong@elderlee.com</a></p> |     |                                                                                                                                                                                                          | <p><b>DRAWN</b><br/>         CHECKED<br/>         APPROVED<br/>         SCALE</p>     |    |   |

Tel: 315-789-6670 Fax: 315-789-6615 DRAWING NO. FR Lafayette EM1' 220