


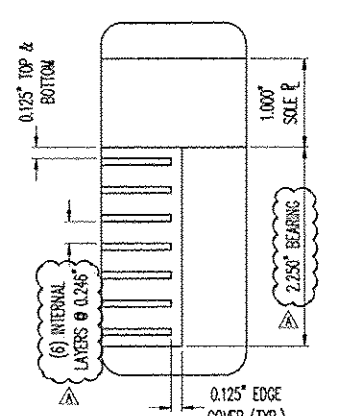

RECEIVED
CK'D BY 74 OK'D BY 150
OCT 12 2011
RESUBMIT _____ APPROVED ☒
BY RSY DATE 10/13/2011